


Schlotzsky



Bench Mark
Square cut top of curb
at west of NE property
corner
Elev. 125.27 City Datum

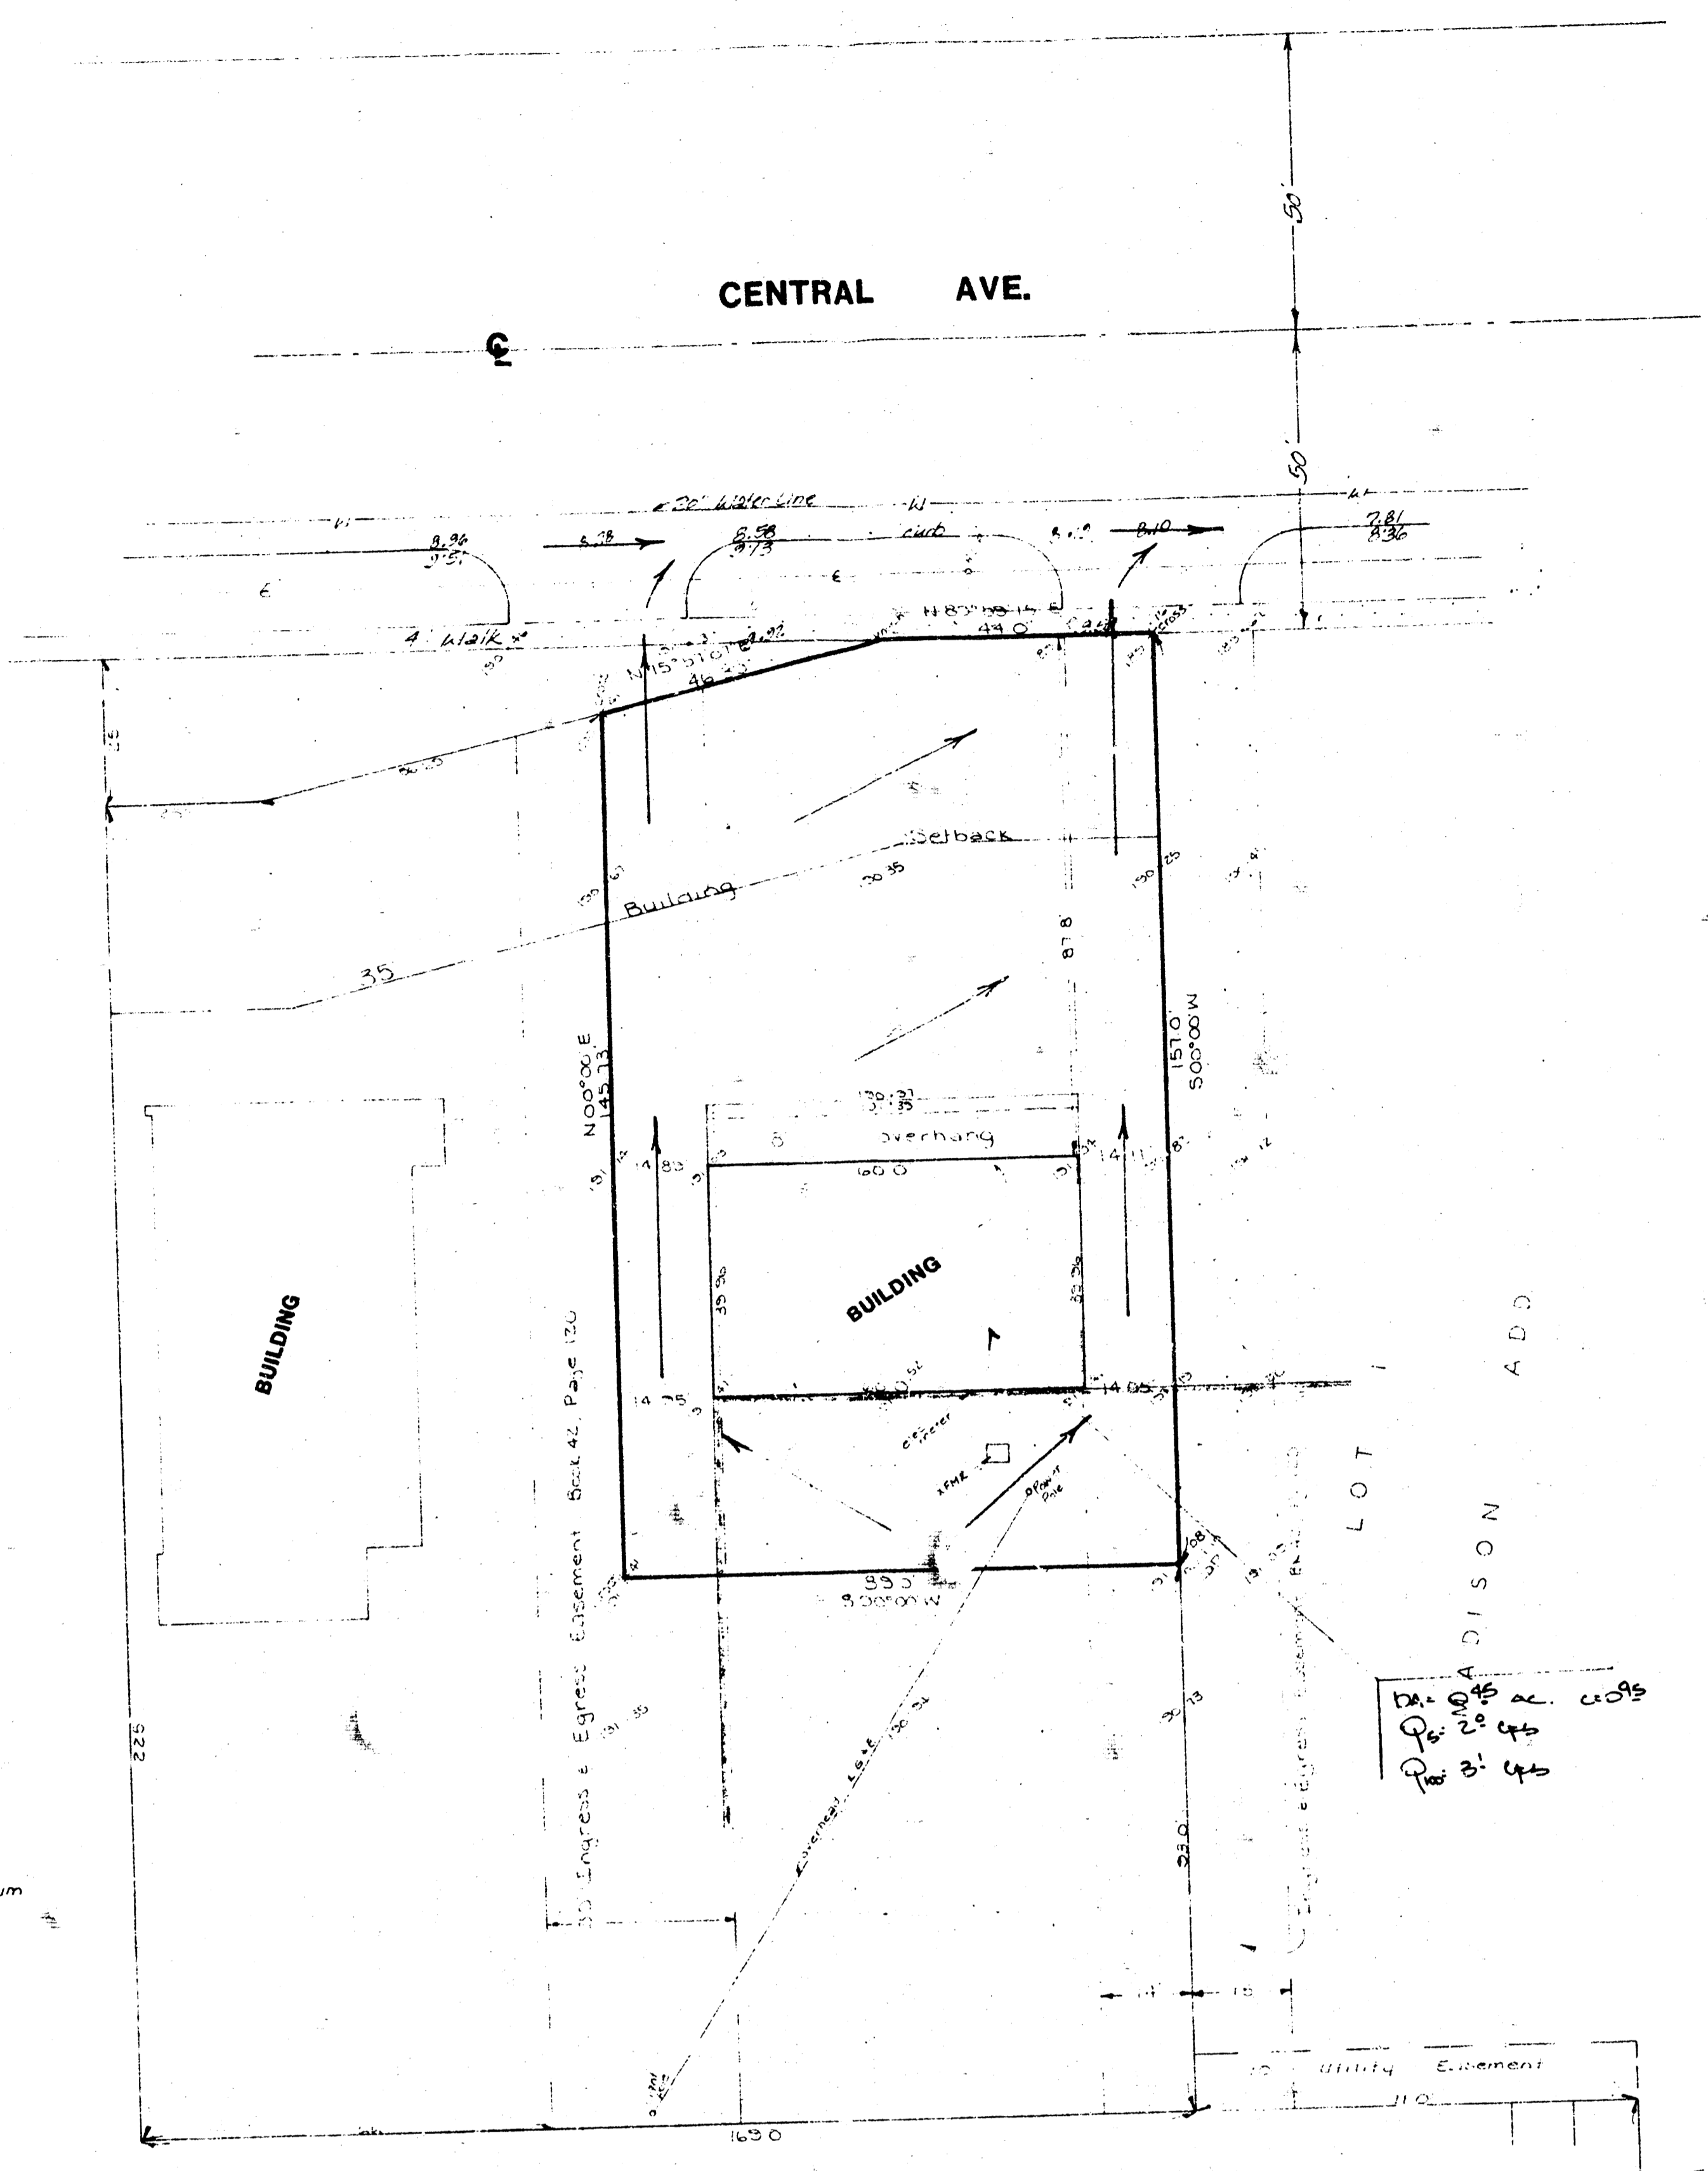

CALIENDO 2ND
ADDITION

ALLEY

SKETCH PLAT

SCHLOTZSKY'S ADDITION

REPLAT OF PART OF LOT 2, MADISON ADDITION, WICHITA, KANSAS

OWNER: MICHAEL J. BOYD

DRAINAGE PLAN

BAUGHMAN COMPANY, P.A.
SURVEYING & ENGINEERING
316 262-3271 • 316 ELLIS • WICHITA, KANSAS 67211

Apr 21 89