



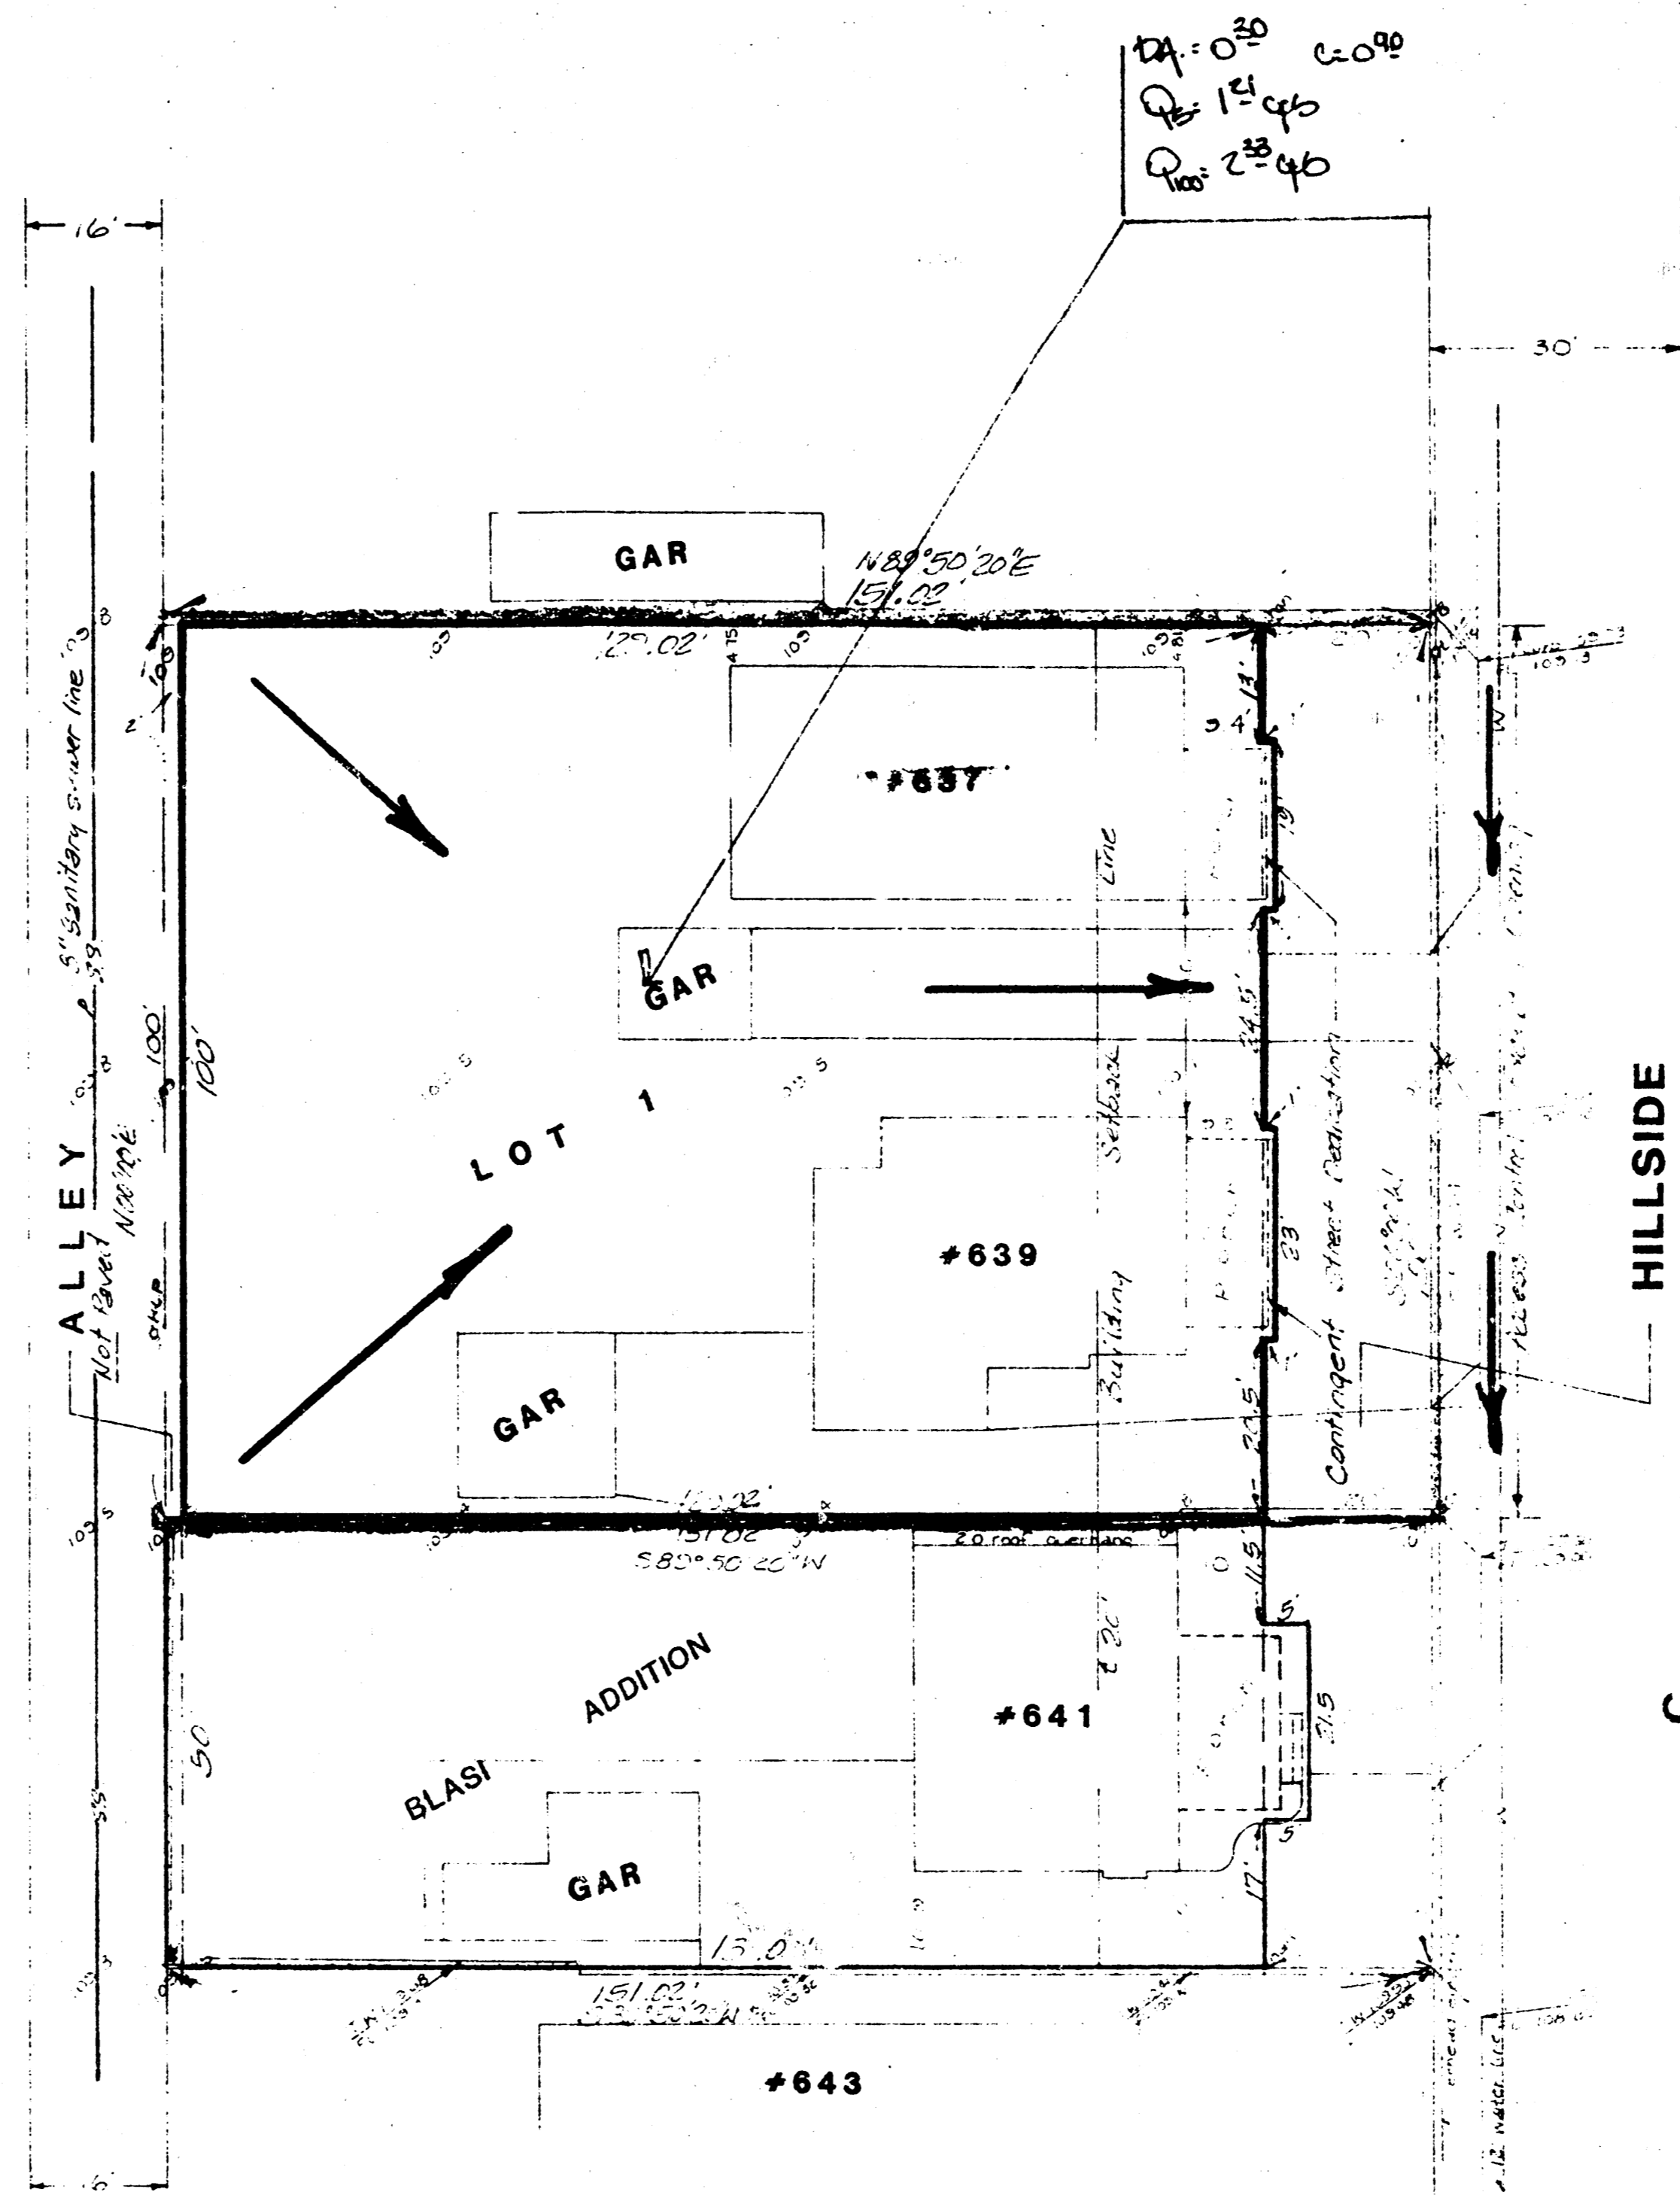

Bench Marks:  
1. Set on top of west curb on  
corner and 41' 0" from Hillside  
42' 0" east south of 1/4 of Orme  
Elev. 510.72 - 1. Datum

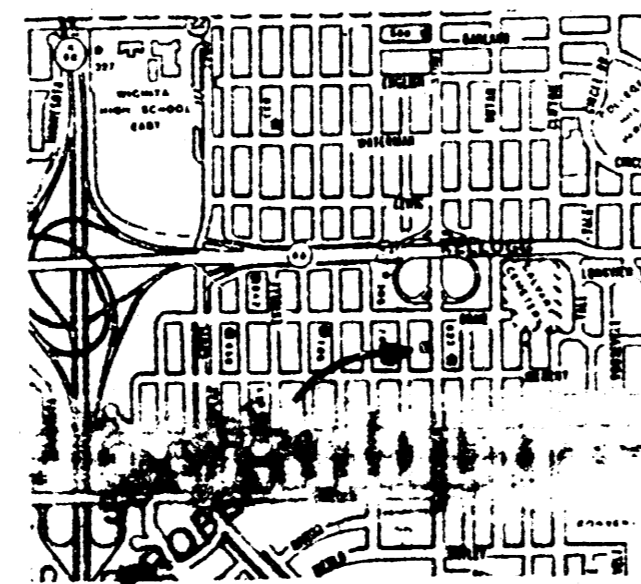

SKETCH PLAT

### SCHUYLER ADDITION

LOTS 73, 75, 77, AND 79, BLOCK 8, SUNNY-SIDE ADDITION, WICHITA, KANSAS

OWNERS:

MARK W. AND ERIN S. SCHUYLER



DRAINAGE PLAN

**BAUGHMAN COMPANY, P.A.**  
SURVEYING & ENGINEERING  
316-262-7271 • 315 ELLIS • WICHITA, KANSAS 67211