




Drainage Plan SHAVER ADDITION Wichita, Sedgwick County, Kansas





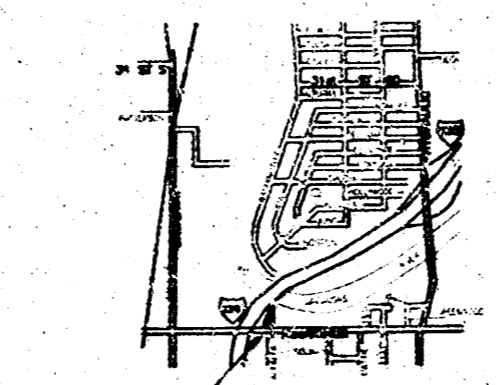


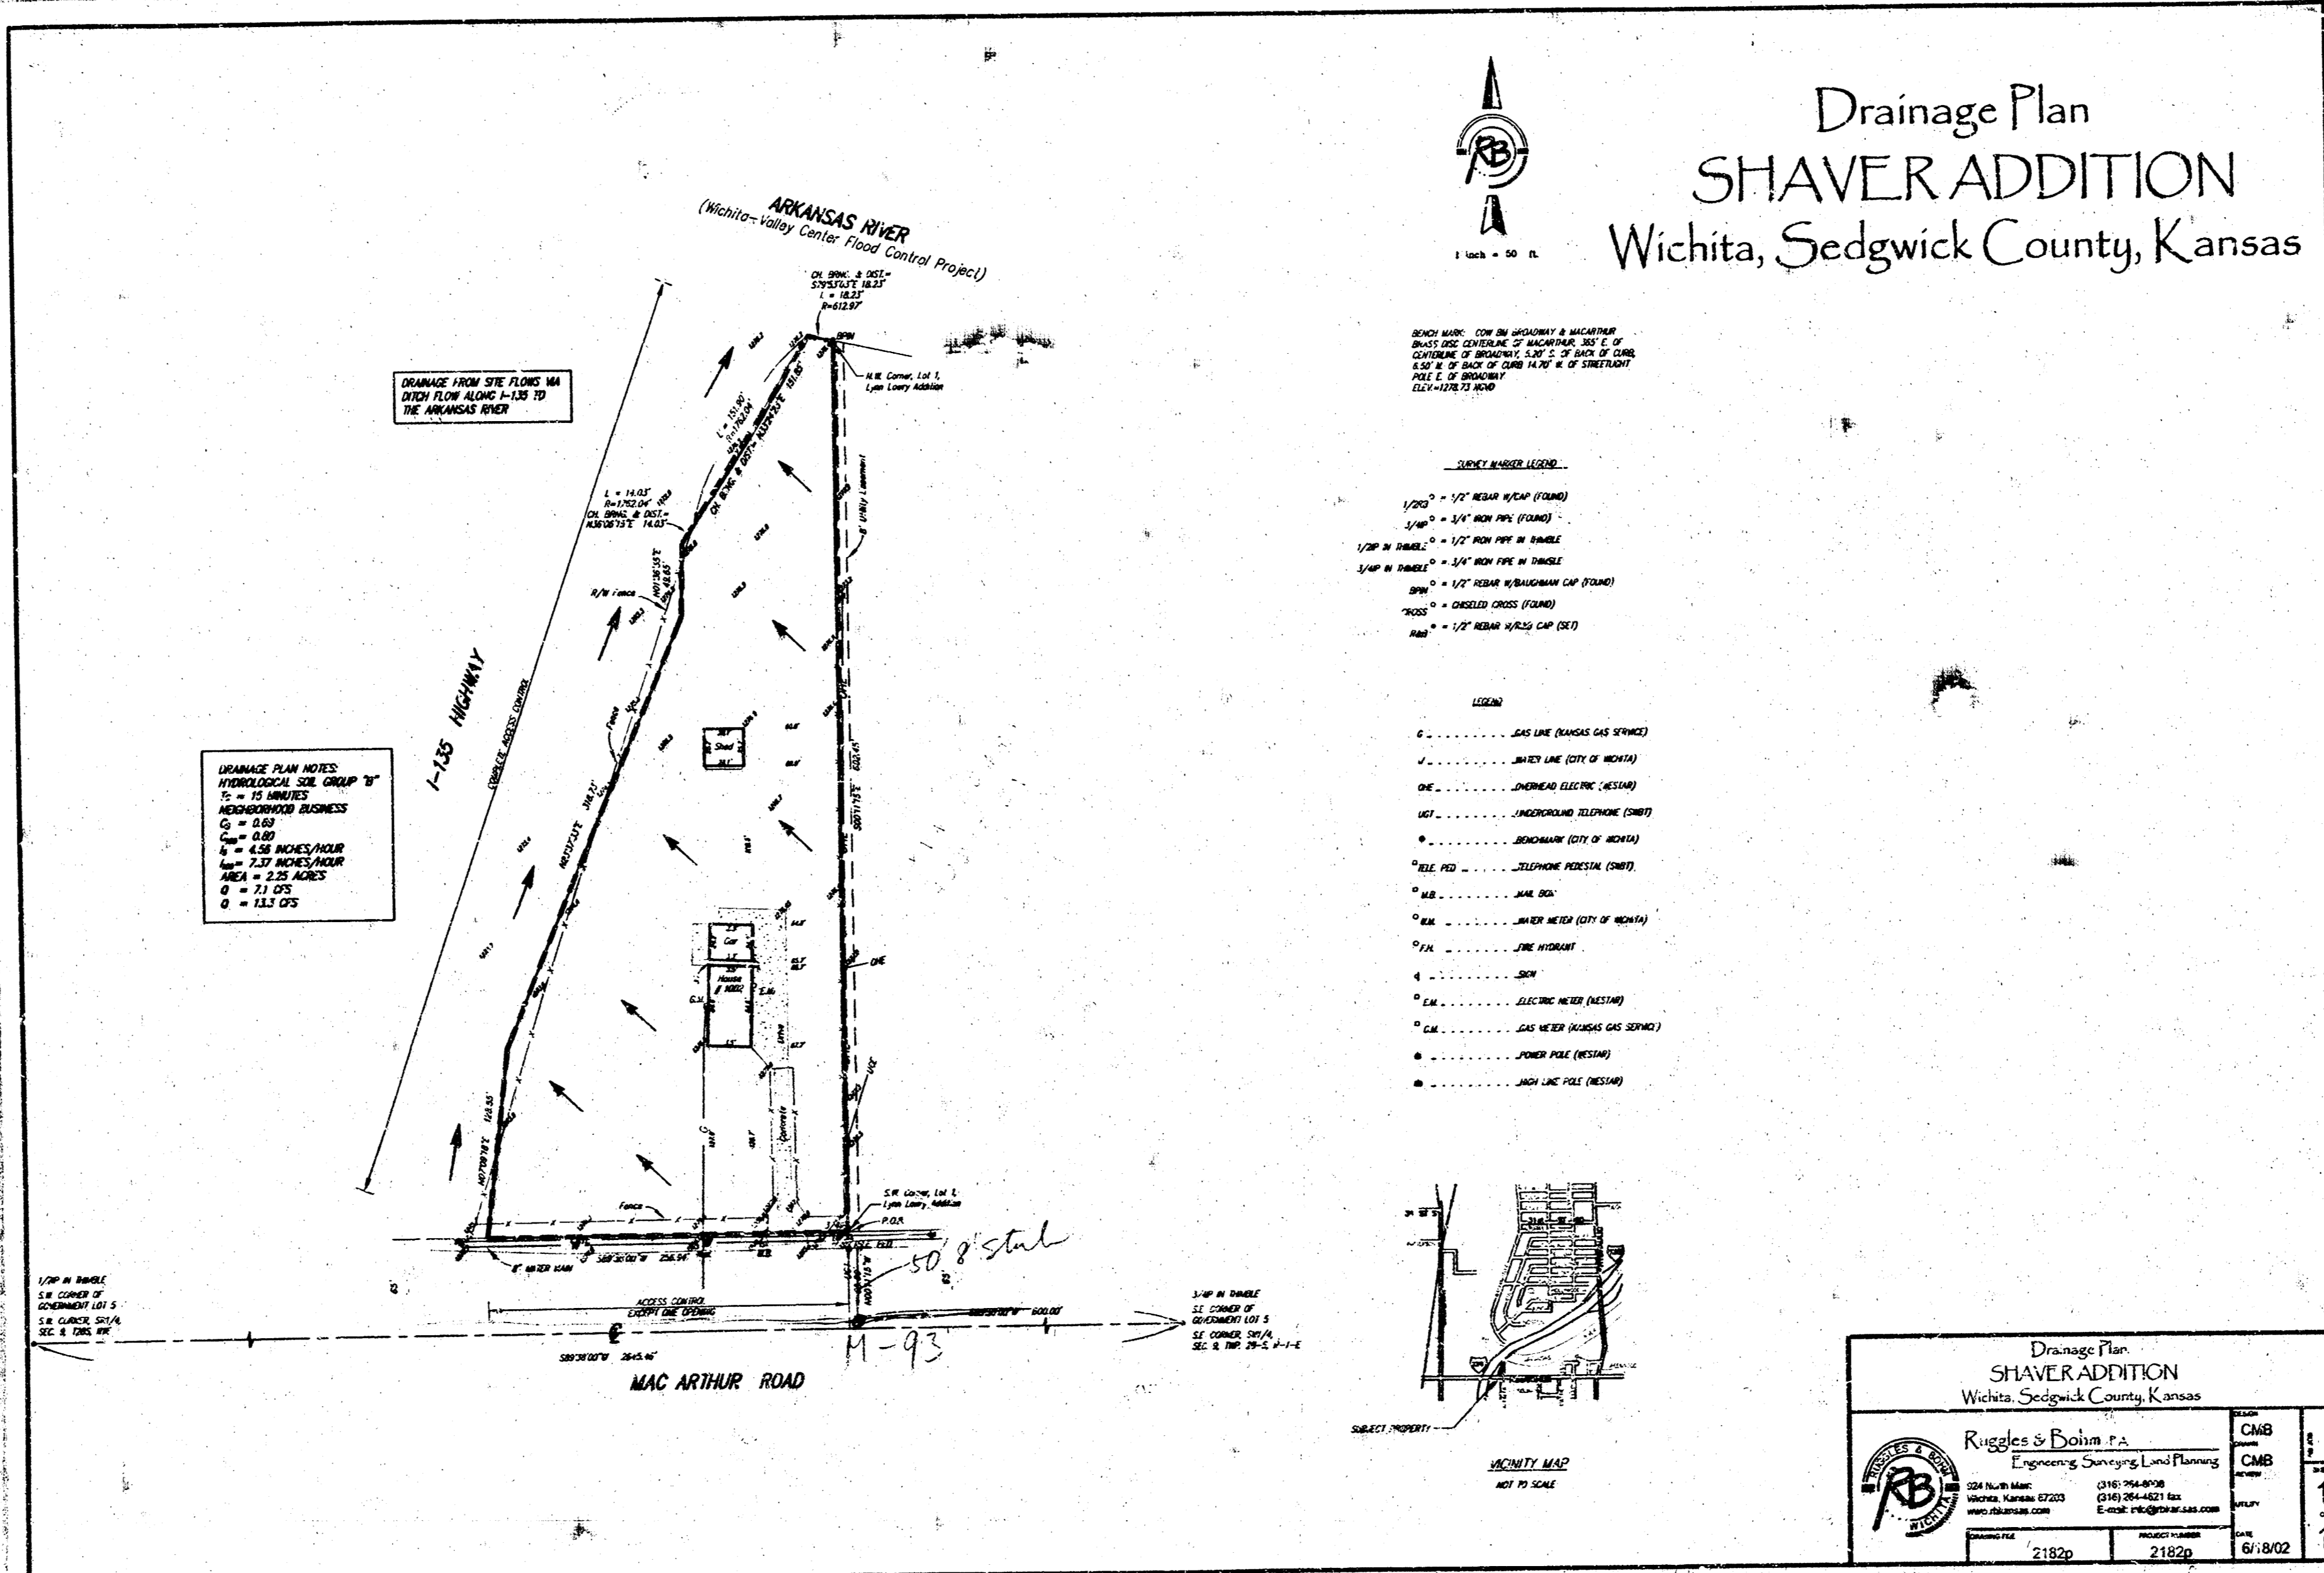

DRAINAGE PLAN NOTES:

Drainage Plan SHAVER ADDITION Wichita, Sedgwick County, Kansas	
