



SCALE: 1" = 30'

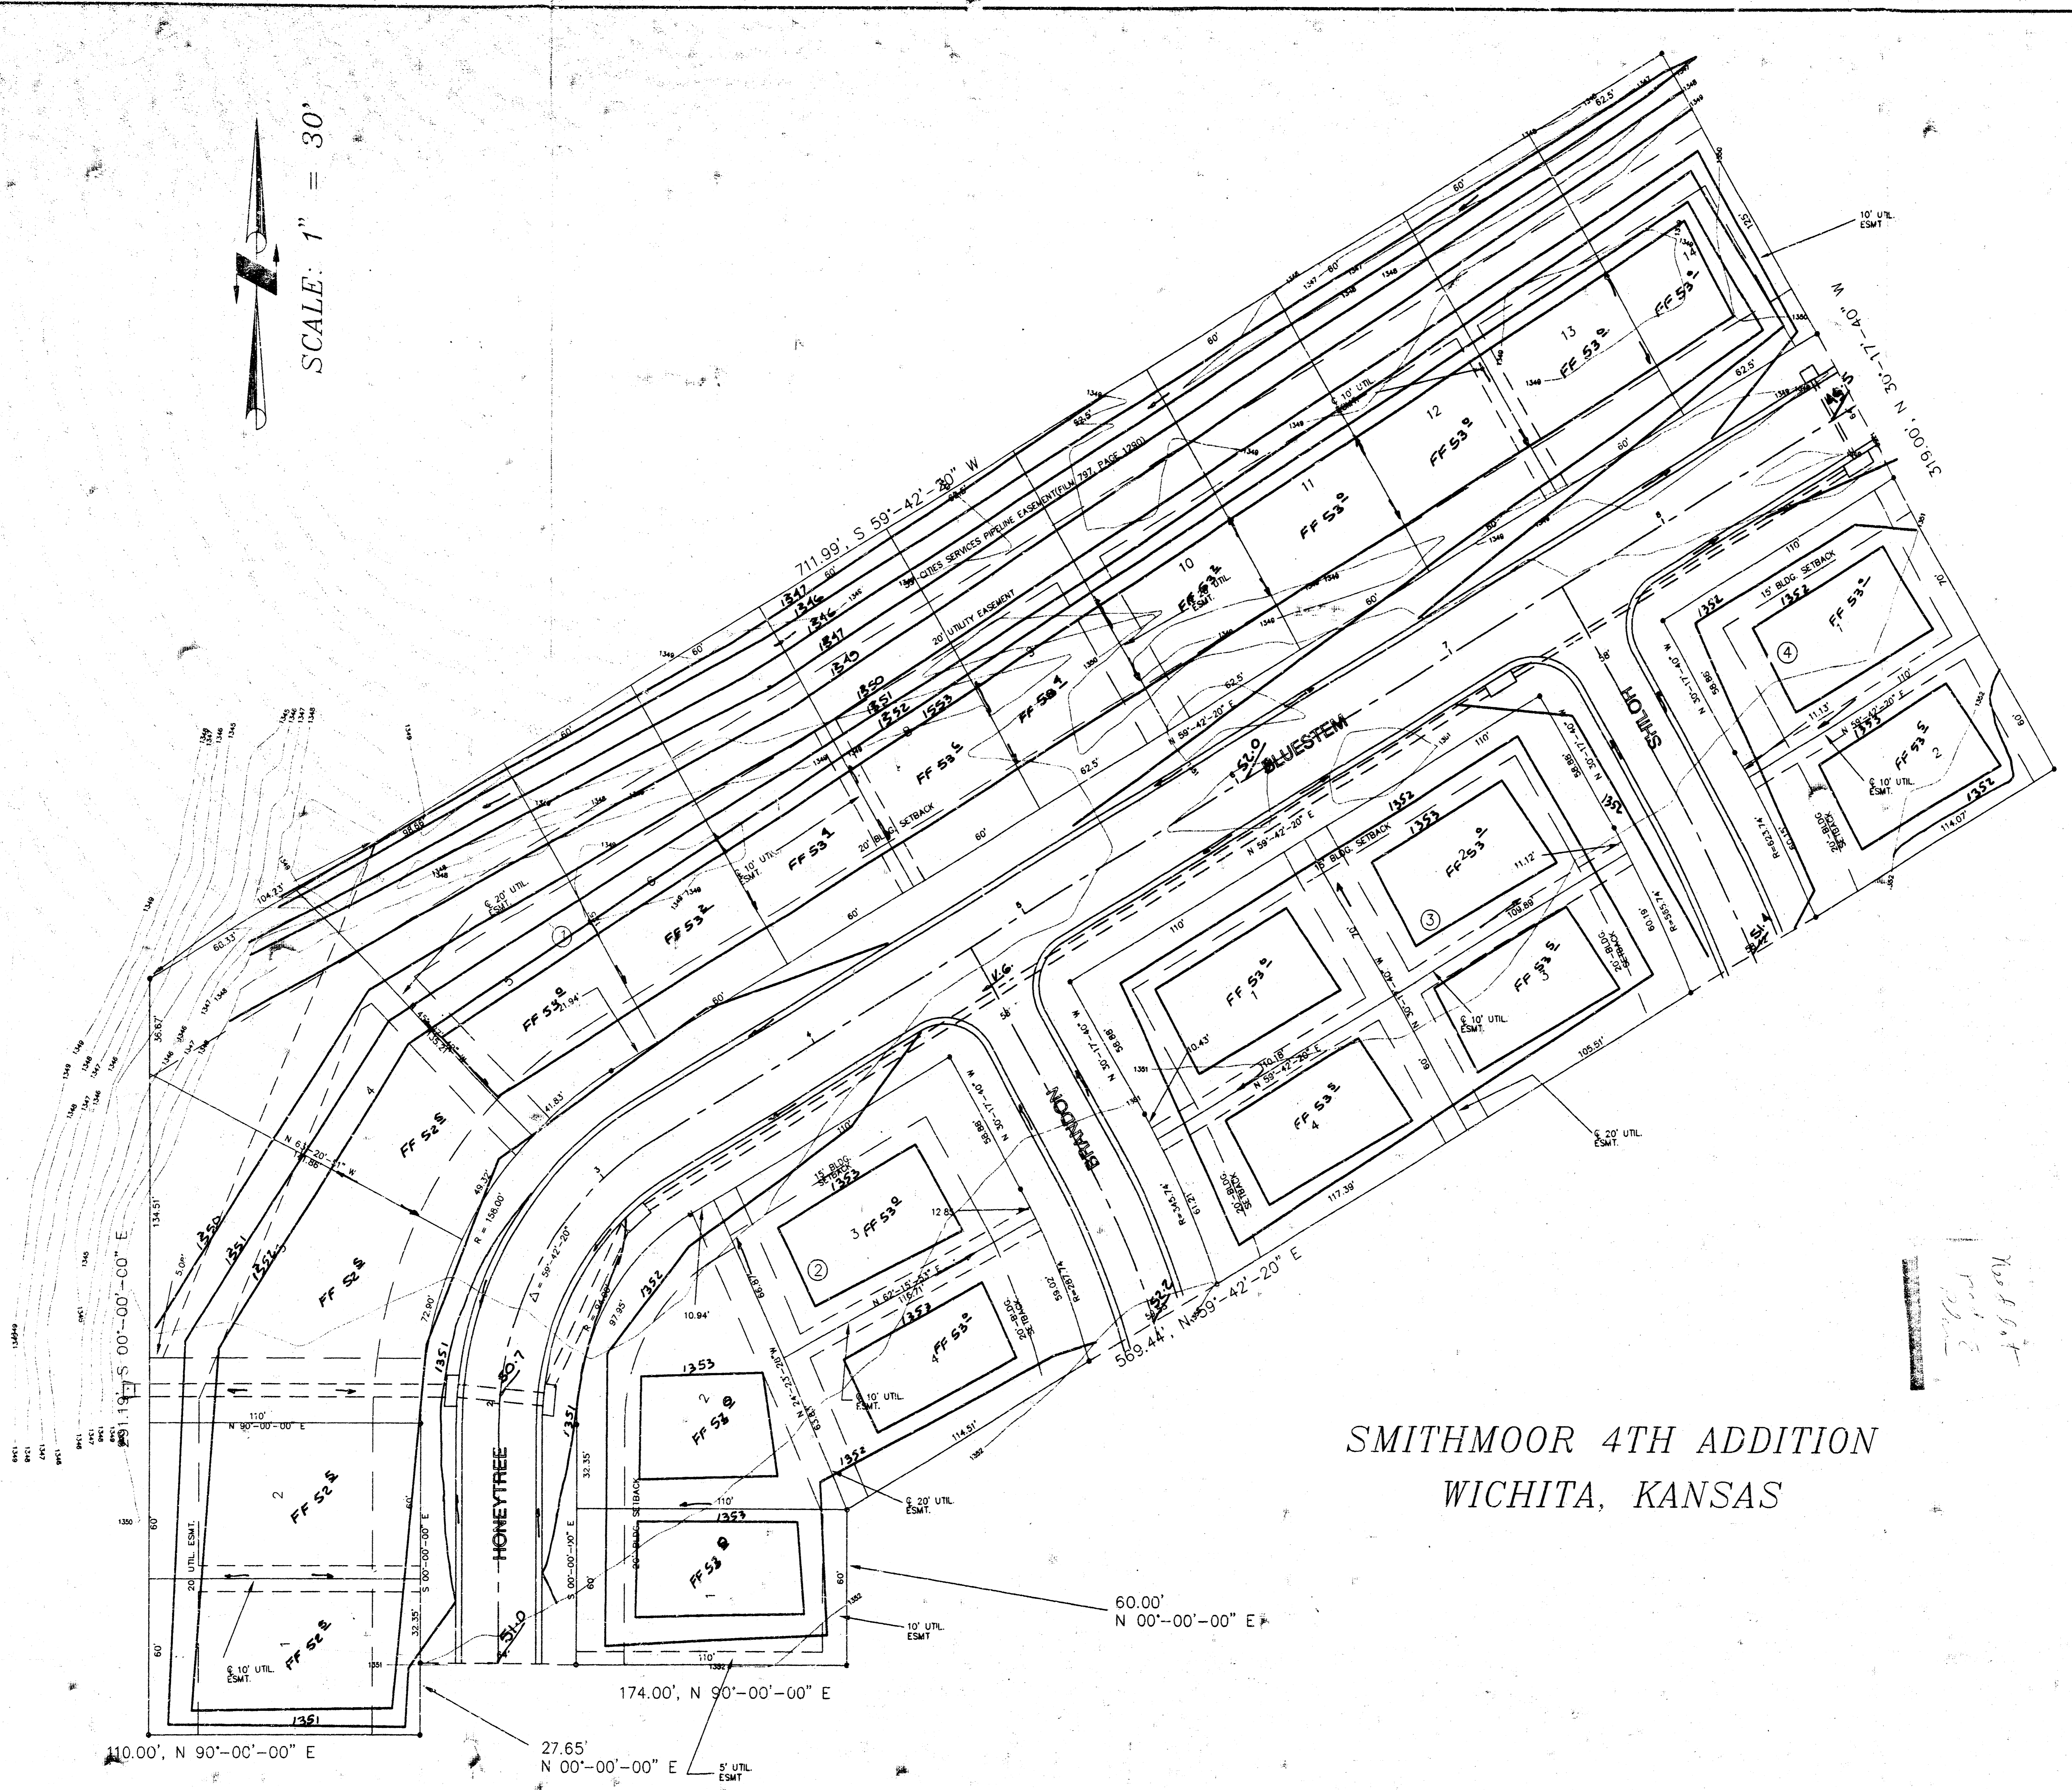


SMITHMOOR 4TH ADDITION
WICHITA, KANSAS

APPROVED
DRAINAGE PLAN

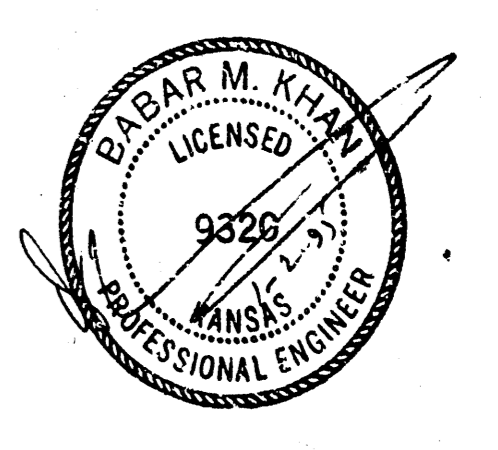

BENCH MARK: TOP OF PROPERTY IRON @
N.W. COR., LOT 6, BLK C, SMITHMOOR 3RD
ADDITION.
ELEV. = 1350.55

LOT GRADING PLAN		
SCALE:	APPROVED:	DRAWN BY:
DATE:	CHECKED:	
PROJECT NO:		SHEET NO.:
94-33 (MUNICIPAL)		
 MUNICIPAL ENGINEERS 264-LAURA, SUITE 201 WICHITA, KANSAS 67211 316-262-3842		