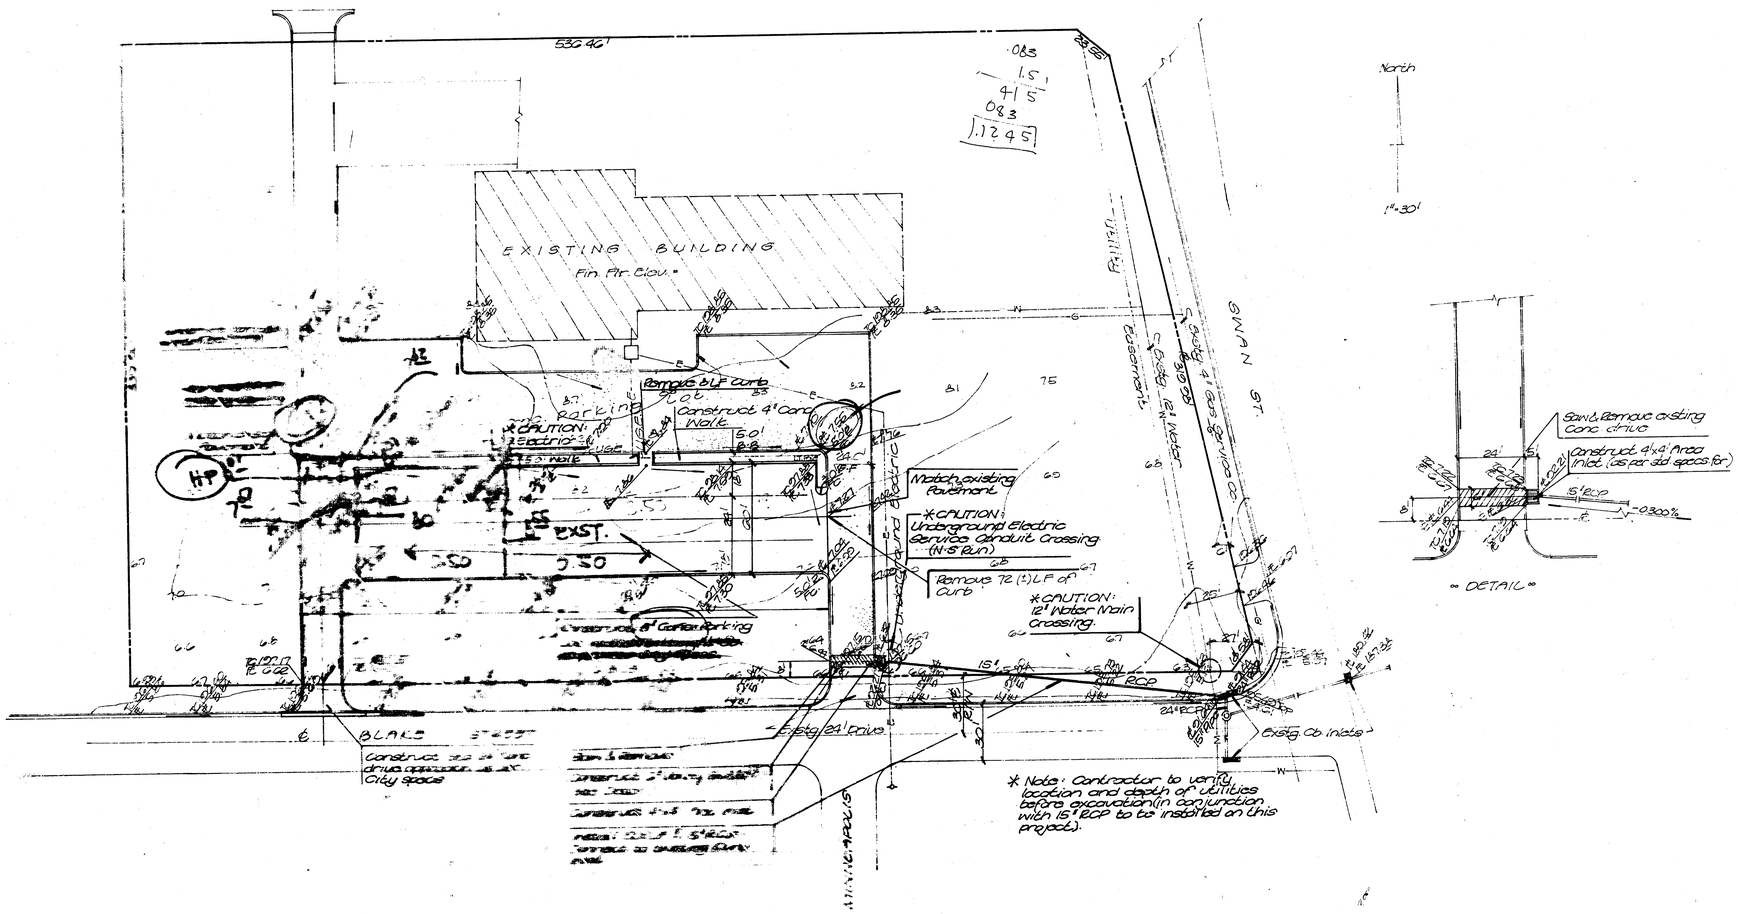STAFFORD ADDITION
(DRAINAGE)