AREA MAP OF

SUMMERFIELD 3RD ADDITION

OWNERS: DONALD C. AND JUDITH A. SLAWSON
104 S. BROADWAY
SUITE 200
WICHITA, KANSAS 67202

ENGINEER: PROFESSIONAL ENGINEERING CONSULTANTS, P.A.
303 S. TOPEKA
WICHITA, KANSAS 67202

SCALE: 1"=40'

NOVEMBER, 1996

● = IRON FOUND

M=MEASURED DISTANCE AND BEARING
D= DEEDED DISTANCE AND BEARING

TOPOGRAPHY BY ARMSTRONG LAND SURVEY, P.A. MAY, 1996

B.M. - CITY OF WICHITA BENCH MARK DISC, 45' NORTH AND 48' EAST OF THE CENTERLINES OF ROACK ROAD AND 21ST STREET NORTH. ELEV.=214.568

B.M. - CITY OF WICHITA BENCH MARK DISC, 44' SOUTH AND 48' EAST OF THE CENTERLINES OF WEBB ROAD AND 21ST STREET NORTH. ELEV.=205.238

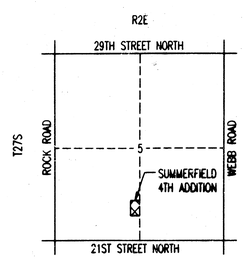

VICINITY MAP

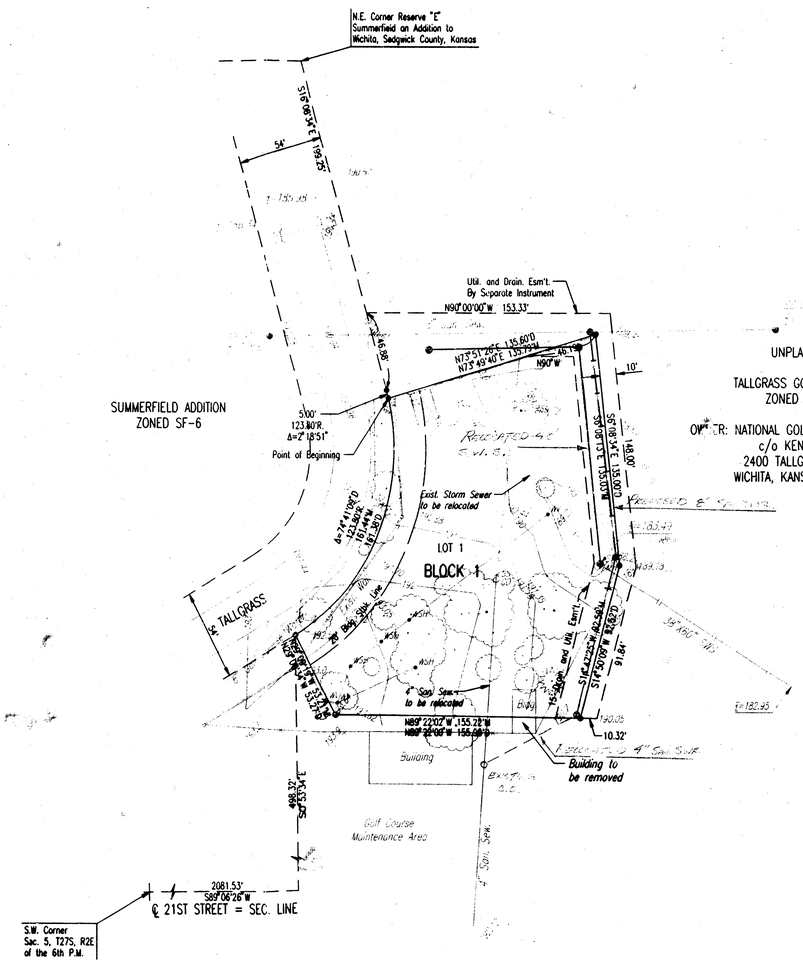

DSNR: SANCHEZ OPER: DEP SCALE: 1=40.00
Q:\1996\96424\ACSUMF.DWG 10-31-1996 11:50:13 am