SUTHERLAND LUMBER NORTH ADDITION
(Drainage)

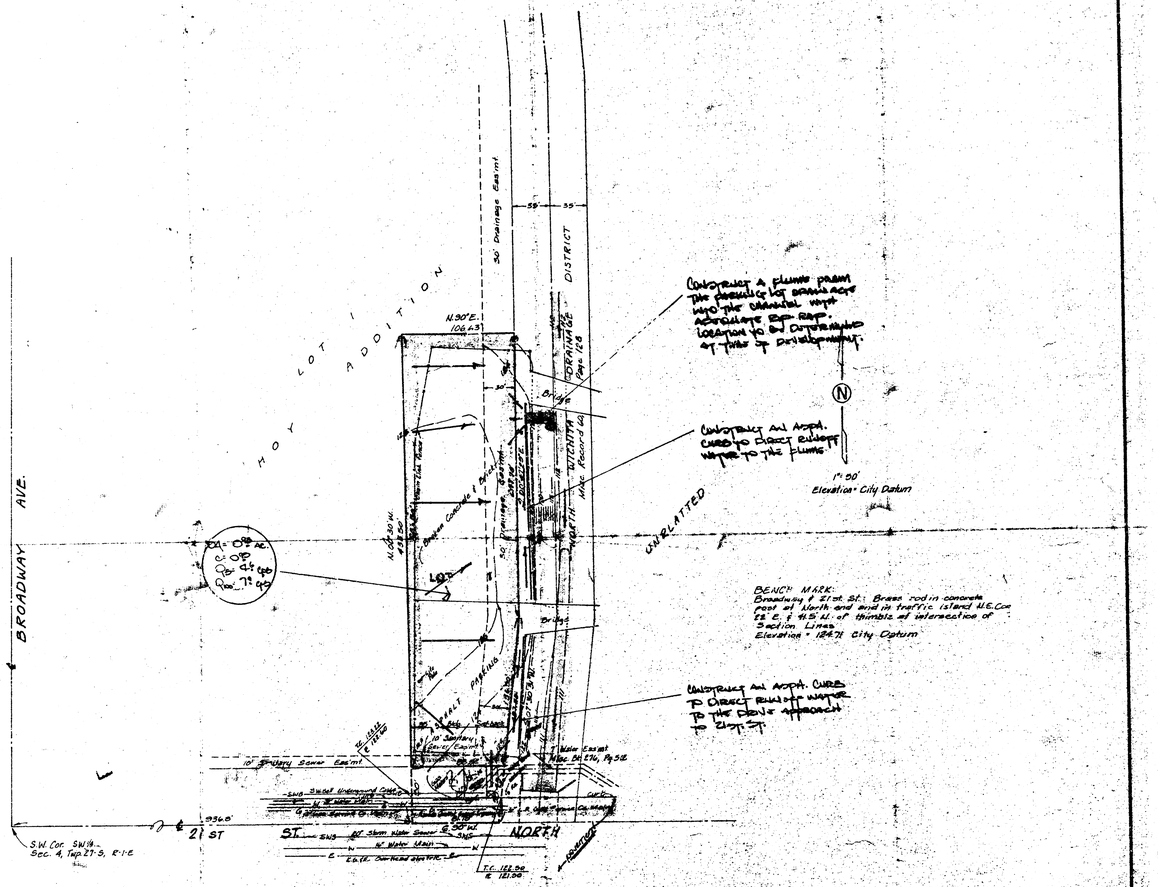

SKETCH PLAT

SUTHERLAND LUMBER NORTH

PART OF THE S 1/2 OF THE SW 1/4 OF THE SW 1/4 OF
SEC. 4, TWP. 27-3, R-1-E

SUTHERLAND LUMBER, A KANSAS LIMITED PARTNERSHIP

DRAINAGE PLAN

RECEIVED
DEC 4 1985
ENGINEERING DIVISION

GAUGHMAN COMPANY, P.A.
CONSULTING ENGINEERS
7-NOV 1985