

Timber Chapel Addn

7

SKETCH PLAT


TIMBER CHAPEL ADDITION

WICHITA, SEDGWICK COUNTY, KANSAS.


Tract in the NW1/4 of Sec. 12, Twp. 27-S, R-1-E of the 6th P.M.
Sedgwick County, Kansas.



Bench Mark:
Disc stamped 235, 1944, 36 feet
south and 36 feet west of the
centerlines of Oliver & 17th St. &
E. South of E.E. Signal light
Elev. = 221.08 City Datum

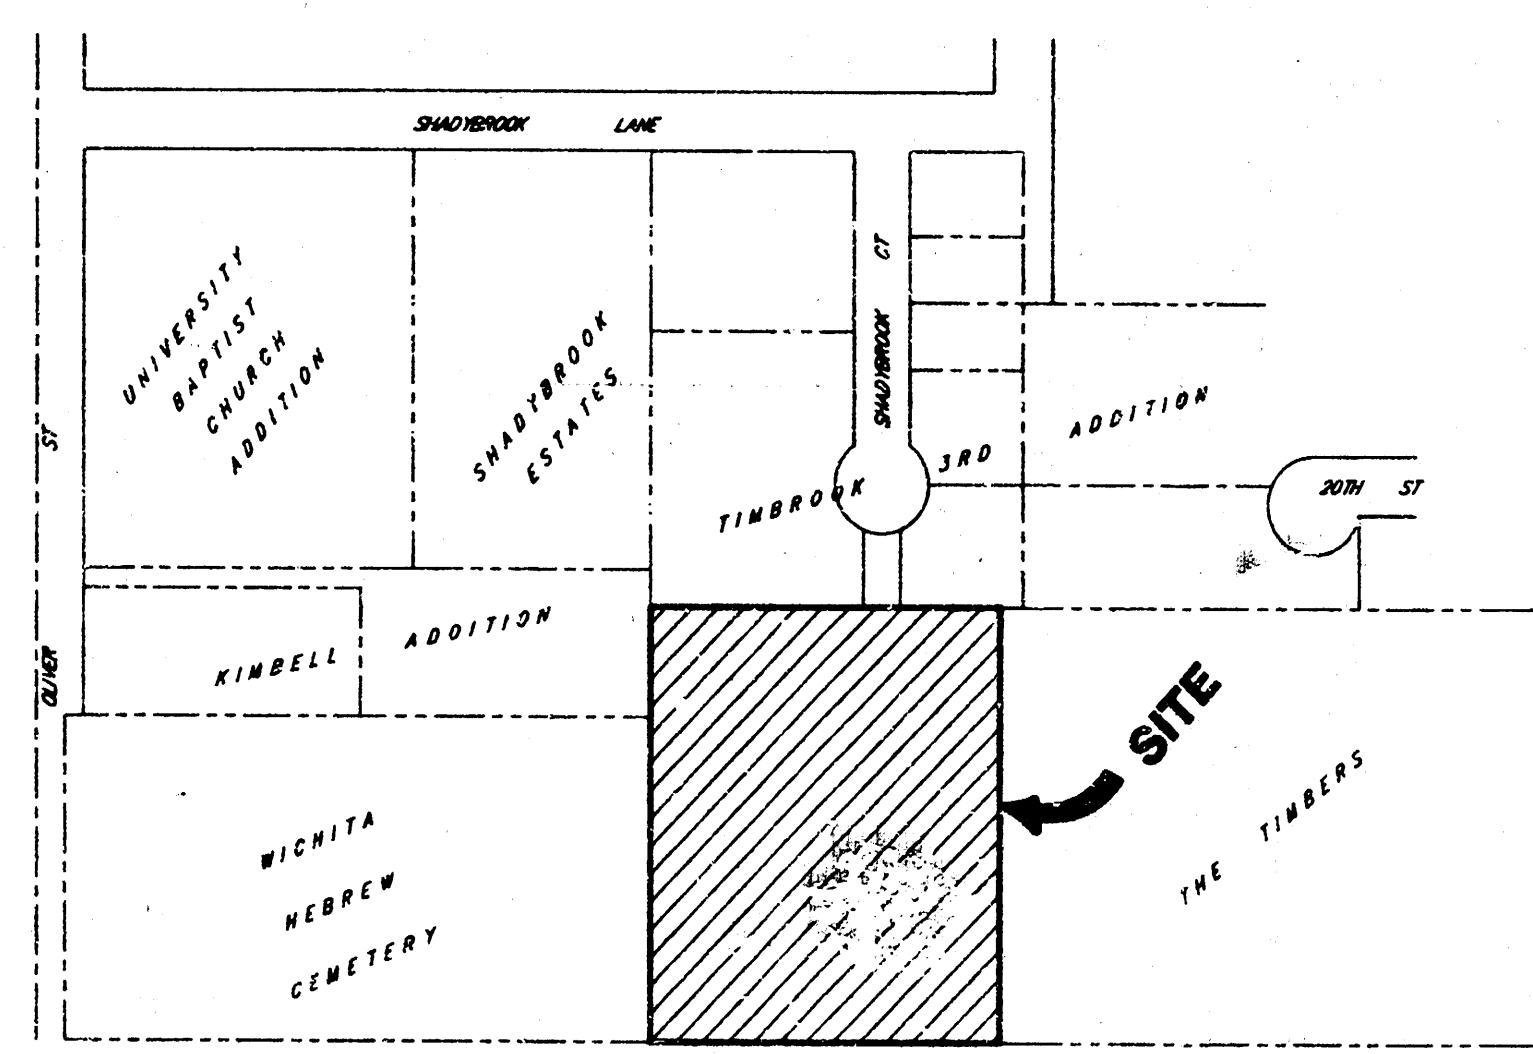

VICINITY MAP

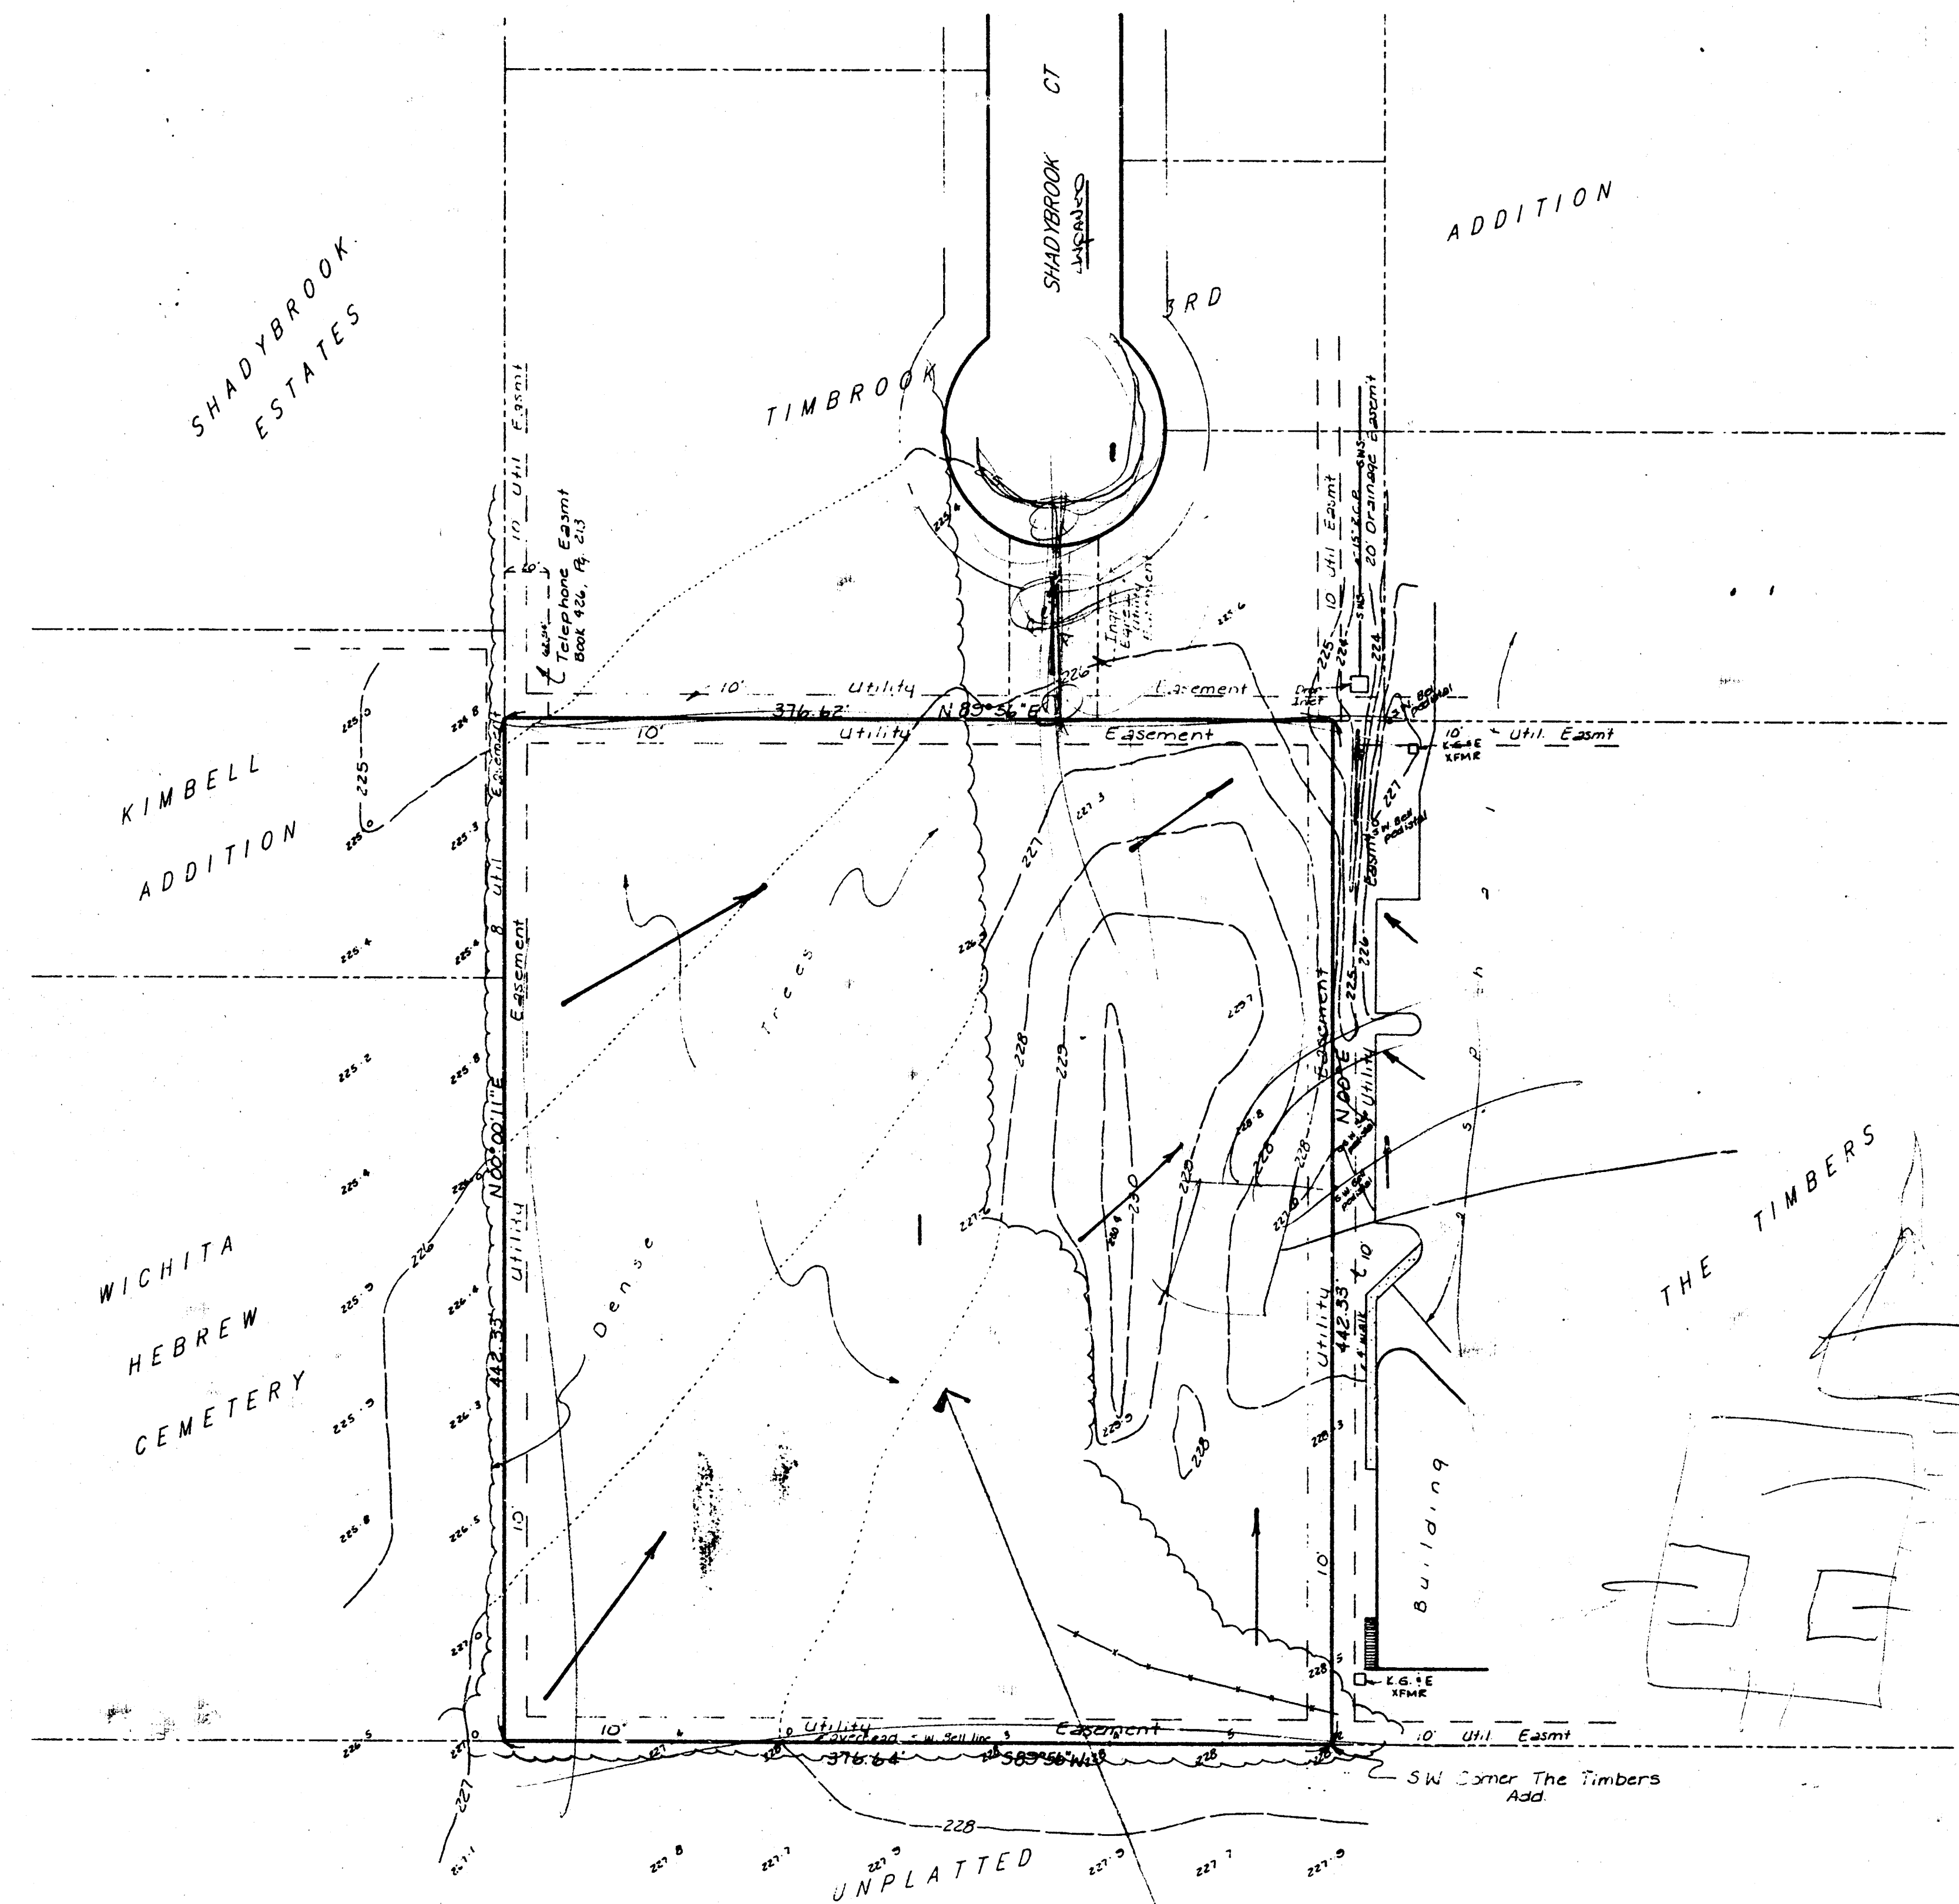

DA 28 ac 0.00
Pc 43 qd
Pw 88 qb

Note - This lot is to be developed as a small church chapel
site - Very little of the area will be paved. Runoff
Runoff factor = 0.30. Runoff will be directed to the
center of lot to an existing storm sewer and drainage
into utility & to drainage easement to street.

DRAINAGE PLAN

BAUGHMAN COMPANY P. A.
SURVEYING & ENGINEERING
316/267-7271 • 315 ELLIS • WICHITA, KANSAS 67211