


THUNDERBIRD 4TH ADDITION  
(Drainage)

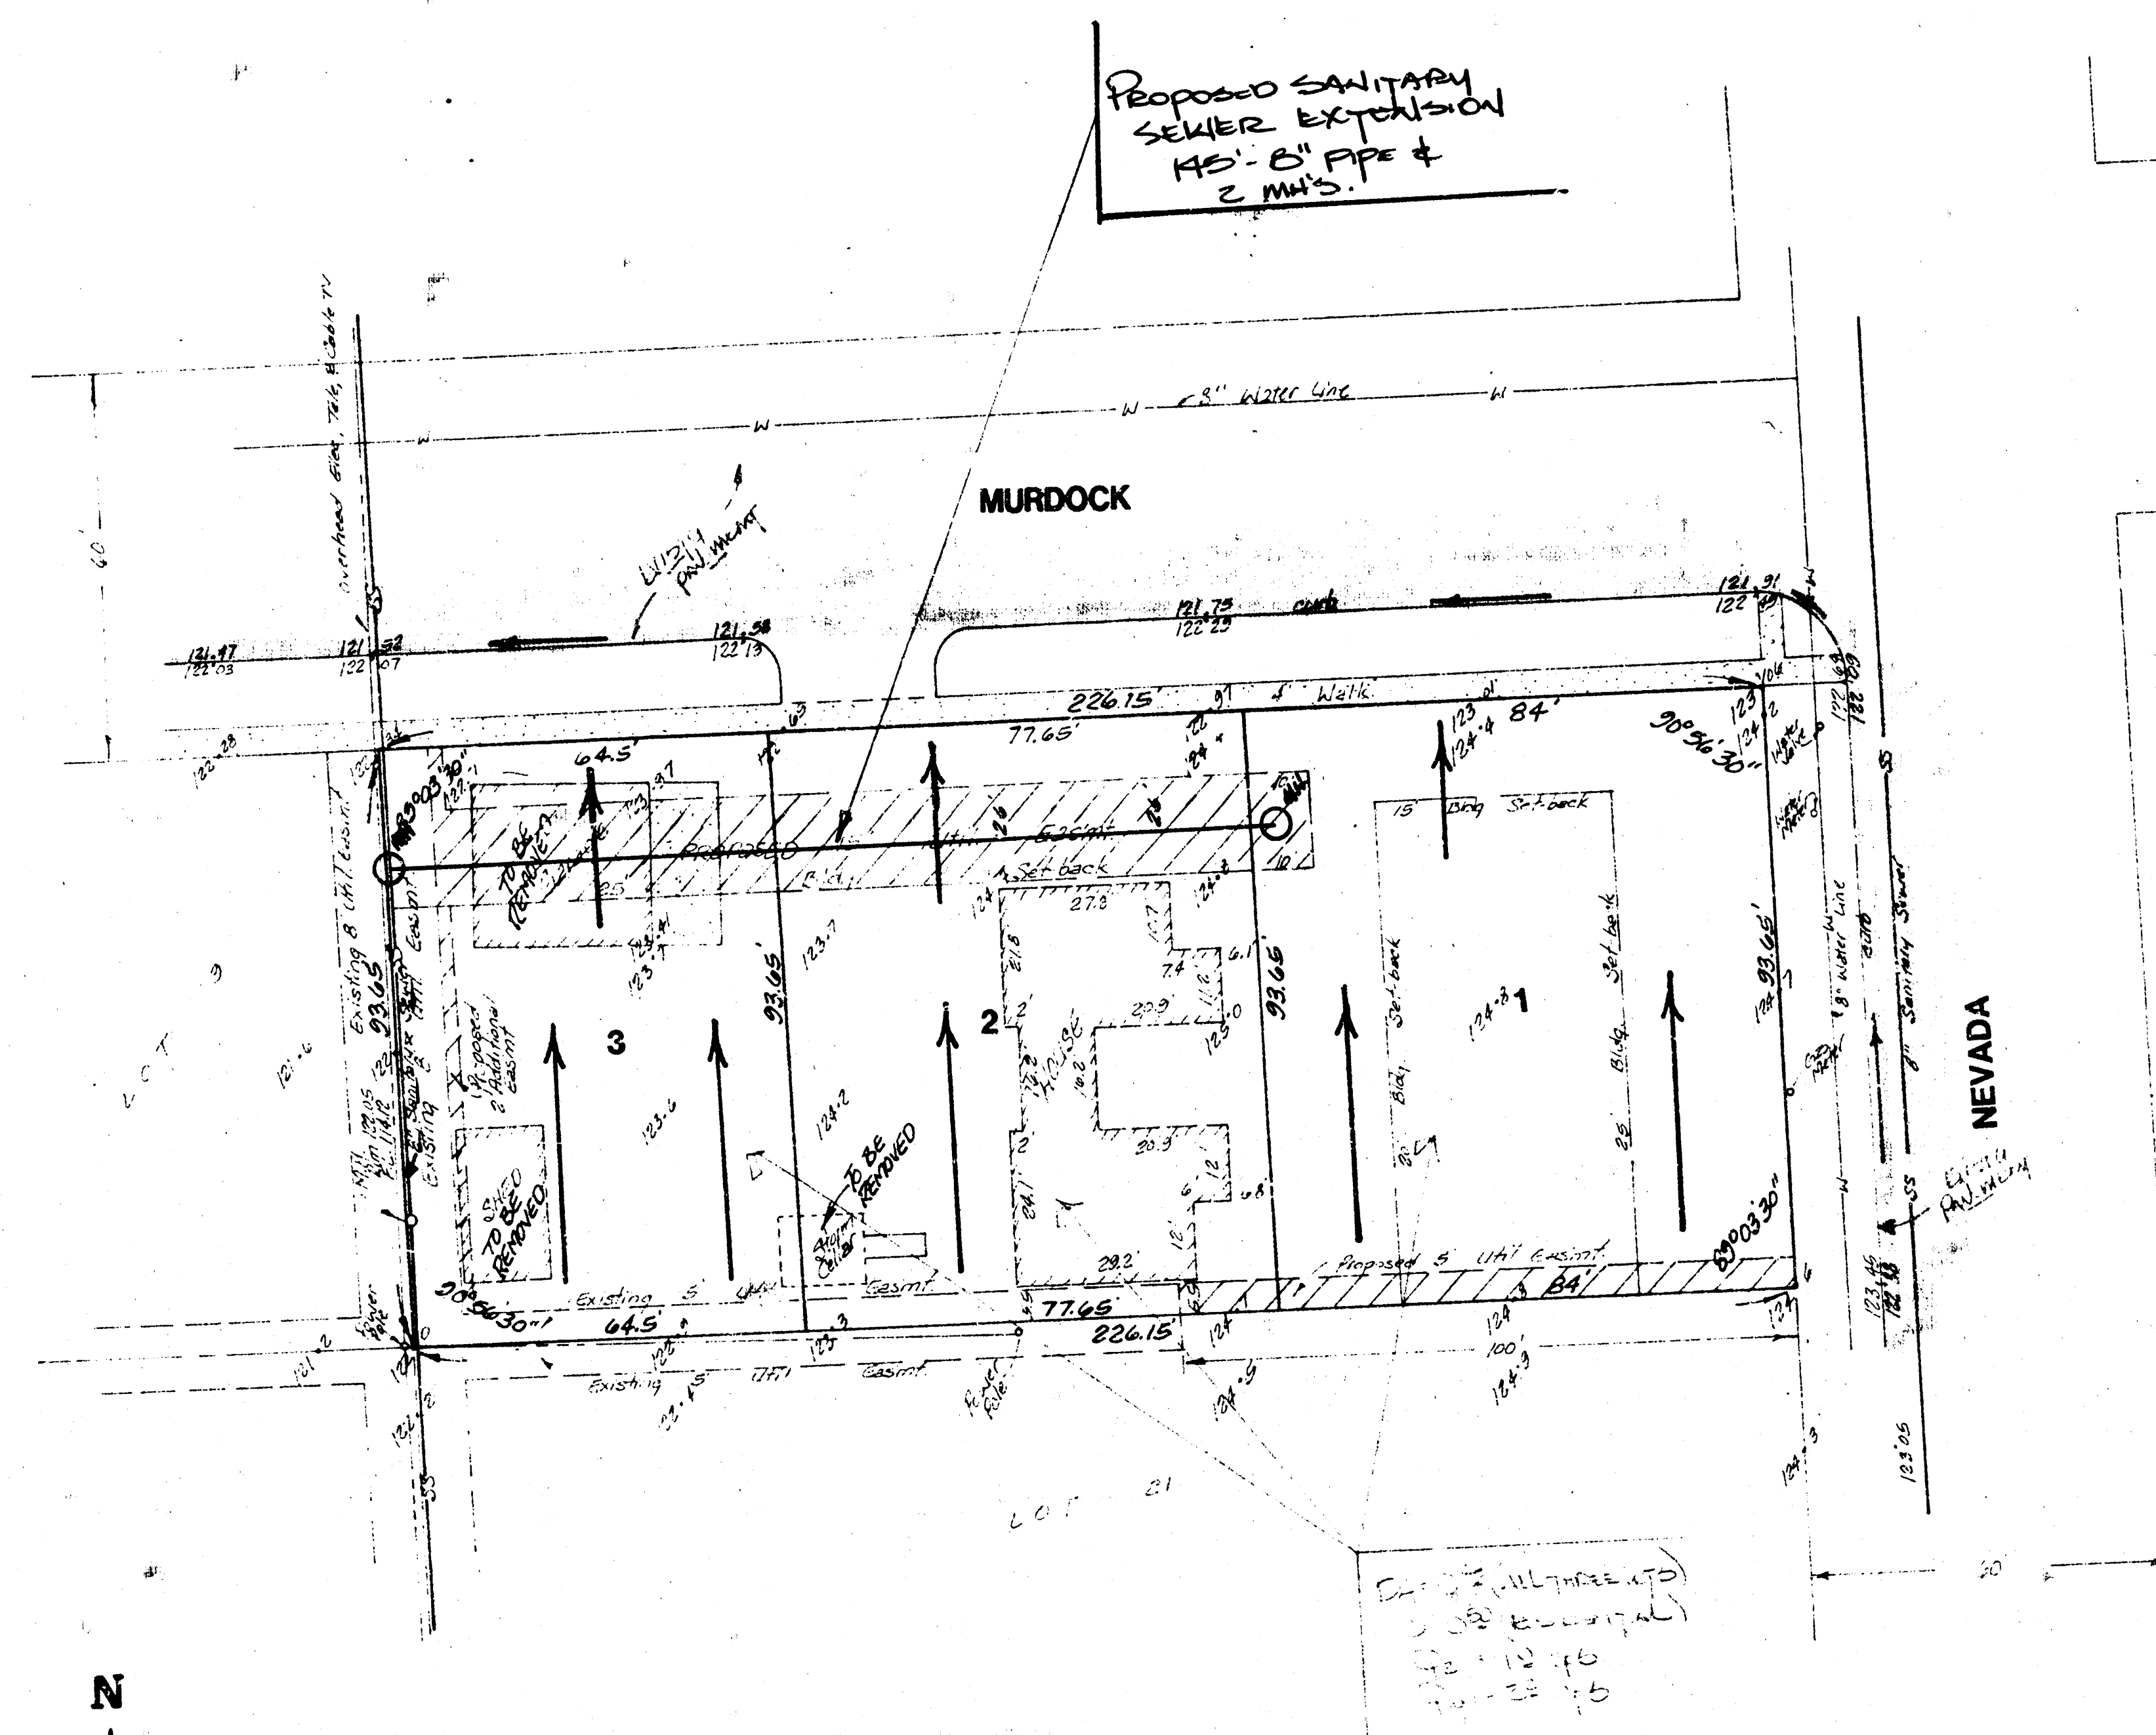

SKETCH PLAT  
**THUNDERBIRD 4TH ADDITION**  
LOT 22, REPLAT OF LOTS 3, 4, 5, 6, 7, 8, 9, CENTRAL  
PLACE ADDITION, SEDGWICK COUNTY, KANSAS.

OWNER: DAVID W. ENTRIEN

**DRAINAGE PLAN** C-1-85



1" = 20'  
ELEV. = CITY DATUM

SEWER MARK:  
CH. Standard Dev. 14.5 ± 0.2 W of E. corner of  
E. 24th St. N.  
Elev. = 121.83 City Datum

SEWER MARK: (CH.)  
W. corner over iron at S.W. cor. of  
Murdock & Nevada  
Elev. = 123.02 City Datum

**GENERAL NOTES**

The lots in this plat are to be residential lots with a runoff factor of 0.50 used in the calculations. The lots when developed will drain north to the pavement on Murdock which drains to the west. Discharge to the street will be thru driveways.

**BAUGHMAN COMPANY, P.A.**  
SURVEYING & ENGINEERING  
316-262-7271 • 300 LAURA • WICHITA, KANSAS 67211

MAY 25