



Timber Grove Lakes 2nd

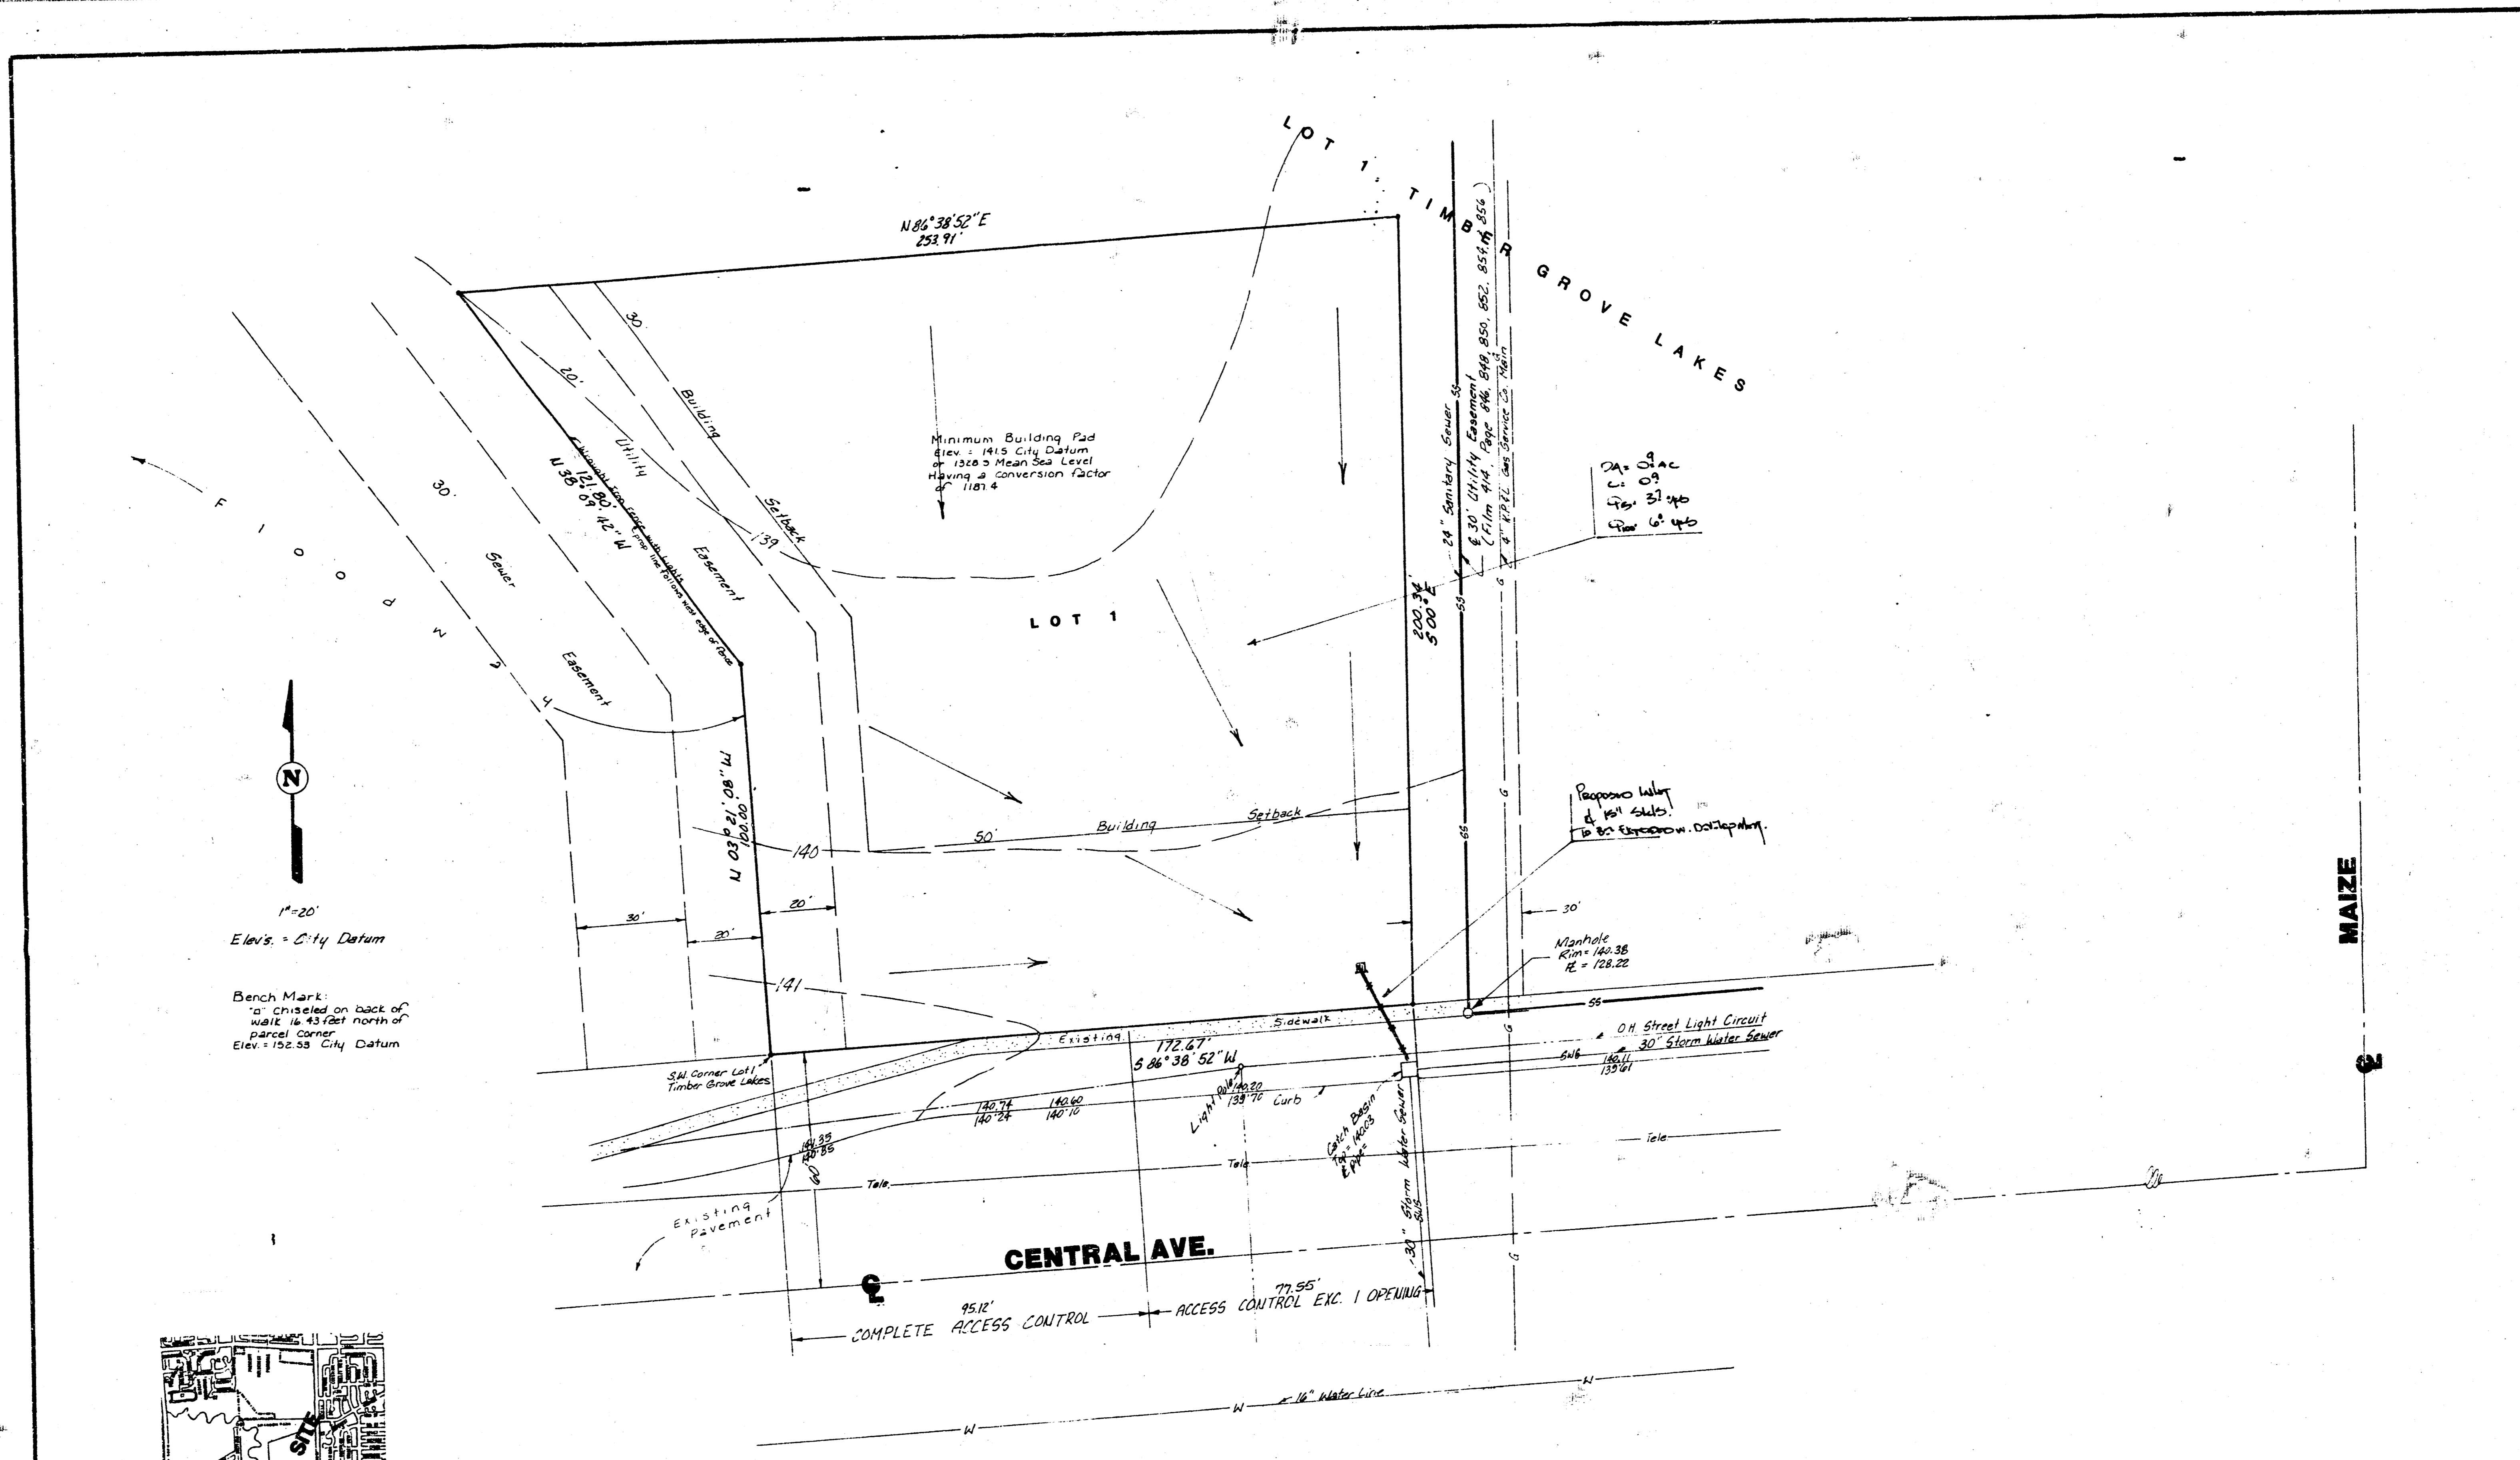

1"=20'
Elev's. - City Datum

Bench Mark:
"B" Chiseled on back of
wall 16.43 feet north of
parcel corner
Elev. = 152.35 City Datum

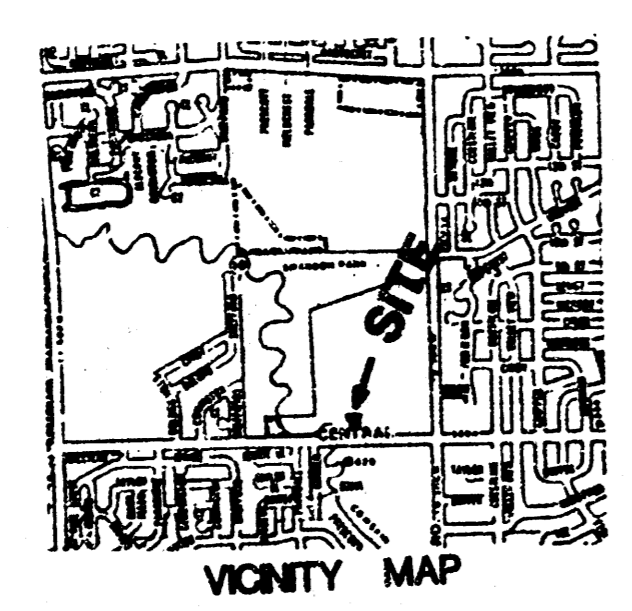

SKETCH PLAT
TIMBER GROVE LAKES 2ND ADDITION

REPLAT OF PART OF LOT 1, TIMBER GROVE LAKES,
AN ADDITION TO WICHITA, KANSAS

Contract Purchaser: Jerry Loftis

DRAINAGE PLAN

BAUGHMAN COMPANY, P.A.
SURVEYING & ENGINEERING
316268-7211 - 315 ELLIS - WICHITA, KANSAS 67211

Topo done - Nov 17, 1987

Oct 20, 1987