


SKETCH PLAT TRACTMAN 2ND ADDITION

WICHITA, SEDGWICK COUNTY, KANSAS

LOTS 2 AND 3, TRACTMAN ADDITION
BERNARD H. TRACTMAN

SERVICE, INC.

THOMAS A. BISHOP, PRESIDENT
WICHITA, KANSAS 67214
TEL 265-7558

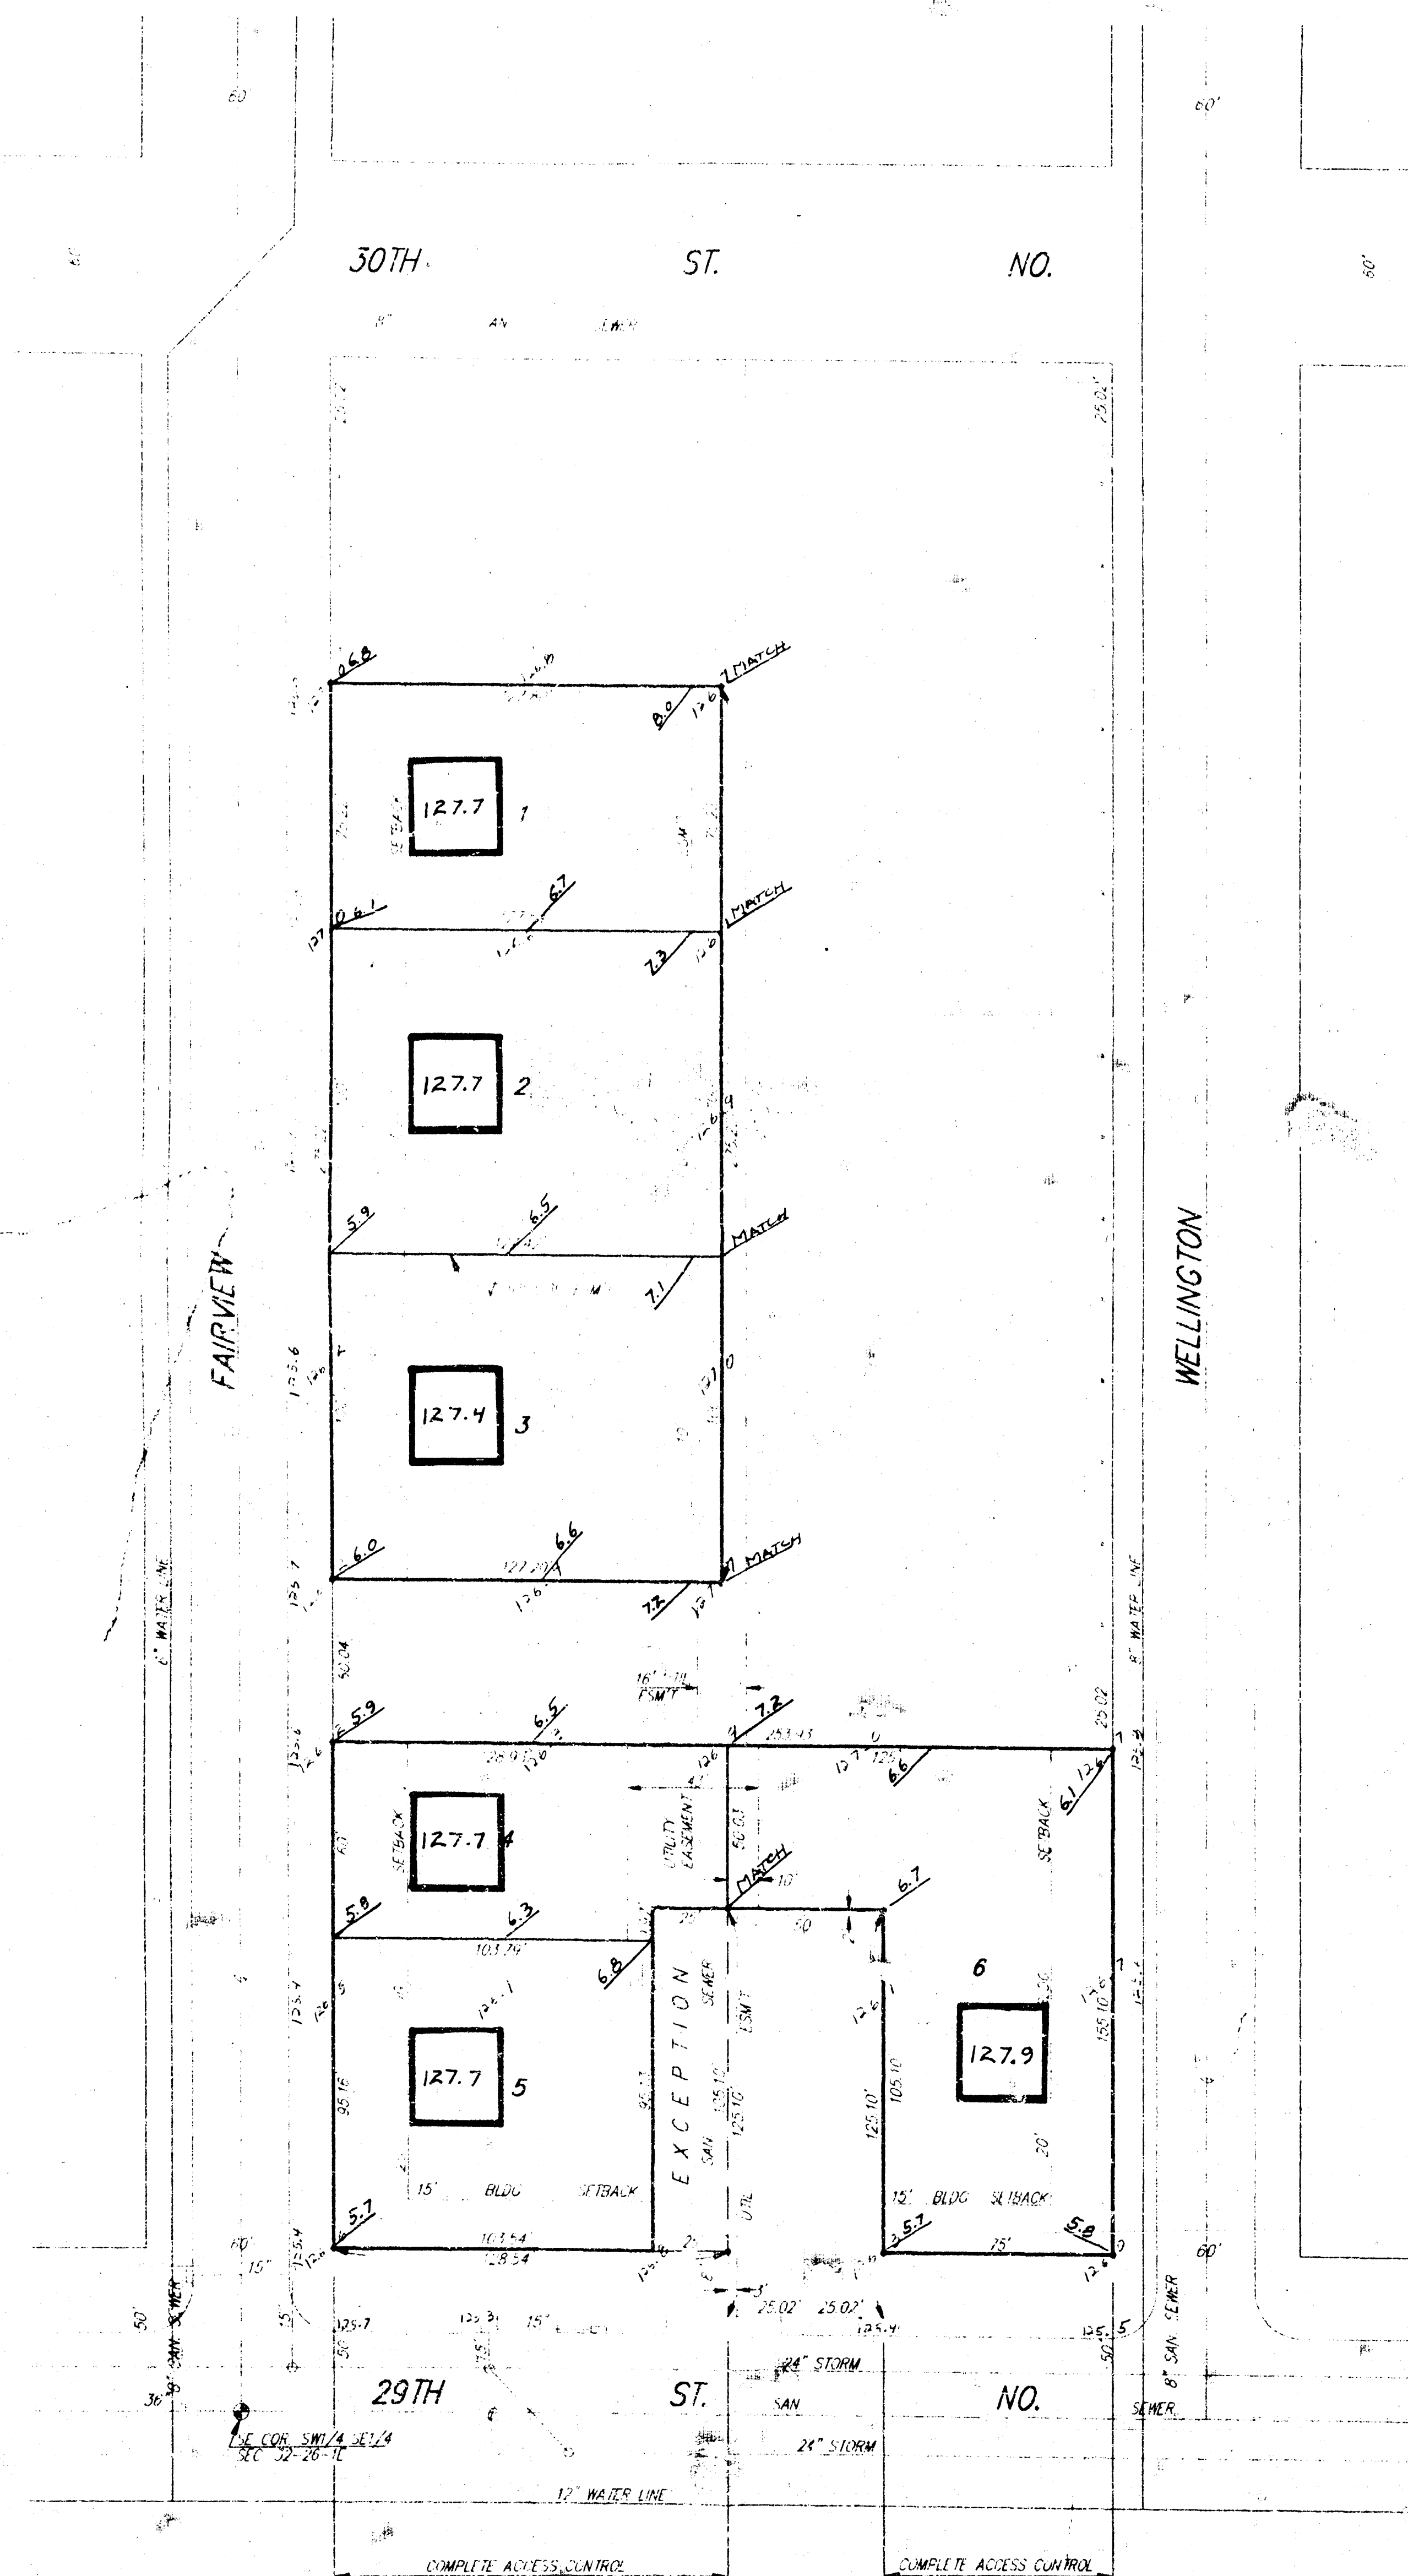

Lot Grading Plan
Oct. 26. 93

**APPROVED
DRAINAGE PLAN**



BAUGHMAN COMPANY P. A.
ENGINEERING & SURVEYING
315/262-7771 • 315 ELLIS • WICHITA, KANSAS 67211

17 NOV 1992


SKETCH PLAT TRACTMAN 2ND ADDITION

WICHITA, SEDGWICK COUNTY, KANSAS

LOTS 2 AND 3, TRACTMAN ADDITION
BERNARD H. TRACTMAN
& FLORENCE TRACTMAN

MEMORIAL HOUSING REHABILITATION
SERVICE, INC.

THOMAS A. BISHOP, PRESIDENT
2145 N. TOPEKA
WICHITA, KANSAS 67214
PH: 265-7558

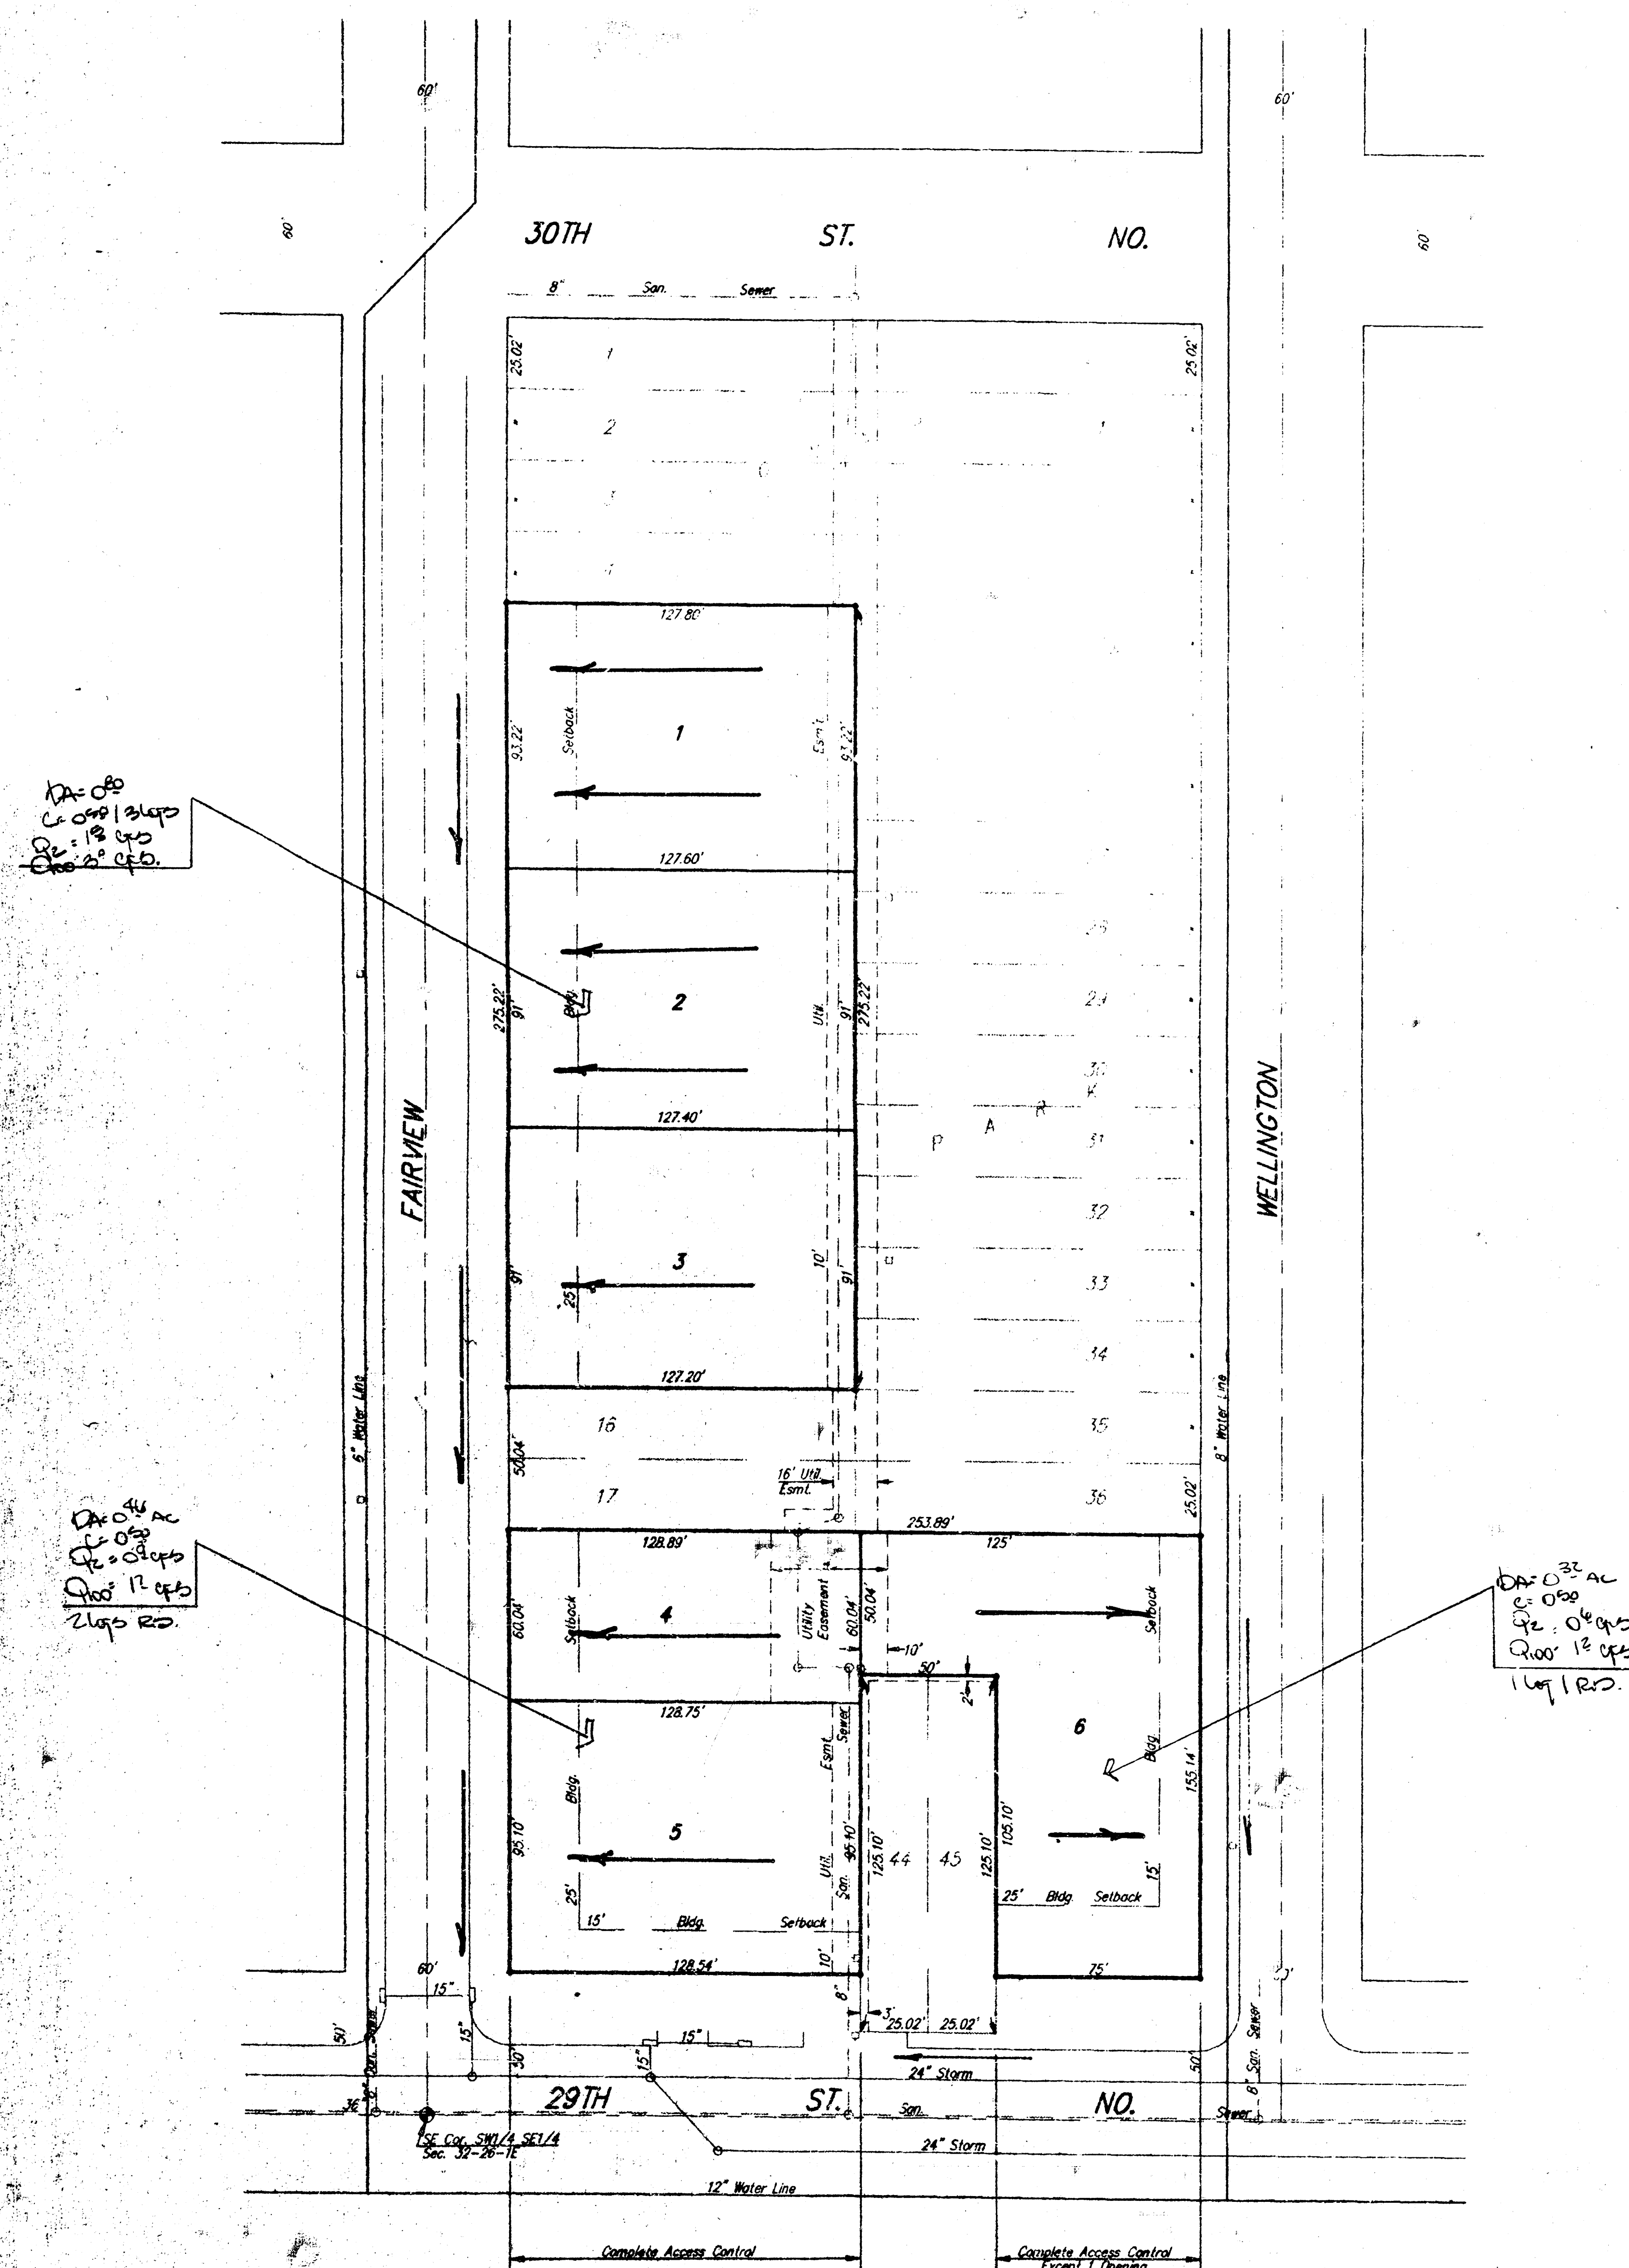

Scale: 1" = 40'
G.M. - Top Iron in
Thumb - 4 29th &
Fairview - E1 125.47

DRAINAGE & UTILITY PLAN

BAUGHMAN COMPANY P. A.
ENGINEERING & SURVEYING
316/262-7271 • 315 ELLIS • WICHITA, KANSAS 67211

24 SEP 92