



S. VOGE ADDITION  
(Drainage)

3RD. ST.

N

1" = 30'  
ELEV. CITY DATUM

BENCH MARK  
City Standard Disc 34" W & 18" S  
of E. West St. & 2nd St.  
Elev. = 118.87 City Datum

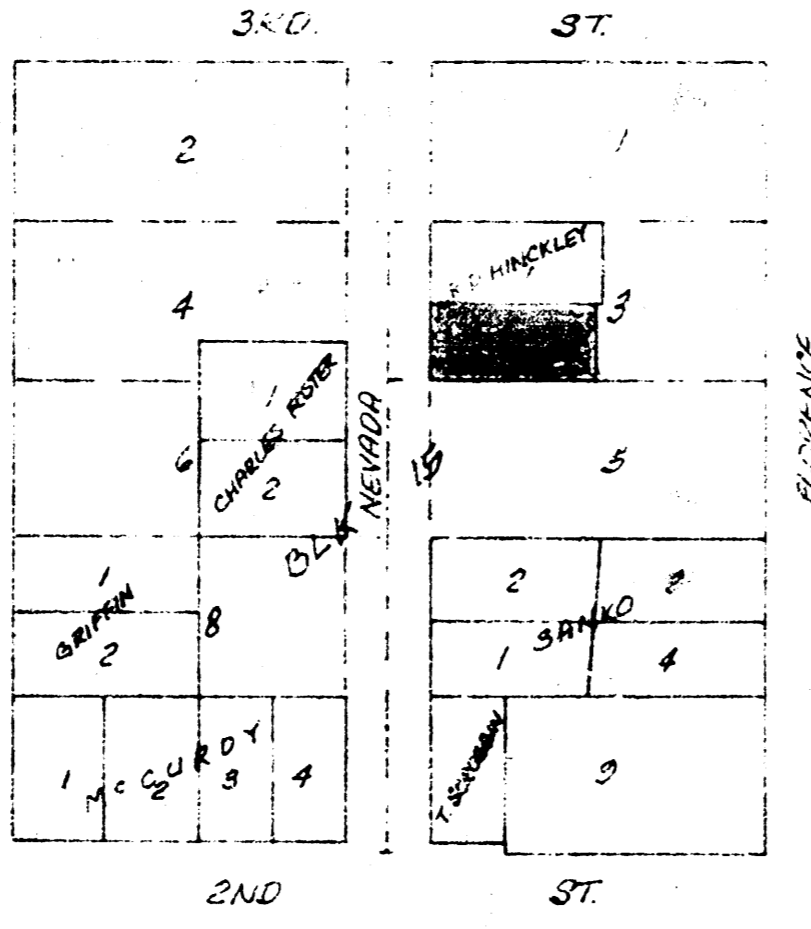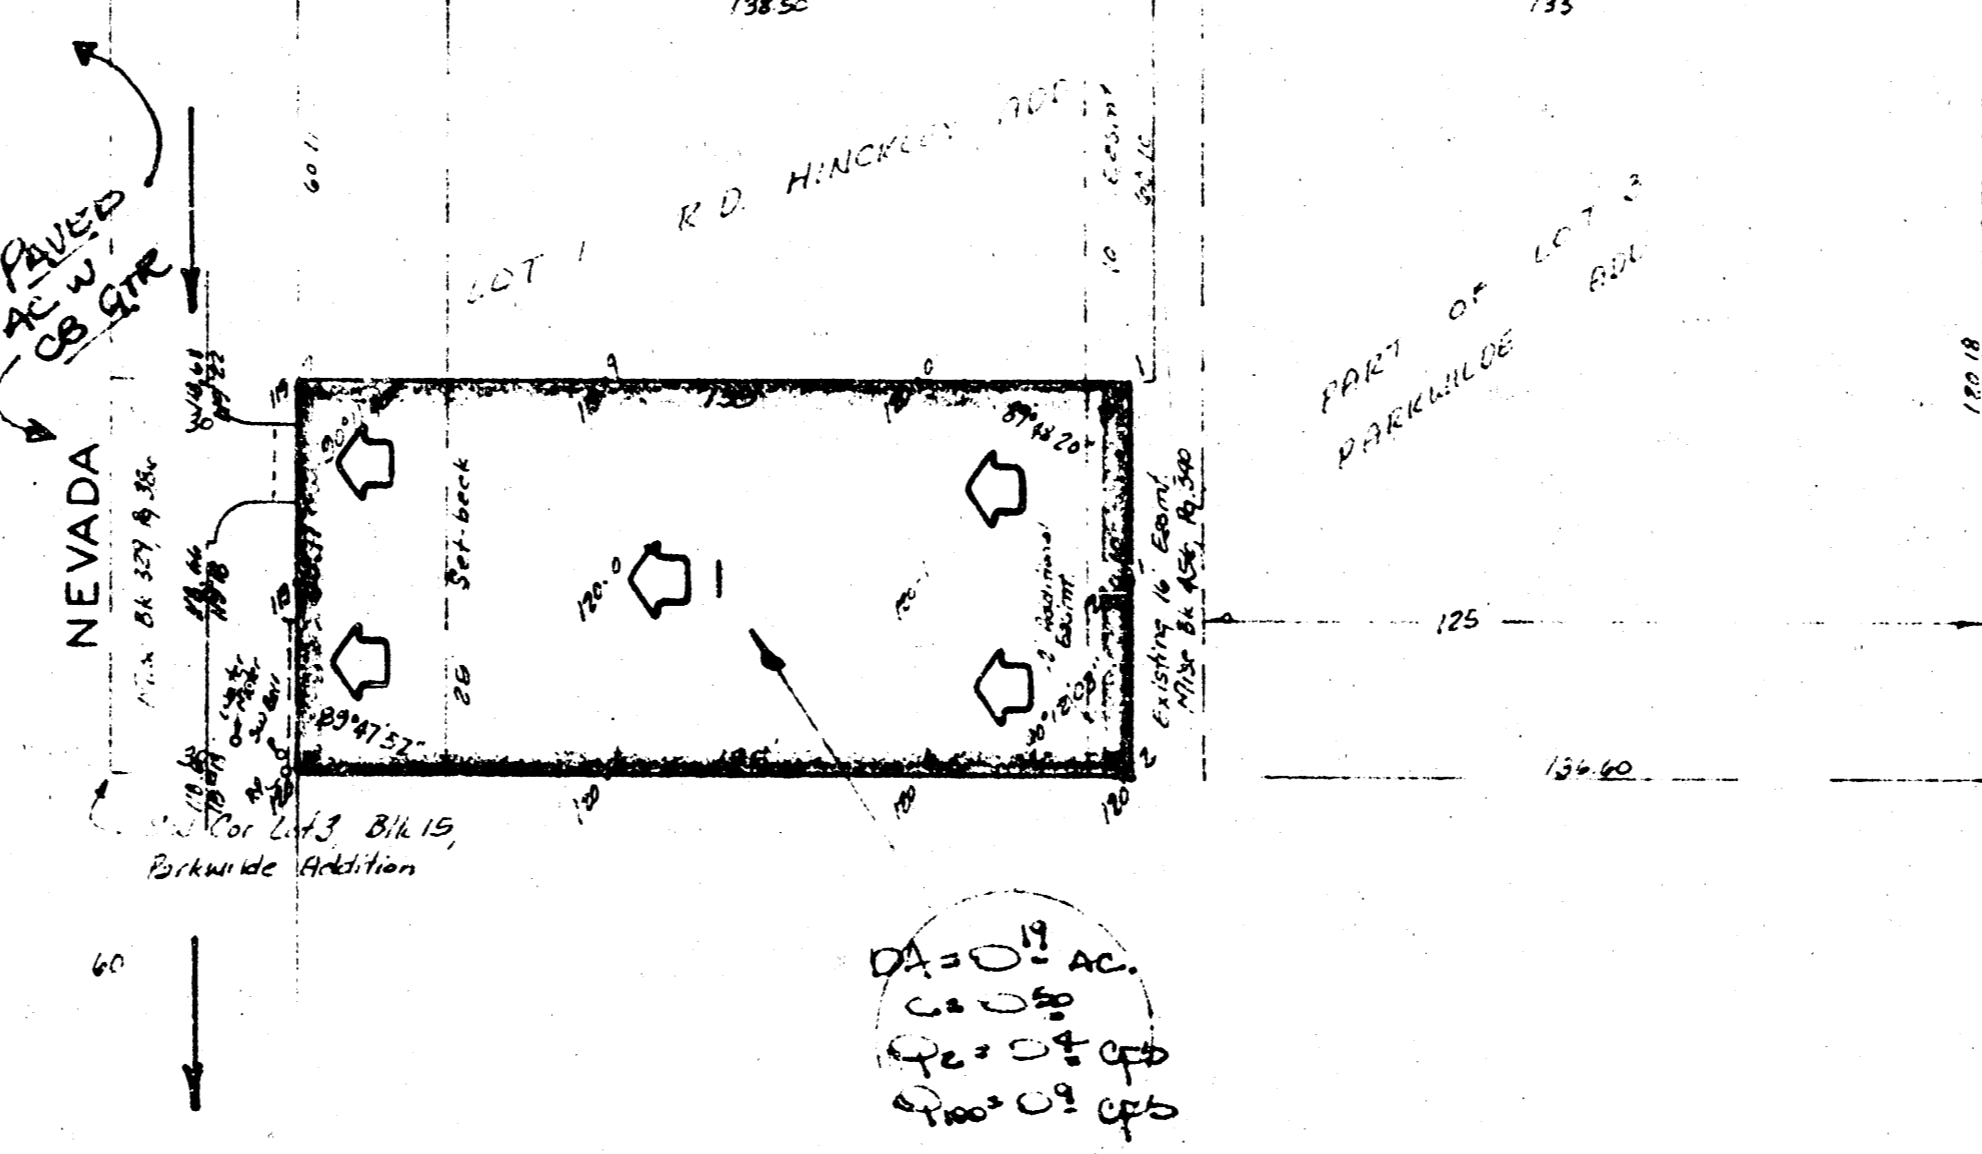

### SKETCH PLAT VOGE ADDITION

THE WEST 165 FEET OF THE S 1/2 OF LOT 3,  
BLOCK 16, PARKWILDE ADDITION, TO THE CITY  
OF WICHITA, SEDGWICK COUNTY, KANSAS.

SID VOGEL

### DRAINAGE PLAN

BAUGHMAN COMPANY, P.A.  
SURVEYING & ENGINEERING  
316.262.7271 • 1301 LAURA • WICHITA, KANSAS 67211

23 MAR 94