


Barbed Wire Associates, a Kansas General Partnership
 _____ by Robert C. Foster, Partner
 Robert C. Foster
 _____ by Charles Associates, Partner
 Charles Associates, Partner
 _____ Leonard E. Marotte, Partner
 Leonard E. Marotte
 _____ Leonard E. Marotte, Partner
 Leonard E. Marotte, Partner

WICHITA, SEDGWICK COUNTY, KANSAS.

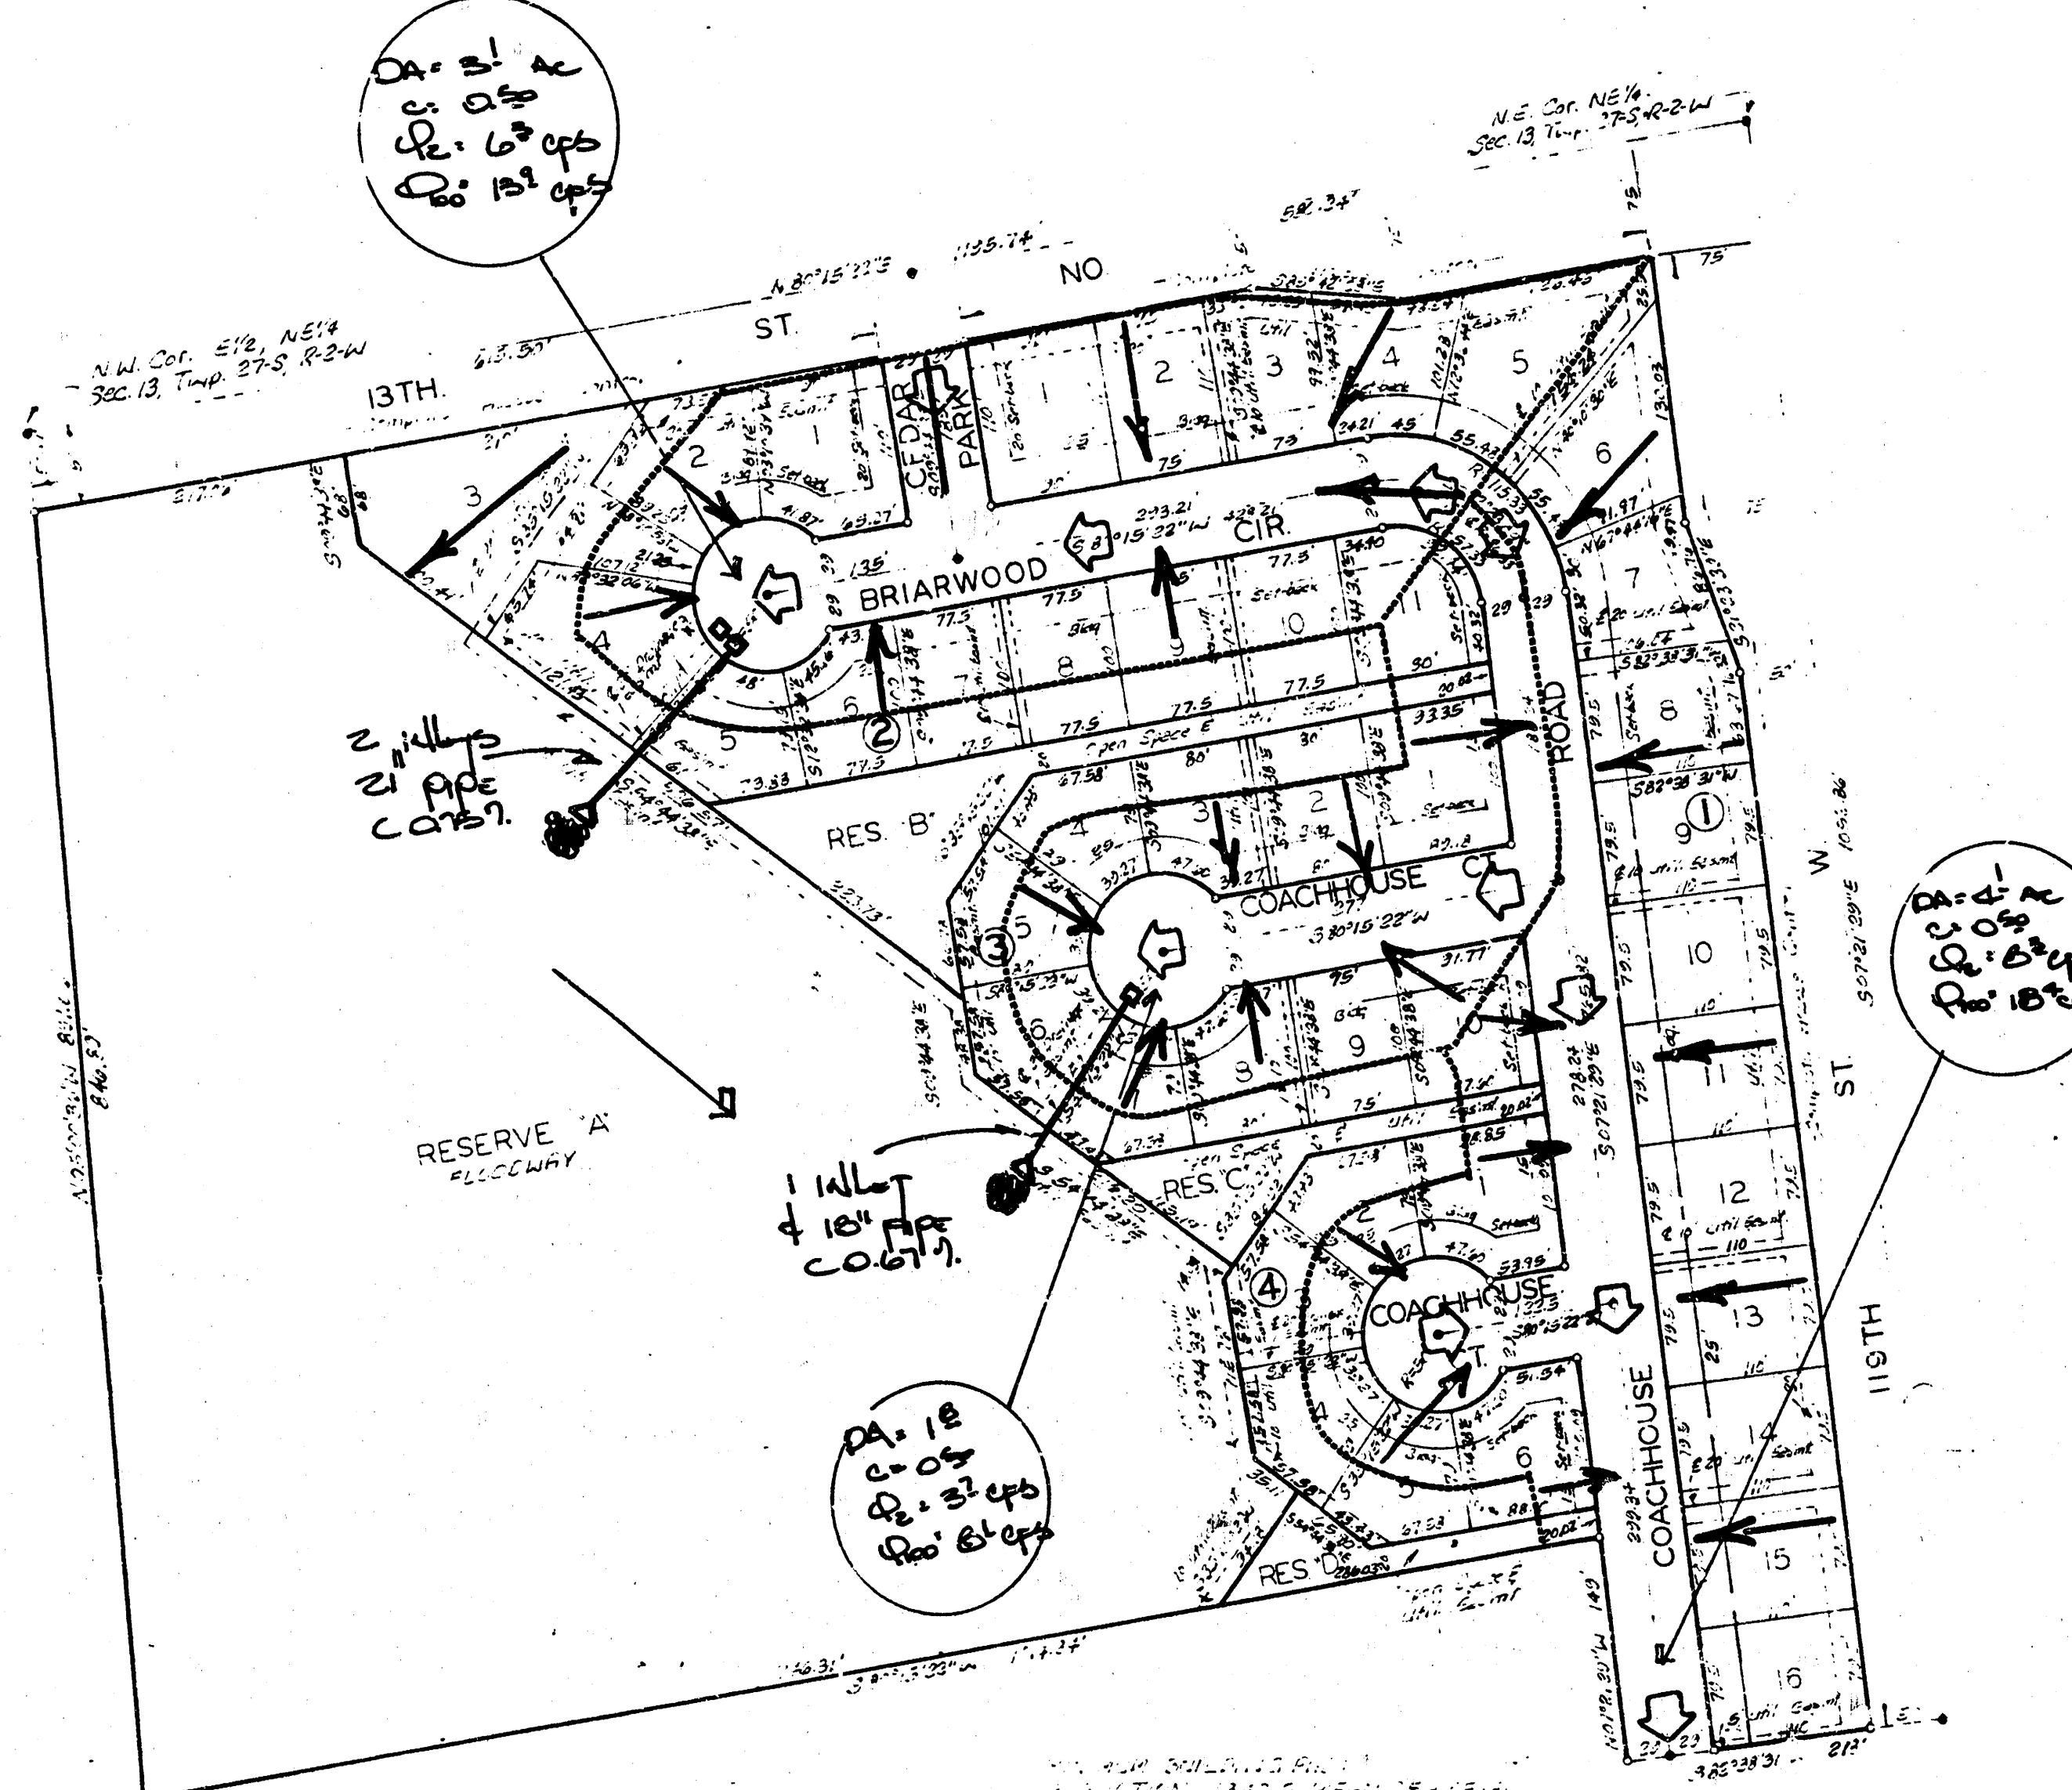

WALNUT CREEK ADDITION
(DRAINAGE)

Walnut Creek Adobe

A) Drainage plan acceptable. Need guarantee of SWS.

lots still extend into floodway
Rear lot lines should conform
to floodway boundaries.

Requires offsite drainage easement
to drain Cooshoouse Road south
to creek

B) SS layout acceptable (extend ^{Brown}
 (Browned also very close) down from east
 Bldg set back = waiting 2 weeks B/LK 12.3.9; etc.
 * Request action! R/W on SS 13th

- * near bridge
- * lot 3 frontage (14.8' at creek)
- * Change platons text to read "appropriate governmental agency"

BAUGHMAN COMPANY, P.A.
SURVEYING & ENGINEERING
316/262-7271 • 330 LAURA • WICHITA, KANSAS 6721

PROJECT WALNUT CREEK AODN

JOB NO. _____

FROM B. Wooten

REFERENCE FINAL DRAINAGE PLAN

**CONFIRMATION
MEMO**

DATE 2-15-64

COPIES TO

Loops will drain according to plan enclosed. Storm sewers will be necessary for two culvert sacs. We would like to grade the small culvert sac easy to delete the storm sewer. & easy. Storm sewer sizes and inlays are indicated. Residential lots with a runoff factor of 0.50.