



WESTWOOD HILLS ADDITION
(Drainage)

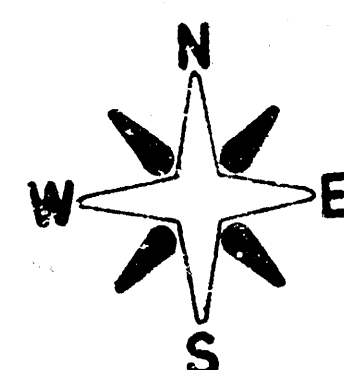

SCALE: 1"=60'

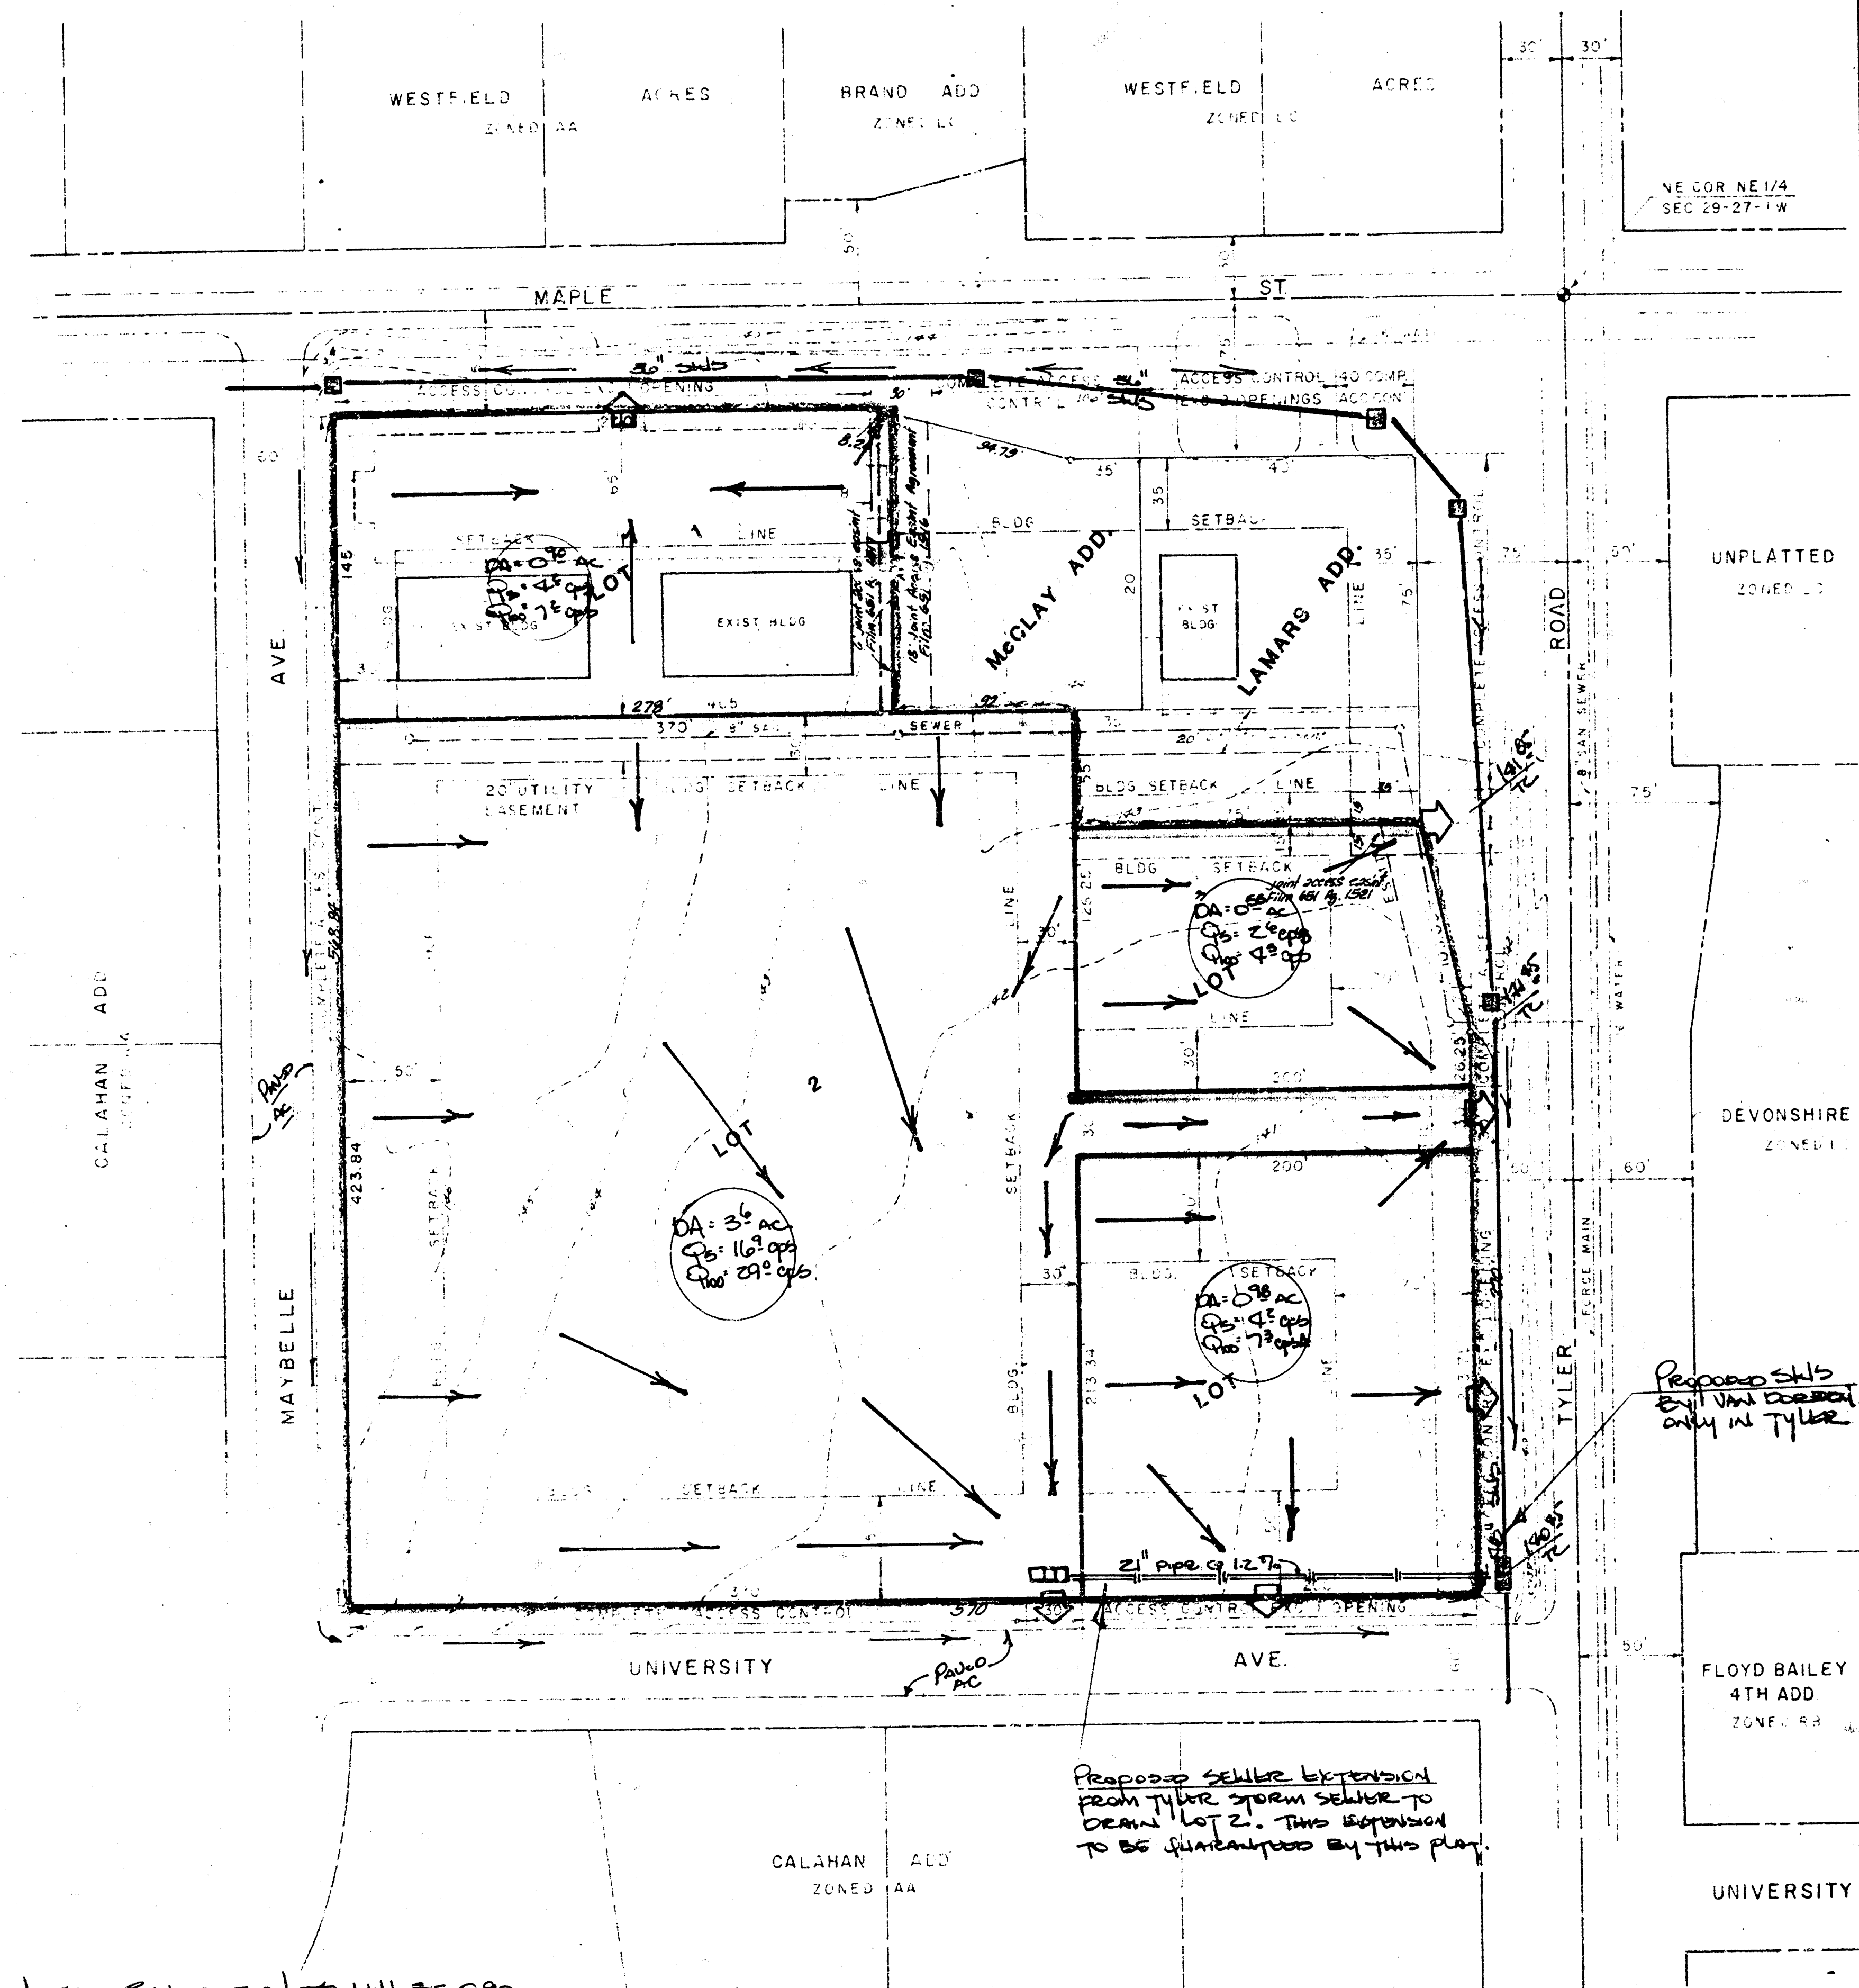

Notes: Runoff for lots will be 0.90.
Lots 1, 3 & 4 will drain to the street's thru drains or plungers.
Lot 2 will need to have storm sewer bypassed to the lot to pick up the 5 year storm flow runoff. The major storm runoff may flow into University thru the driveway and drain east to Tyler.
Proposed storm sewers & structures by VanDoren are indicated.

SKETCH PLAT
WESTWOOD HILLS ADDITION

PART OF BLOCK Z, CALAHAN ADDITION,
SEDGWICK COUNTY, KANSAS
OWNERS:
R. KELL HAWKINS and V. JERRY BLUE

DRAINAGE PLAN

BAUGHMAN COMPANY, P.A.
SURVEYING & ENGINEERING
318-262-7271 • 370 LAURA • WICHITA, KANSAS 67211

7-6-1994