



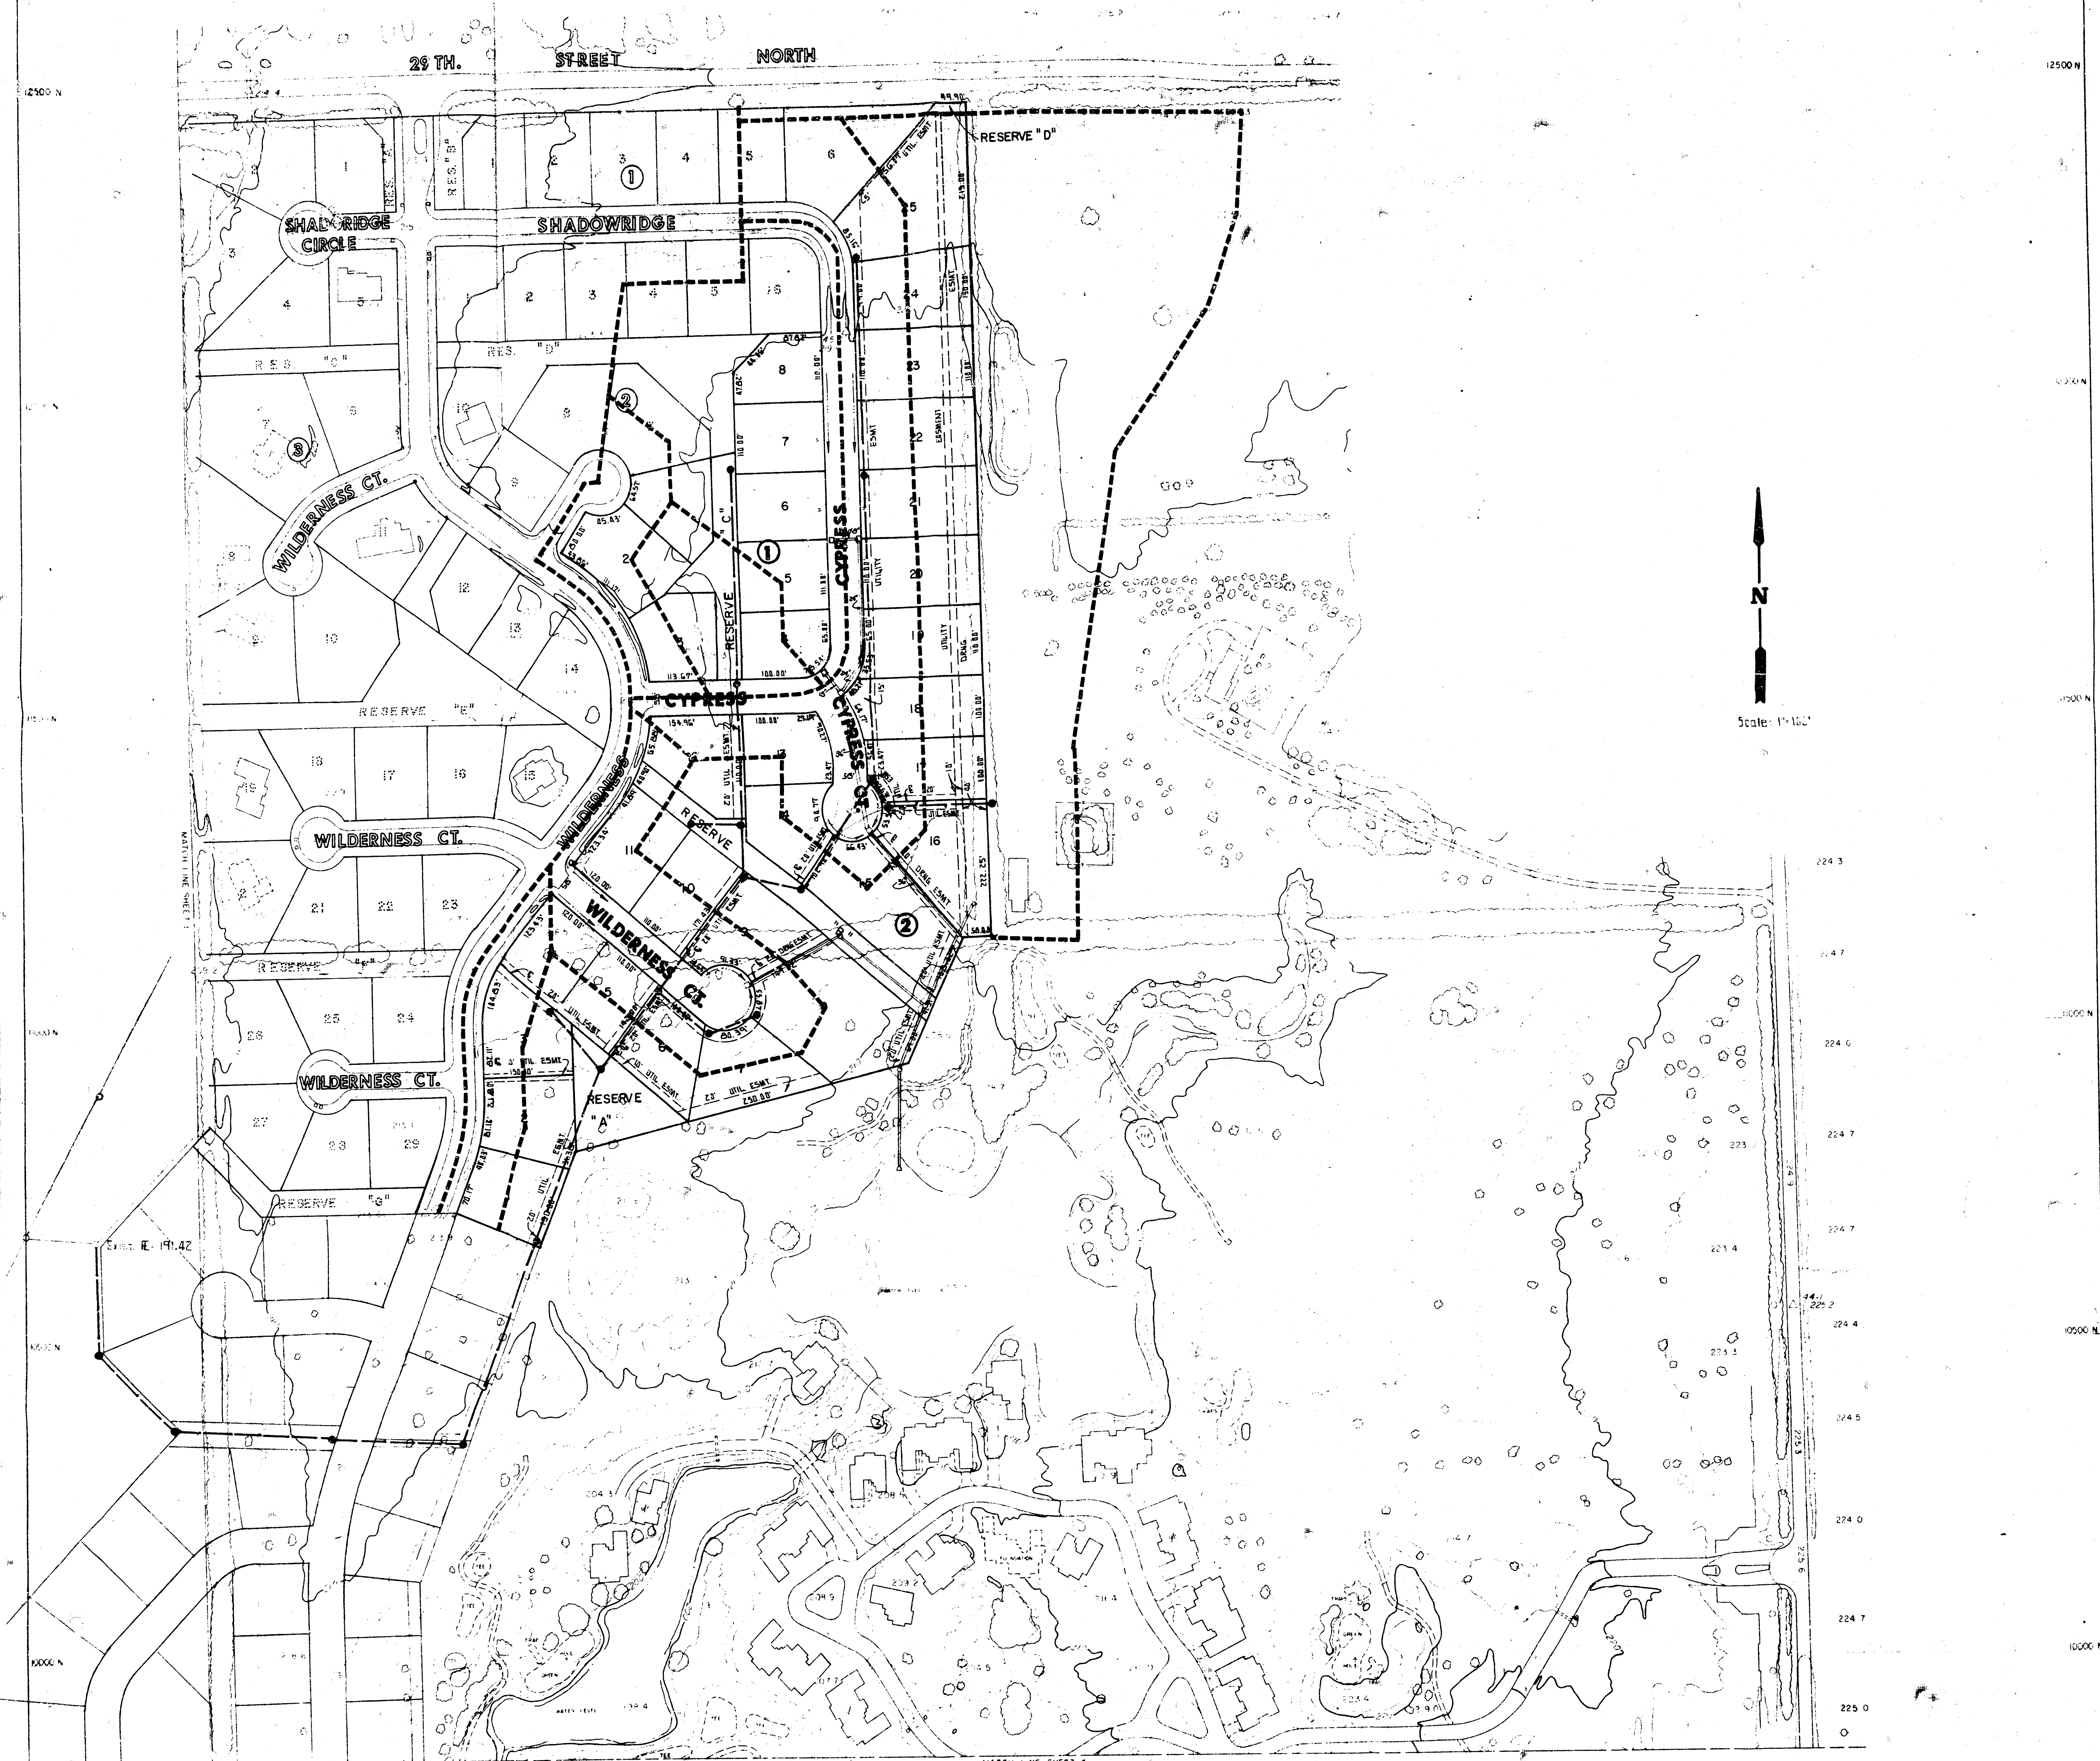

WILDERNESS SECOND

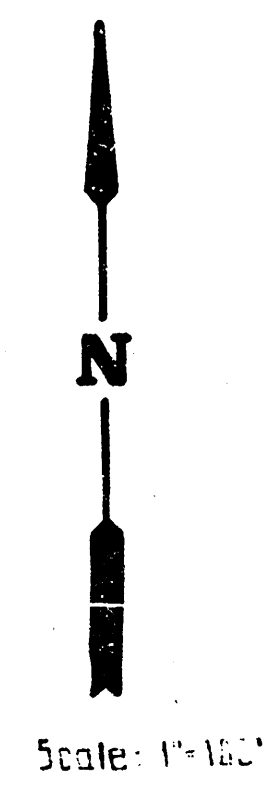


Revised
10/10/84

DRAINAGE PLAN

Drawn by: K.M.
Checked by: D.M.
Date: 10/10/84

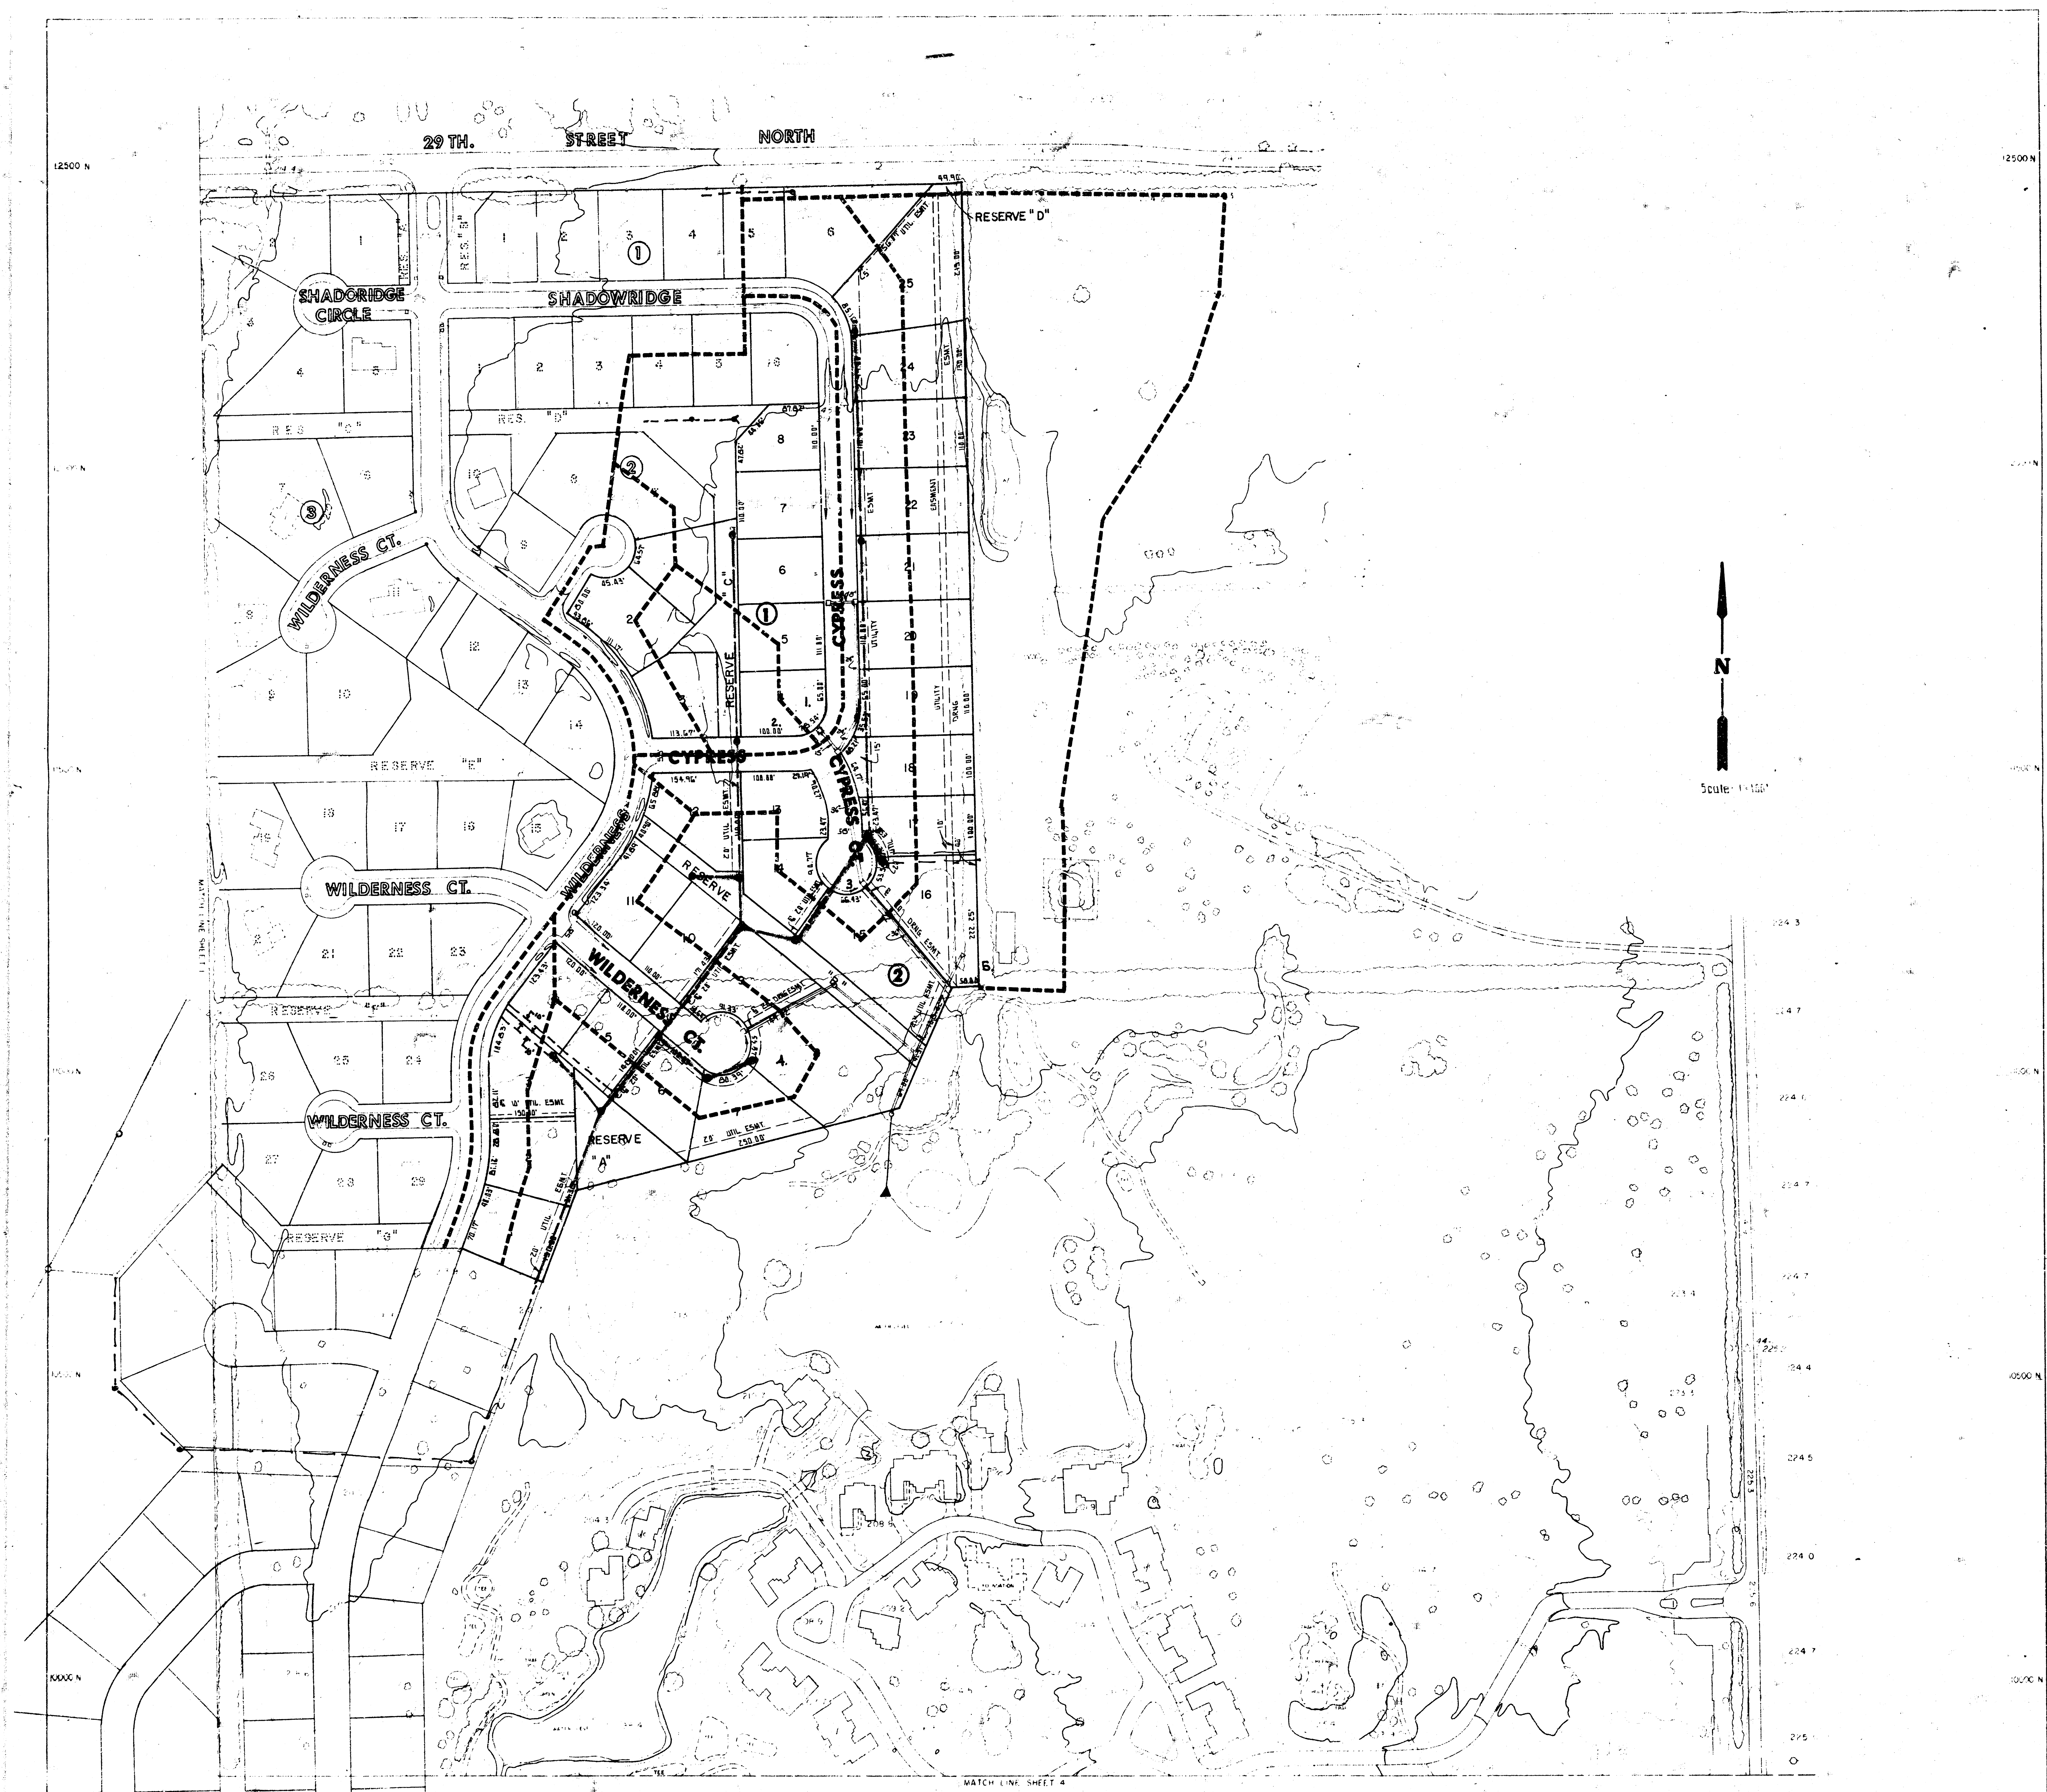

WILDERNESS SECOND

1. Drainage Plan should have information on Proposed R.O.S.W.s and Proposed T.C. Elevations.
2. Extend S.W.S. outlet directly to Lake.