



Jesse Williams Add'n

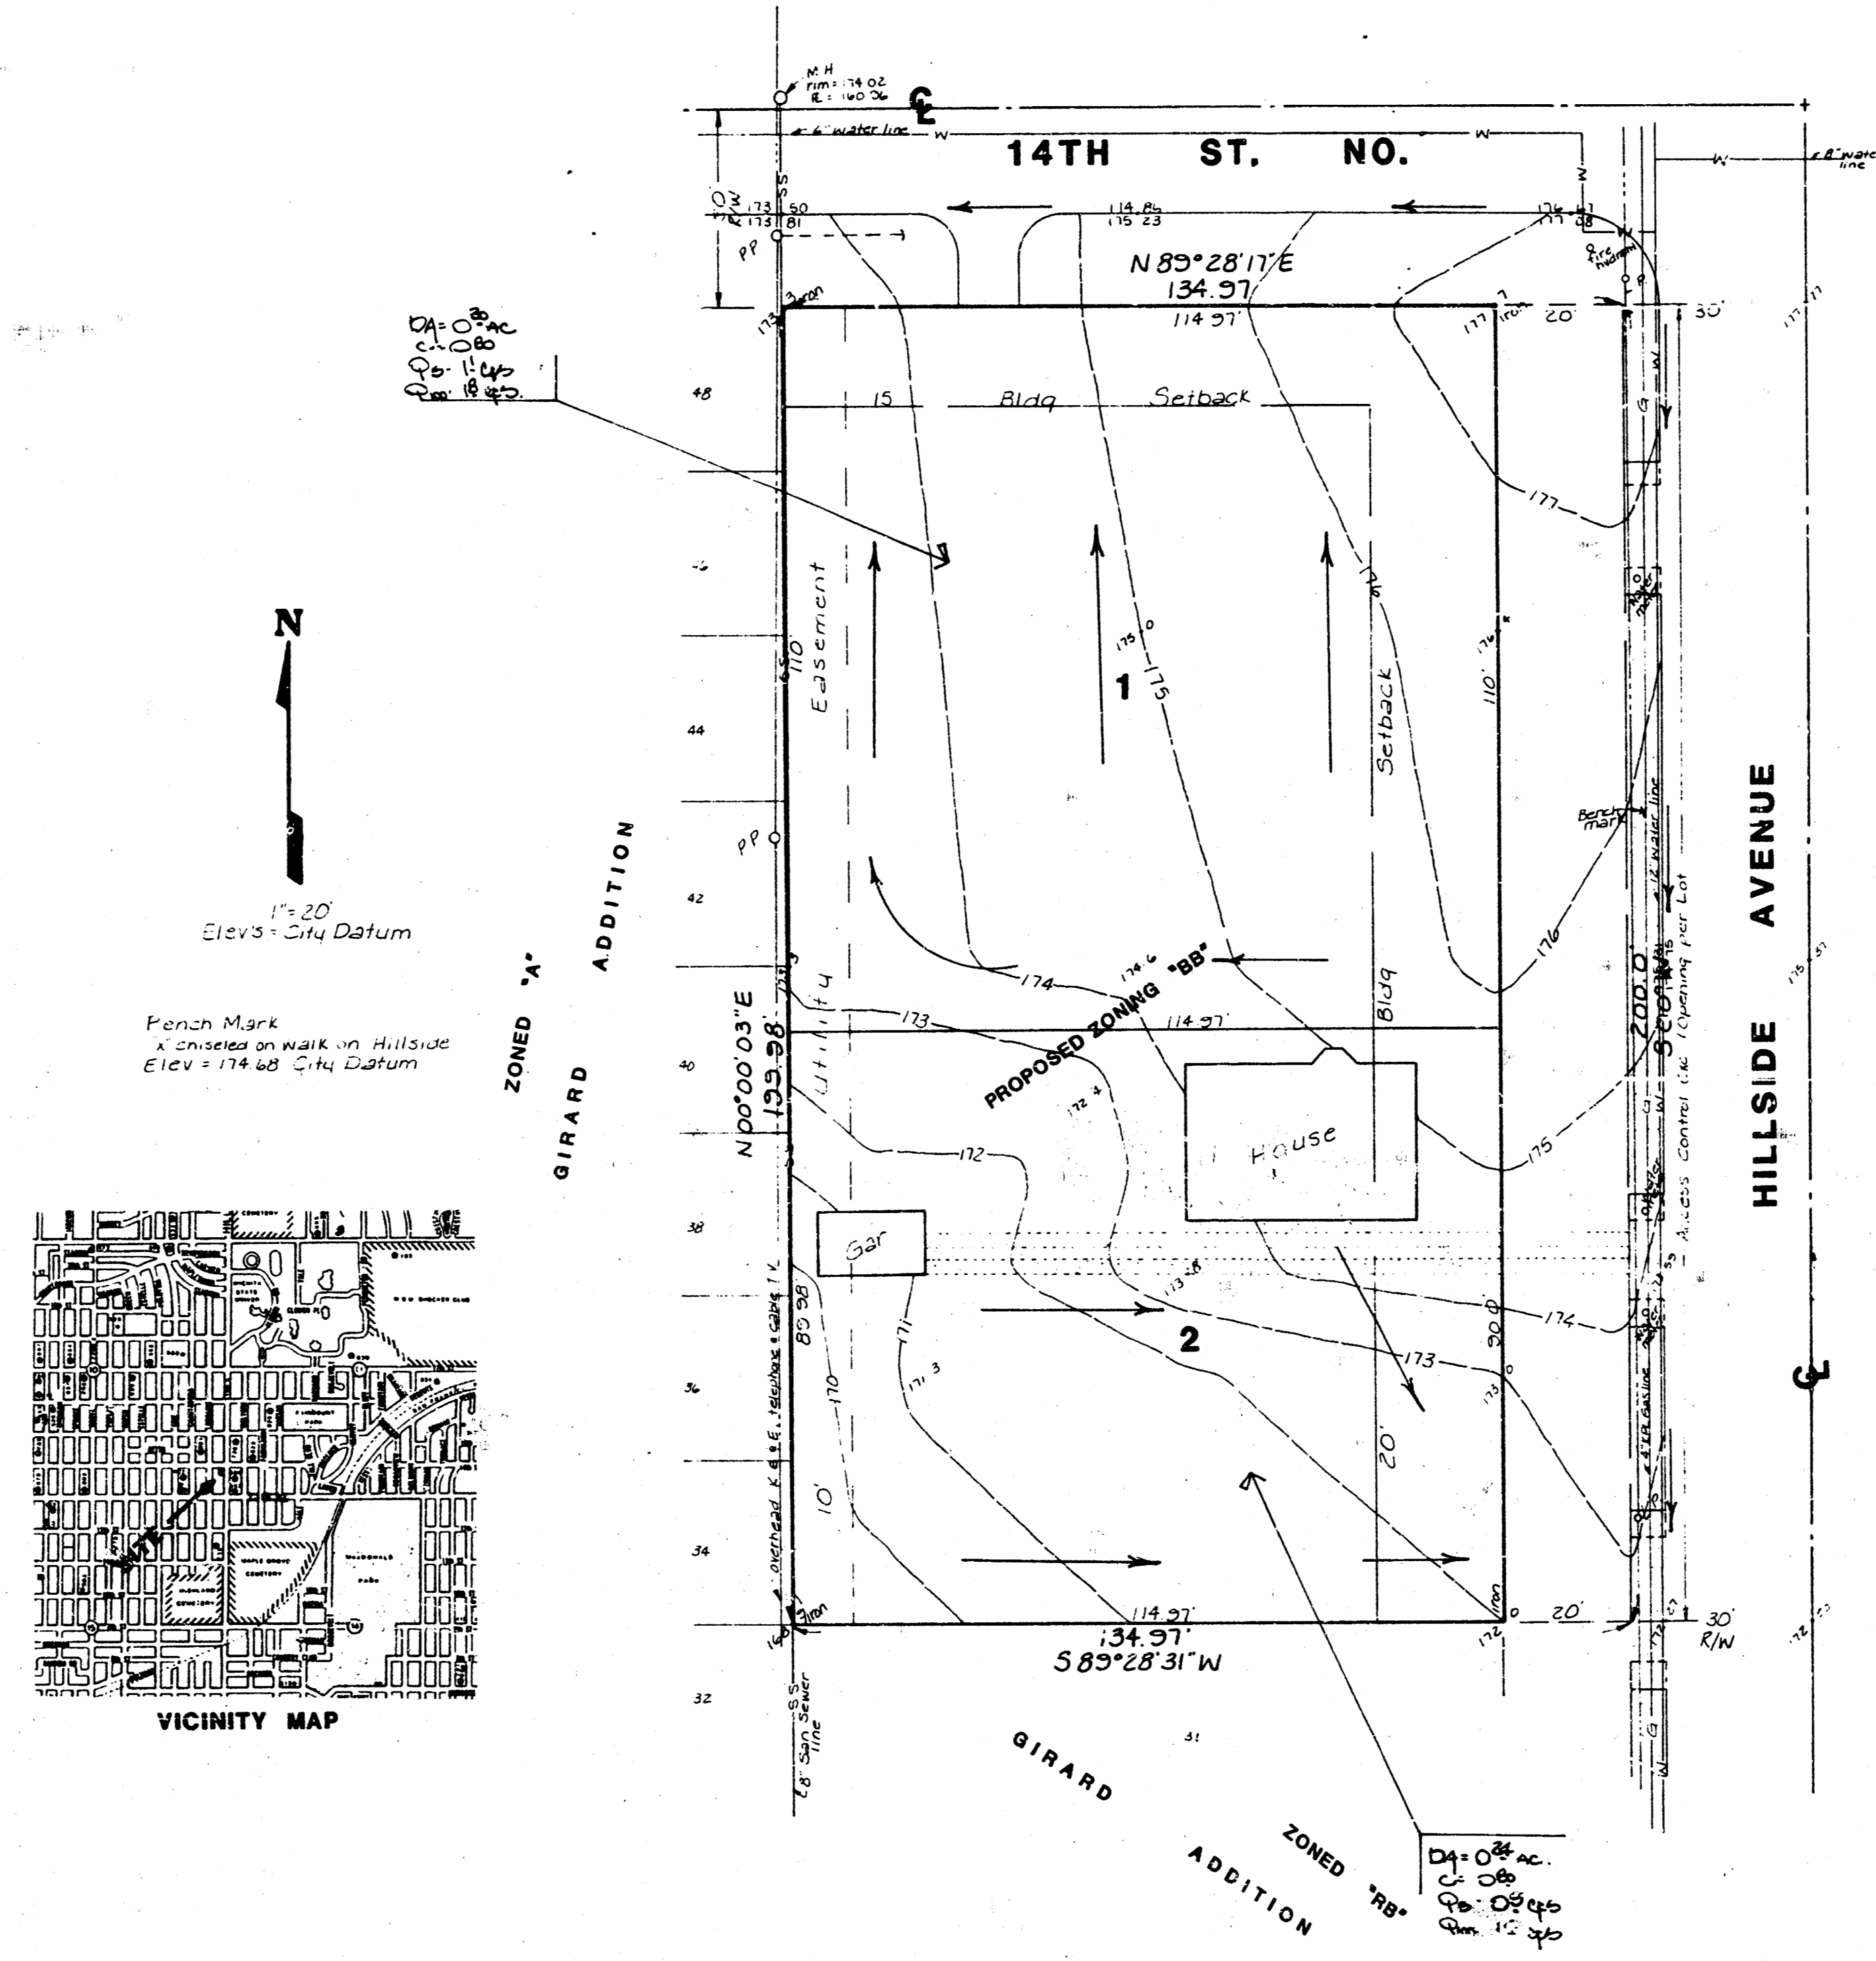

N
 Elev. = City Datum
 1" = 20'
 Bench Mark
 x on sidewalk on Hillside

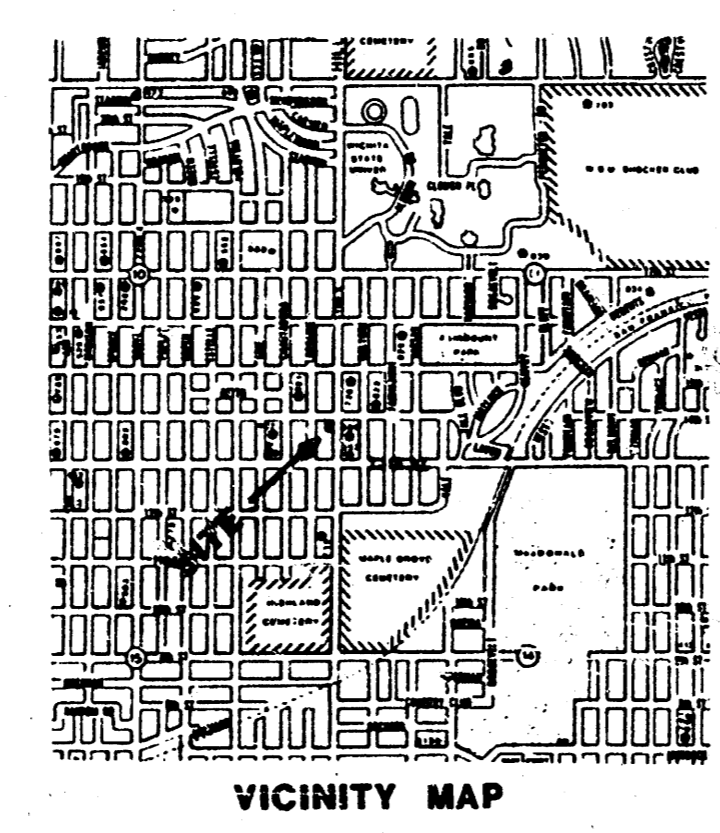

Note: The lots when redeveloped for office usage shall be graded to drain to the streets as indicated - unless other off-site drainage agreements are made.

SKETCH PLAT

JESSE WILLIAMS ADDITION

LOTS 33, 35, 37, 39, 41, 45, 43, 47 ON HILLSIDE AVENUE IN GIRARD ADDITION, WICHITA, KANSAS

OWNER: JESSE AND GLORIA WILLIAMS

DRAINAGE PLAN

ED BAUGHMAN COMPANY, P.A.
 SURVEYING & ENGINEERING
 312 WEST 77TH - 313 EAST - WICHITA, KANSAS 67211