
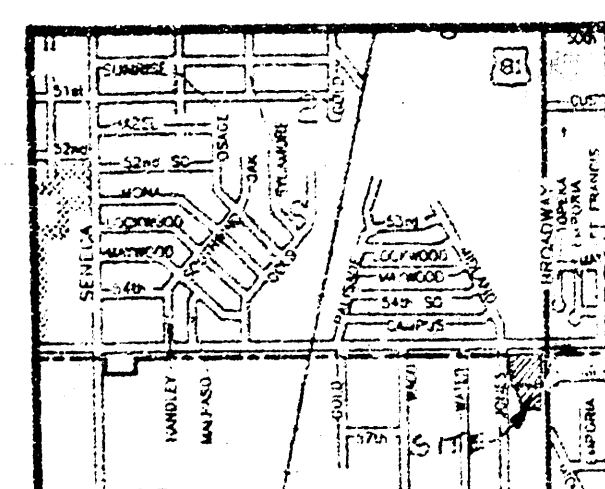


PRELIMINARY PLAT

WONG 2ND ADDITION

WICHITA, SEDGWICK COUNTY, KANSAS

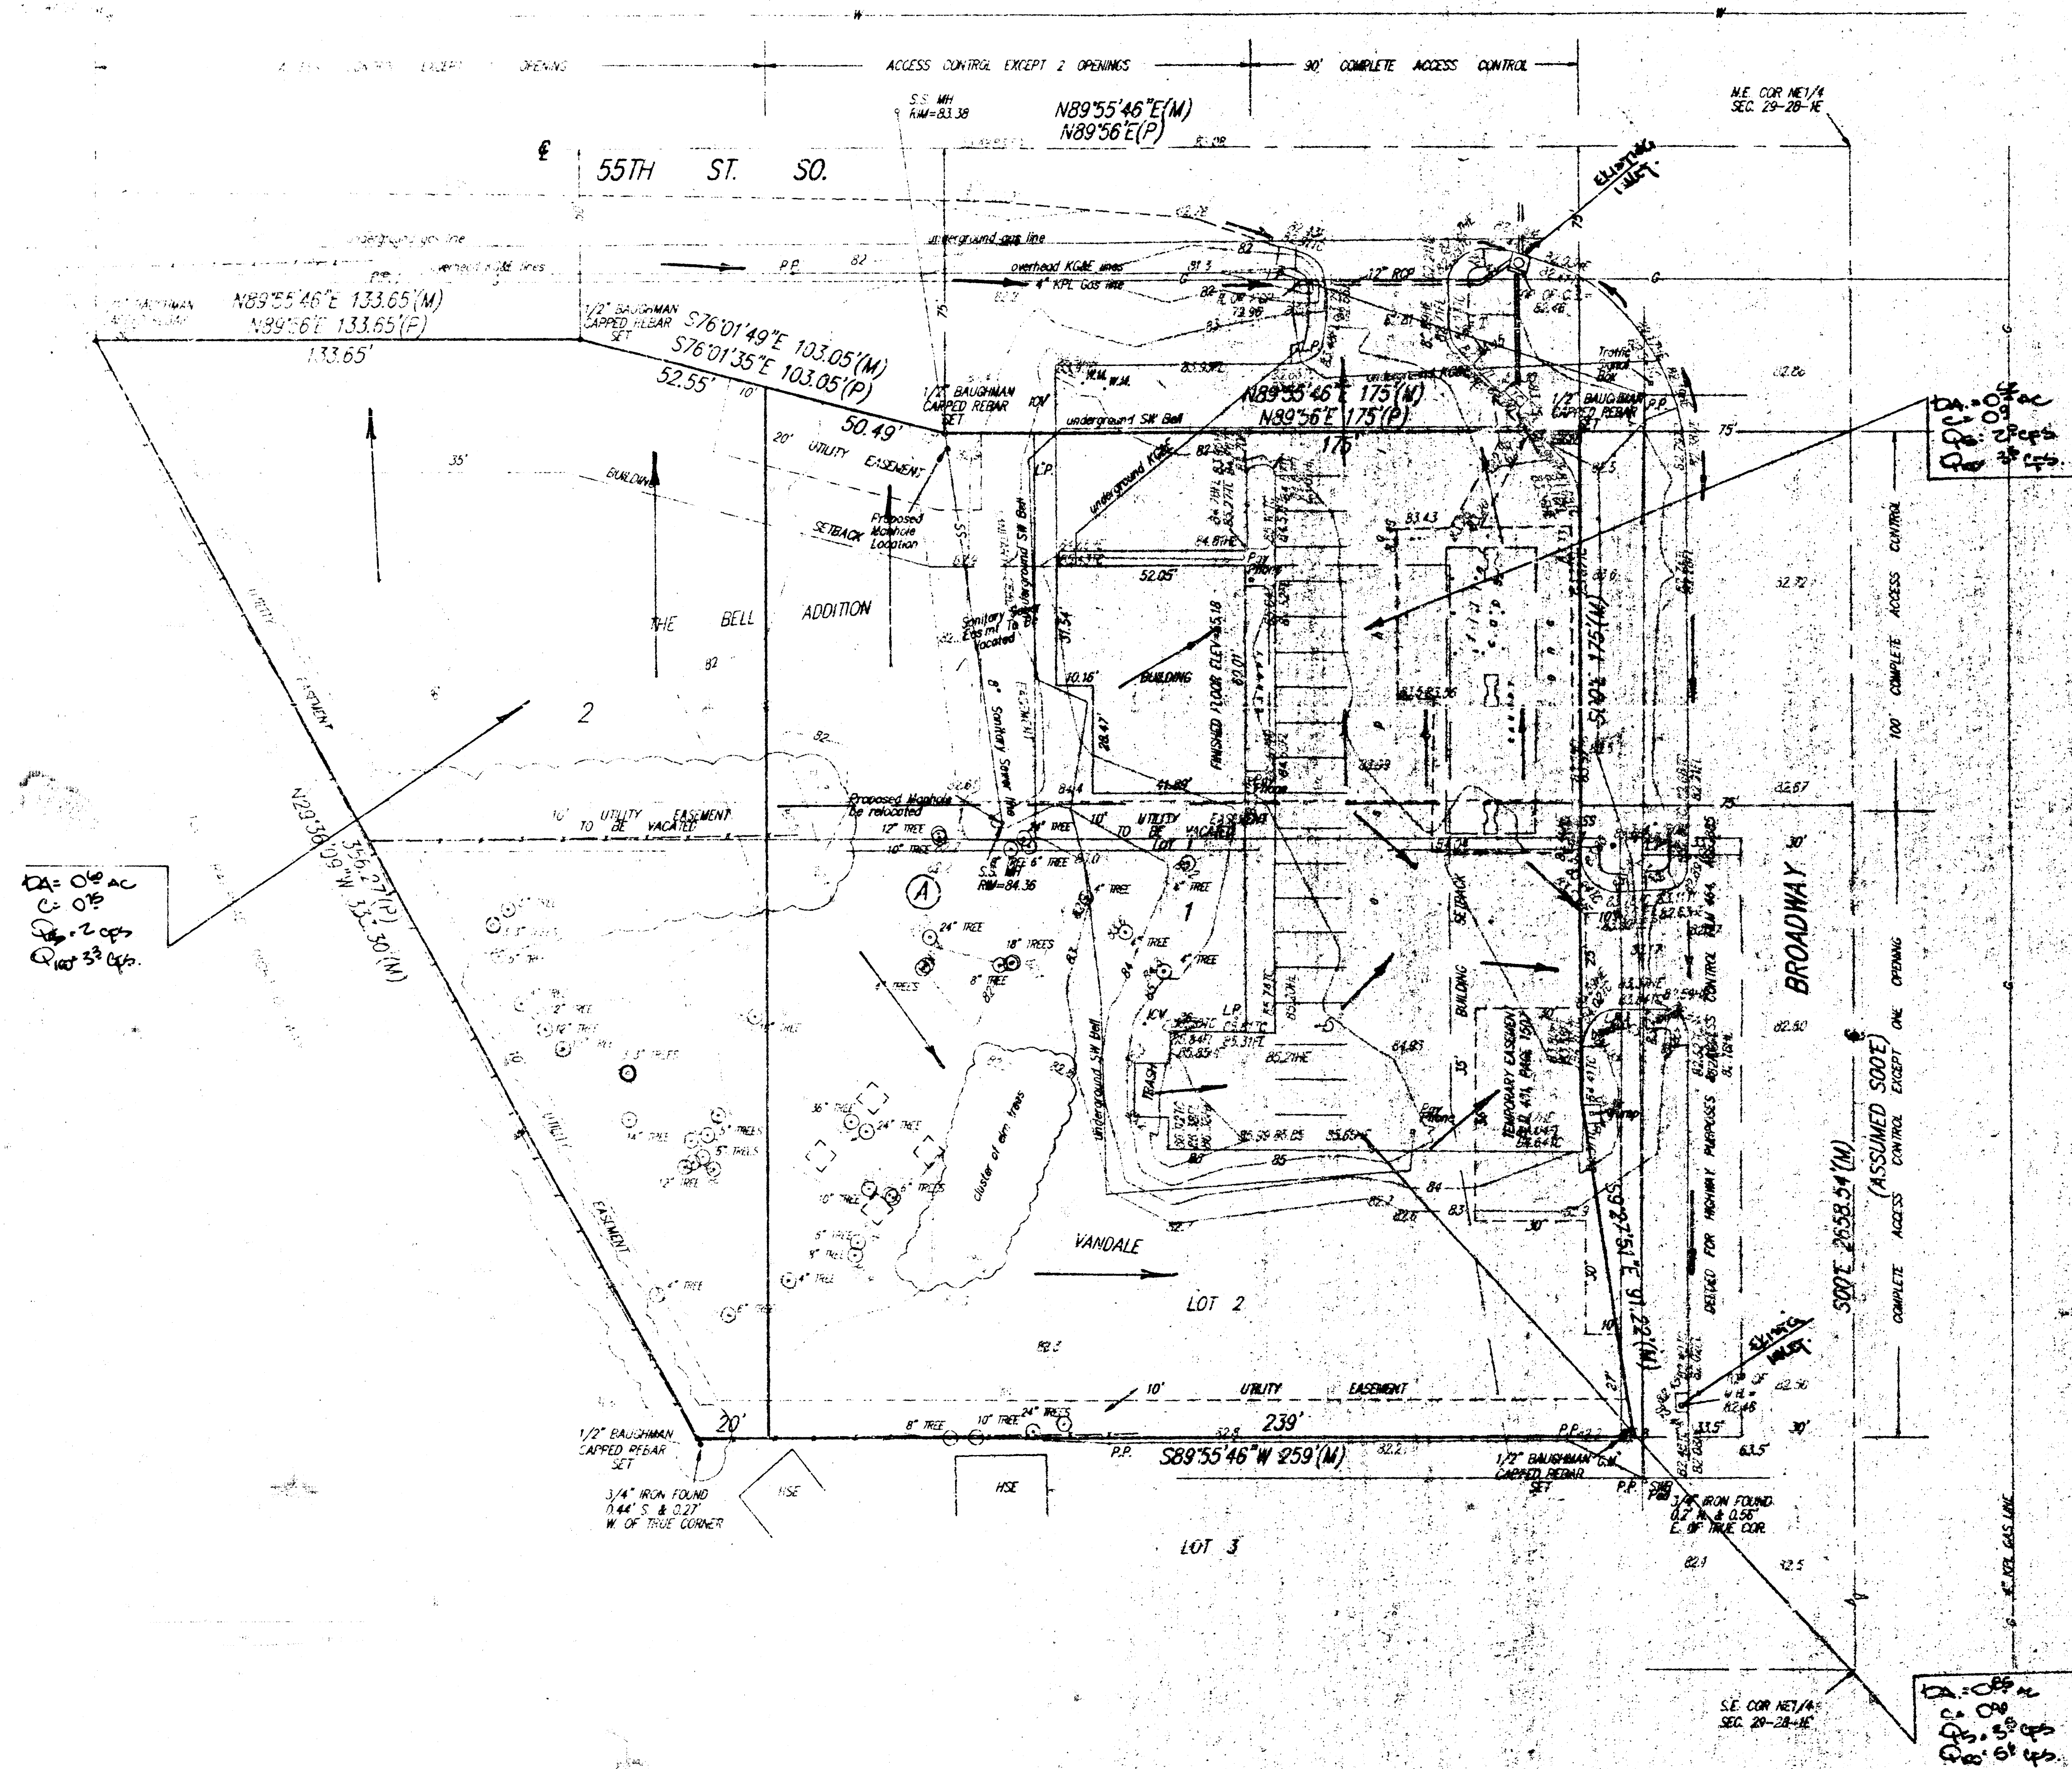

1/4\"/>

DRAINAGE PLAN

3/10/94