



Mitchell

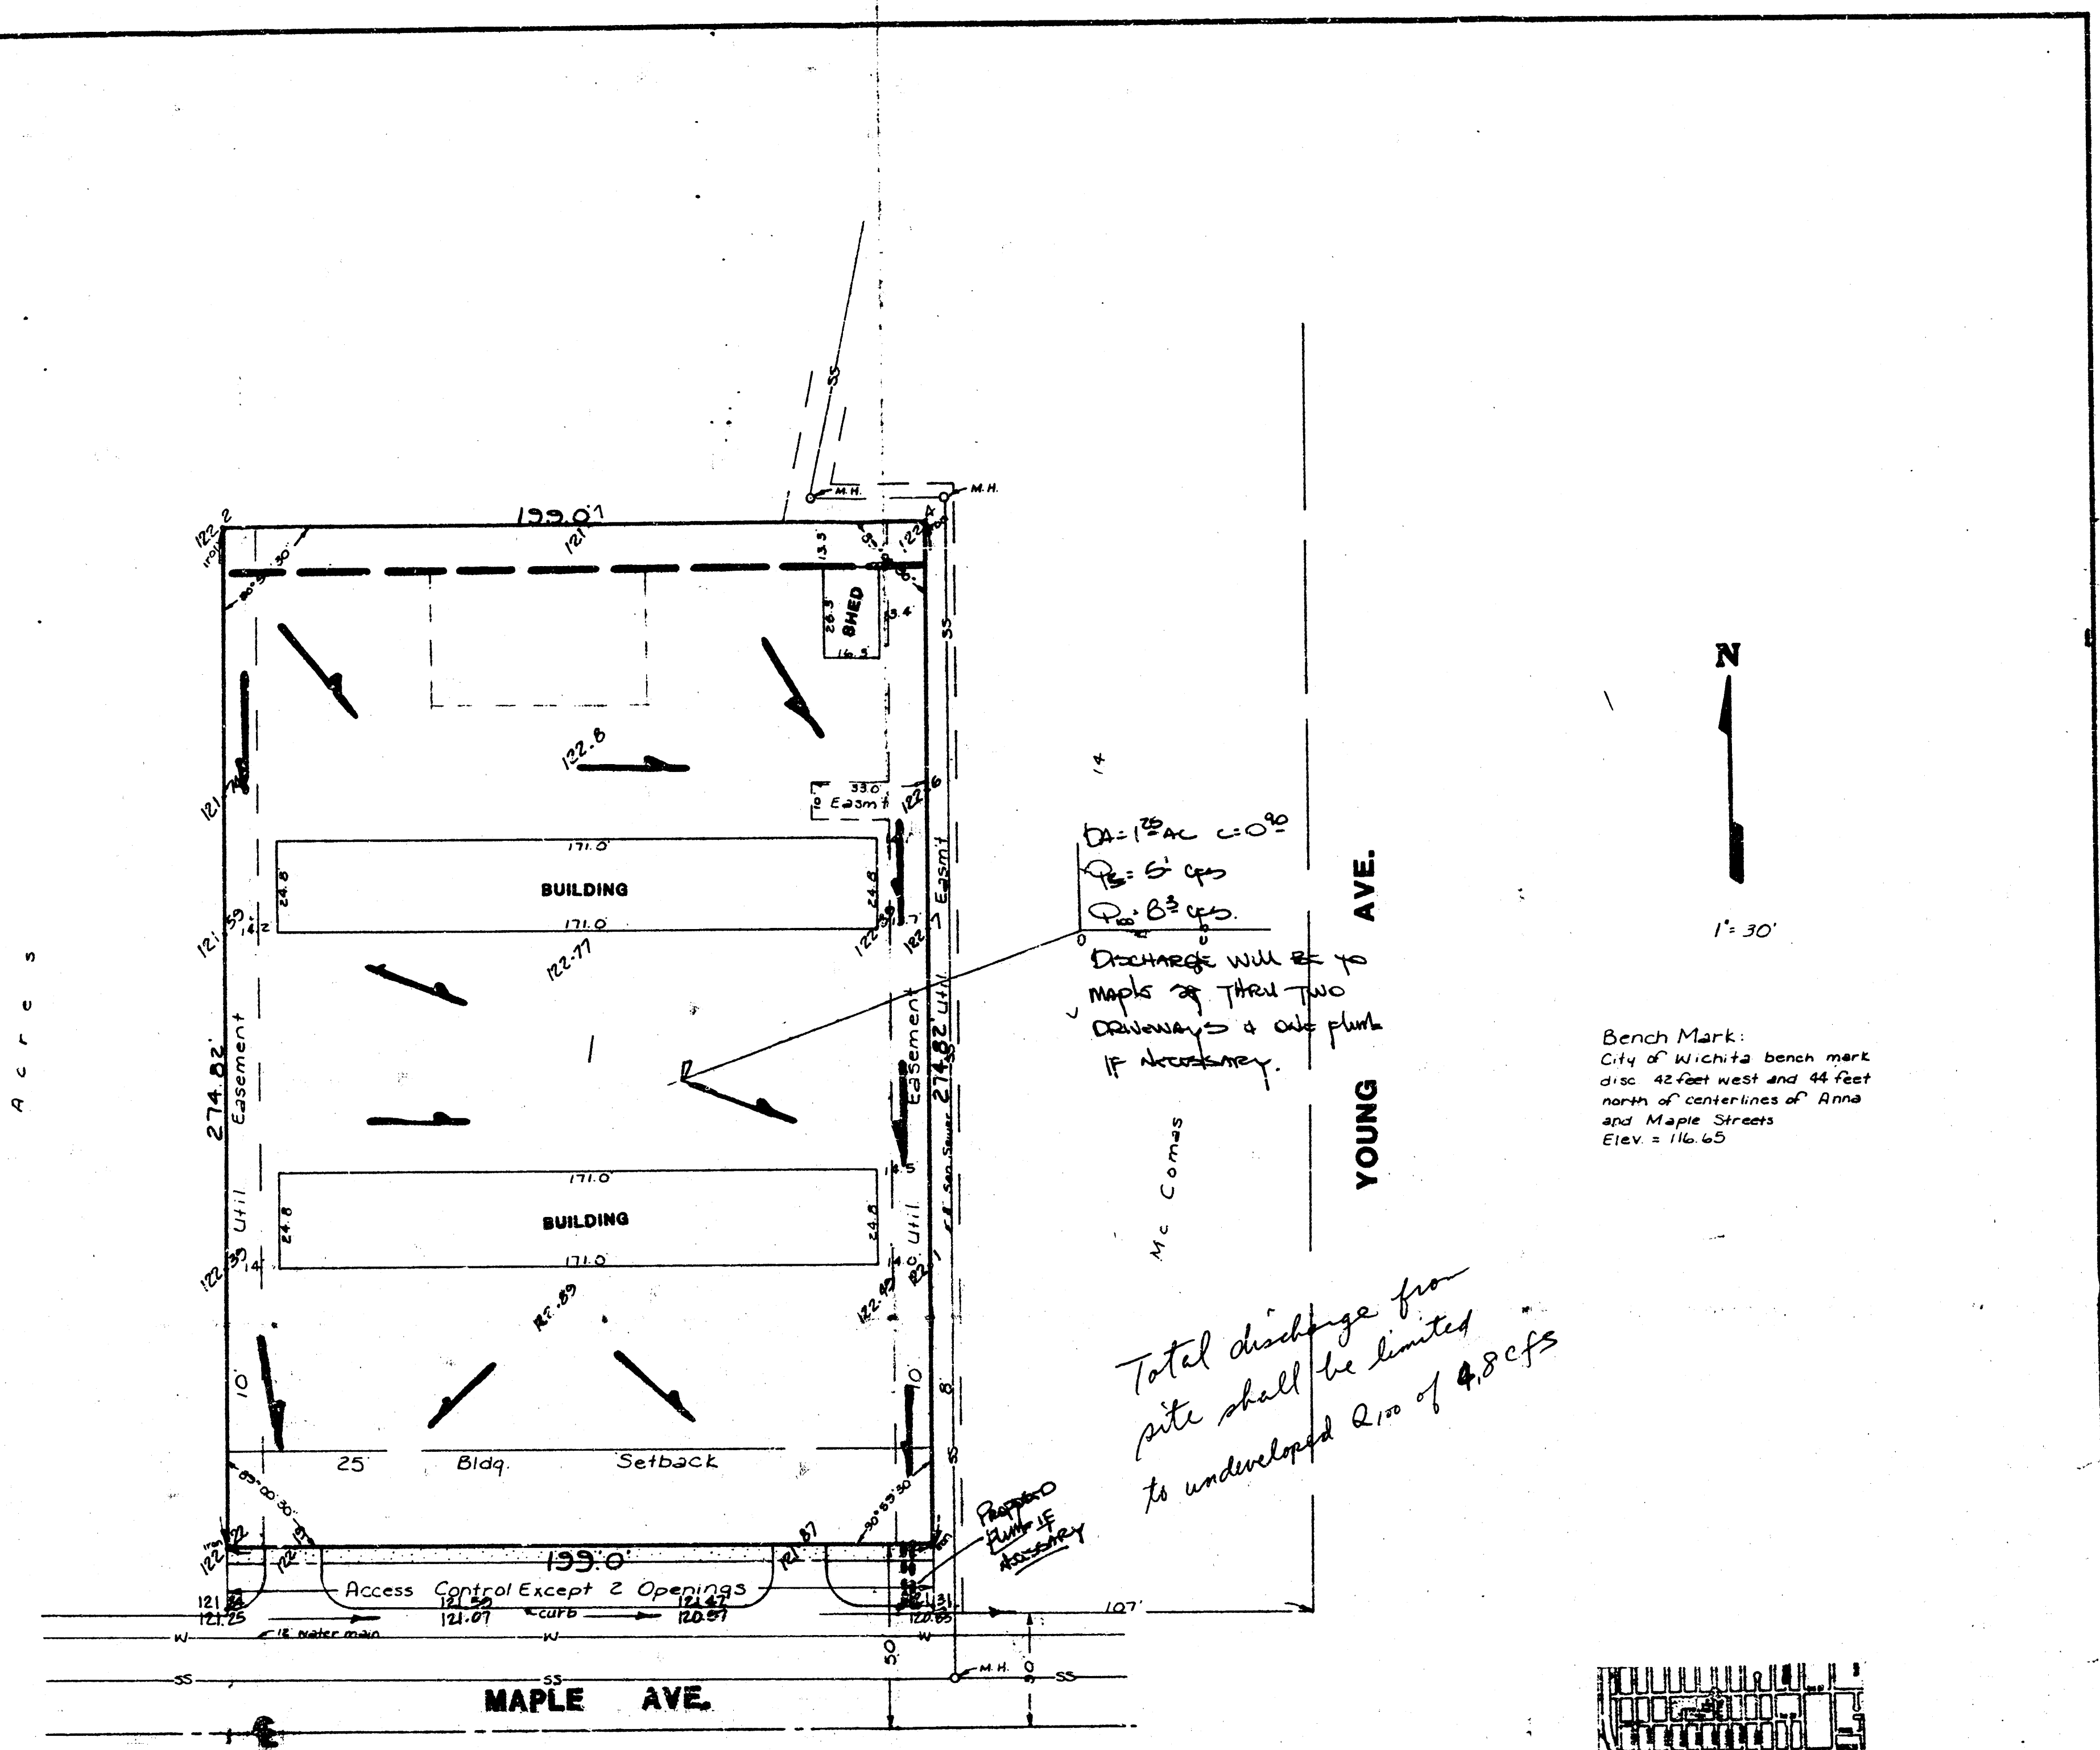


Discharge will be to
Maple or thru two
drainways & out plumb
if necessary.

Total discharge from
site shall be limited

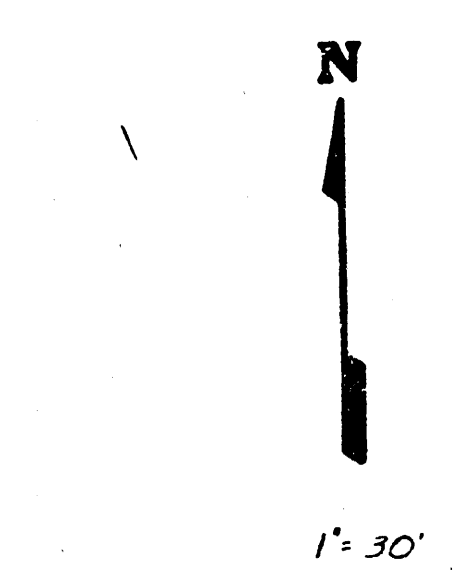

Bench Mark:
City of Wichita bench mark
disc 42 feet west and 44 feet
and Maple Streets

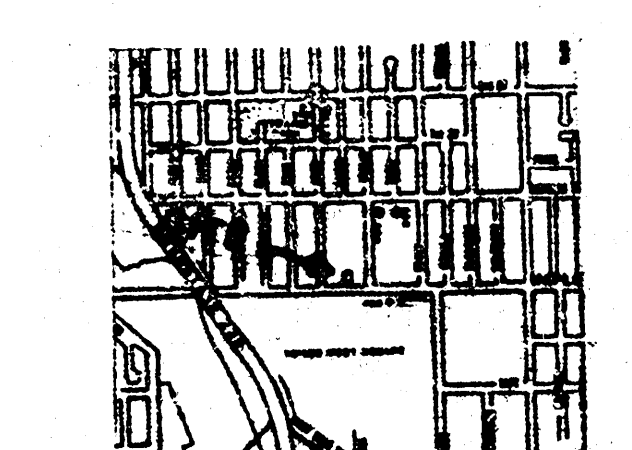

VICINITY MAP

NOTE: SITE SHALL DRAIN TO STREET RW
AT DRIVEWAY AND/OR PLUMES.

PRELIMINARY PLAT
DRAINAGE CONCEPT & PLAN
MITCHELL ADDITION

LOT 1, STRUNK ADDITION, AND THE SOUTH 71.17 FEET OF THE NORTH
142.25 FEET OF LOT 14, McCOMAS ADDITION, EXCEPT THE EAST 107 FEET THEREOF.

OWNER: WILLIAM B. MITCHELL

BAUGHMAN COMPANY, P.A.
SURVEYING & ENGINEERING
3-11-89