
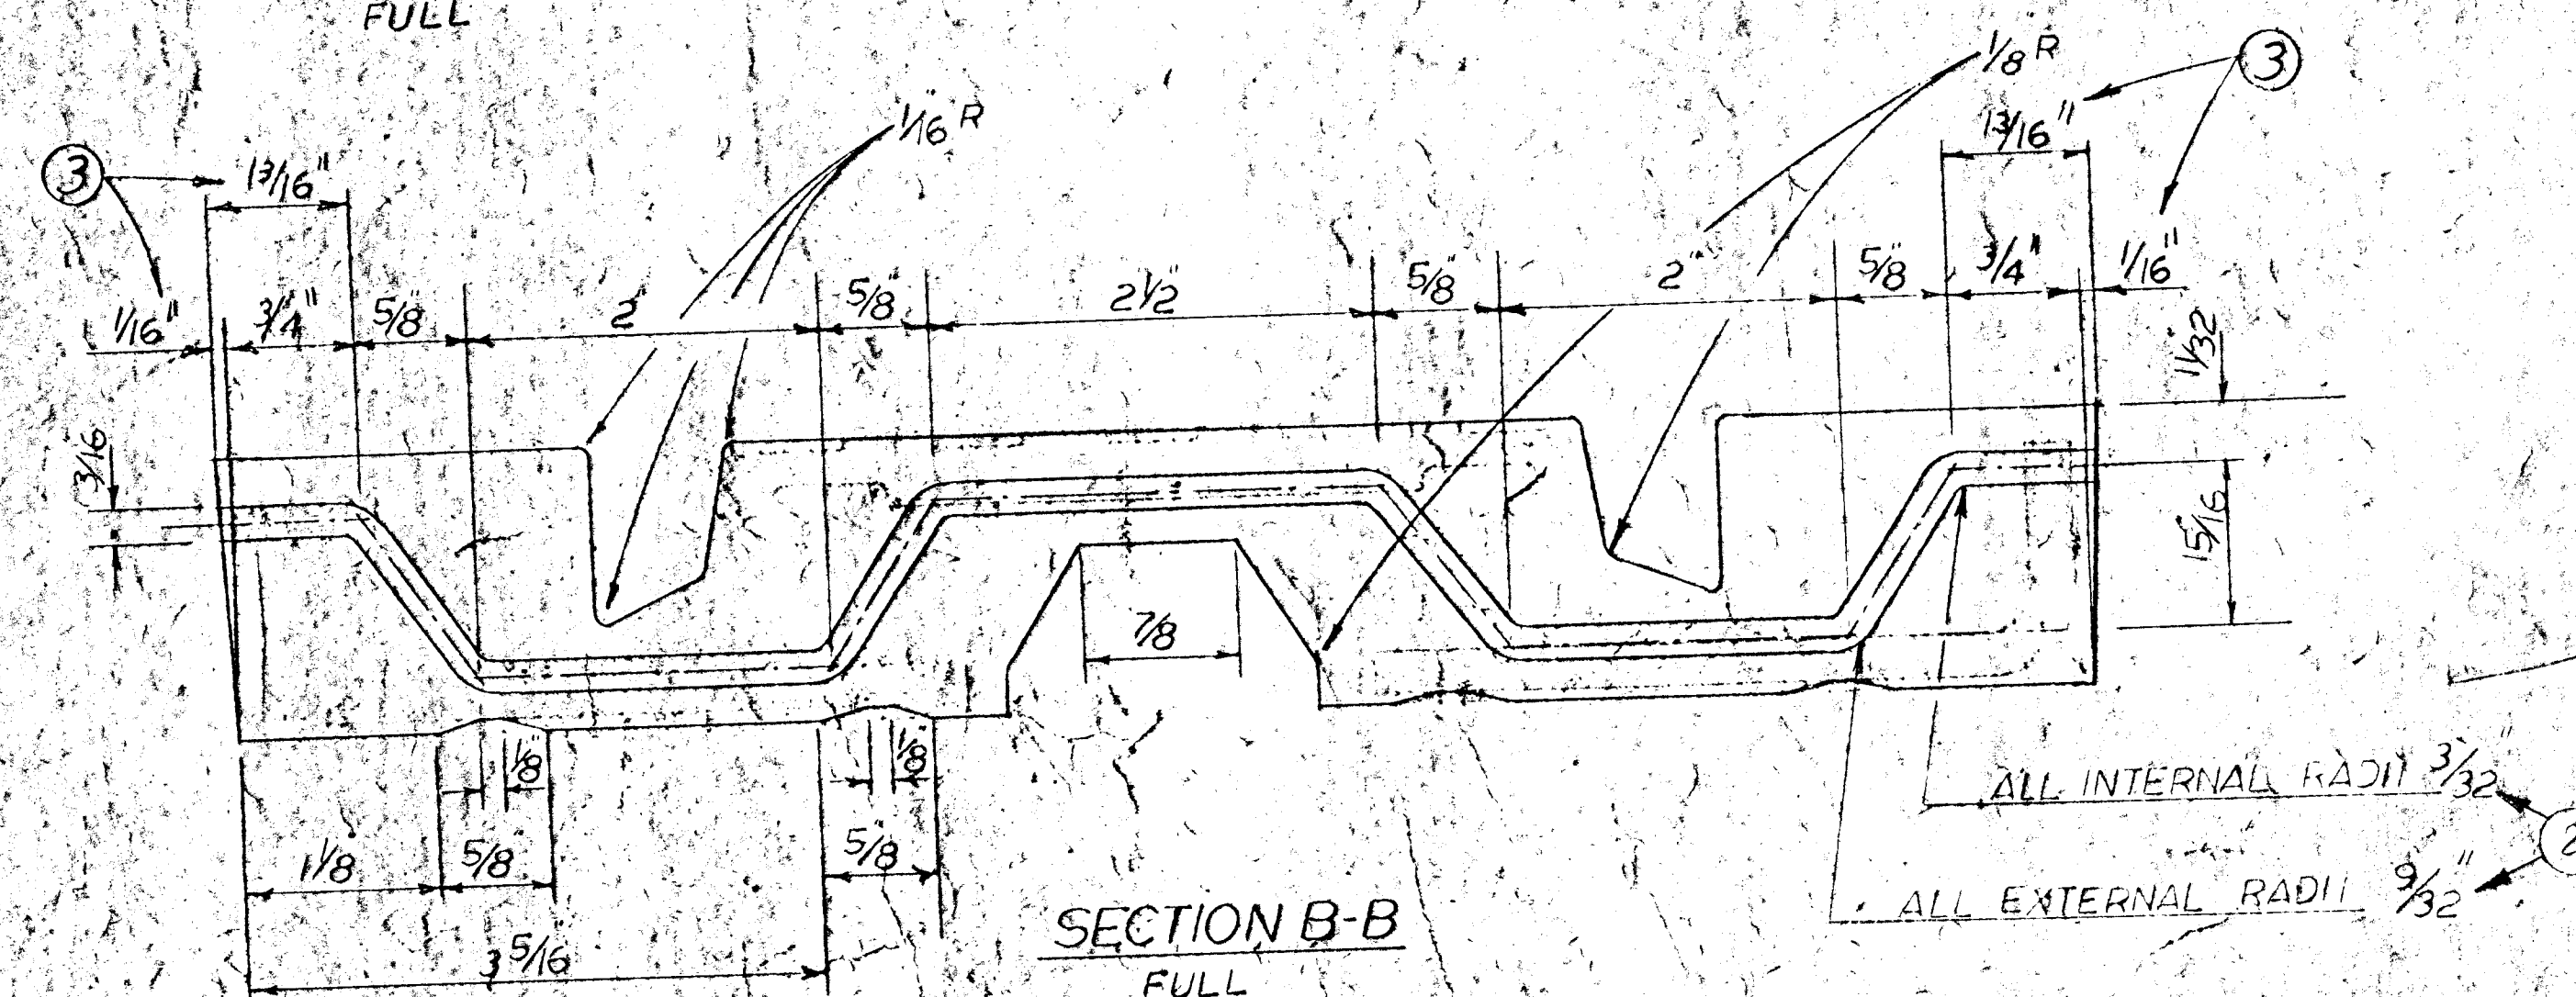
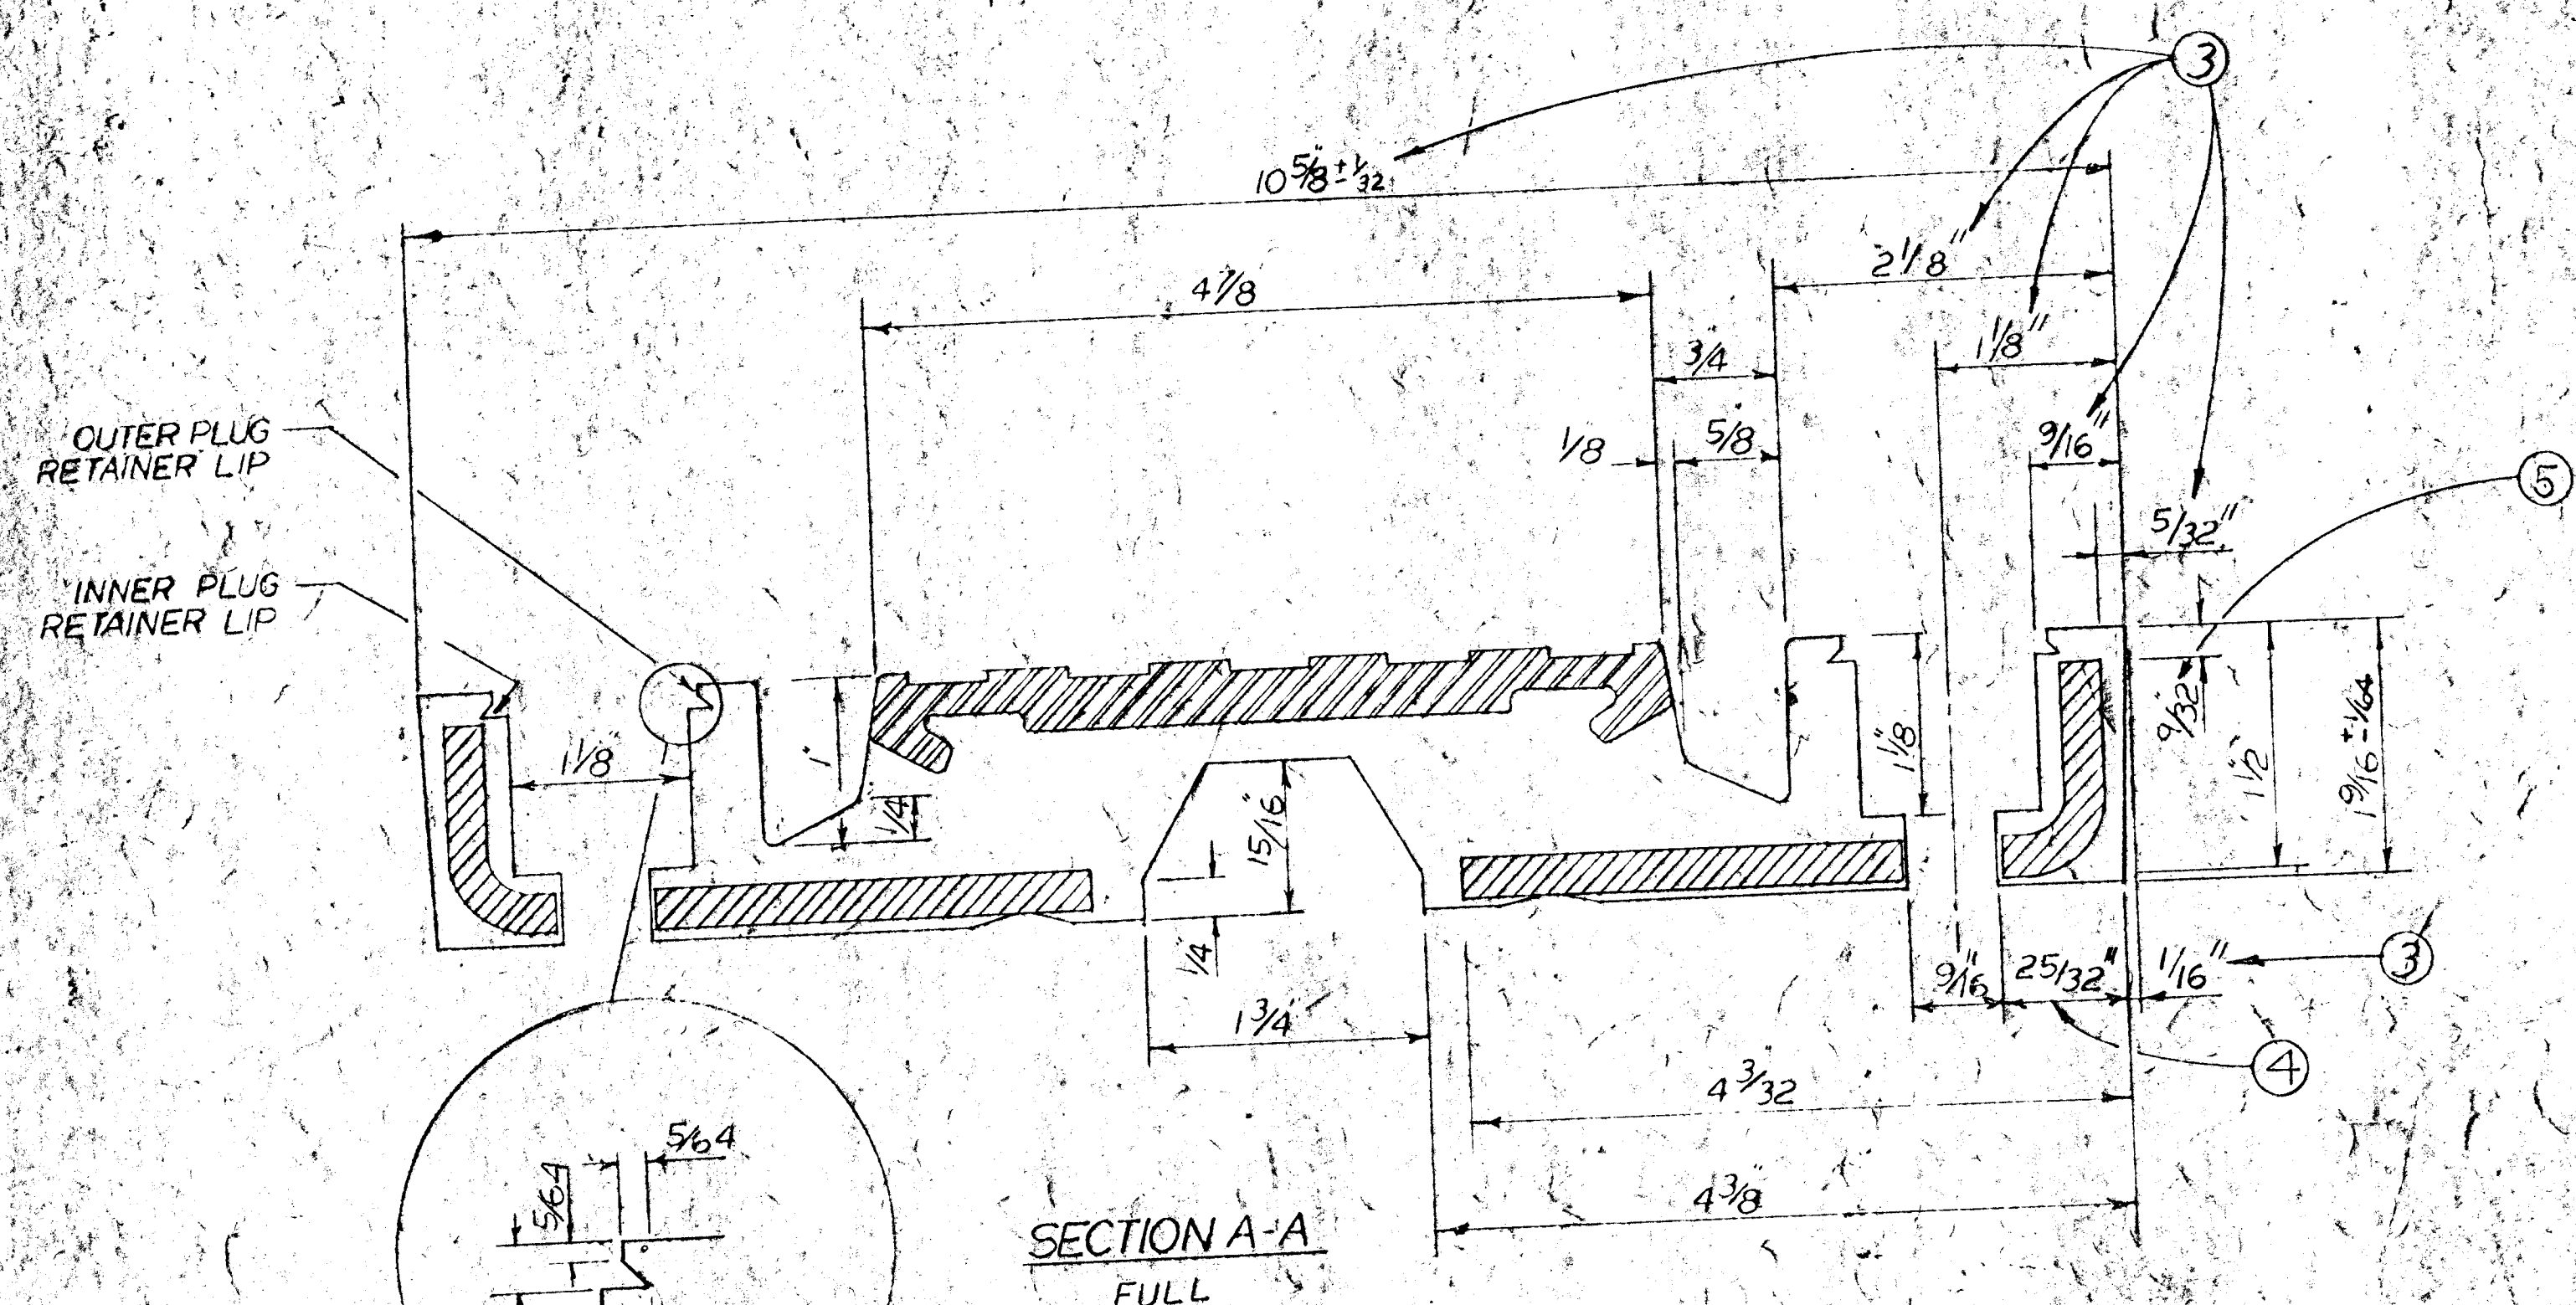
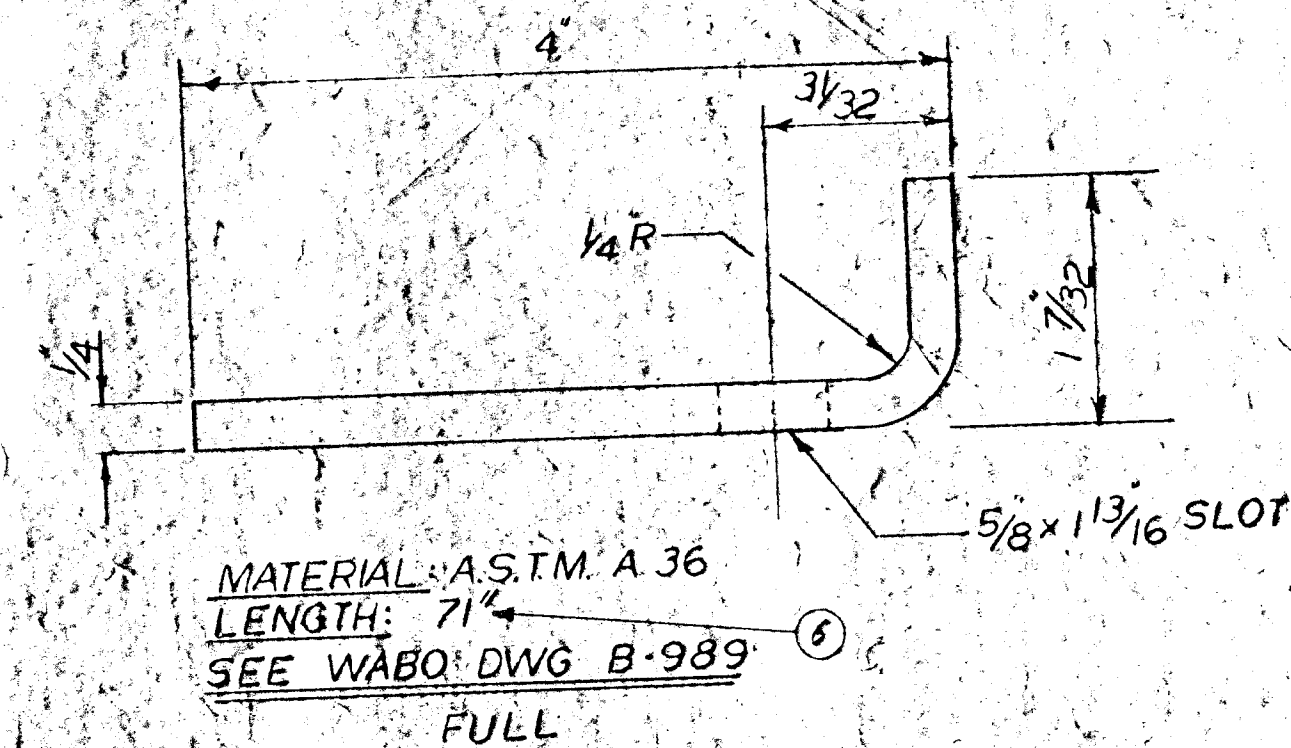
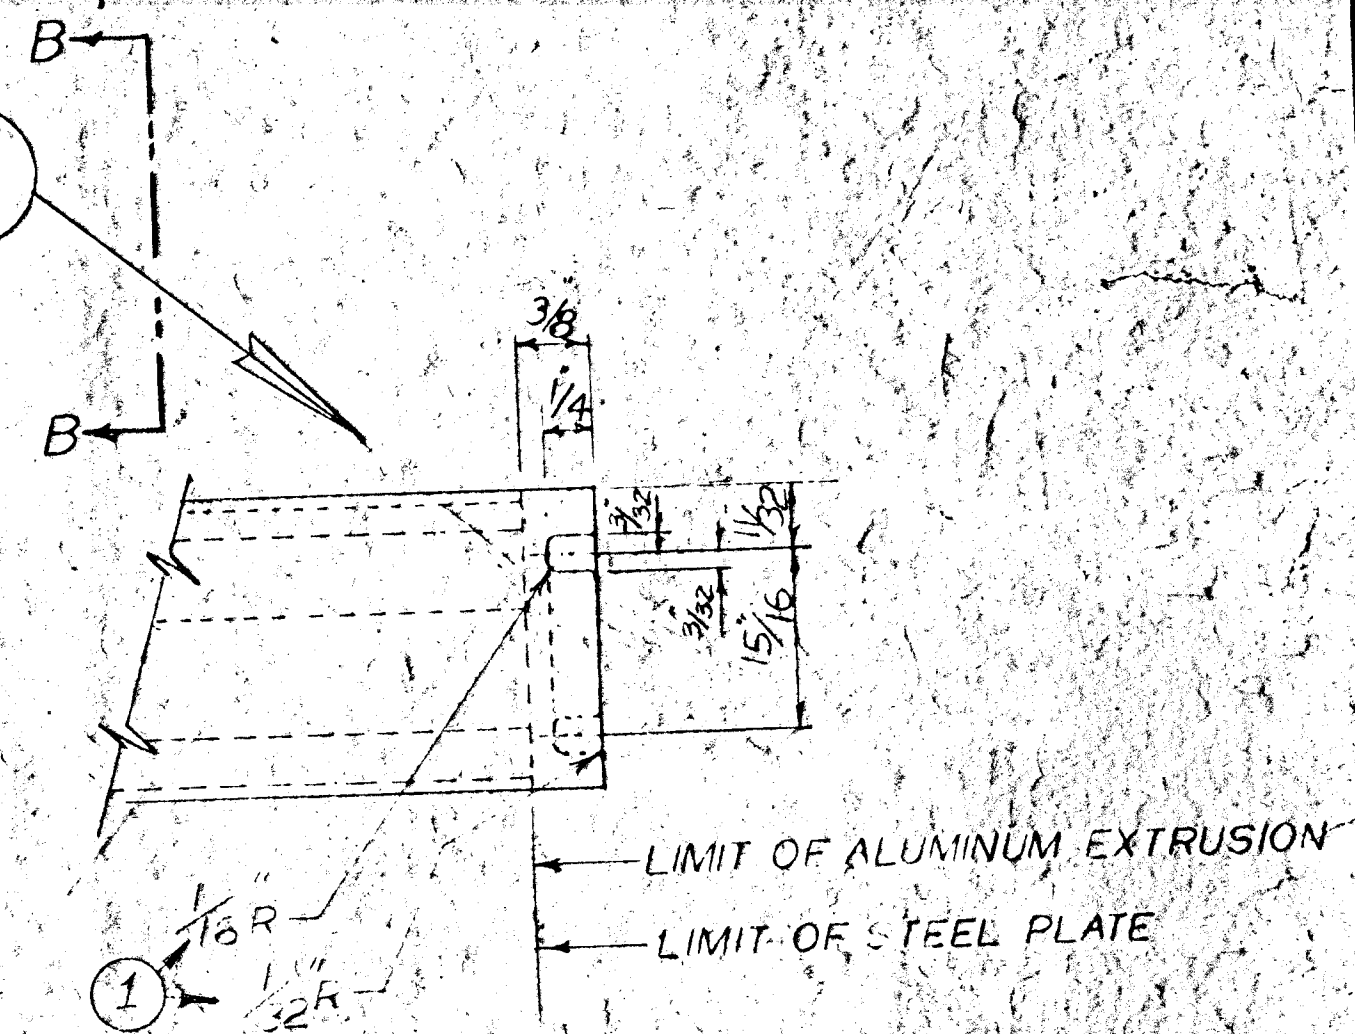
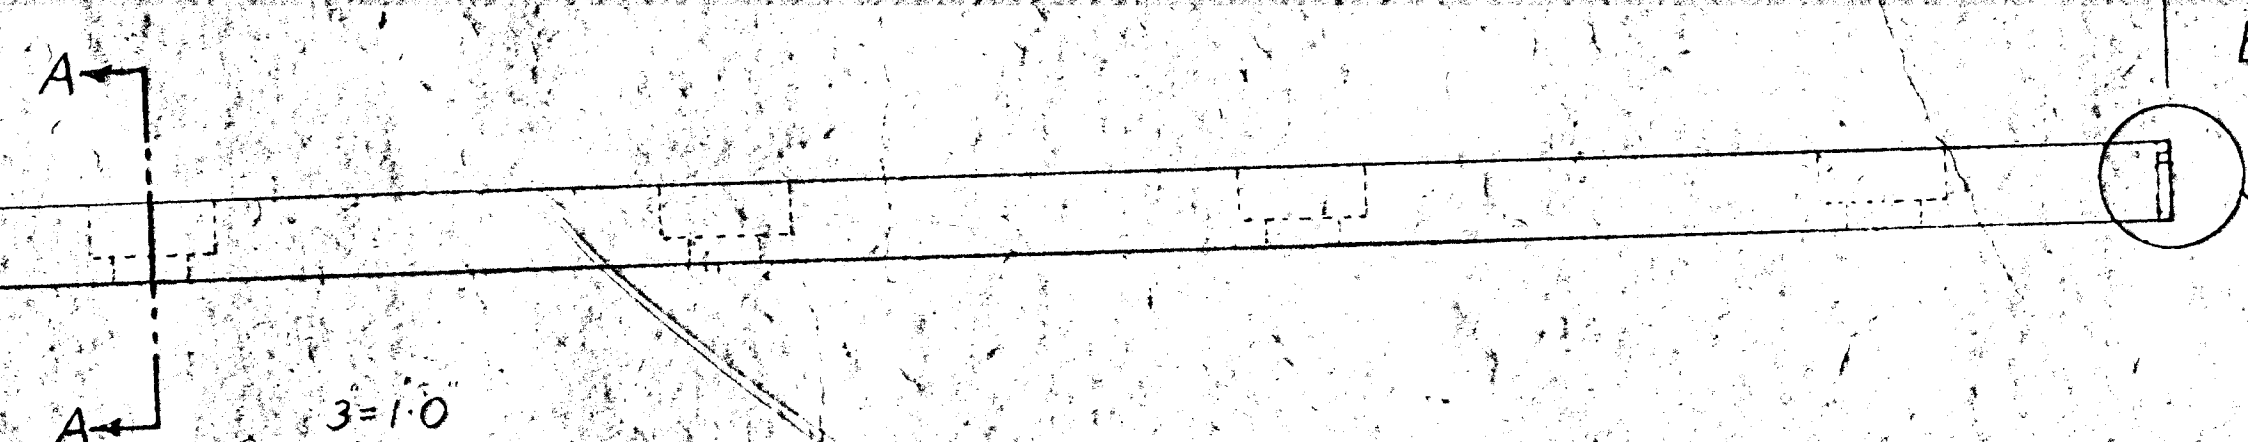
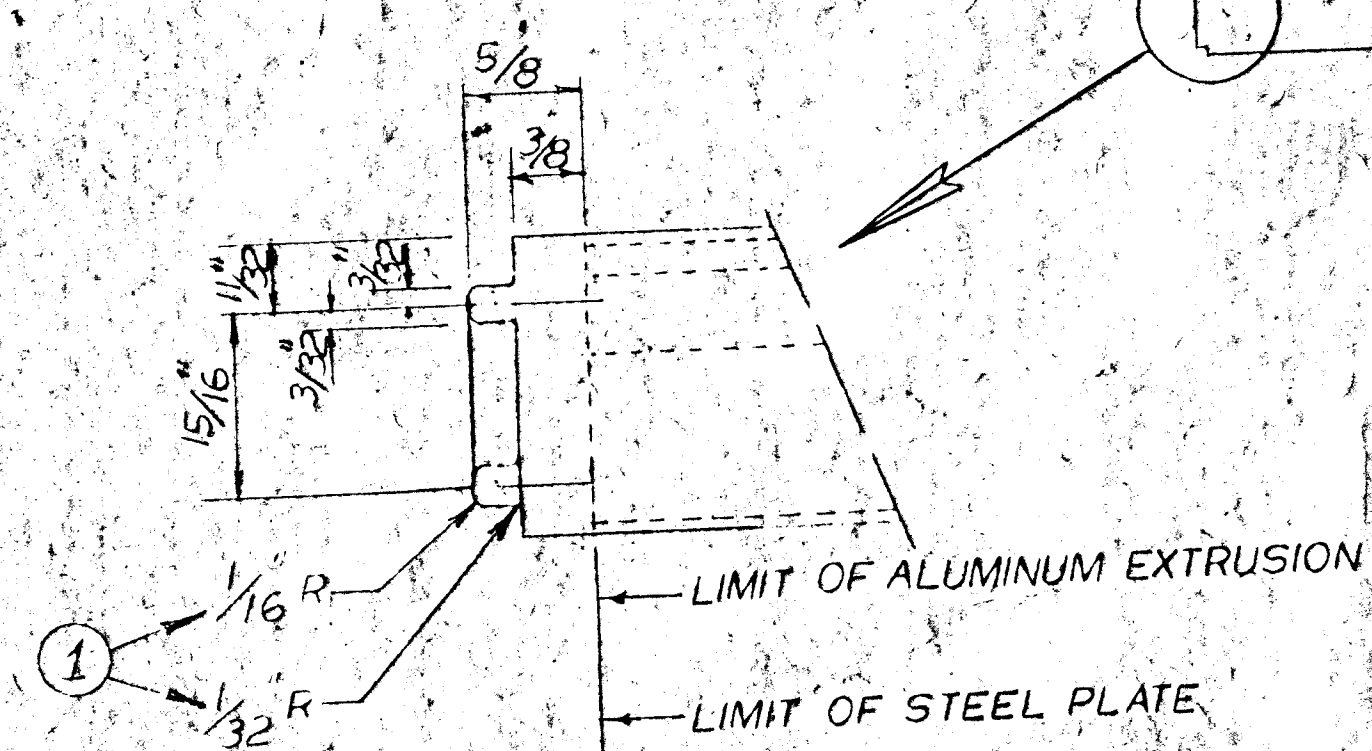


MATERIAL: ALUMINUM 6061-T6
LENGTH: 71 1/4
SEE WABO DWG. B-995
FULL

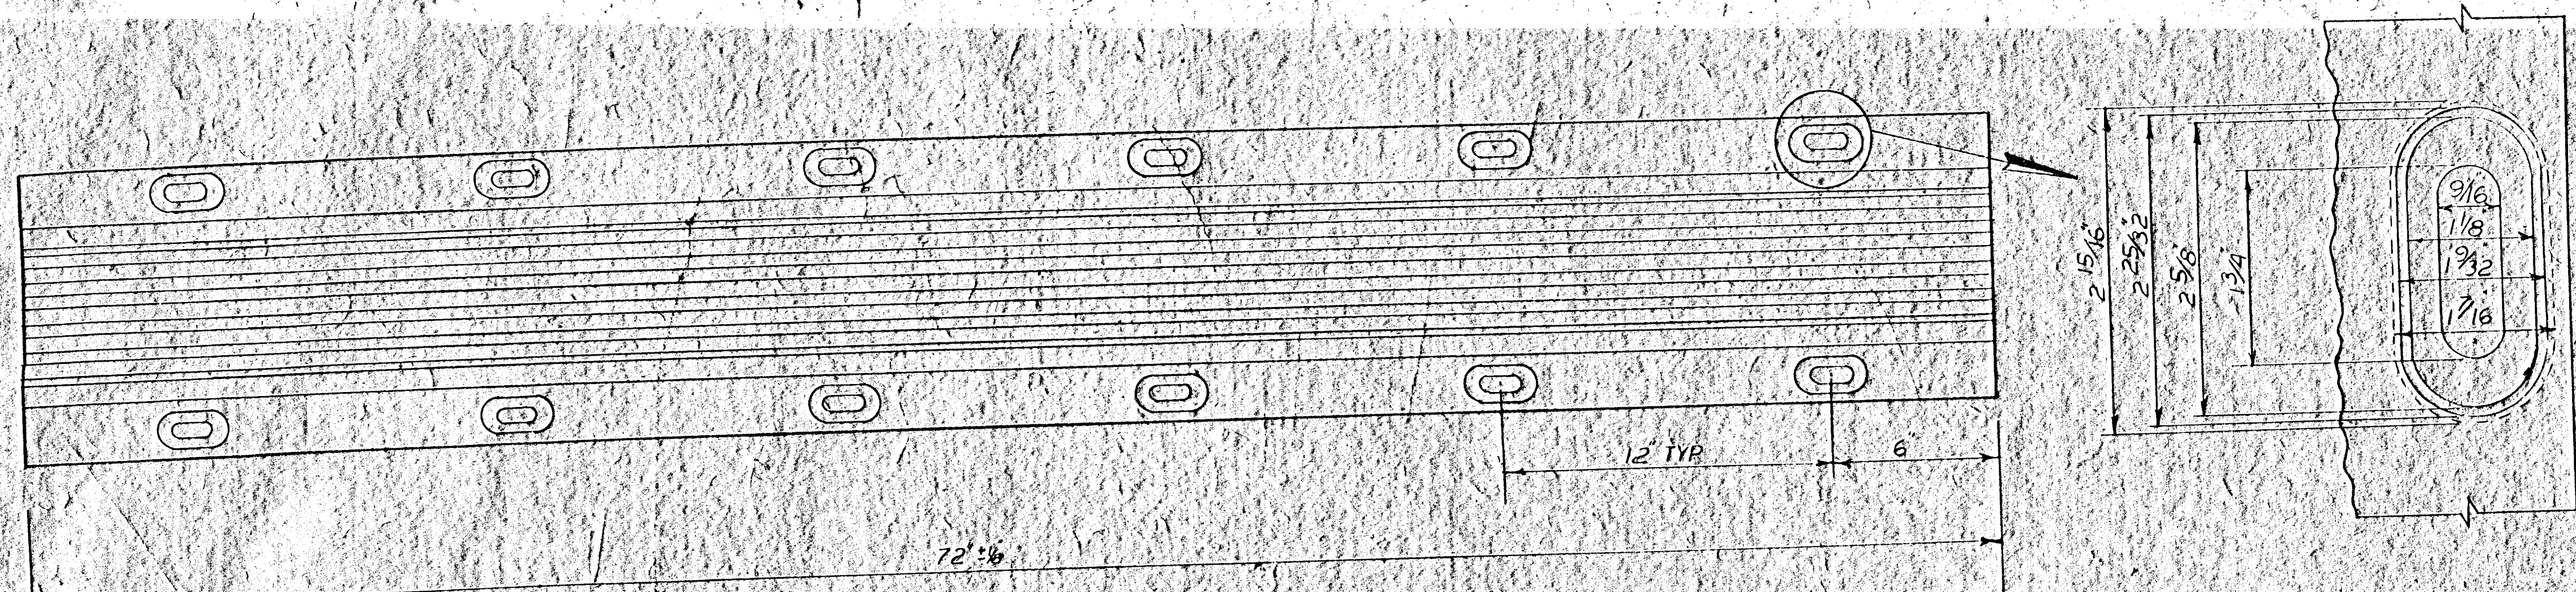

NO.	DATE	DESCRIPTION	NAME	SCALE:	APPROVED BY:	DRAWN BY W.W.
1	1-14-73	RAIRN ADDED TO T4G	E.K.	DATE: 1-18-73		REVISED
2	1-14-73	RAIRN ADDED TO TWO CORNERS	E.K.			
3	1-22-73	INCREASE "X-SECTION V8"	GH	WABOFTEX SR 2A DRAWING NUMBER: A-9844		
4	1-22-73	CORRECT DIM. IN SEC. A-A	CH			
5	1-22-73	INCREASE DIM. FROM 1/2" TO 7/8"	R.K.			
6	3-12-73	CHANGED LENGTH OF STEEL ANGLE	J.M.A.			