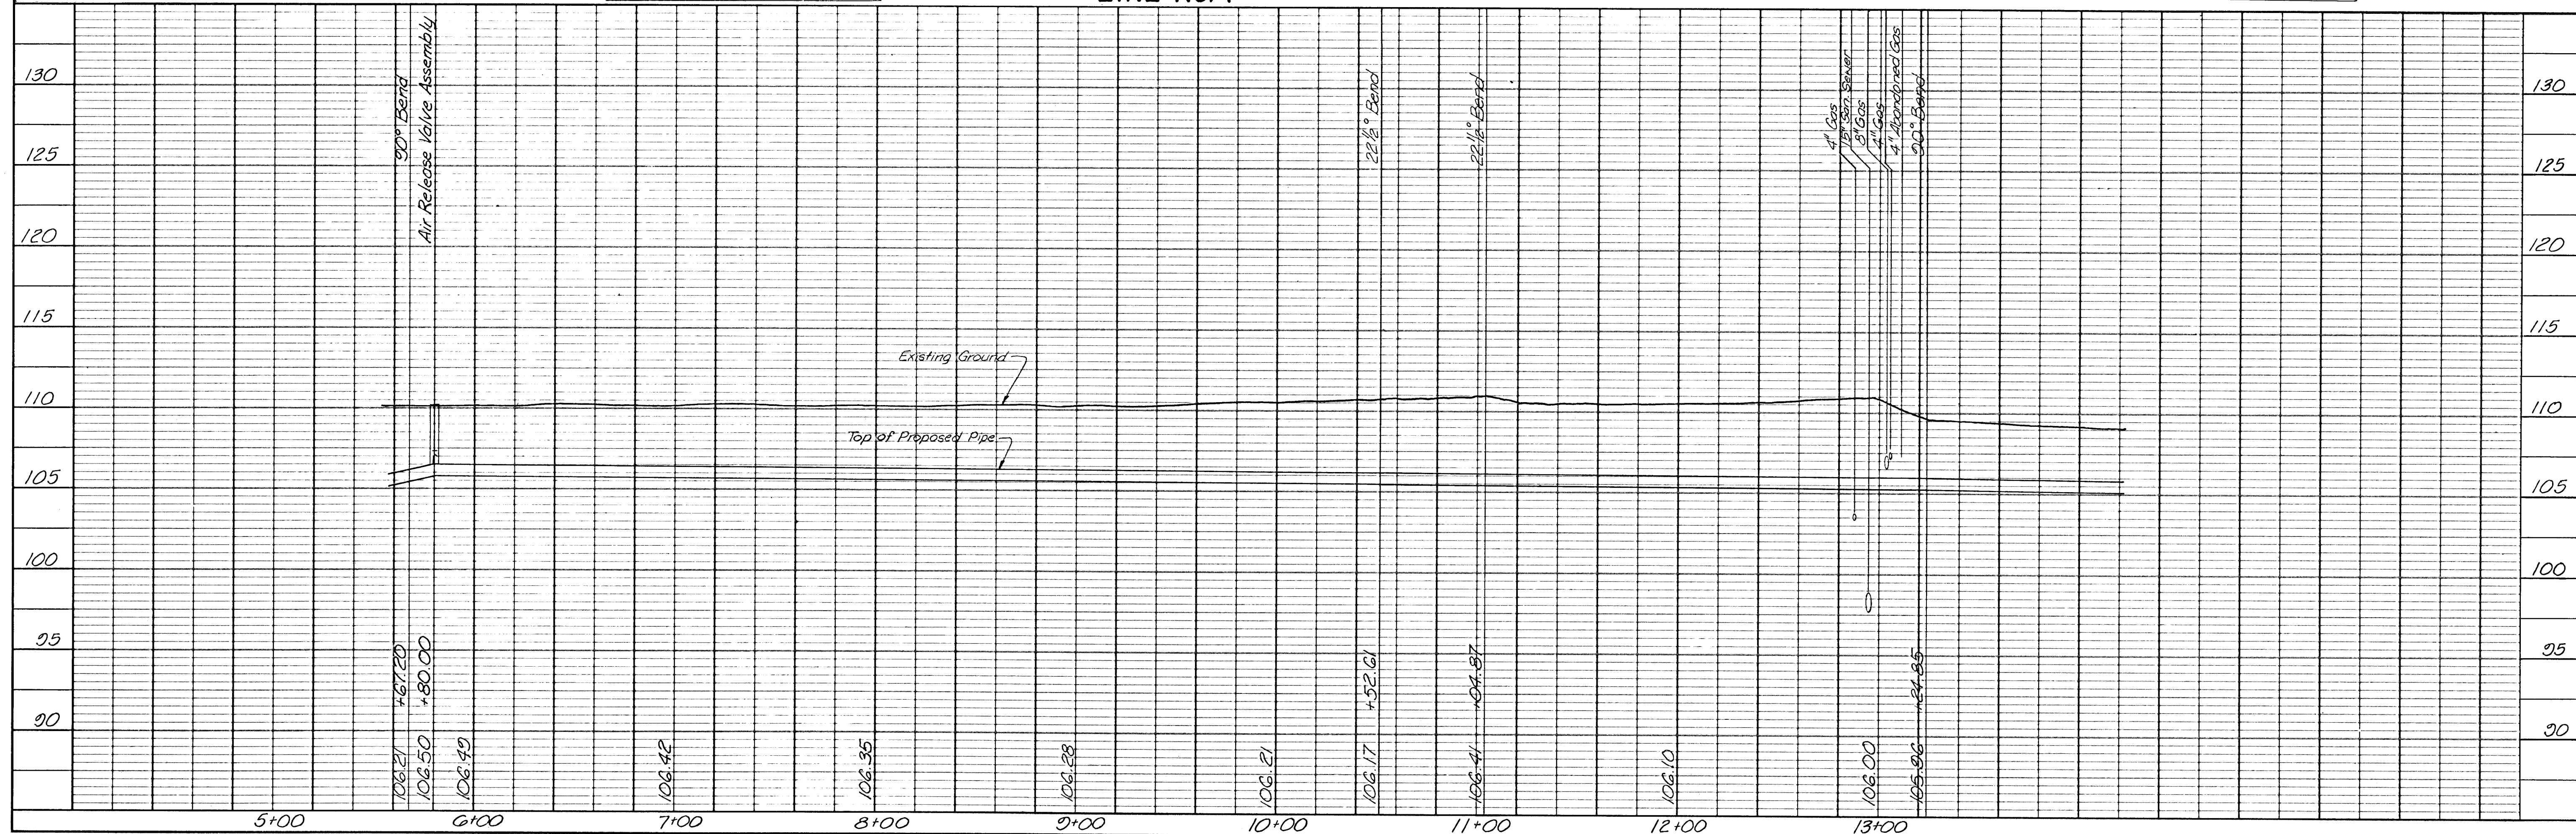
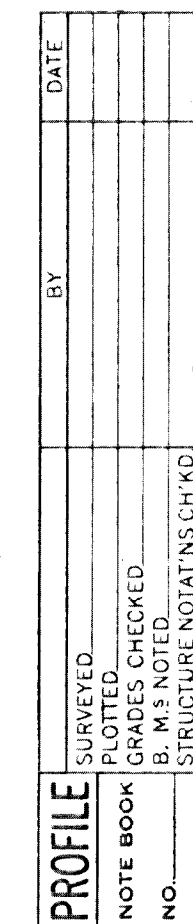


PI #3 Baseline No. 1 Sta. 20+00 = Baseline No. 2 Sta. 10+00 = NE Corner, Section 10, T28S, R1W, 3/4" Iron Pipe in Thimble

1. Top Center of Fire Hydrant	61.80
2. Center of Steel Fence Corner Post	62.42
3. Nail and Shiner NNE Face of Power Pole	54.72

PLAN: LAT. & LONG.

PROFILE: HORIZ. SAME AS ABOVE

[illegible]