
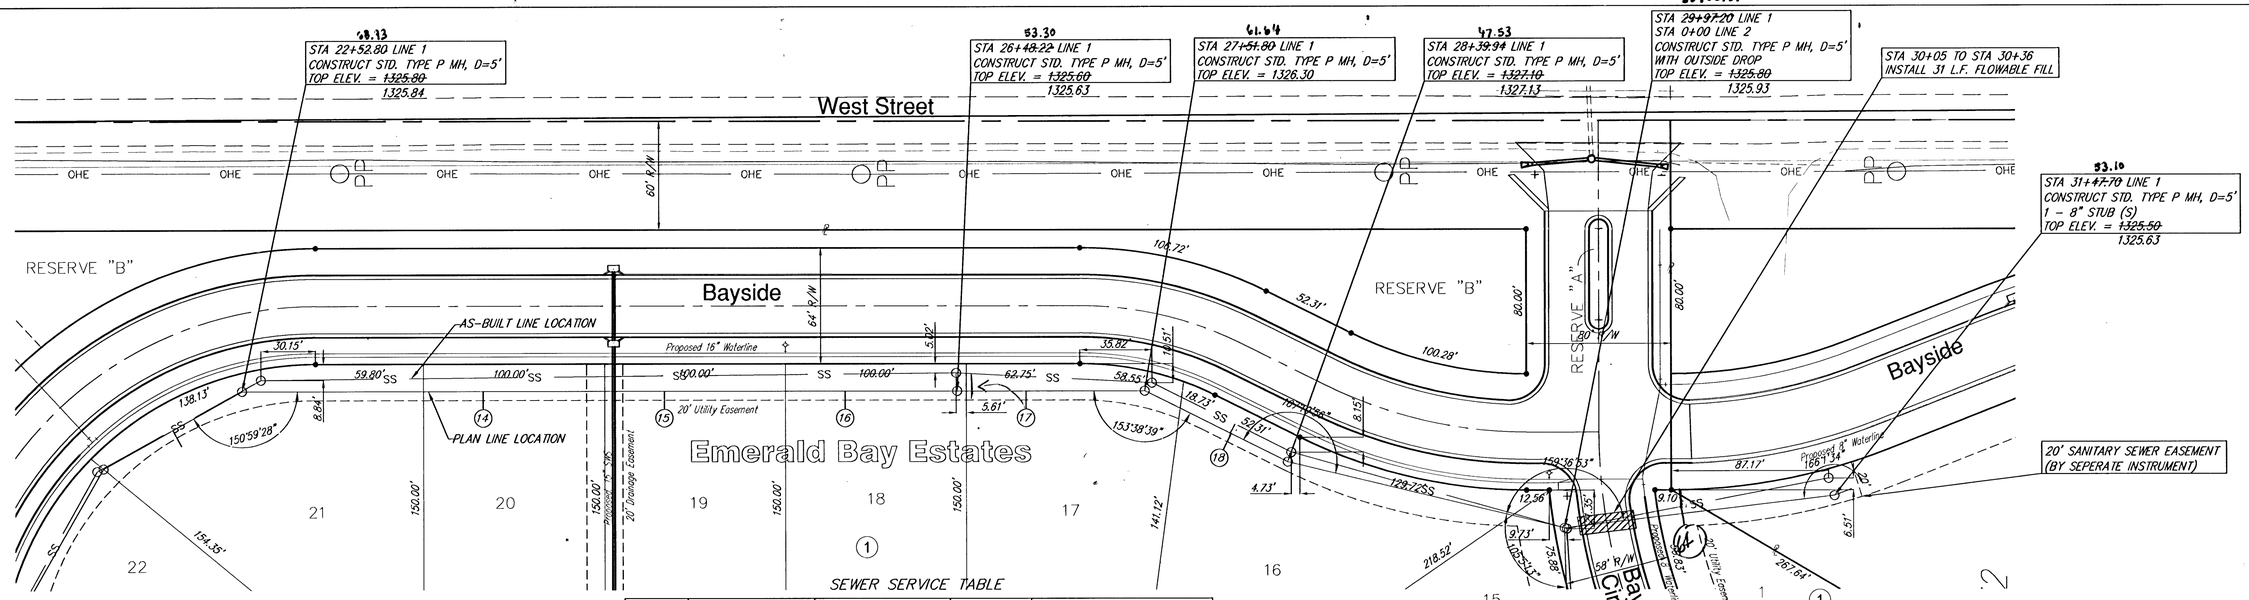


NUMBER	TYPE	LOCATION			STATION\ DIRECTION	FOR INFORMATION ONLY	
		LOT NO.	BLOCK NO.	LINE NO.		APPROXIMATE LENGTH 4" PIPE VERTICAL	HORIZONTAL
14	8" X 4" Tee Saddle	20	1	1	23+~~86~~/R	90 17'	~~10~~ 11
15	8" X 4" Tee Saddle	19	1	1	24+~~88~~/R	91 17'	~~10~~ 11.5
16	8" X 4" Tee Saddle	18	1	1	25+~~86~~/R	93 16'	10'
17	8" X 4" Tee Saddle	17	1	1	26+~~86~~/R	52 17'	~~10~~ 11
18	8" X 4" Tee Saddle	16	1	1	28+~~68~~/R	09 17'	~~10~~ 11
19	8" X 4" Tee Saddle	1	1	1	30+70/R	15'	12'

NOTE: ALL BACKFILL FOR SHALL BE SAND FLUSHED AND VIBRATED.

SCALE 1" = 40' HORIZ.
1" = 5' VERT.
IRON = ●

12-4-06 JEF "AS-BUILT" 3-15-07 AML 12-3-07 AML

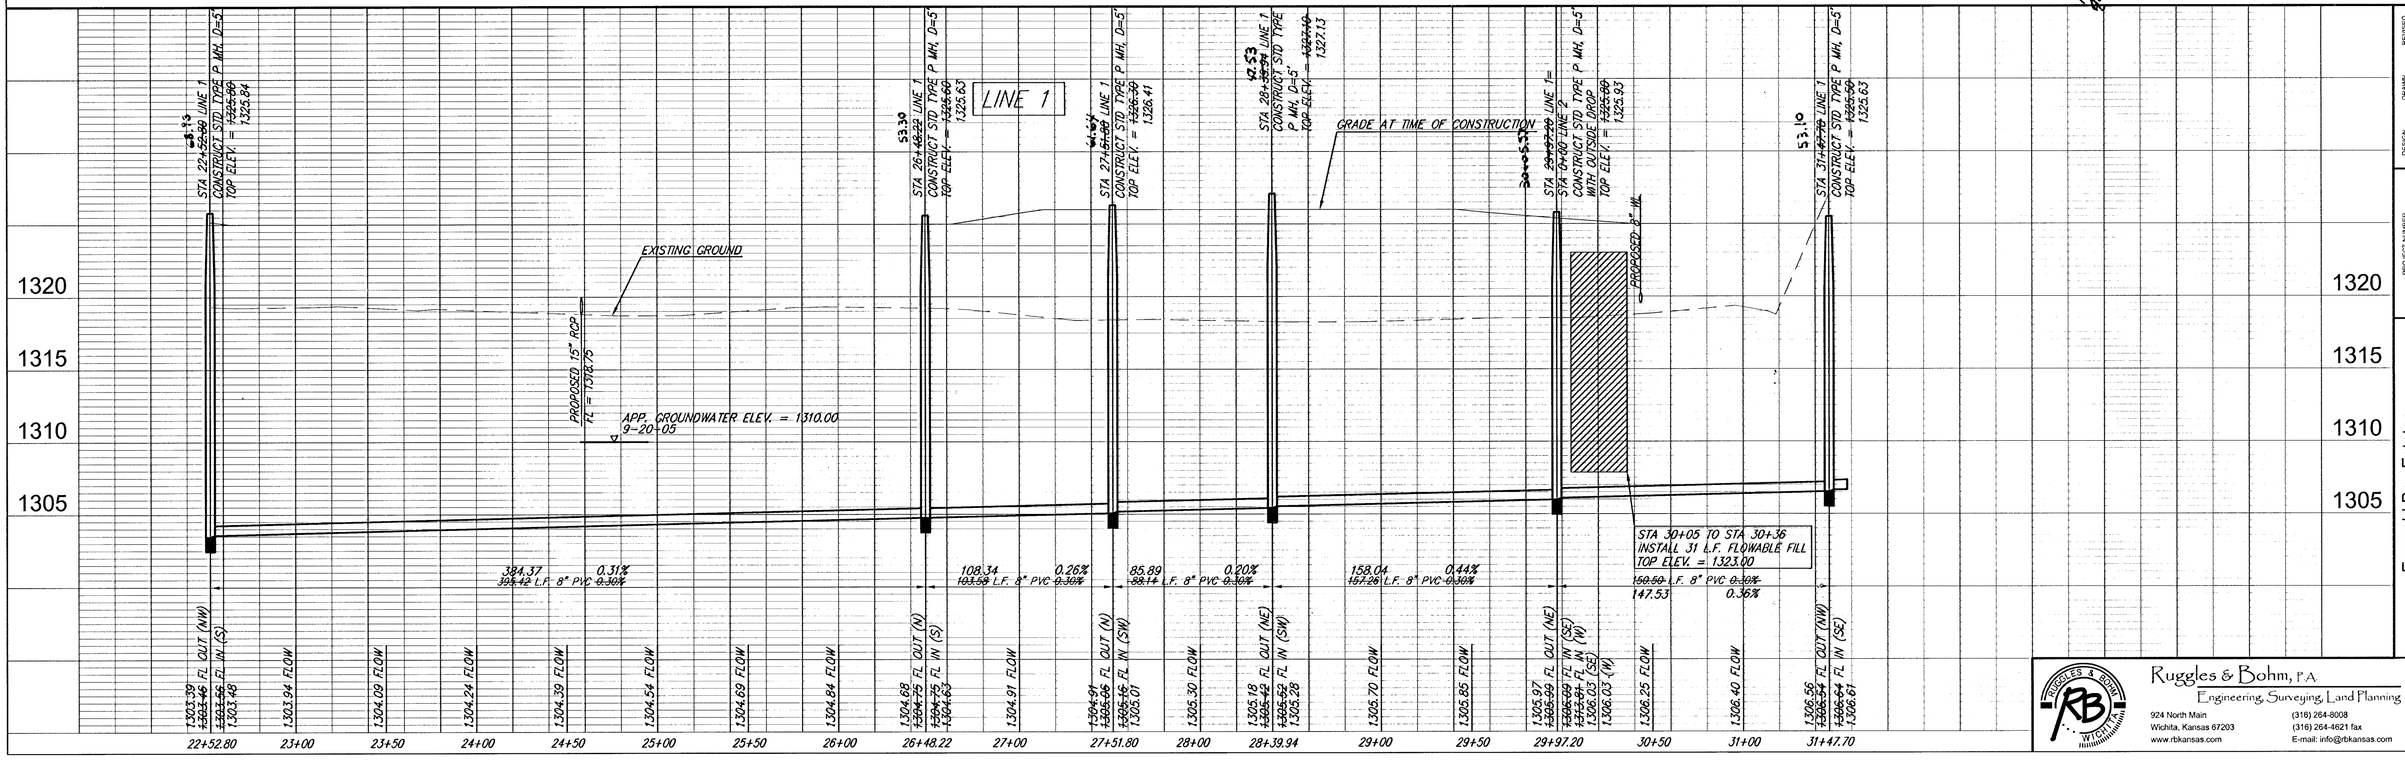

Ruggles & Bohm, P.A.
Engineering, Surveying, Land Planning
924 North Main
Wichita, Kansas 67203
www.rbkansas.com
(316) 264-8008
(316) 264-4621 fax
E-mail: info@rbkansas.com

DESIGN AML | DRAWN MLP | REVISED | REVIEW | DATE: Jan. 5, 2006 | UTILITY

PROJECT NUMBER 468-84139

DRAWING FILE: Sanitary Sewer [LINE 1C]

Emerald Bay Estates
Sanitary Sewer
WICHITA, KANSAS

RB JOB 2822E

SHEET 4 OF 17