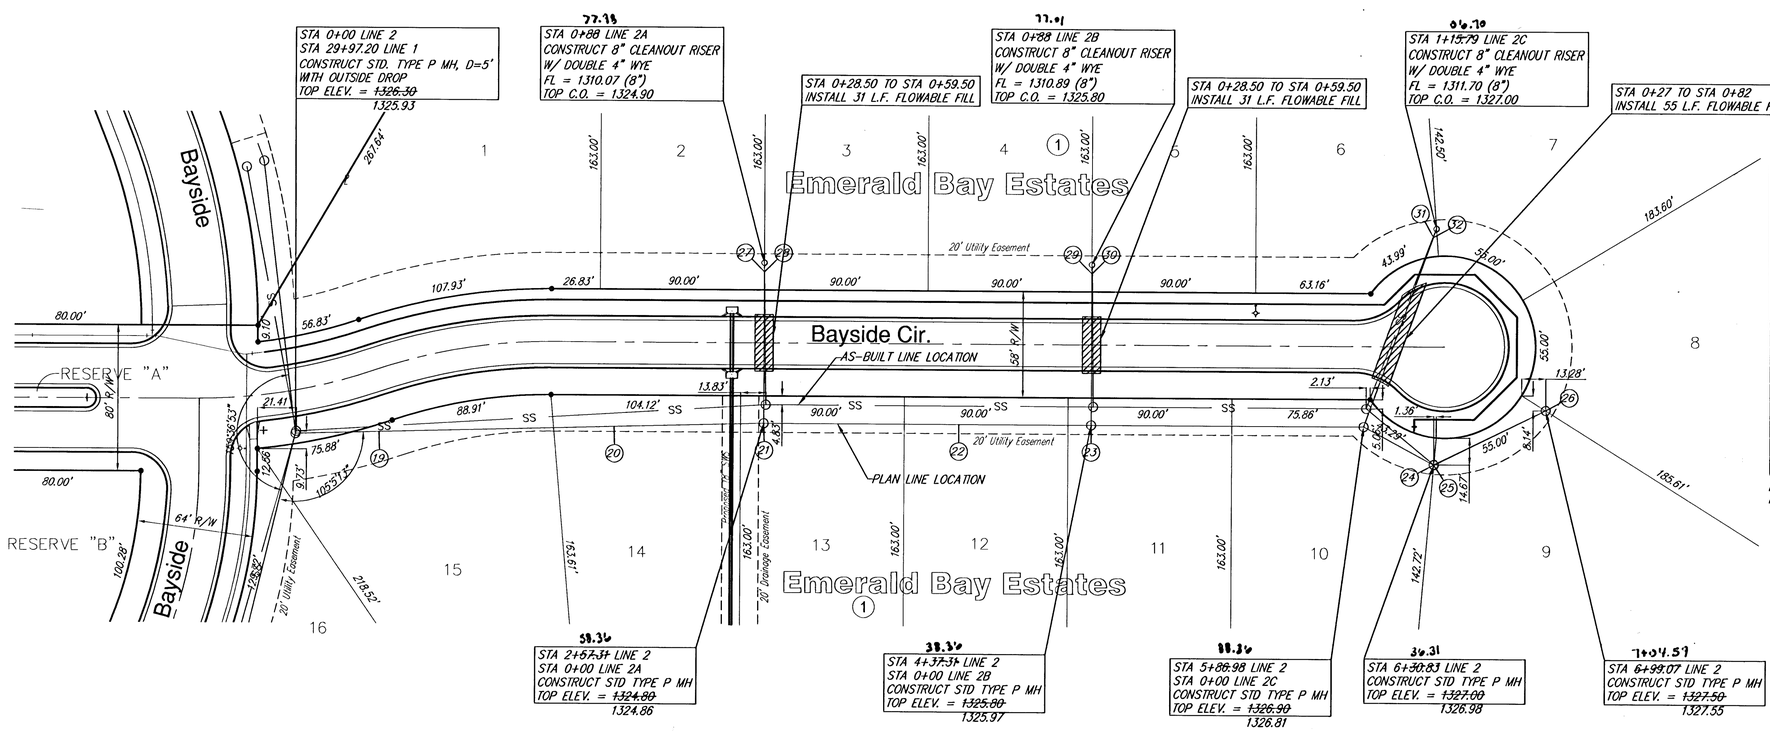

SEWER SERVICE TABLE

NUMBER	TYPE	LOCATION			STATION \ DIRECTION	FOR INFORMATION ONLY APPROXIMATE LENGTH 4" PIPE	
		LOT NO.	BLOCK NO.	LINE NO.		VERTICAL	HORIZONTAL
19	8" X 4" Tee Saddle	15	1	2	0+~~88~~/R 44	7'	10' 11'
20	8" X 4" Tee Saddle	14	1	2	1+~~25~~/R 73	6'	10' 11'
21	4" MH Riser	13	1	2	2+~~57~~/R 58	5'	10'
22	8" X 4" Tee Saddle	12	1	2	3+~~65~~/R 64	6'	10'
23	4" MH Riser	11	1	2	4+~~37~~/R 38	5'	10' 9.5'
24	4" MH Riser	10	1	2	6+~~31~~/R 36	5'	10'
25	4" MH Riser	9	1	2	6+~~31~~/R 36	5'	10' 9.5'
26	4" MH Riser	8	1	2	6+~~99~~/R 7+04	5'	10' 10.5'
27	8" X 4" Double Wye	2	1	2A	0+~~85~~/L 78	5'	10' 9'
28	8" X 4" Double Wye	3	1	2A	0+~~85~~/R 78	5'	10' 9.5'
29	8" X 4" Double Wye	4	1	2B	0+~~85~~/L 77	5'	10' 9.5'
30	8" X 4" Double Wye	5	1	2B	0+~~85~~/R 77	5'	10'
31	8" X 4" Double Wye	6	1	2C	1+~~31~~/L 07	5'	10' 9'
32	8" X 4" Double Wye	7	1	2C	1+~~31~~/R 07	5'	10'

NOTE: Vertical Riser Pipe shall be extended to 2' minimum above ground water elevation and 4' maximum below proposed ground elevation.

NOTE: ALL BACKFILL FOR SHALL BE SAND FLUSHED AND VIBRATED.

SCALE 1" = 40' HORIZ.
1" = 5' VERT.
IRON = ●

"AS-BUILT"
12-4-07 RB
3-15-07 AML
12-7-07 AML

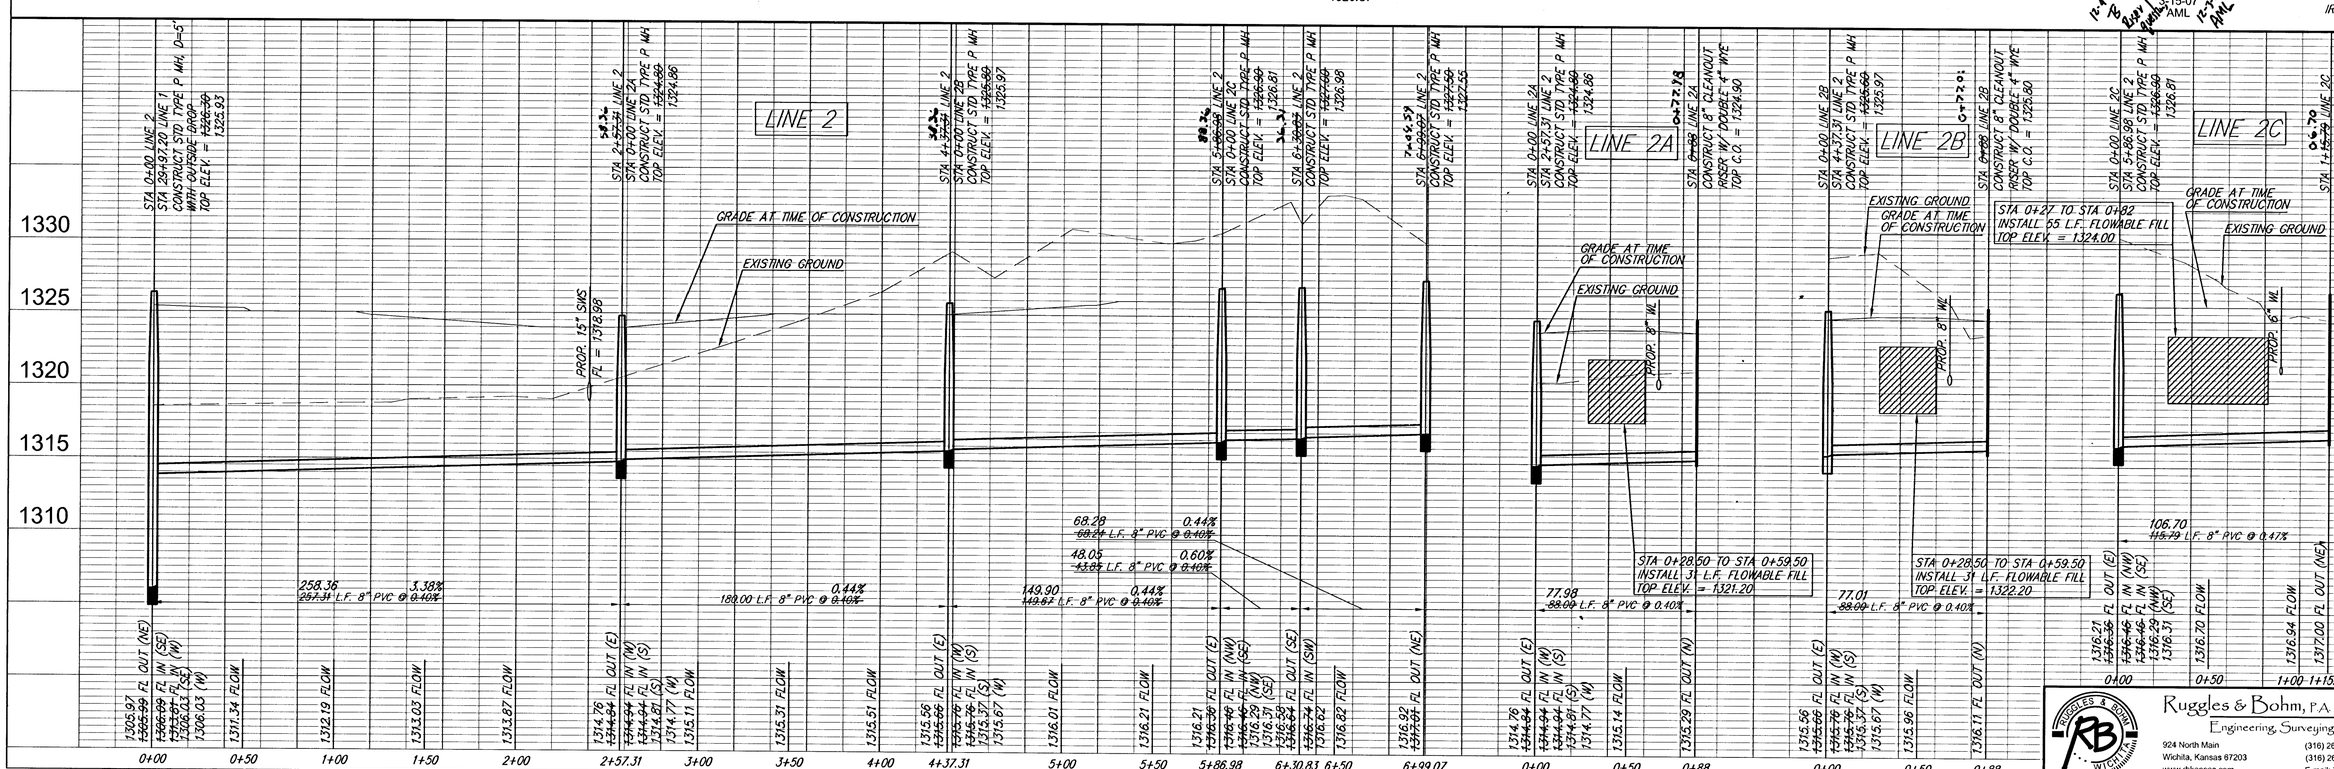

Ruggles & Bohm, P.A.
Engineering, Surveying, Land Planning
924 North Main
Wichita, Kansas 67203
www.rbkansas.com
(316) 264-8008
(316) 264-4621 fax
E-mail: info@rbkansas.com

DESIGN AML | DRAWN MLP | REVISED | REVIEW
UTILITY | DATE Jan. 5, 2006

PROJECT NUMBER 468-84139
DRAWING FILE Sanitary Sewer (LINE 2A-D)

Emerald Bay Estates
Sanitary Sewer
WICHITA, KANSAS

RB JOB 2822E
SHEET 5 OF 17