



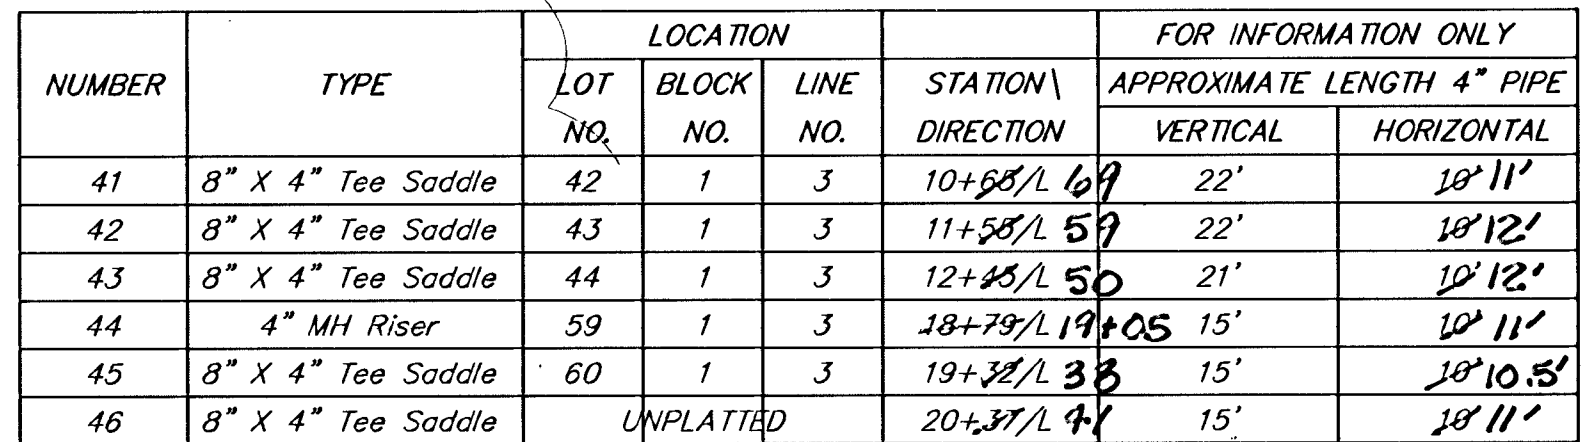

SANITARY SEWER EASEMENT
(BY SEPERATE INSTRUMENT)

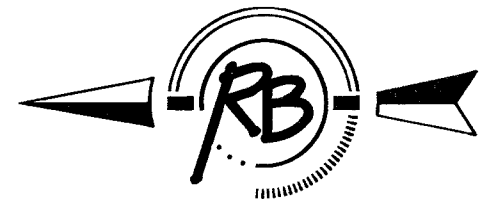

17 7 2822E RB JOB	17 7 2822E SHEET	Emerald Bay Estates Sanitary Sewer WICHITA, KANSAS	PROJECT NUMBER 468-84139	DESIGN AML	DRAWN MLP	REVISED
			DRAWING FILE Sanitary Sewer \$LINE 3-21			UTILITY DATE

