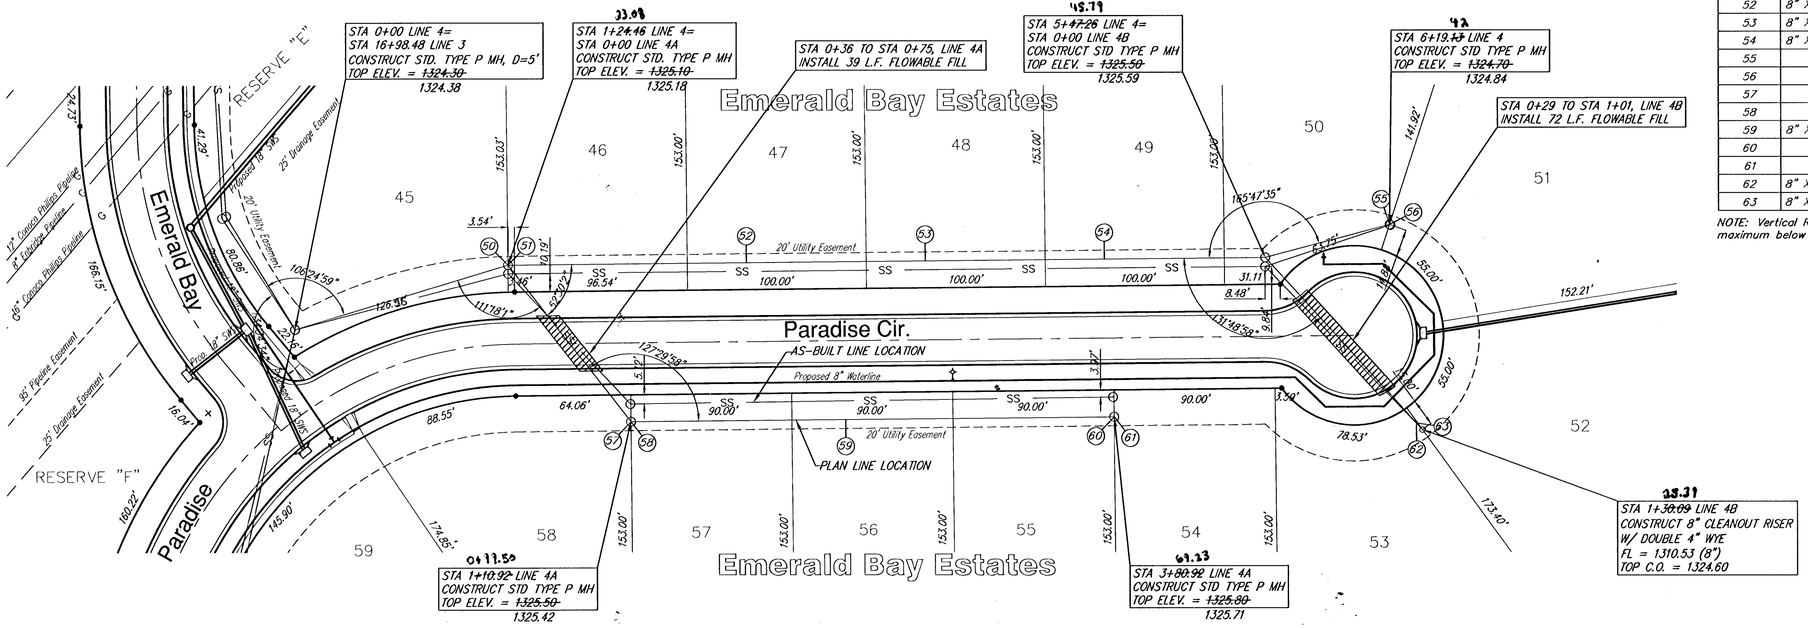

SEWER SERVICE TABLE

NUMBER	TYPE	LOCATION			STATION\ DIRECTION	FOR INFORMATION ONLY APPROXIMATE LENGTH 4" PIPE	
		LOT NO.	BLOCK NO.	LINE NO.		VERTICAL	HORIZONTAL
50	4" MH Riser	45	1	4	1+24/L 23	6'	~~10'~~ 11'
51	4" MH Riser	46	1	4	1+24/L 23	6'	~~10'~~ 10.5'
52	8" X 4" Tee Saddle	47	1	4	2+57/L 54	6'	~~10'~~ 10.5'
53	8" X 4" Tee Saddle	48	1	4	3+57/L 55	6'	~~10'~~ 9.5'
54	8" X 4" Tee Saddle	49	1	4	4+57/L 56	5'	~~10'~~ 9.5'
55	4" MH Riser	50	1	4	6+19/L	3'	~~10'~~ 11.5'
56	4" MH Riser	51	1	4	6+19/L	3'	~~10'~~ 12'
57	4" MH Riser	58	1	4A	1+11/R 01+99	5'	10'
58	4" MH Riser	57	1	4A	1+11/R 01+99	5'	~~10'~~ 9.5'
59	8" X 4" Tee Saddle	56	1	4A	2+31/R 20	5'	~~10'~~ 10.5'
60	4" MH Riser	55	1	4A	3+81/R 69	4'	~~10'~~ 11'
61	4" MH Riser	54	1	4A	3+81/R 69	4'	~~10'~~ 10.5'
62	8" X 4" Double Wye	53	1	4B	1+30/L	3'	~~10'~~ 9'
63	8" X 4" Double Wye	52	1	4B	1+30/R	3'	~~10'~~ 9'

NOTE: Vertical Riser Pipe shall be extended to 2' minimum above ground water elevation and 4' maximum below proposed ground elevation.

NOTE: ALL BACKFILL FOR SHALL BE SAND FLUSHED AND VIBRATED.

"AS-BUILT"
3-15-07
AML

SCALE 1" = 40' HORIZ.
1" = 5' VERT.
IRON = ●

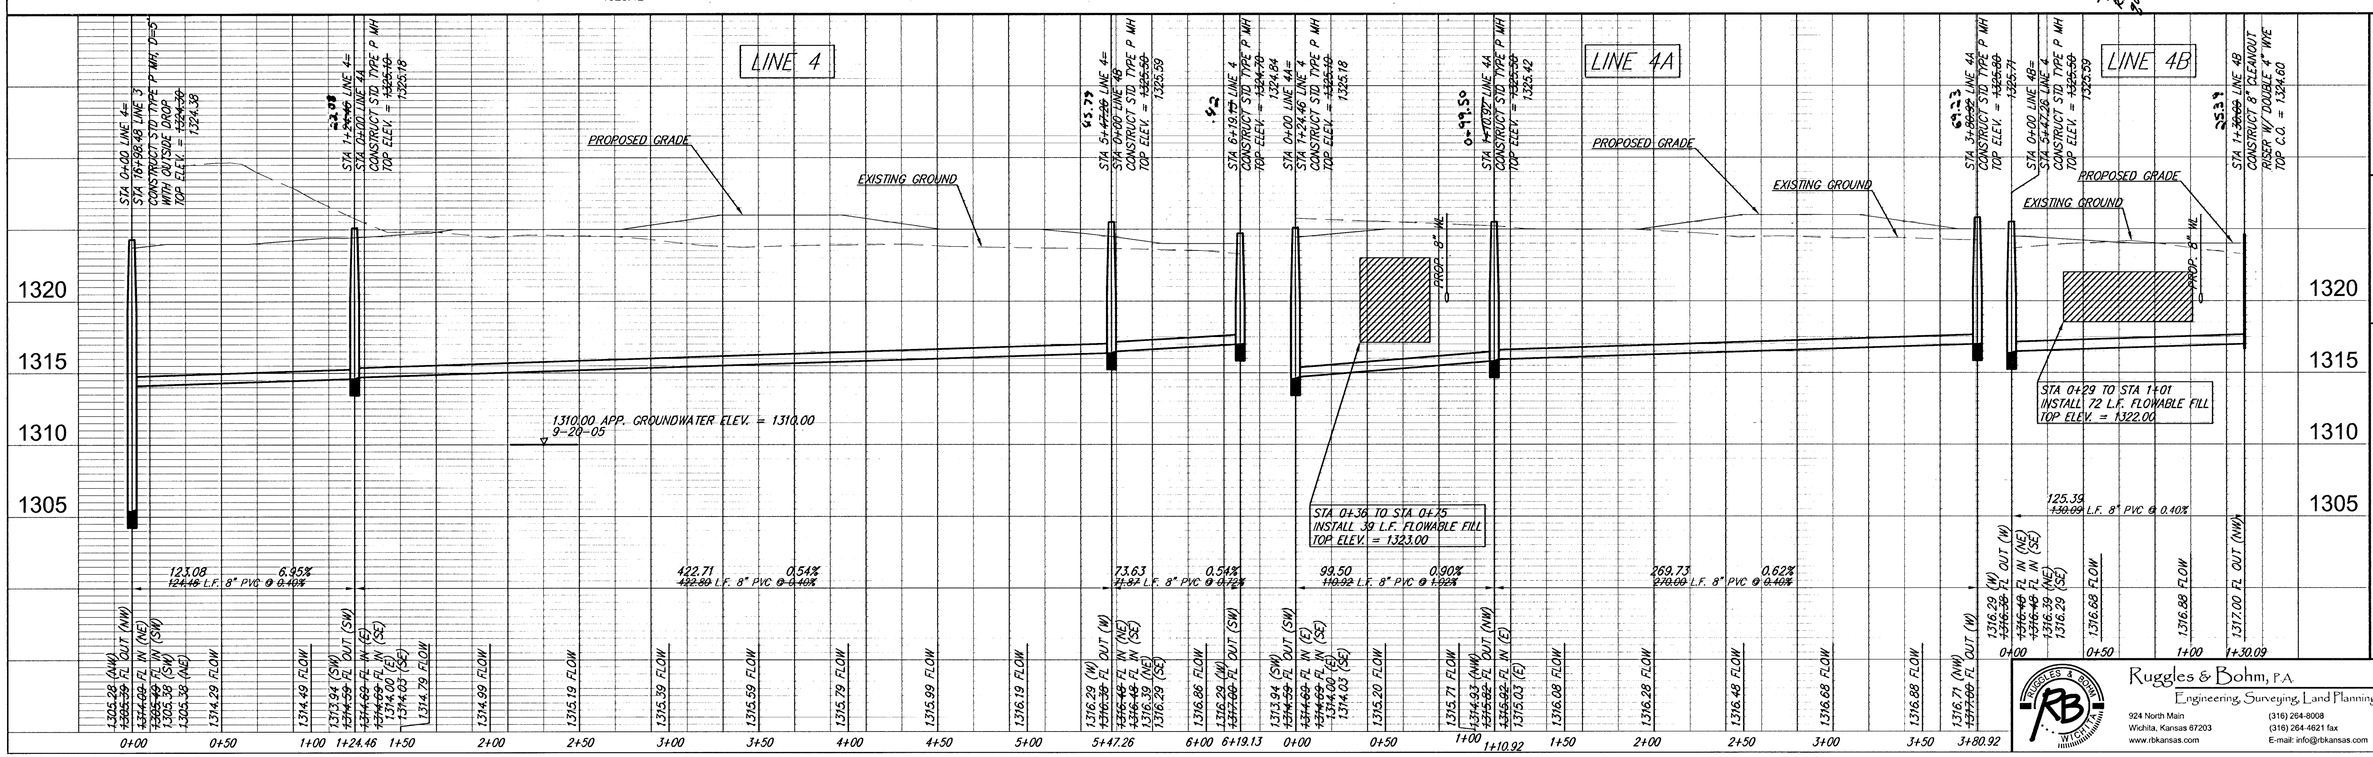

Emerald Bay Estates
Sanitary Sewer
WICHITA, KANSAS

DESIGN	DRAWN	REVISED
AML	MLP	
UTILITY	DATE	REVIEW
	Jan. 5, 2006	

PROJECT NUMBER 468-84139
DRAWING FILE Sanitary Sewer (LINE 4-4C)

Ruggles & Bohm, P.A.
Engineering Surveying Land Planning
924 North Main
Wichita, Kansas 67203
www.rbkansas.com
(316) 264-8008
(316) 264-4621 fax
E-mail: info@rbkansas.com

R9 JOB 2822E
SHEET 9 of 17