




FHWA REGION NO.	STATE	PROJECT NO.	YEAR	SHEET NO.	TOTAL SHEETS
7	KANSAS	54-87 K-6657-01	2002	10	1122

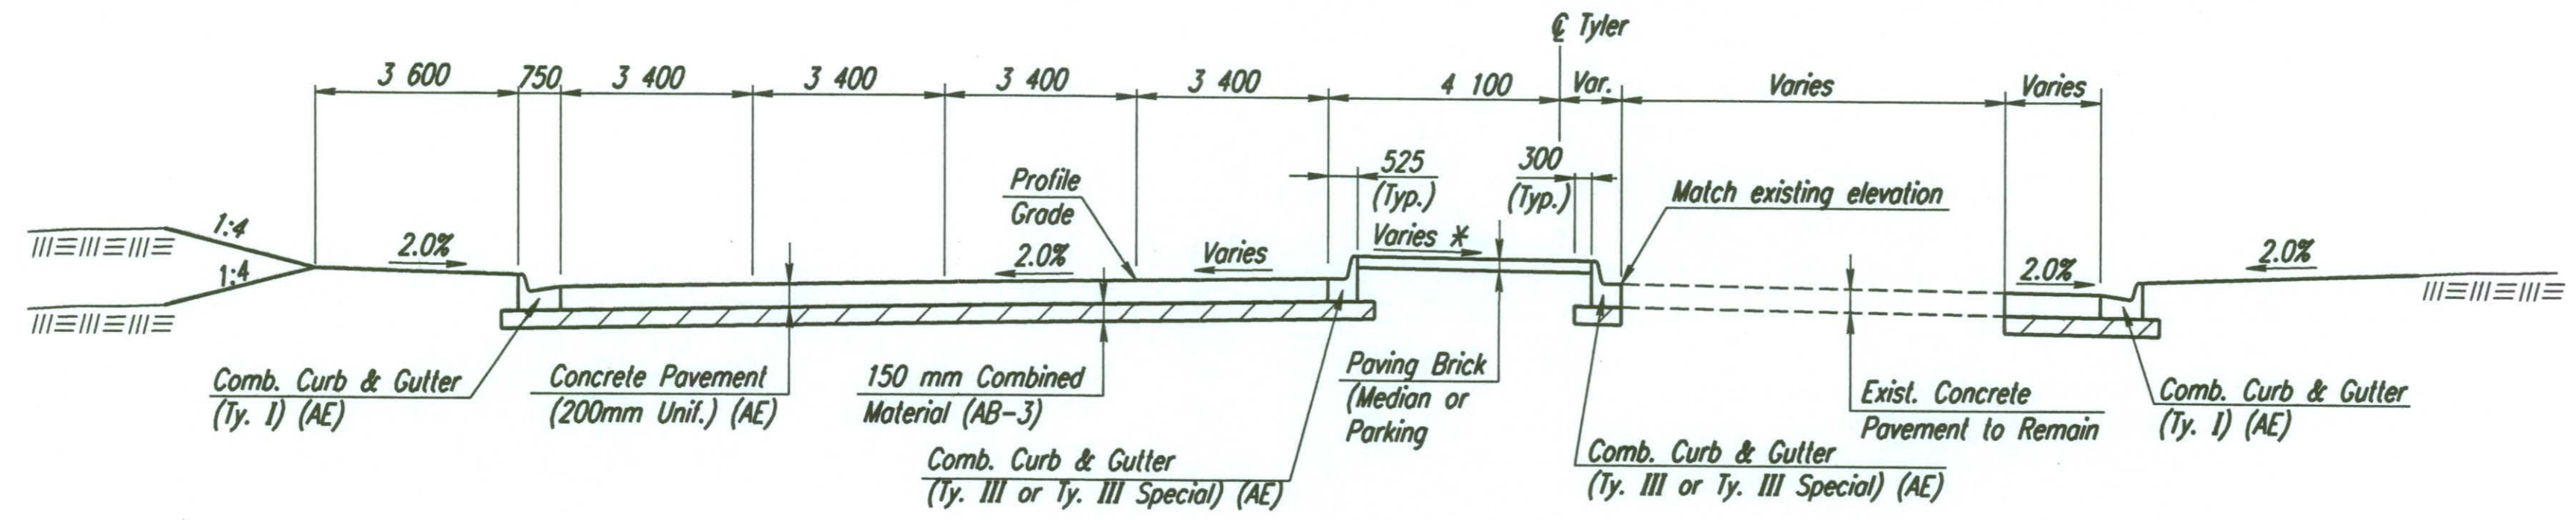


TYPICAL SECTION
Sta. 5+041.498 to Sta. 5+086.656 Lt.
Sta. 5+058.000 to Sta. 5+086.045 Rt.

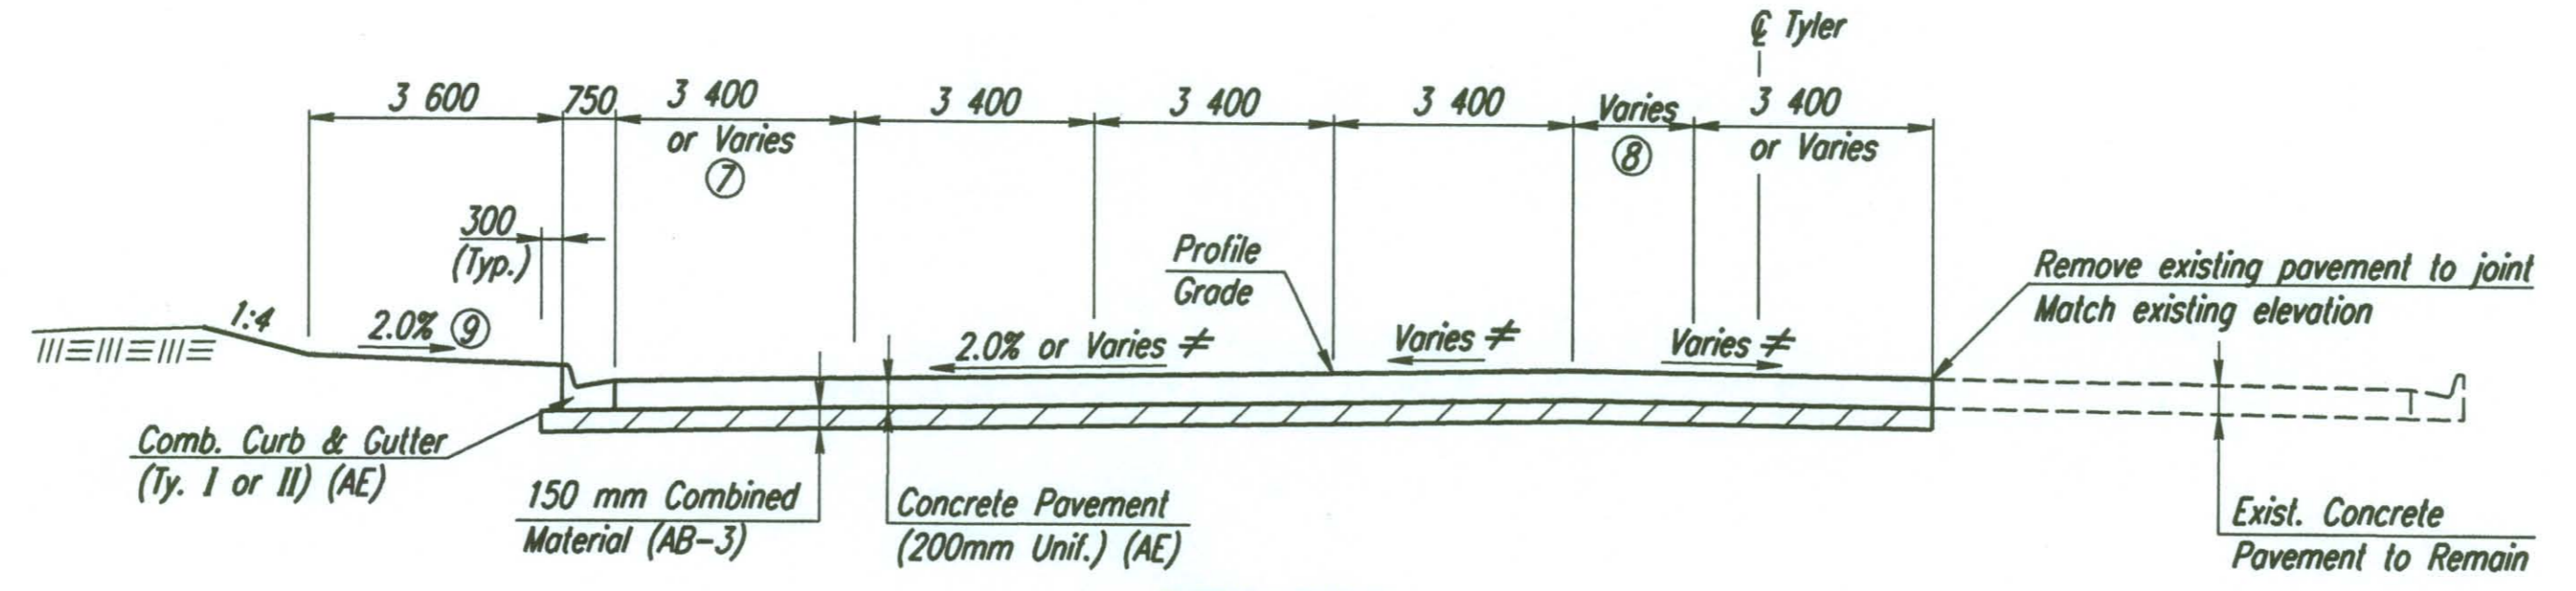

TYPICAL SECTION
Sta. 5+086.045 to Sta. 5+278.230

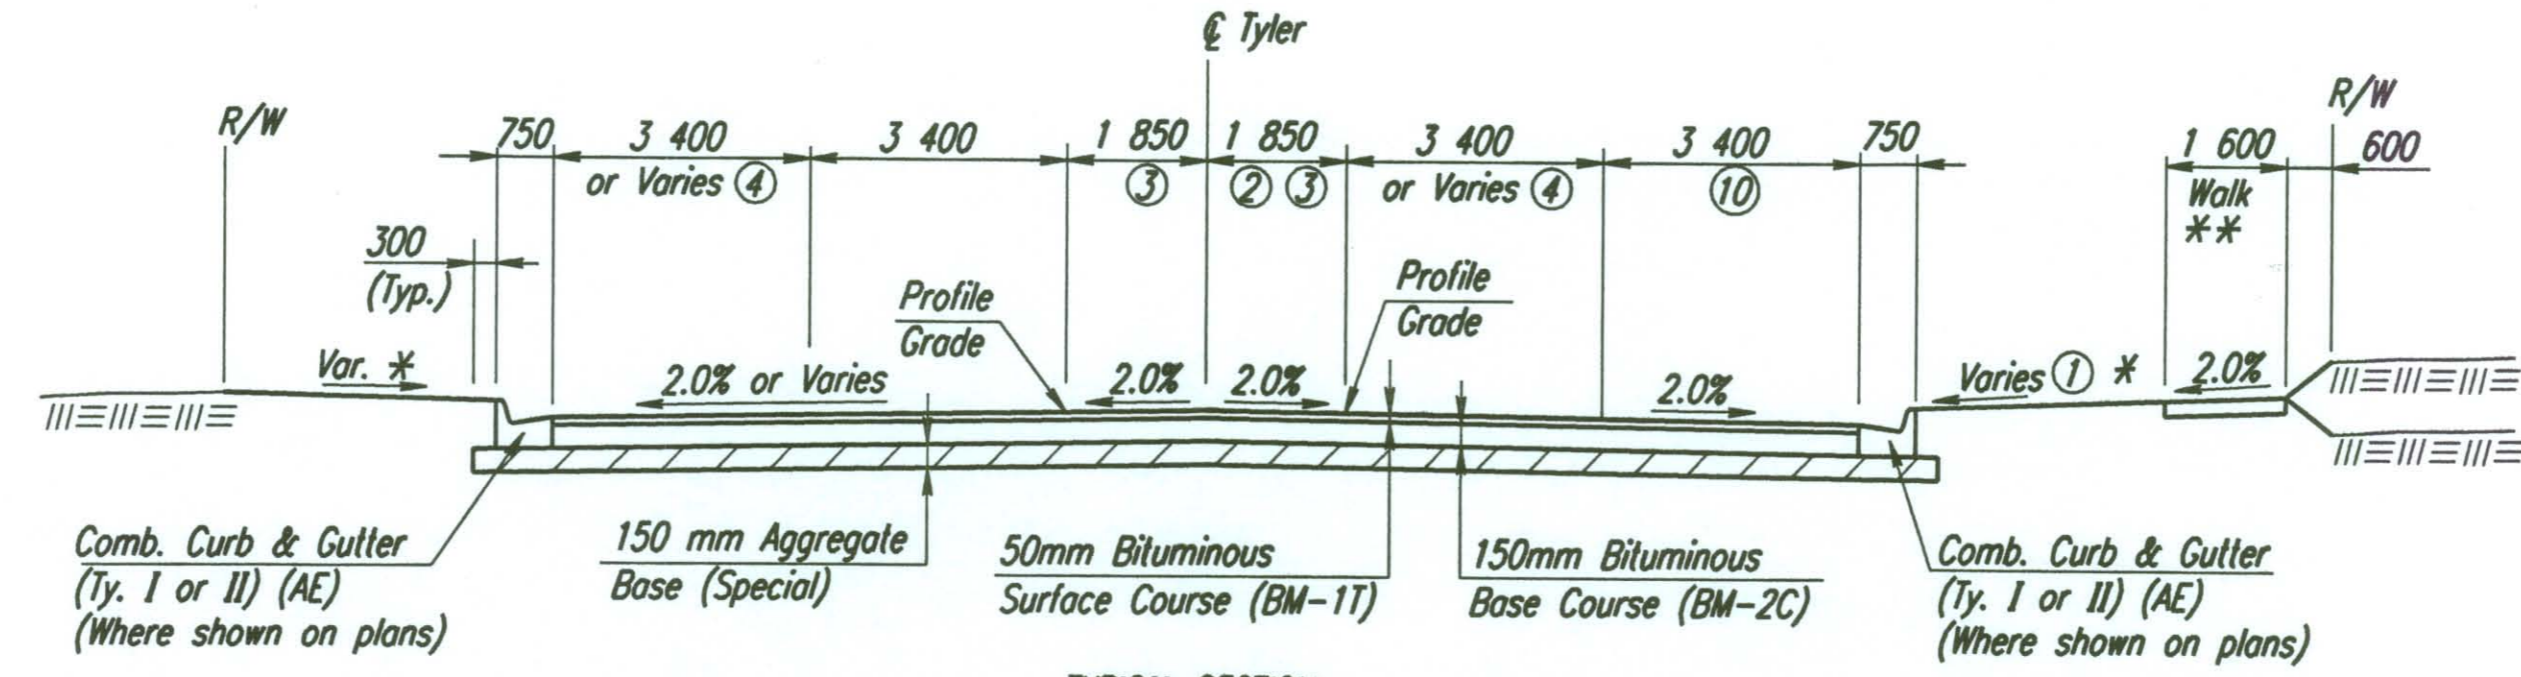

TYPICAL SECTION
Sta. 5+278.320 to Sta. 5+655.000

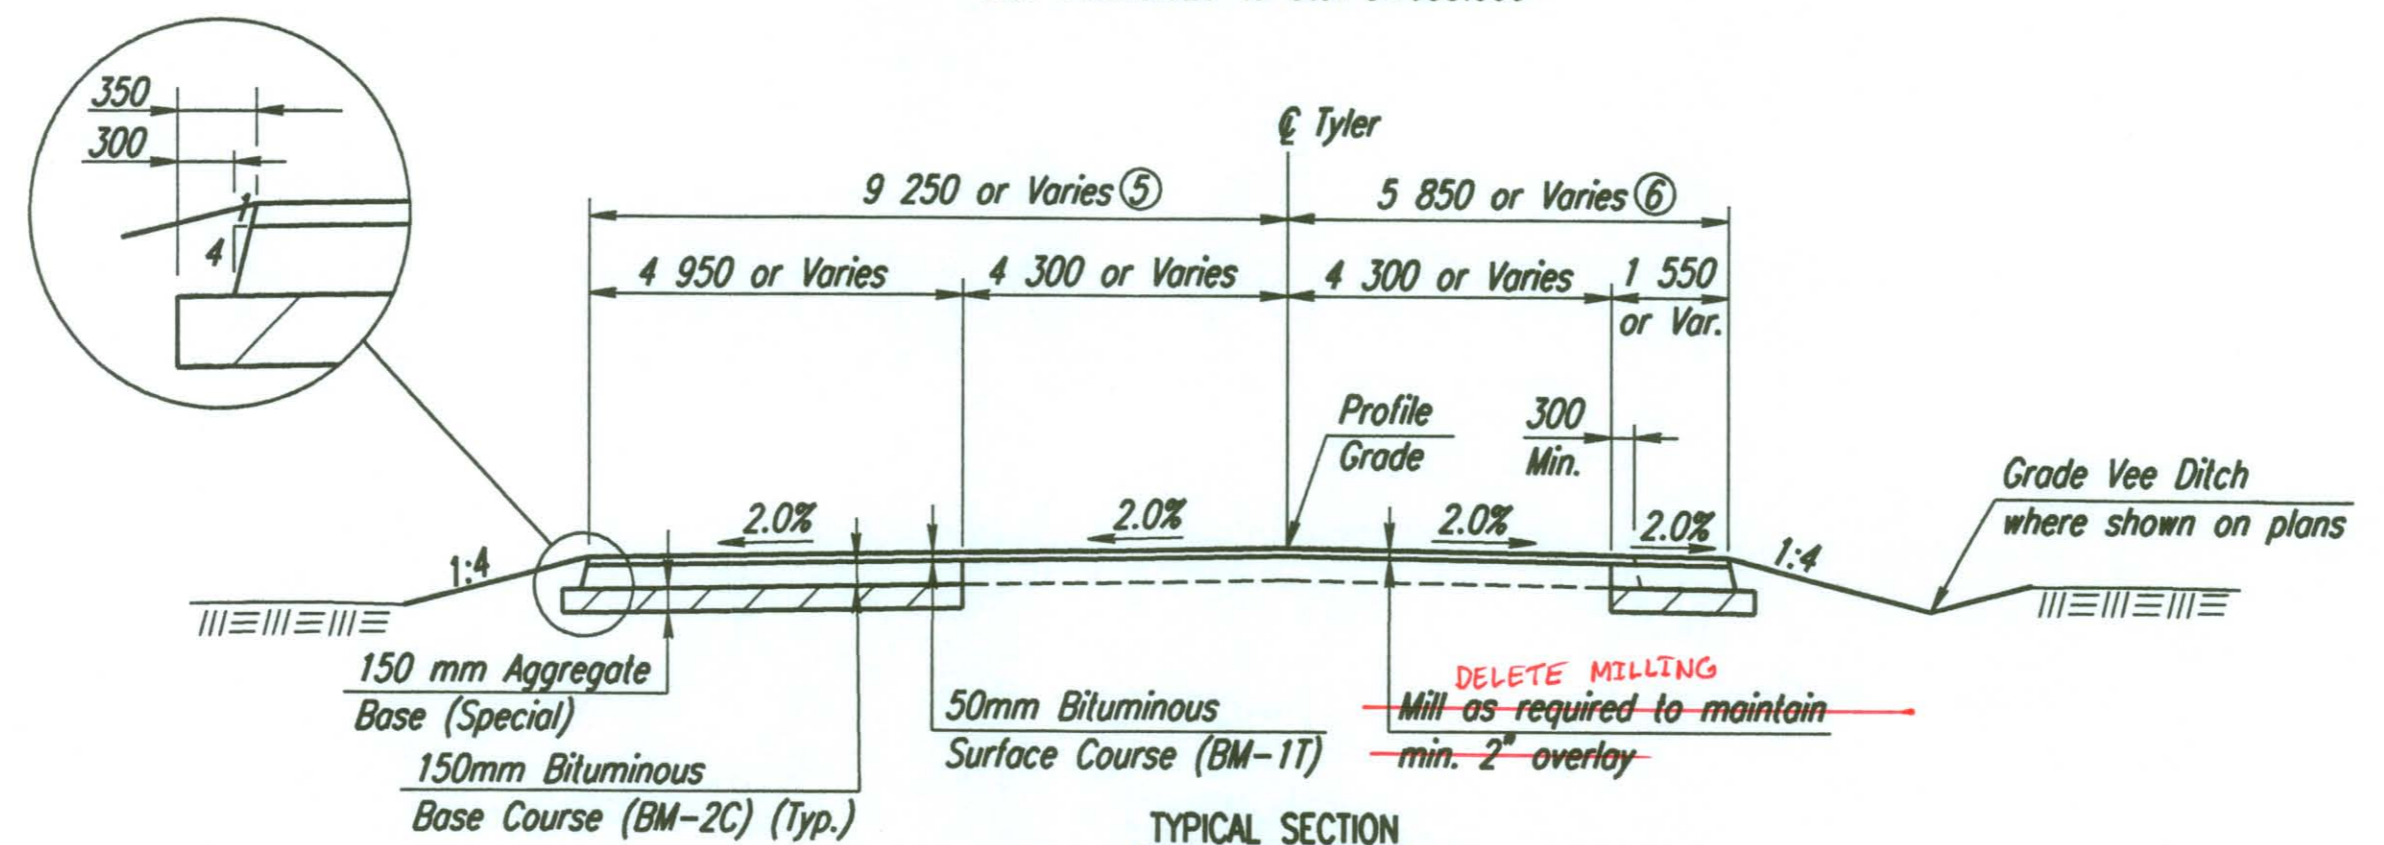

TYPICAL SECTION
Sta. 5+655.000 to Sta. 5+787.965

- ≠ See paving plans for elevations.
- * See x-sections for variations.
- ** Where shown on plans.
- ① From Sta. 5+300 to Sta. 5+440 and from Sta. 5+530 to Sta. 5+600 the front edge of sidewalk is 50mm above curb height. See x-sections for other stations.
- ② @ Roadway varies from 1.850m Lt. @ Sta. 5+350 to 0.0m Lt. @ Sta. 5+424.
- ③ Varies from 1.85m @ Sta. 5+560 to 0.0m @ Sta. 5+595.
- ④ Varies from 3.40m @ Sta. 5+560 to 5.25m @ Sta. 5+595.
- ⑤ Varies from 9.25m @ Sta. 5+672.547 to 4.00m @ Sta. 5+787.965.
- ⑥ Varies from 5.85m @ Sta. 5+706.466 to 4.0m @ Sta. 5+787.965.
- ⑦ Varies from 3.4m @ Sta. 5+114.342 to 0.0m @ Sta. 5+137.271.
- ⑧ Lane ends at St. 5+173.670.
- ⑨ At Sta. 5+165 the slope will vary from the back of curb to the right-of-way line. See cross sections.
- ⑩ Lane ends at intersection of Tyler & Harry

DATE	
BY	
REFERENCES NOTED	
REFERENCES CHECKED	

DSNR: RCH OPER: JCP SCALE: 1:100
 I:/1997/97362/TYPSECT/TYLERTYP.DGN 10-25-2001 14:50:18 LAST REV: 12-27-01 BY: JCP

Revisions		By	Date
CITY OF WICHITA			
TYPICAL SECTIONS TYLER ROAD			
SEDGWICK COUNTY			
Professional Engineering Consultants, P.A. 303 S. TOPEKA • WICHITA, KANSAS 67202 316-262-2691 • FAX 316-262-3003			
Designed by	RCH	Checked by	WDH
Drawn by	JCP	Date	April, 2002
		Job No.	97362