



DATE	
BY	
REFERENCES NOTED	
REFERENCES CHECKED	

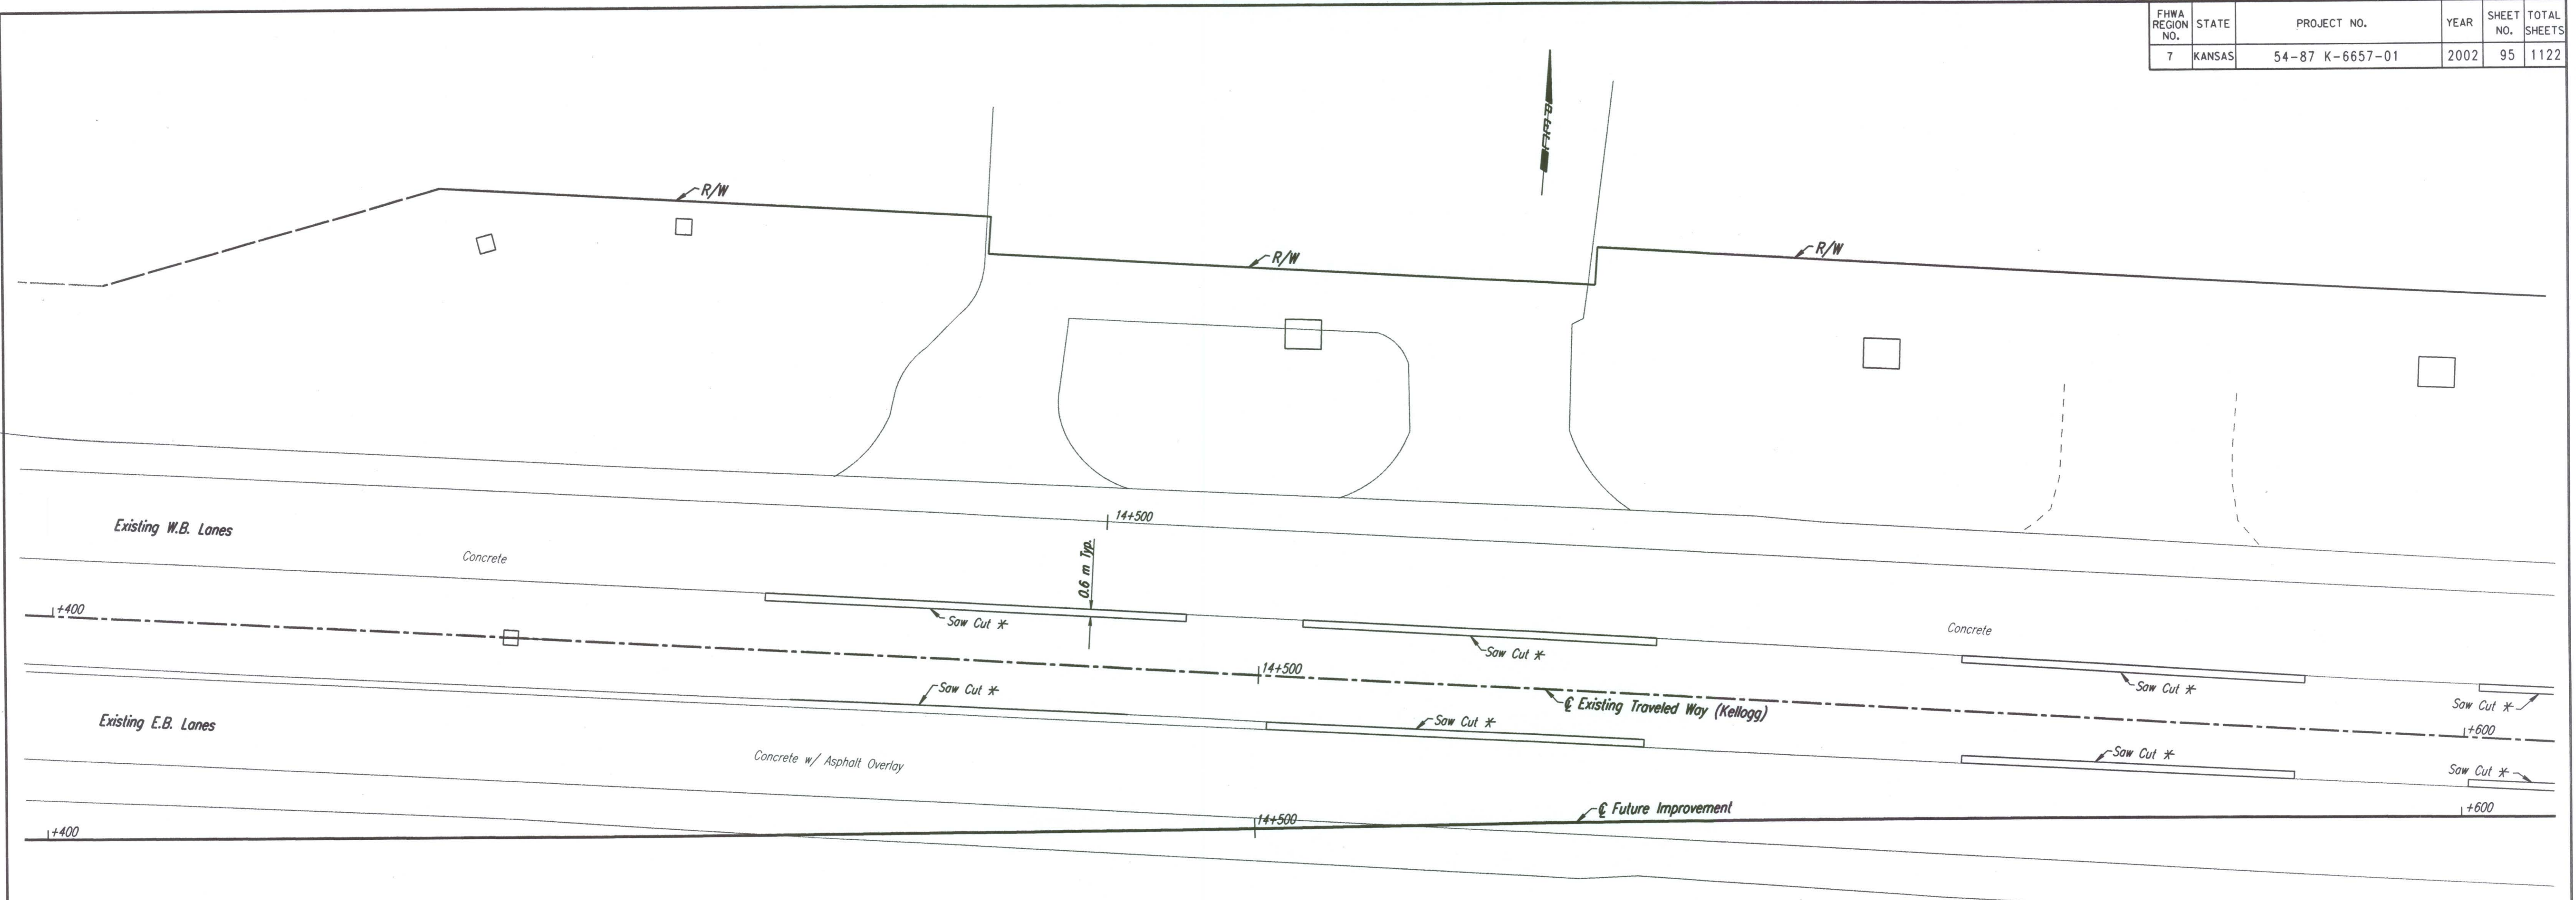

- CONCRETE PAVEMENT JOINT TYPES:**
- A) CONTRACTION JOINT with #16 x 600mm DEFORMED TIE BARS & SAWN.
 - B) CONTRACTION JOINT with #16 x 600mm DEFORMED TIE BARS ONLY.
 - C) CONTRACTION JOINT: KEYWAY ONLY.
 - D) CONTRACTION JOINT with KEYWAY & #16 x 600mm DEFORMED TIE BARS.
 - E) CONTRACTION JOINT with SMOOTH DOWEL BARS:
 - 1) 200mm PCCP = 25mm x 450mm.
 - 2) 260mm PCCP = 32mm x 450mm.
 - F) CONTRACTION JOINT: NON-TIED.
 - G) CONTRACTION JOINT along curb & gutter with #16 x 900mm EPOXY COATED DEFORMED TIE BARS.
 - H) CONTRACTION JOINT with SMOOTH DOWEL BARS:
 - 1) 200mm PCCP = 25mm x 450mm.
 - 2) 260mm PCCP = 32mm x 450mm.
 - I) CONTRACTION JOINT (mainline outside shoulder only) with 2-#16 continuous epoxy deformed bars left uncut & SAWN.
 - J) CONTRACTION JOINT (outside shoulder) with 2-#16 continuous epoxy deformed bars.
 - K) CONTRACTION JOINT (inside or outside shoulder) NON-TIED & SAWN.
 - L) EXPANSION JOINT (19mm).
 - M) CONTRACTION JOINT along curb/gutter with KEYWAY & #16 x 900mm TIE BARS.

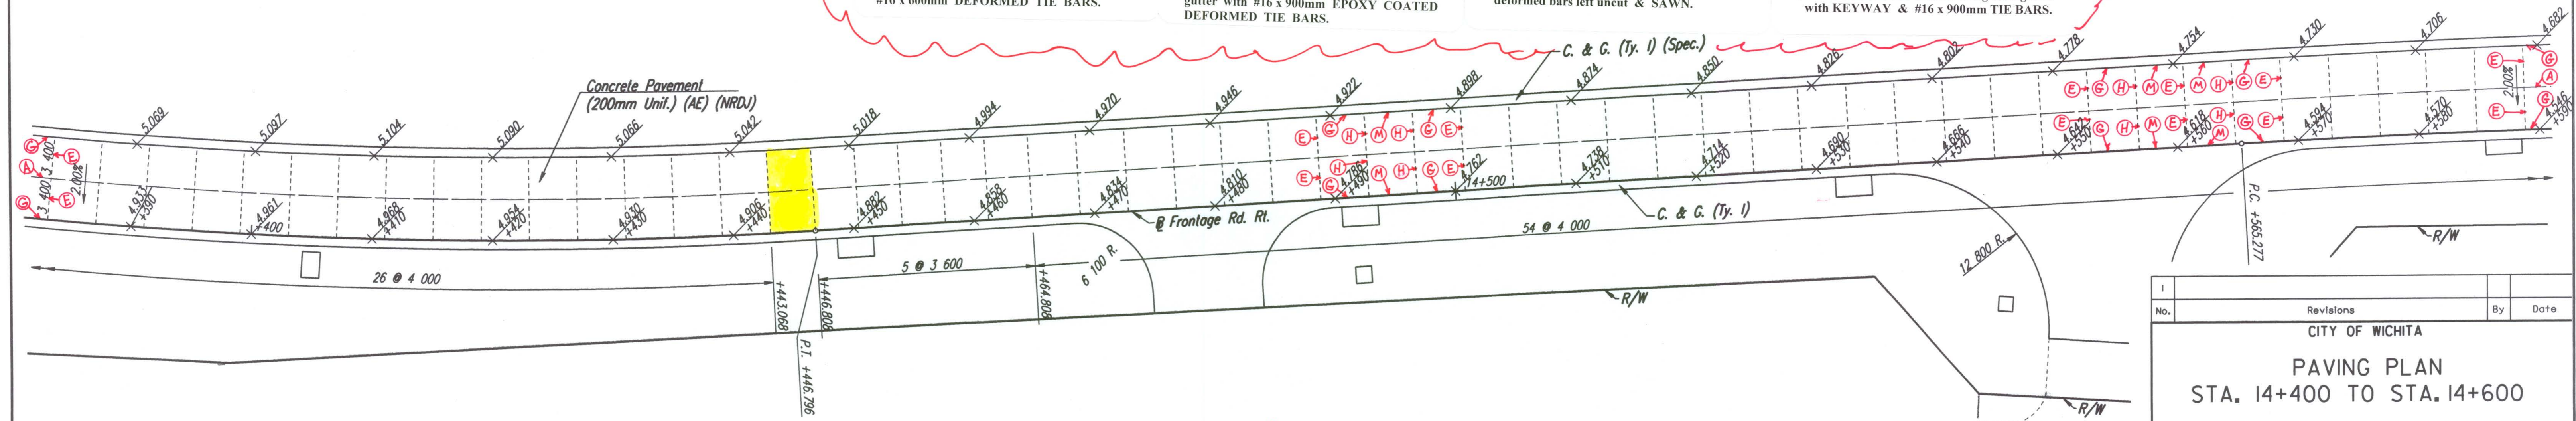

* REMOVED & REPLACED
 * Saw cut to a neat line at median crossover locations.

DSNR: WDH OPER: JGP SCALE: 1:250
 i:/1997/97362/PAVING/PAV144.DGN 1-31-2001 15:02:54 LAST REV: 11-21-01 BY: JGP

1			
No.	Revisions	By	Date
CITY OF WICHITA PAVING PLAN STA. 14+400 TO STA. 14+600 SEDGWICK COUNTY			
Professional Engineering Consultants, P.A. <small>303 S. TOPEKA • WICHITA, KANSAS 67202 316-262-2691 • FAX 316-262-3003</small>			
Designed by	WDH	Checked by	WDH
Drawn by	JGP	Date	Apr 11, 2002
		Job No.	97362