
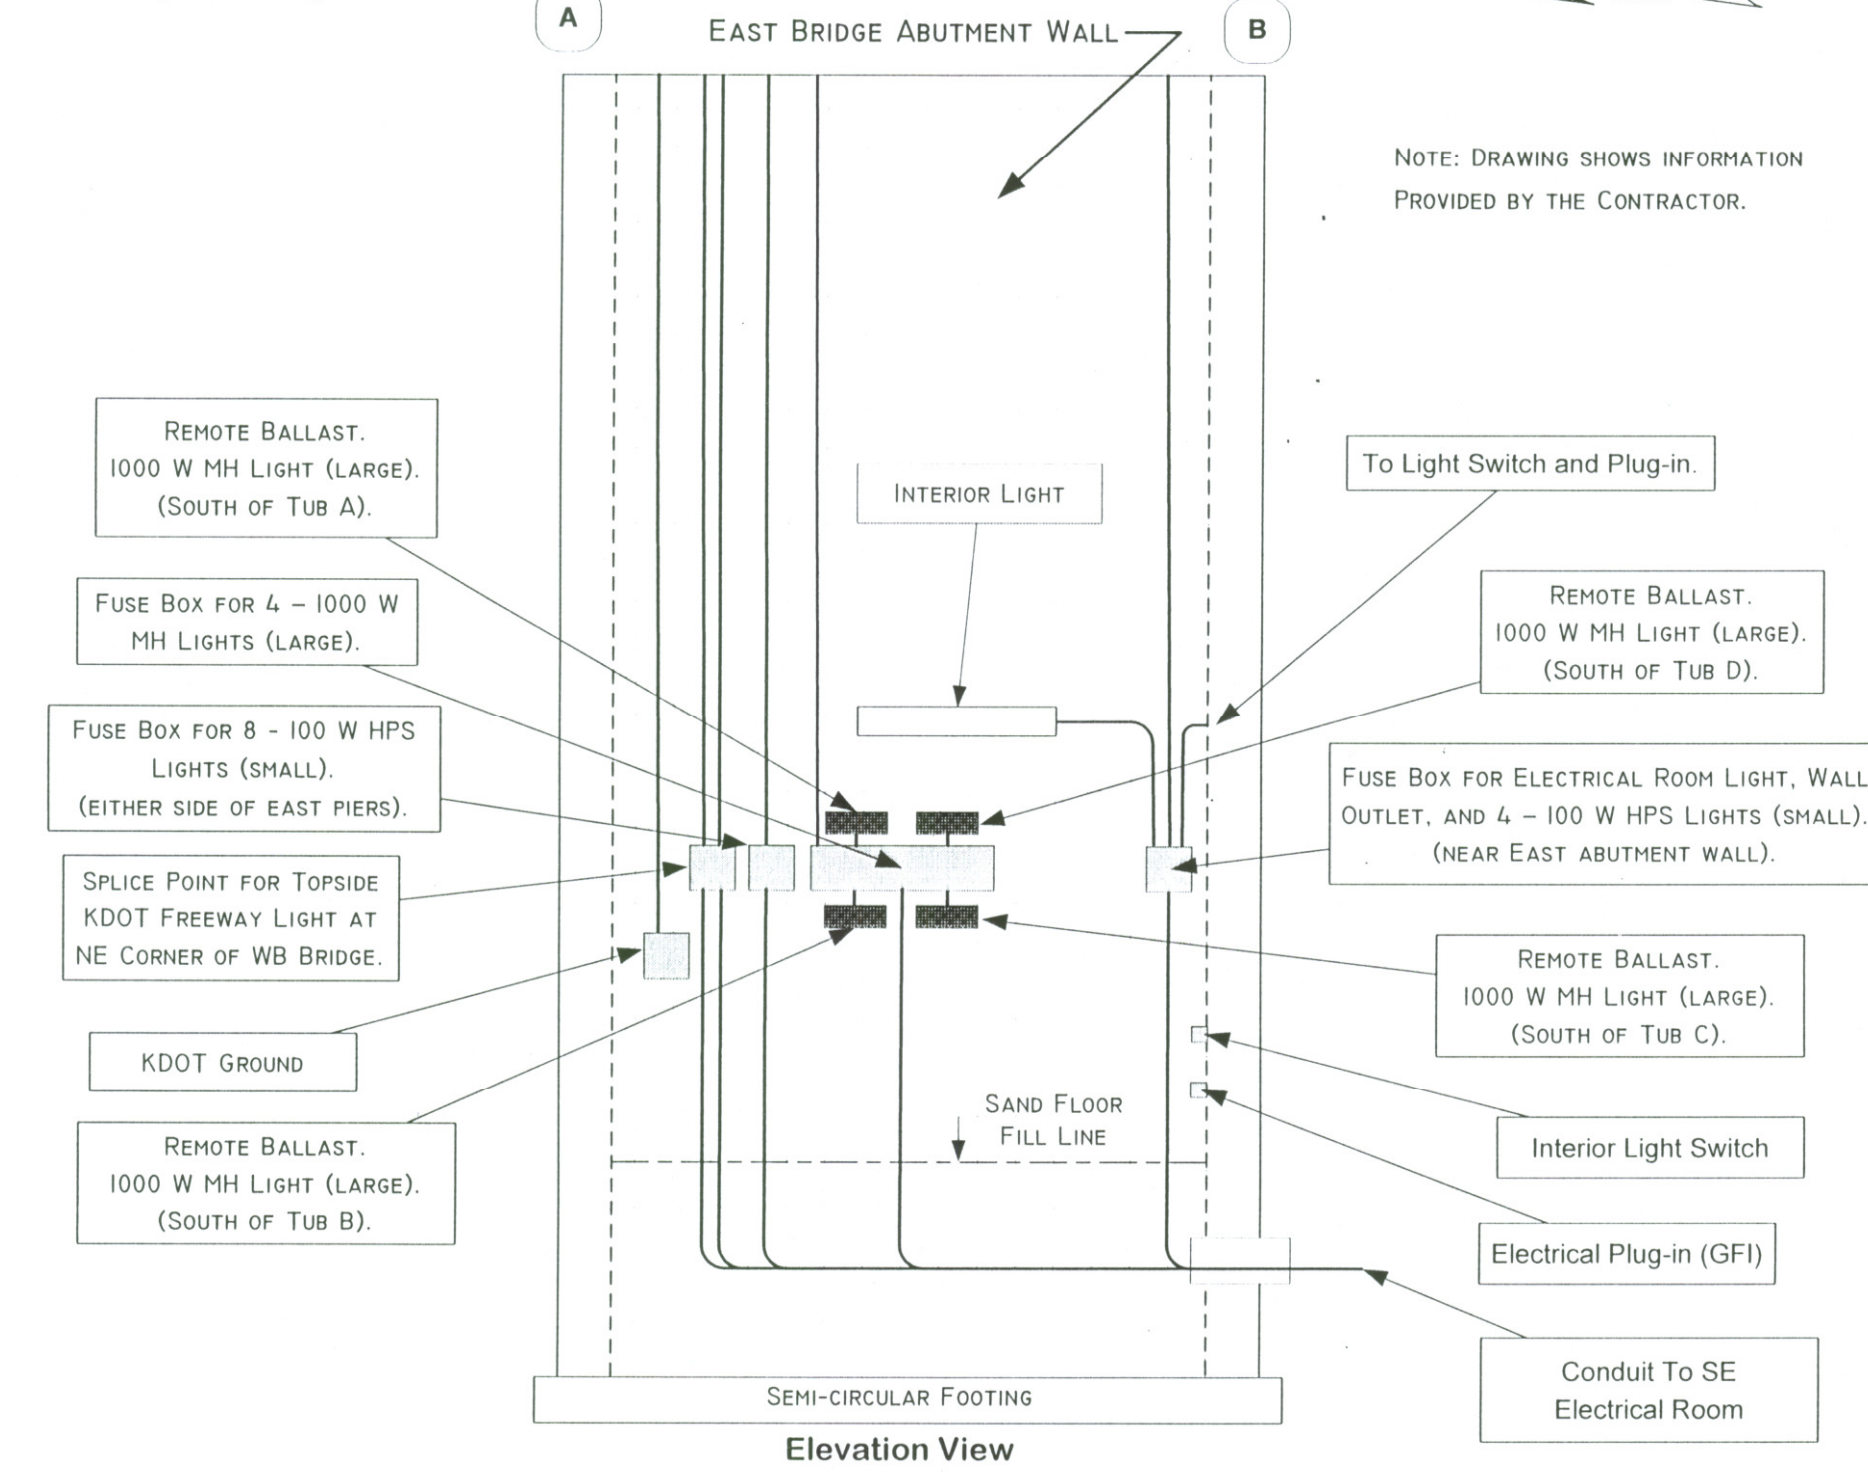


FHWA REGION NO.	STATE	PROJECT NO.	YEAR	SHEET NO.	TOTAL SHEETS
7	KANSAS	54 - 87 K - 6657 - 01	2002	646C	1122

## BRIDGE ELECTRICAL ROOM LAYOUT @ TYLER ROAD



WEST KELLOGG FREEWAY - MAIZE AND TYLER ROAD INTERCHANGES  
 CITY OF WICHITA PROJECT NO: 472 - 83533  
 K.D.O.T. PROJECT NO: 54 - 87 K 6657 - 01

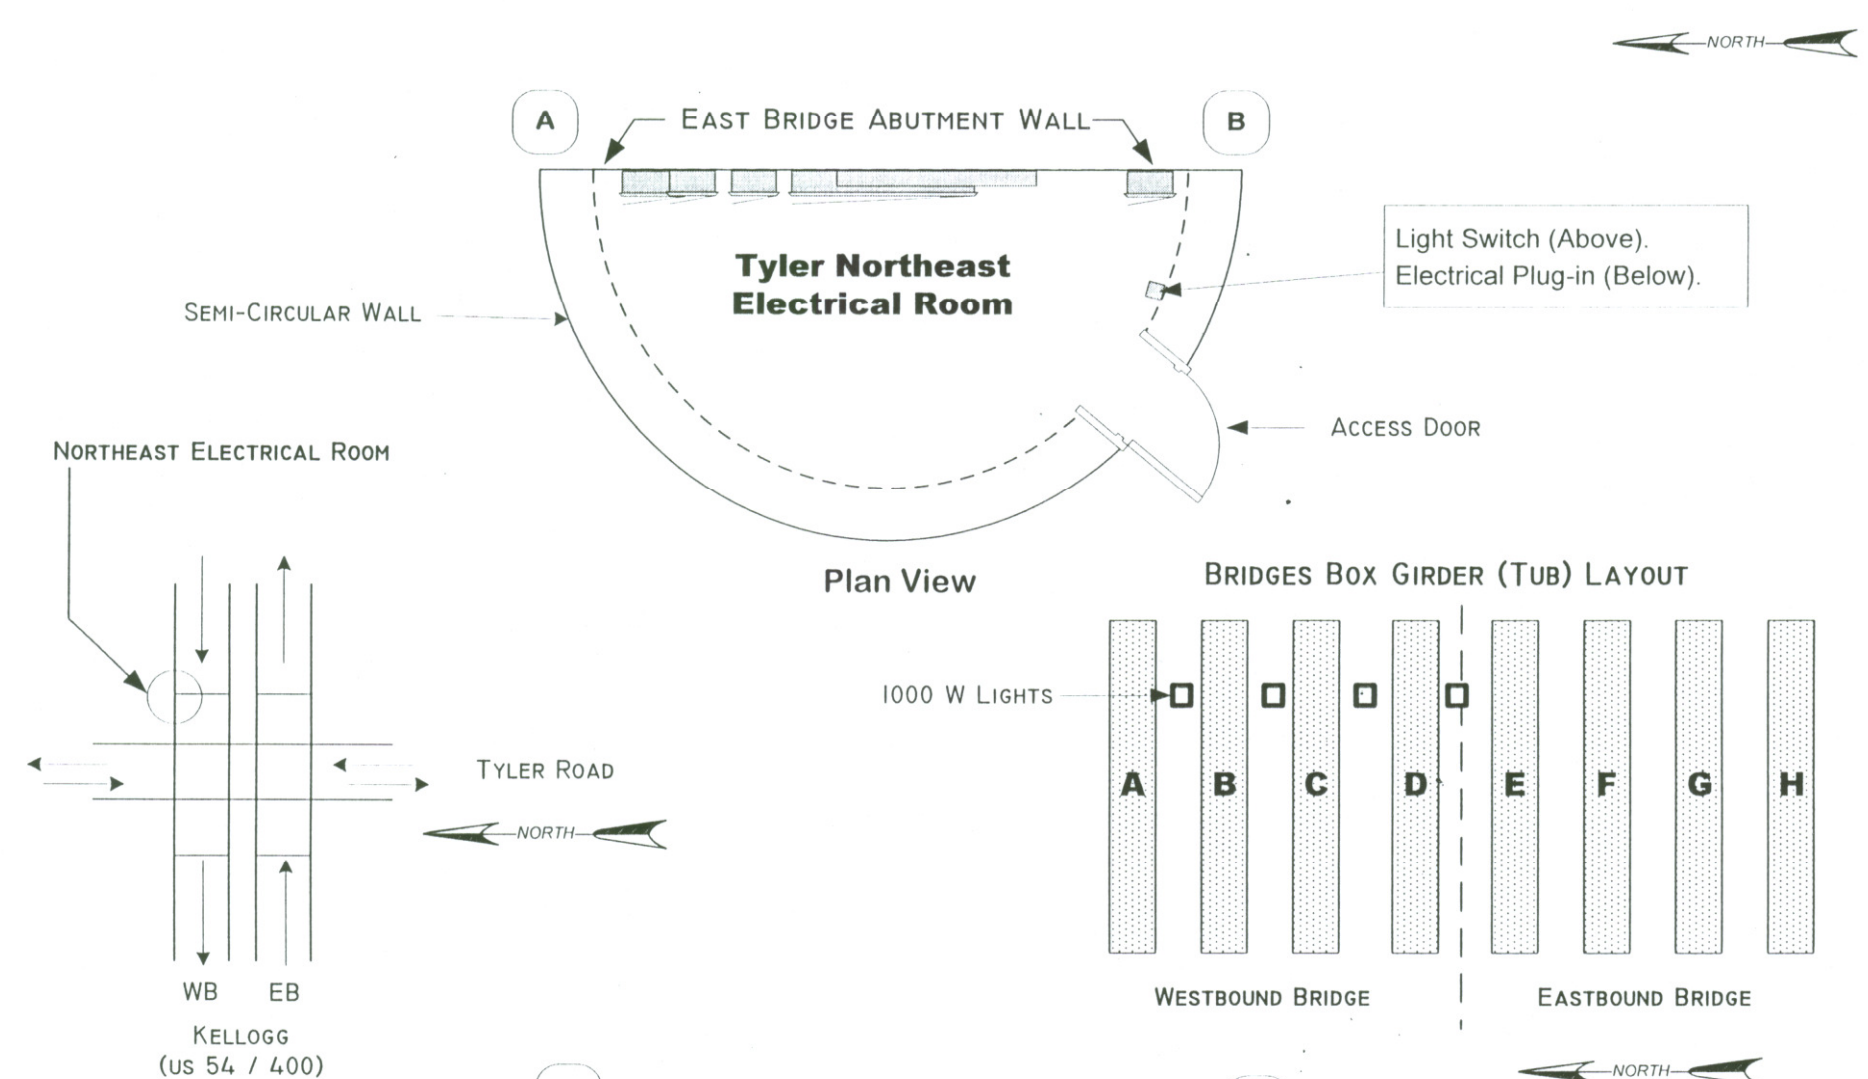

NOTE: 1000 W MH AND 100 W HPS LIGHTS ARE "UNDER BRIDGE LIGHTS" BELOW EAST HALF OF BRIDGE No. 54 - 87 - 20.13 (496) WB KELLOGG.

## BRIDGE ELECTRICAL ROOM LAYOUT @ TYLER ROAD

WEST KELLOGG FREEWAY - MAIZE AND TYLER ROAD INTERCHANGES  
 CITY OF WICHITA PROJECT NO: 472 - 83533  
 K.D.O.T. PROJECT NO: 54 - 87 K 6657 - 01

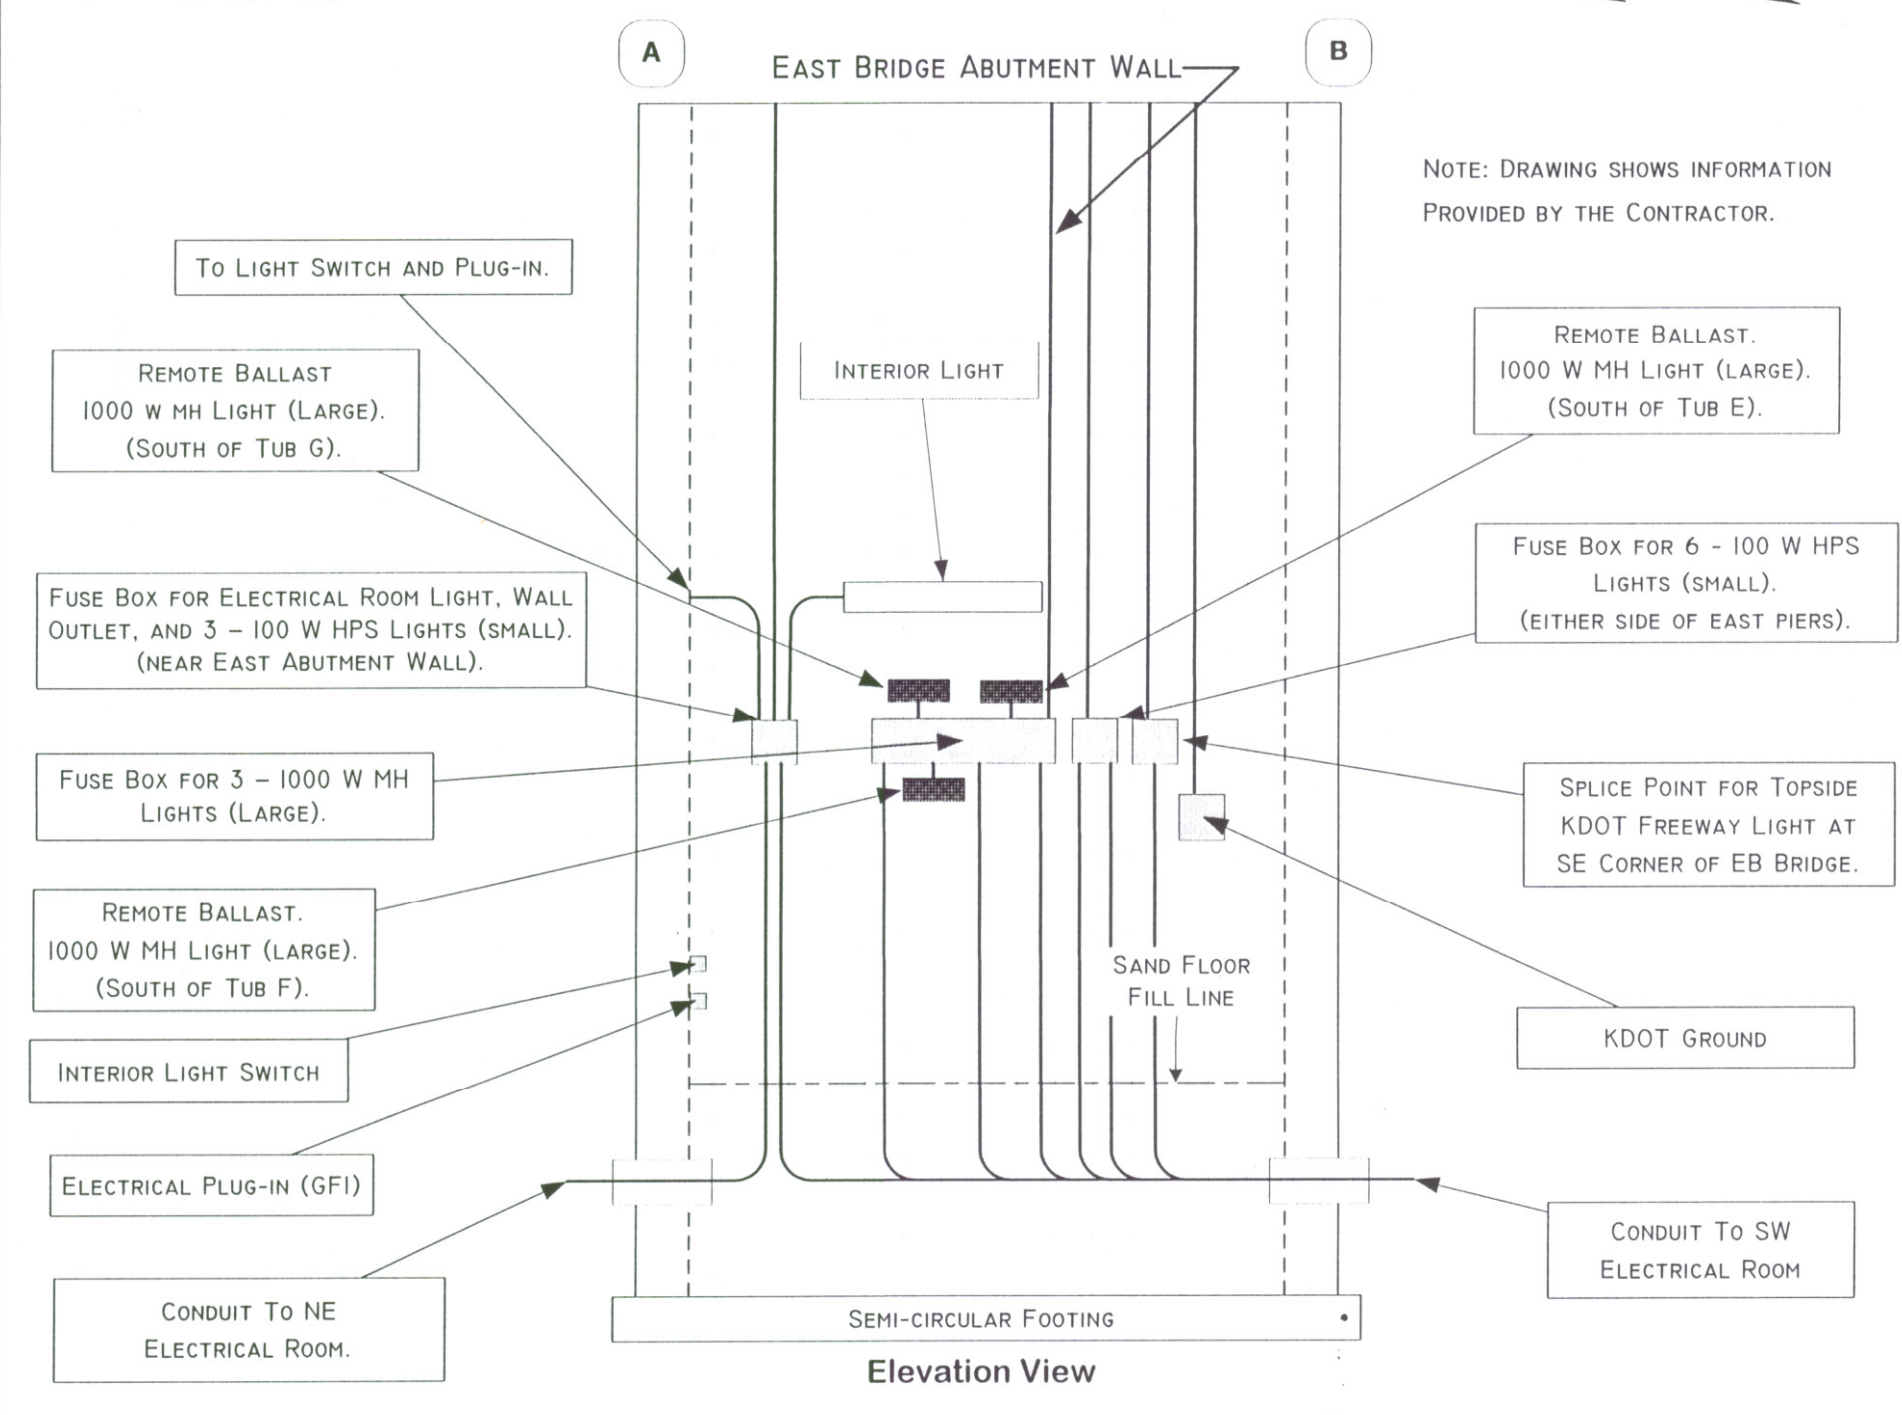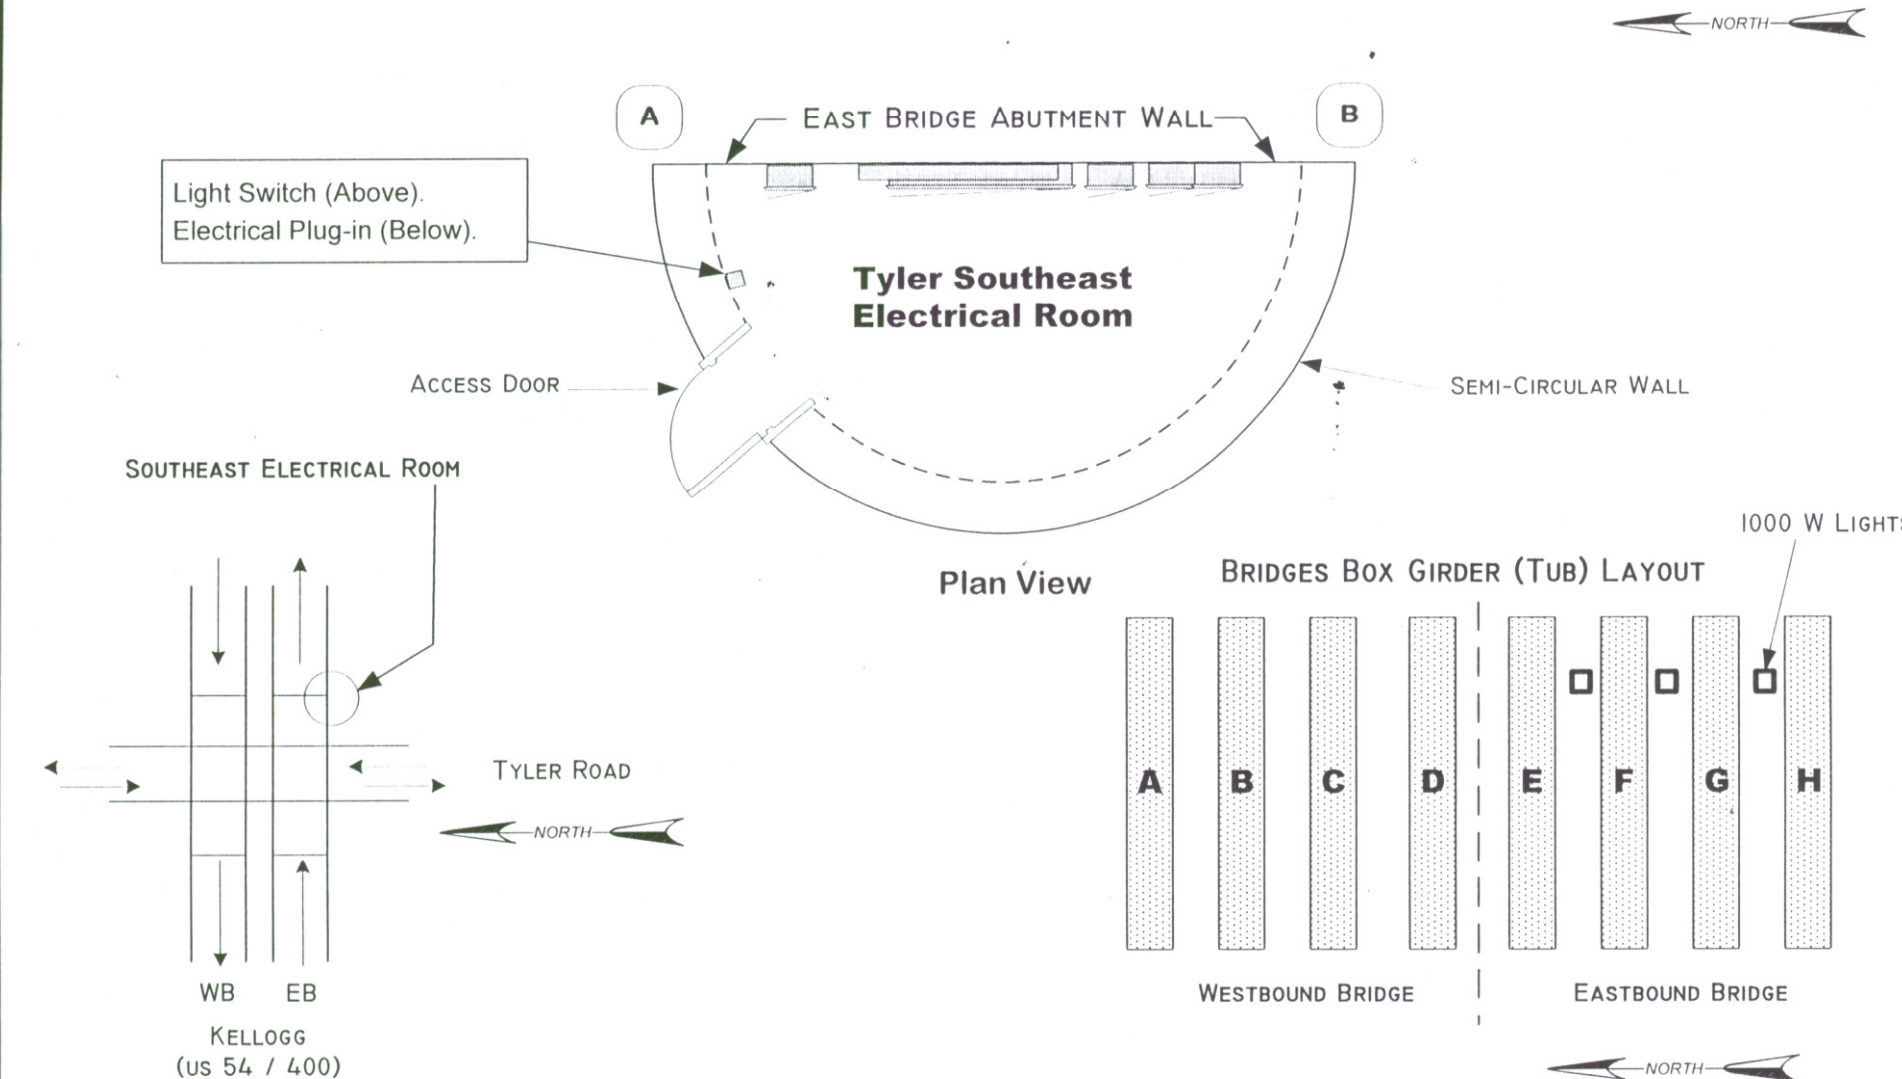

NOTE: 1000 W MH AND 100 W HPS LIGHTS ARE "UNDER BRIDGE LIGHTS" BELOW EAST HALF OF BRIDGE No. 54 - 87 - 20.12 (497) EB KELLOGG.