



DATE	
BY	
REFERENCES NOTED	
REFERENCES CHECKED	

REVISED,
See sheet # 683R2.

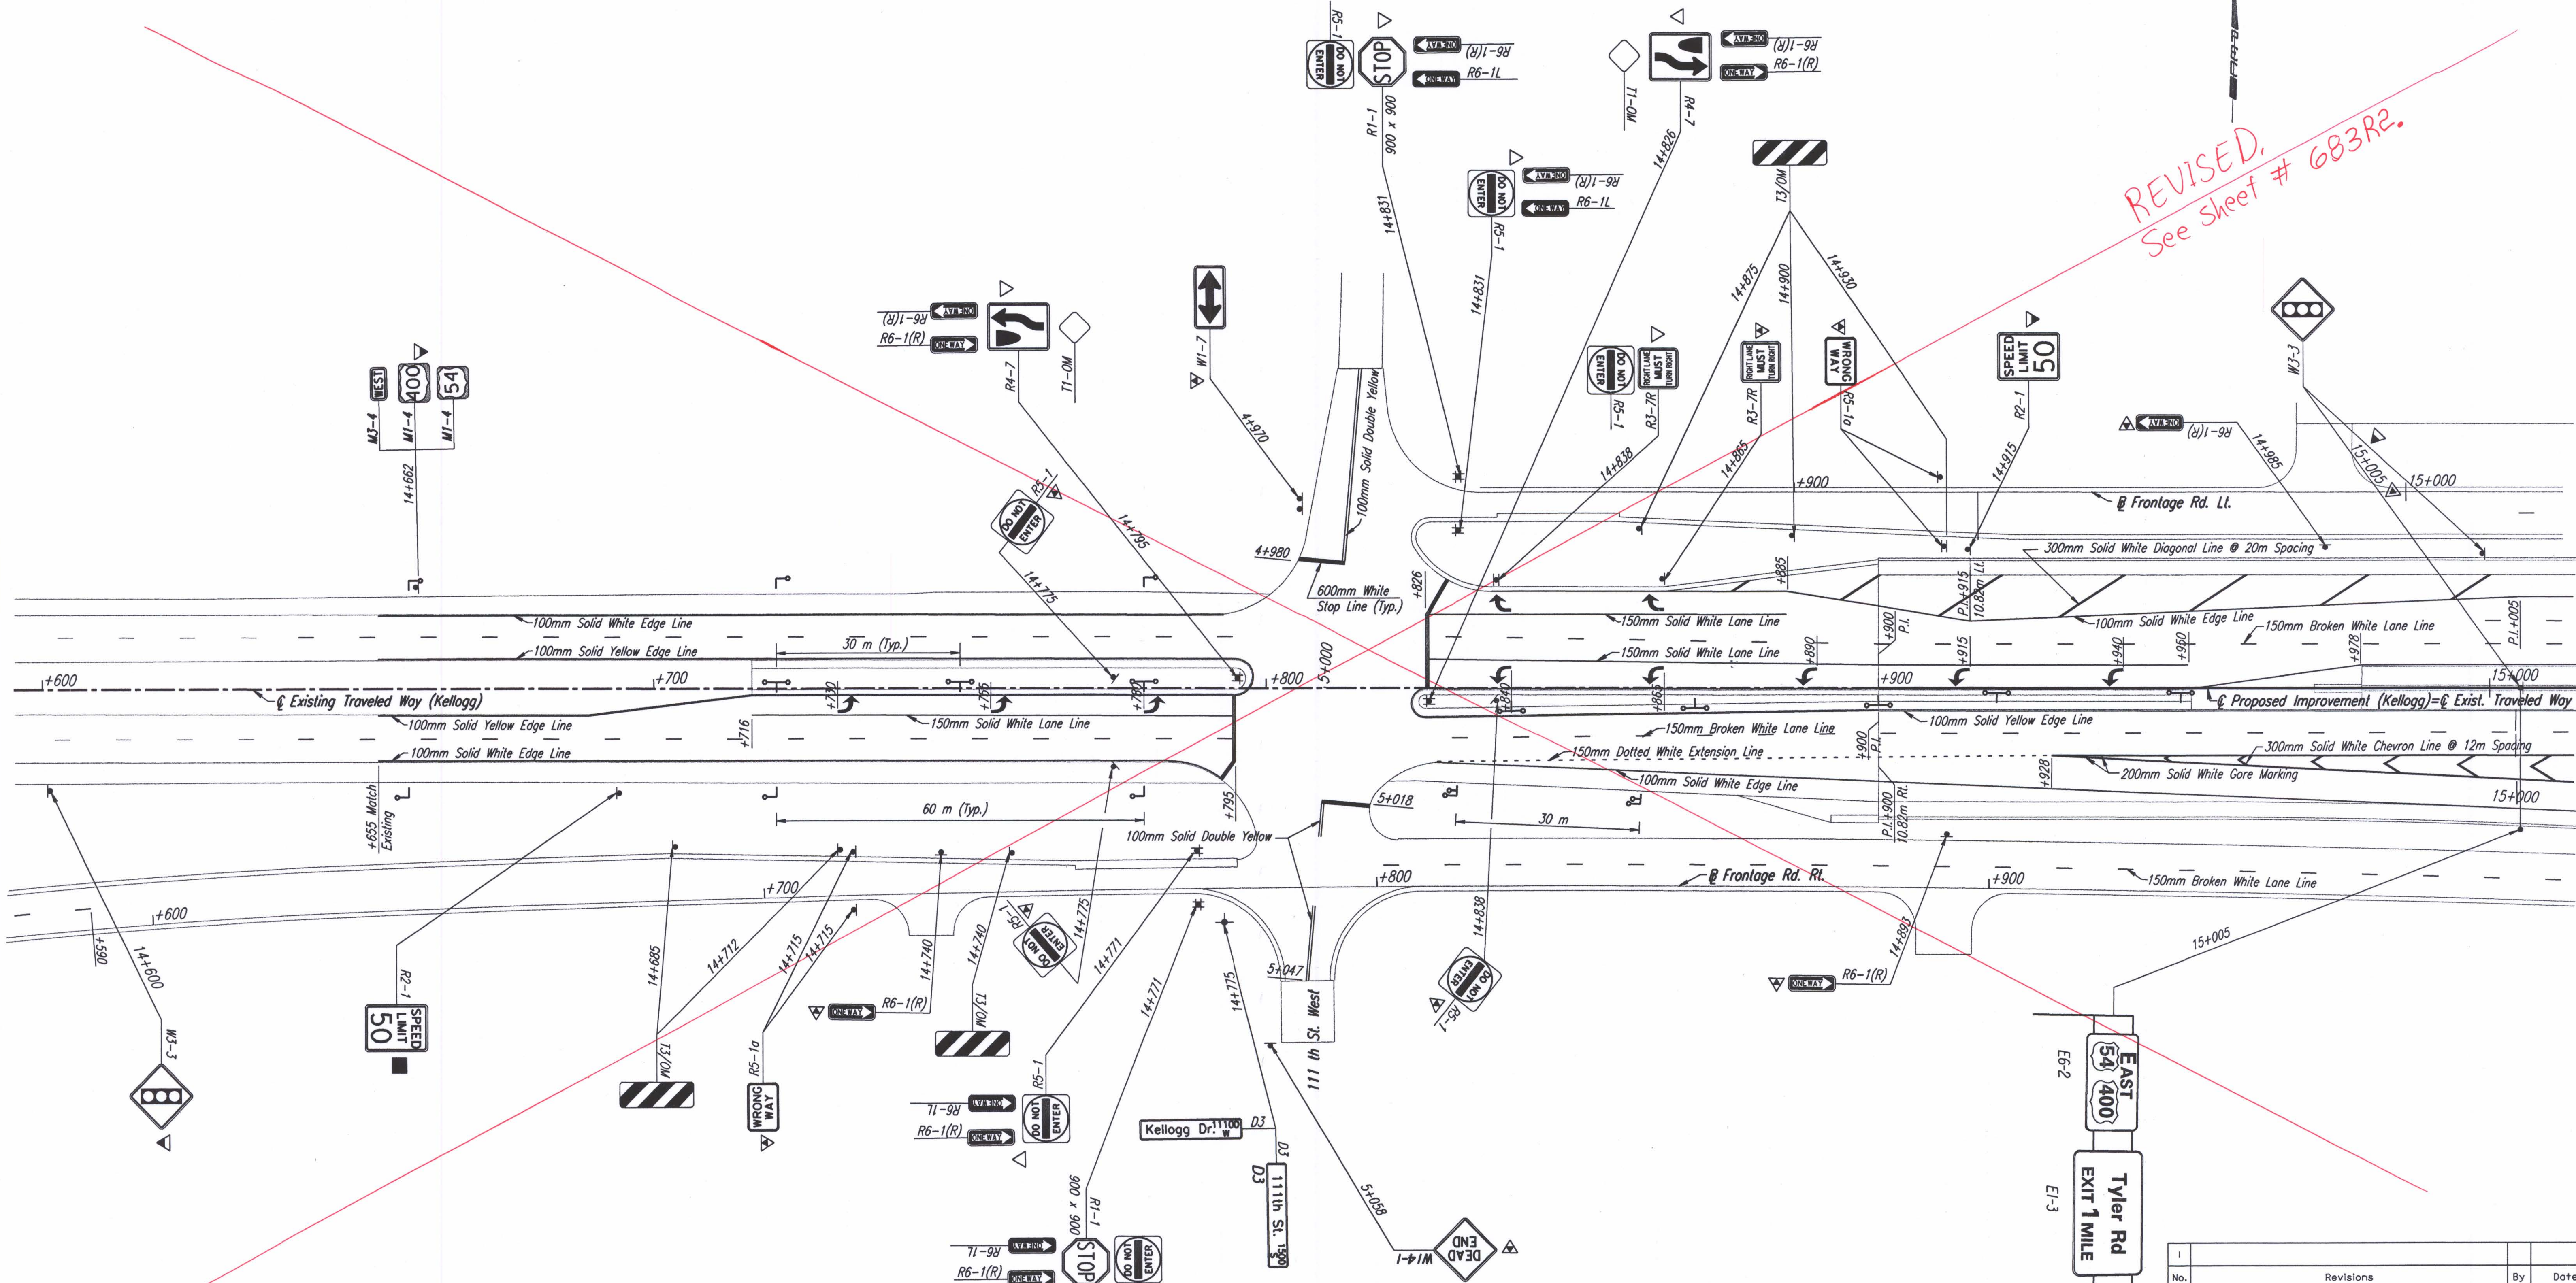

FLEXIBLE DELINEATION				
	Type A		Type B	
	Type I	Type III	Type I	Type III
White	6		2	
Yellow (Back to Back)		8		

DSNR: WDH OPER: JGP SCALE: 1:500
 I:/1997/97362/Marking/PL146.DGN 12-1-1999 7:19:49 LAST REV: 1-24-2002 BY: svb

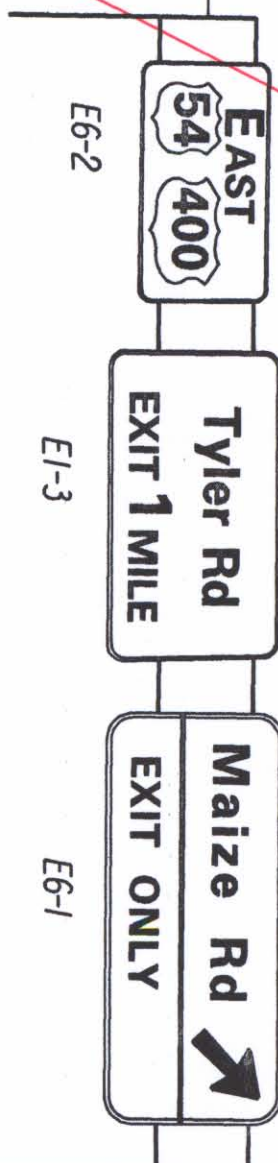

No.	Revisions	By	Date
CITY OF WICHITA			
SIGNING & MARKING PLAN STA. 14+600 TO STA. 15+000			
SEDGWICK COUNTY			
Professional Engineering Consultants, P.A. 303 S. TOPEKA • WICHITA, KANSAS 67202 316-262-2691 • FAX 316-262-3003			
Designed by	RPG	Checked by	WDH
Drawn by	SVB	Date	April, 2002
		Job No.	97362