FHWA REGION NO.	STATE	PROJECT NO.	YEAR	SHEET NO.	TOTAL SHEETS
7	KANSAS	54-87 K-6657-01	2002	688	1122

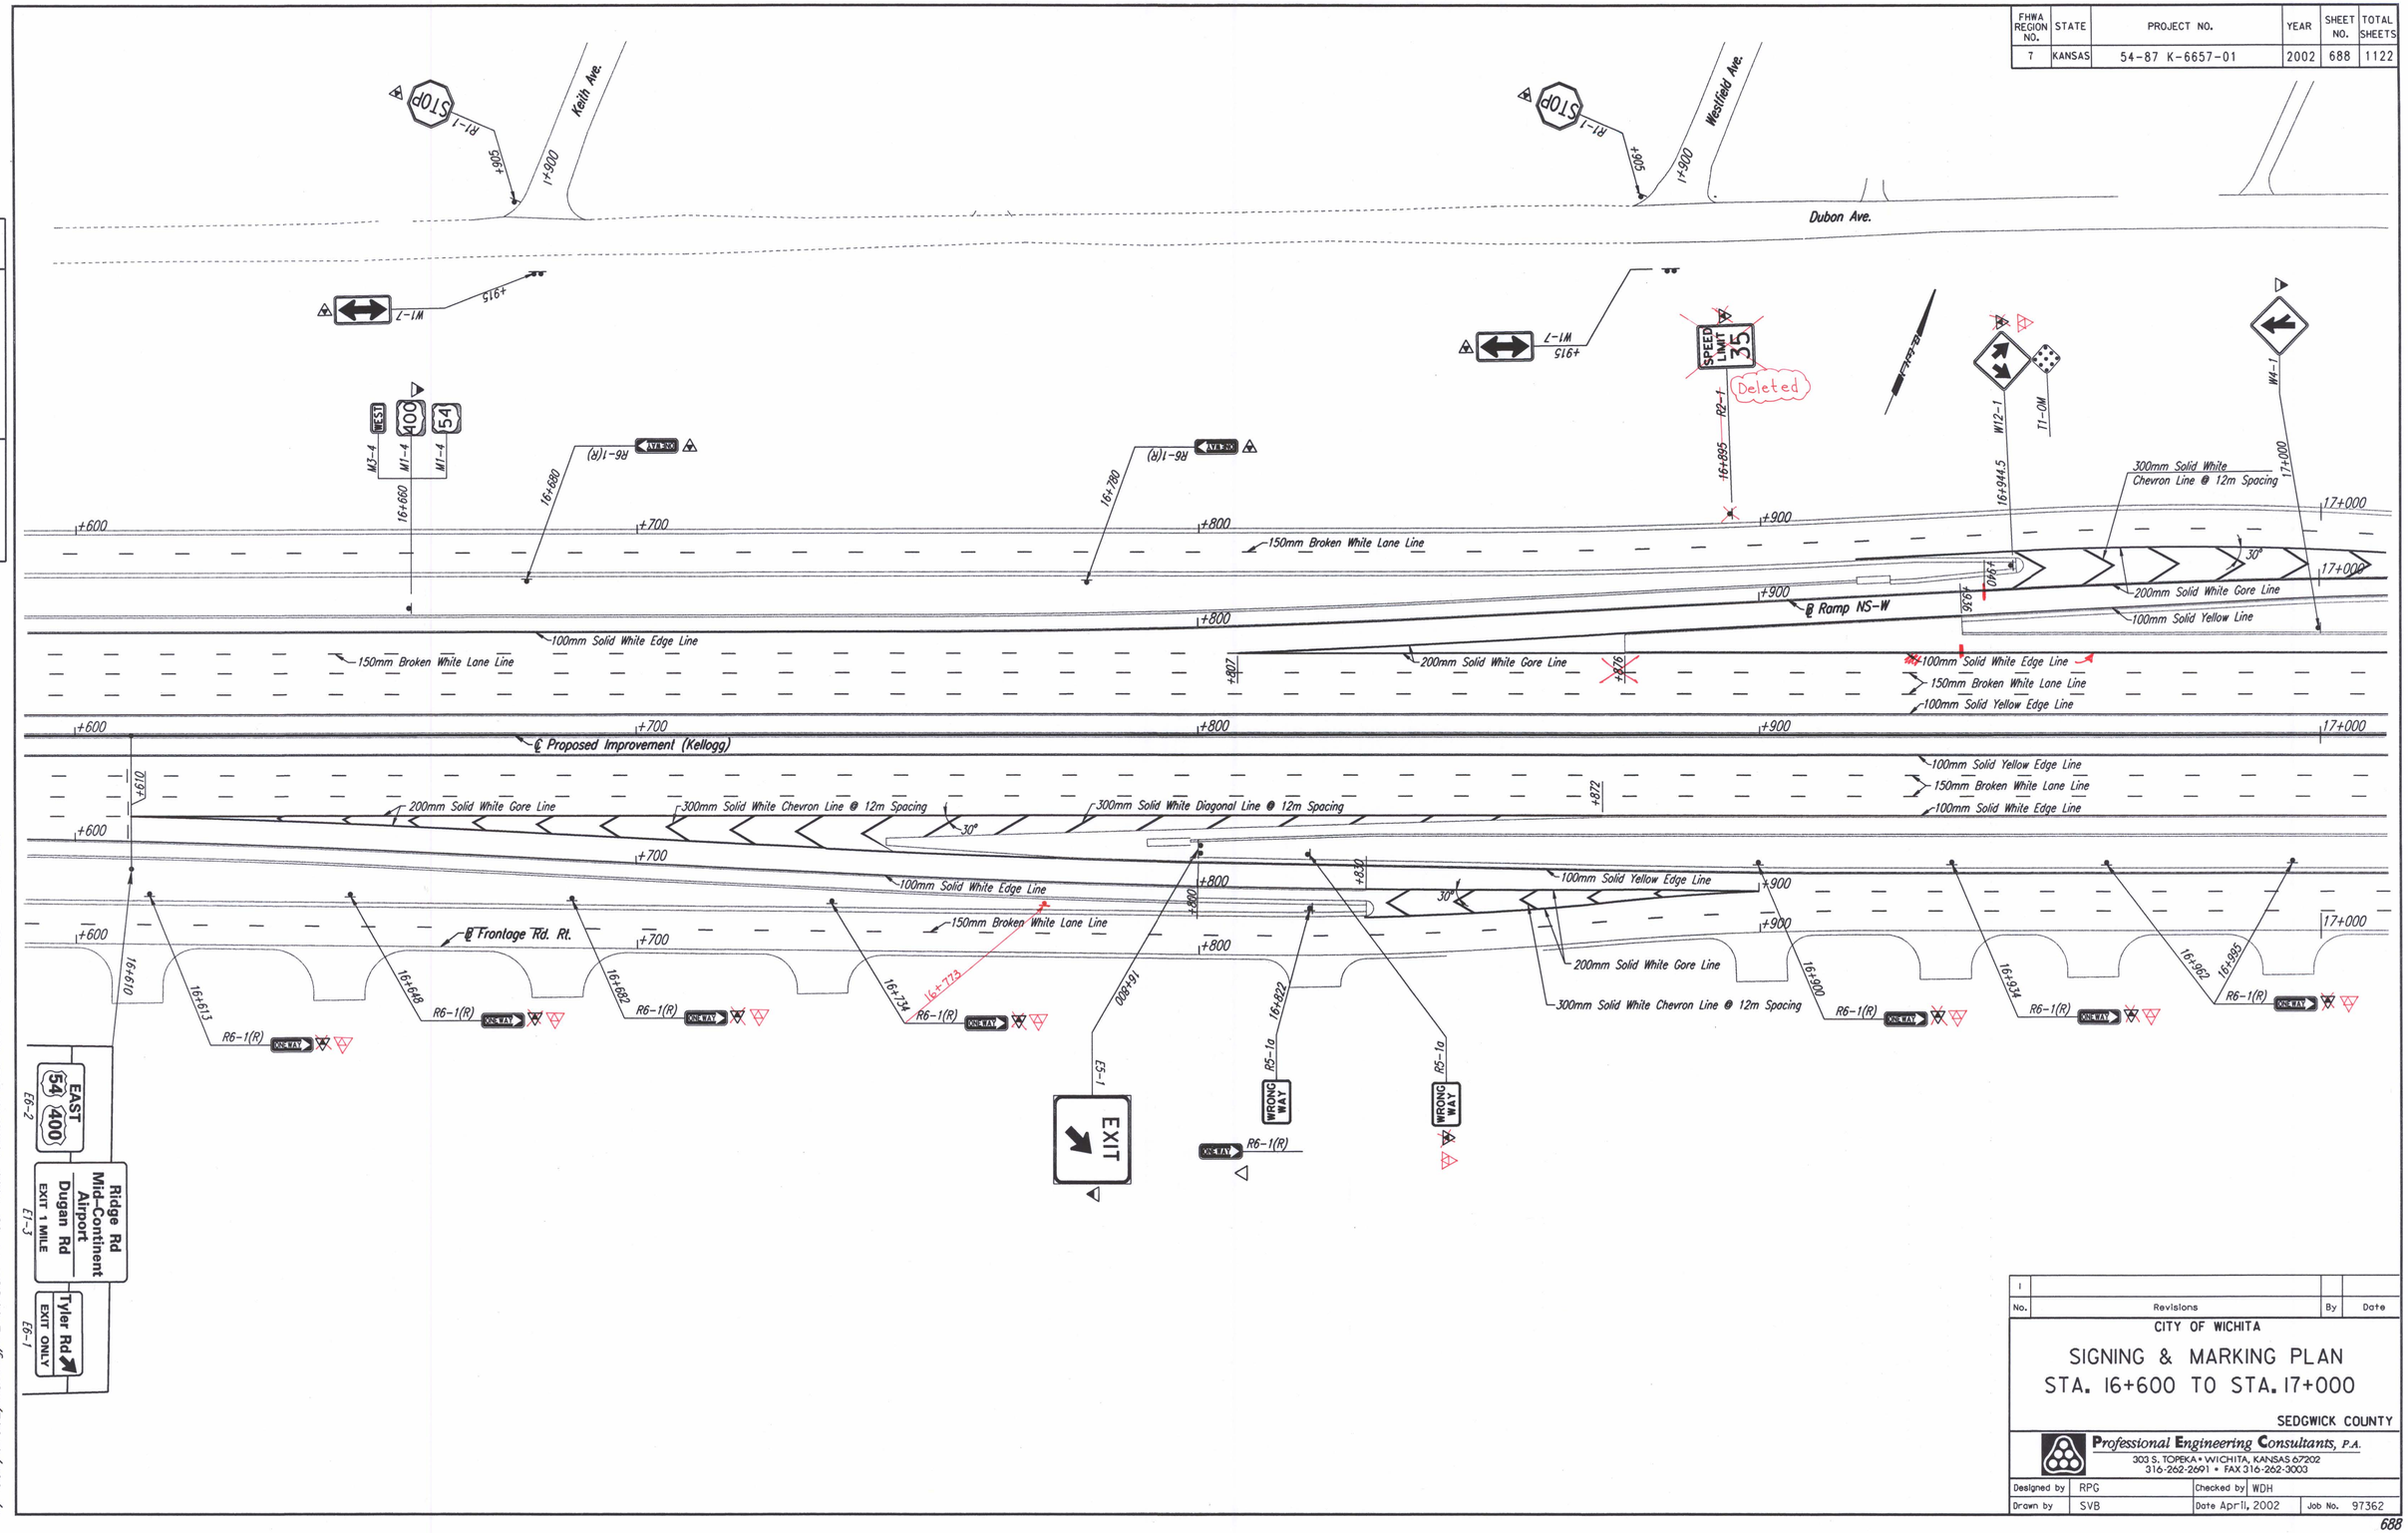

No.	Revisions	By	Date
1			

CITY OF WICHITA

SIGNING & MARKING PLAN
STA. 16+600 TO STA. 17+000

SEDGWICK COUNTY

Professional Engineering Consultants, P.A.
303 S. TOPEKA • WICHITA, KANSAS 67202
316-262-2691 • FAX 316-262-3003

Designed by	RPG	Checked by	WDH
Drawn by	SVB	Date April, 2002	Job No. 97362

	BY	DATE
REFERENCES NOTED		
REFERENCES CHECKED		

DSNR: WDH OPER: JGP SCALE: 1:500
I:/1997/97362/Marking/PL166.DGN 11-08-1999 15:38:48 LAST REV: 1-24-2002 BY: svb