REG NO.	STATE	PROJECT NO.	YEAR	SHEET NO.	TOTAL SHEETS
7	KANSAS	54-87 K-6657-01	2002	926	1122

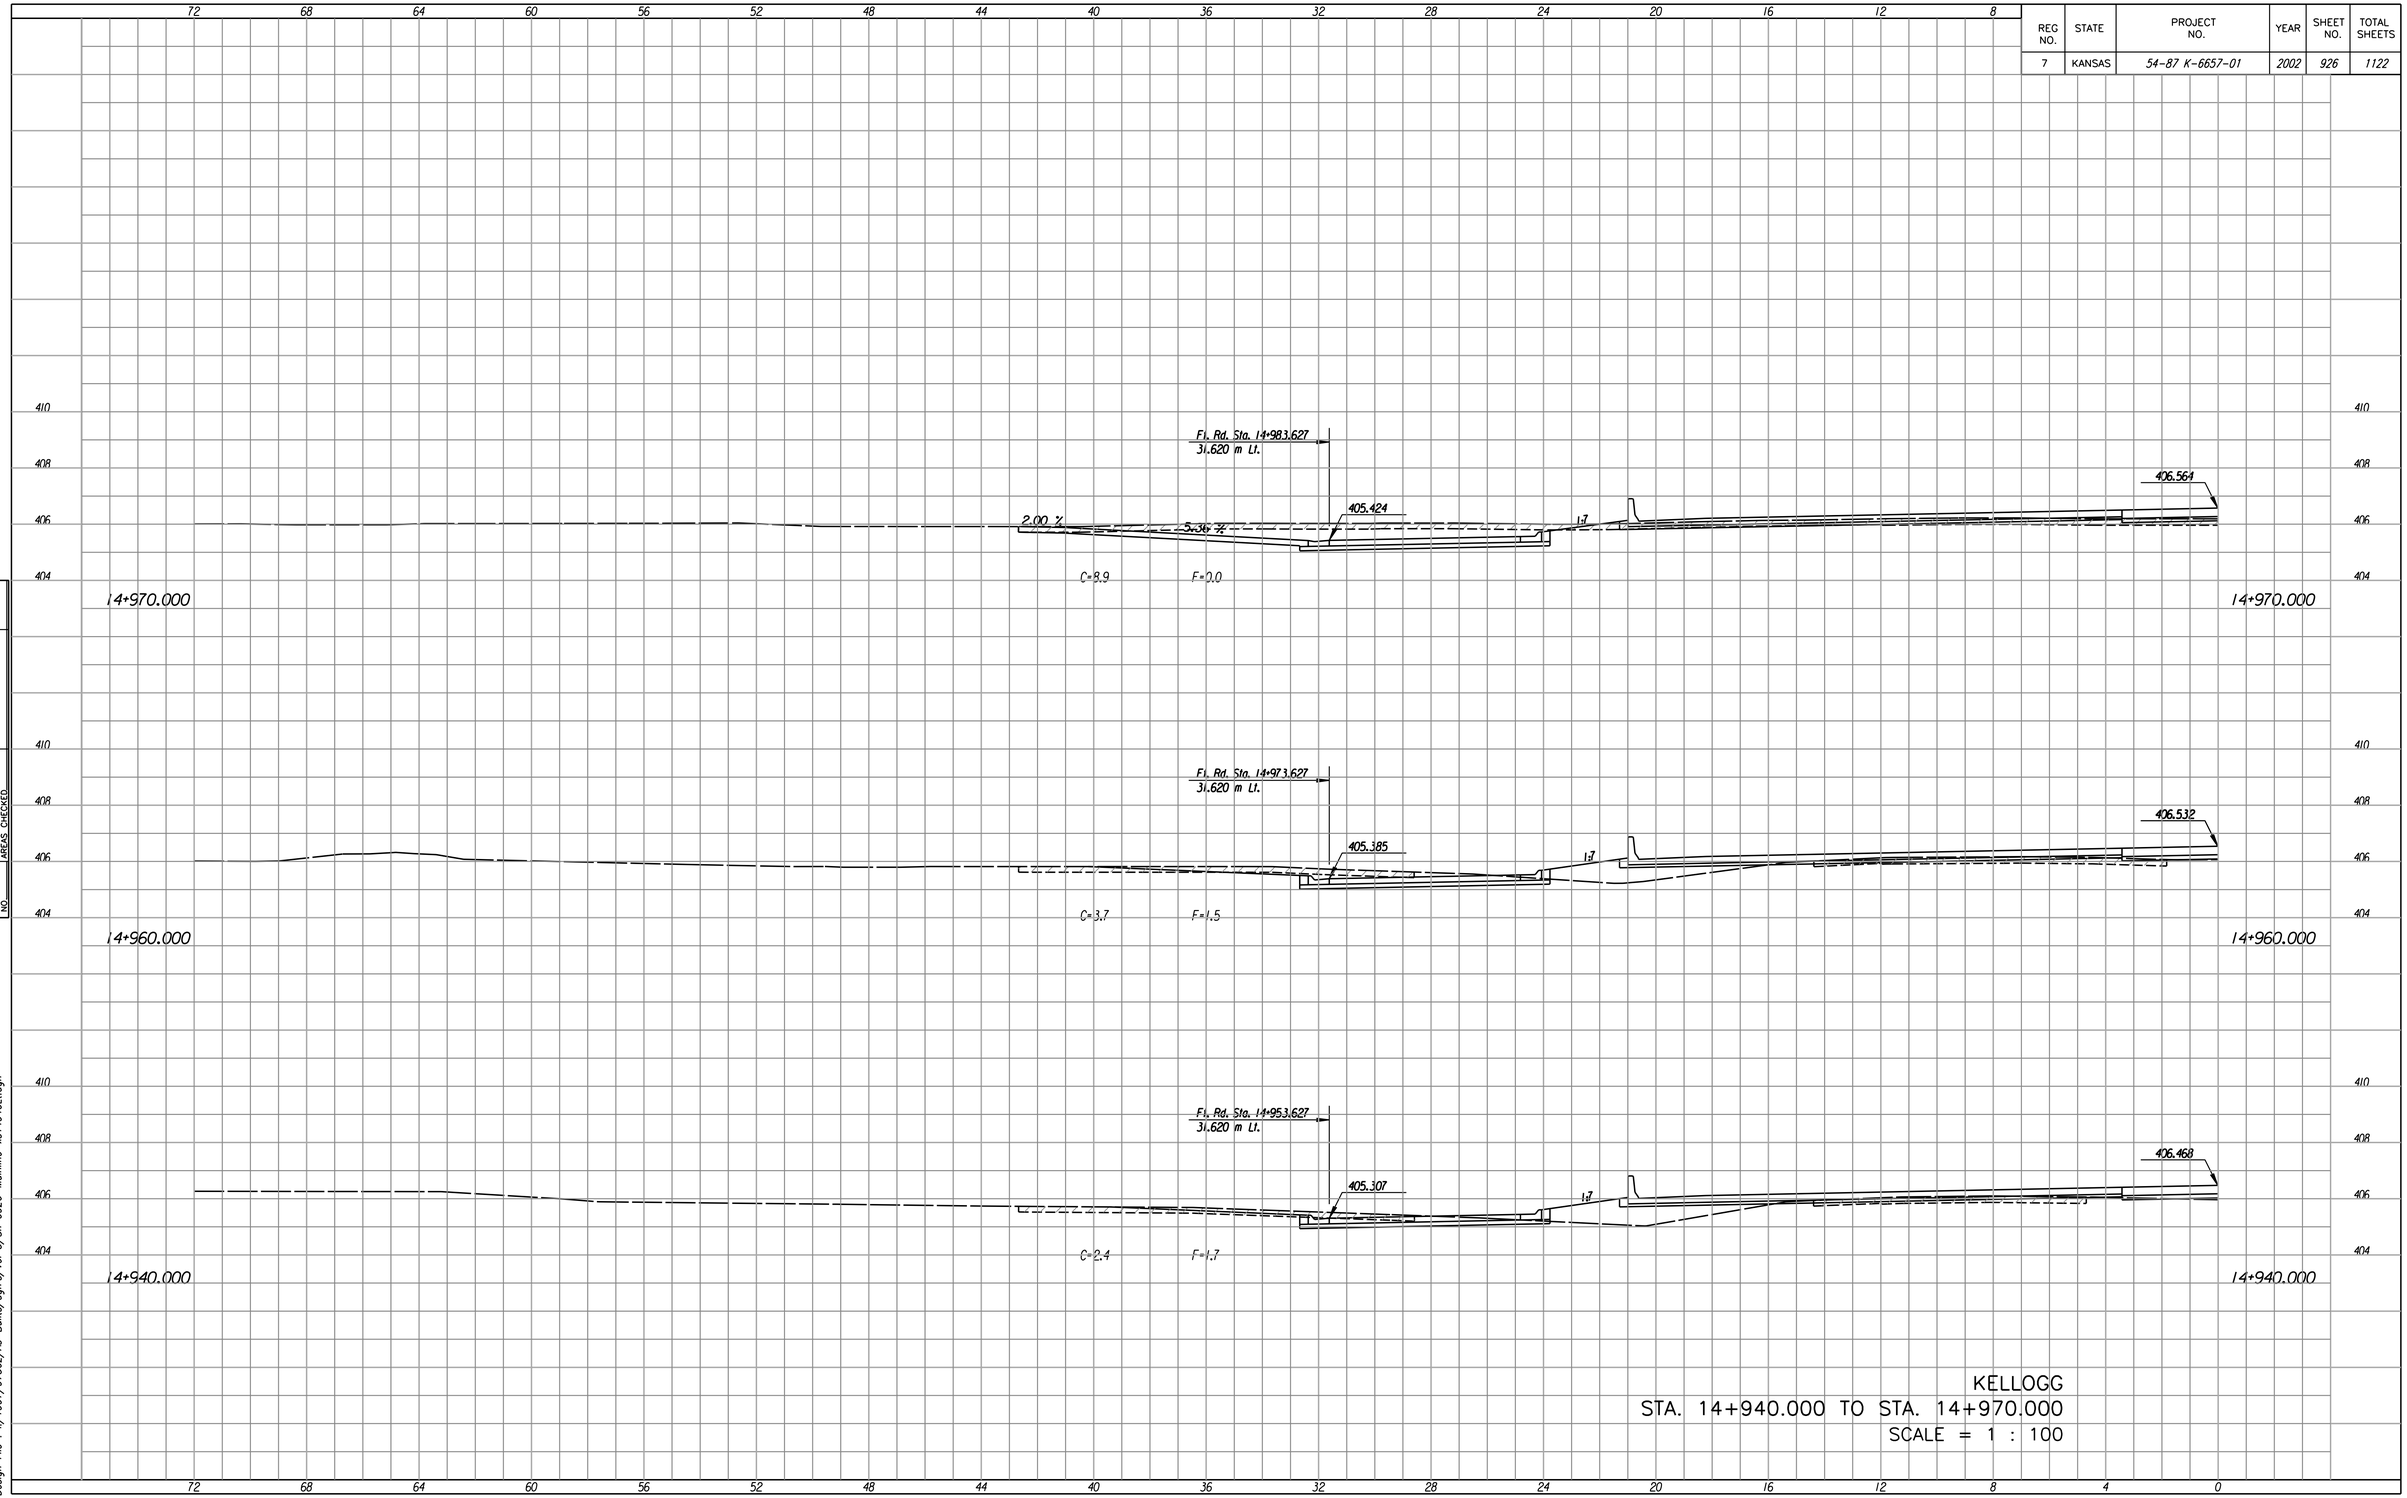

KELLOGG
STA. 14+940.000 TO STA. 14+970.000
SCALE = 1 : 100

NO.	BY	DATE

FINAL SURVEY
NOTE BOOK
SURVEYED
PLOTTED
TAB-NOTE
AREAS
AREAS CHECKED

Last Rev. : 10-12-07 By: gdr
Scale : 100
Design File : t:/1997/97362/As-Builts/dgns/Vol 5/Sh 0926-Mainline-xs14940L.dgn