REG NO.	STATE	PROJECT NO.	YEAR	SHEET NO.	TOTAL SHEETS
7	KANSAS	54-87 K-6657-01	2002	943	1122

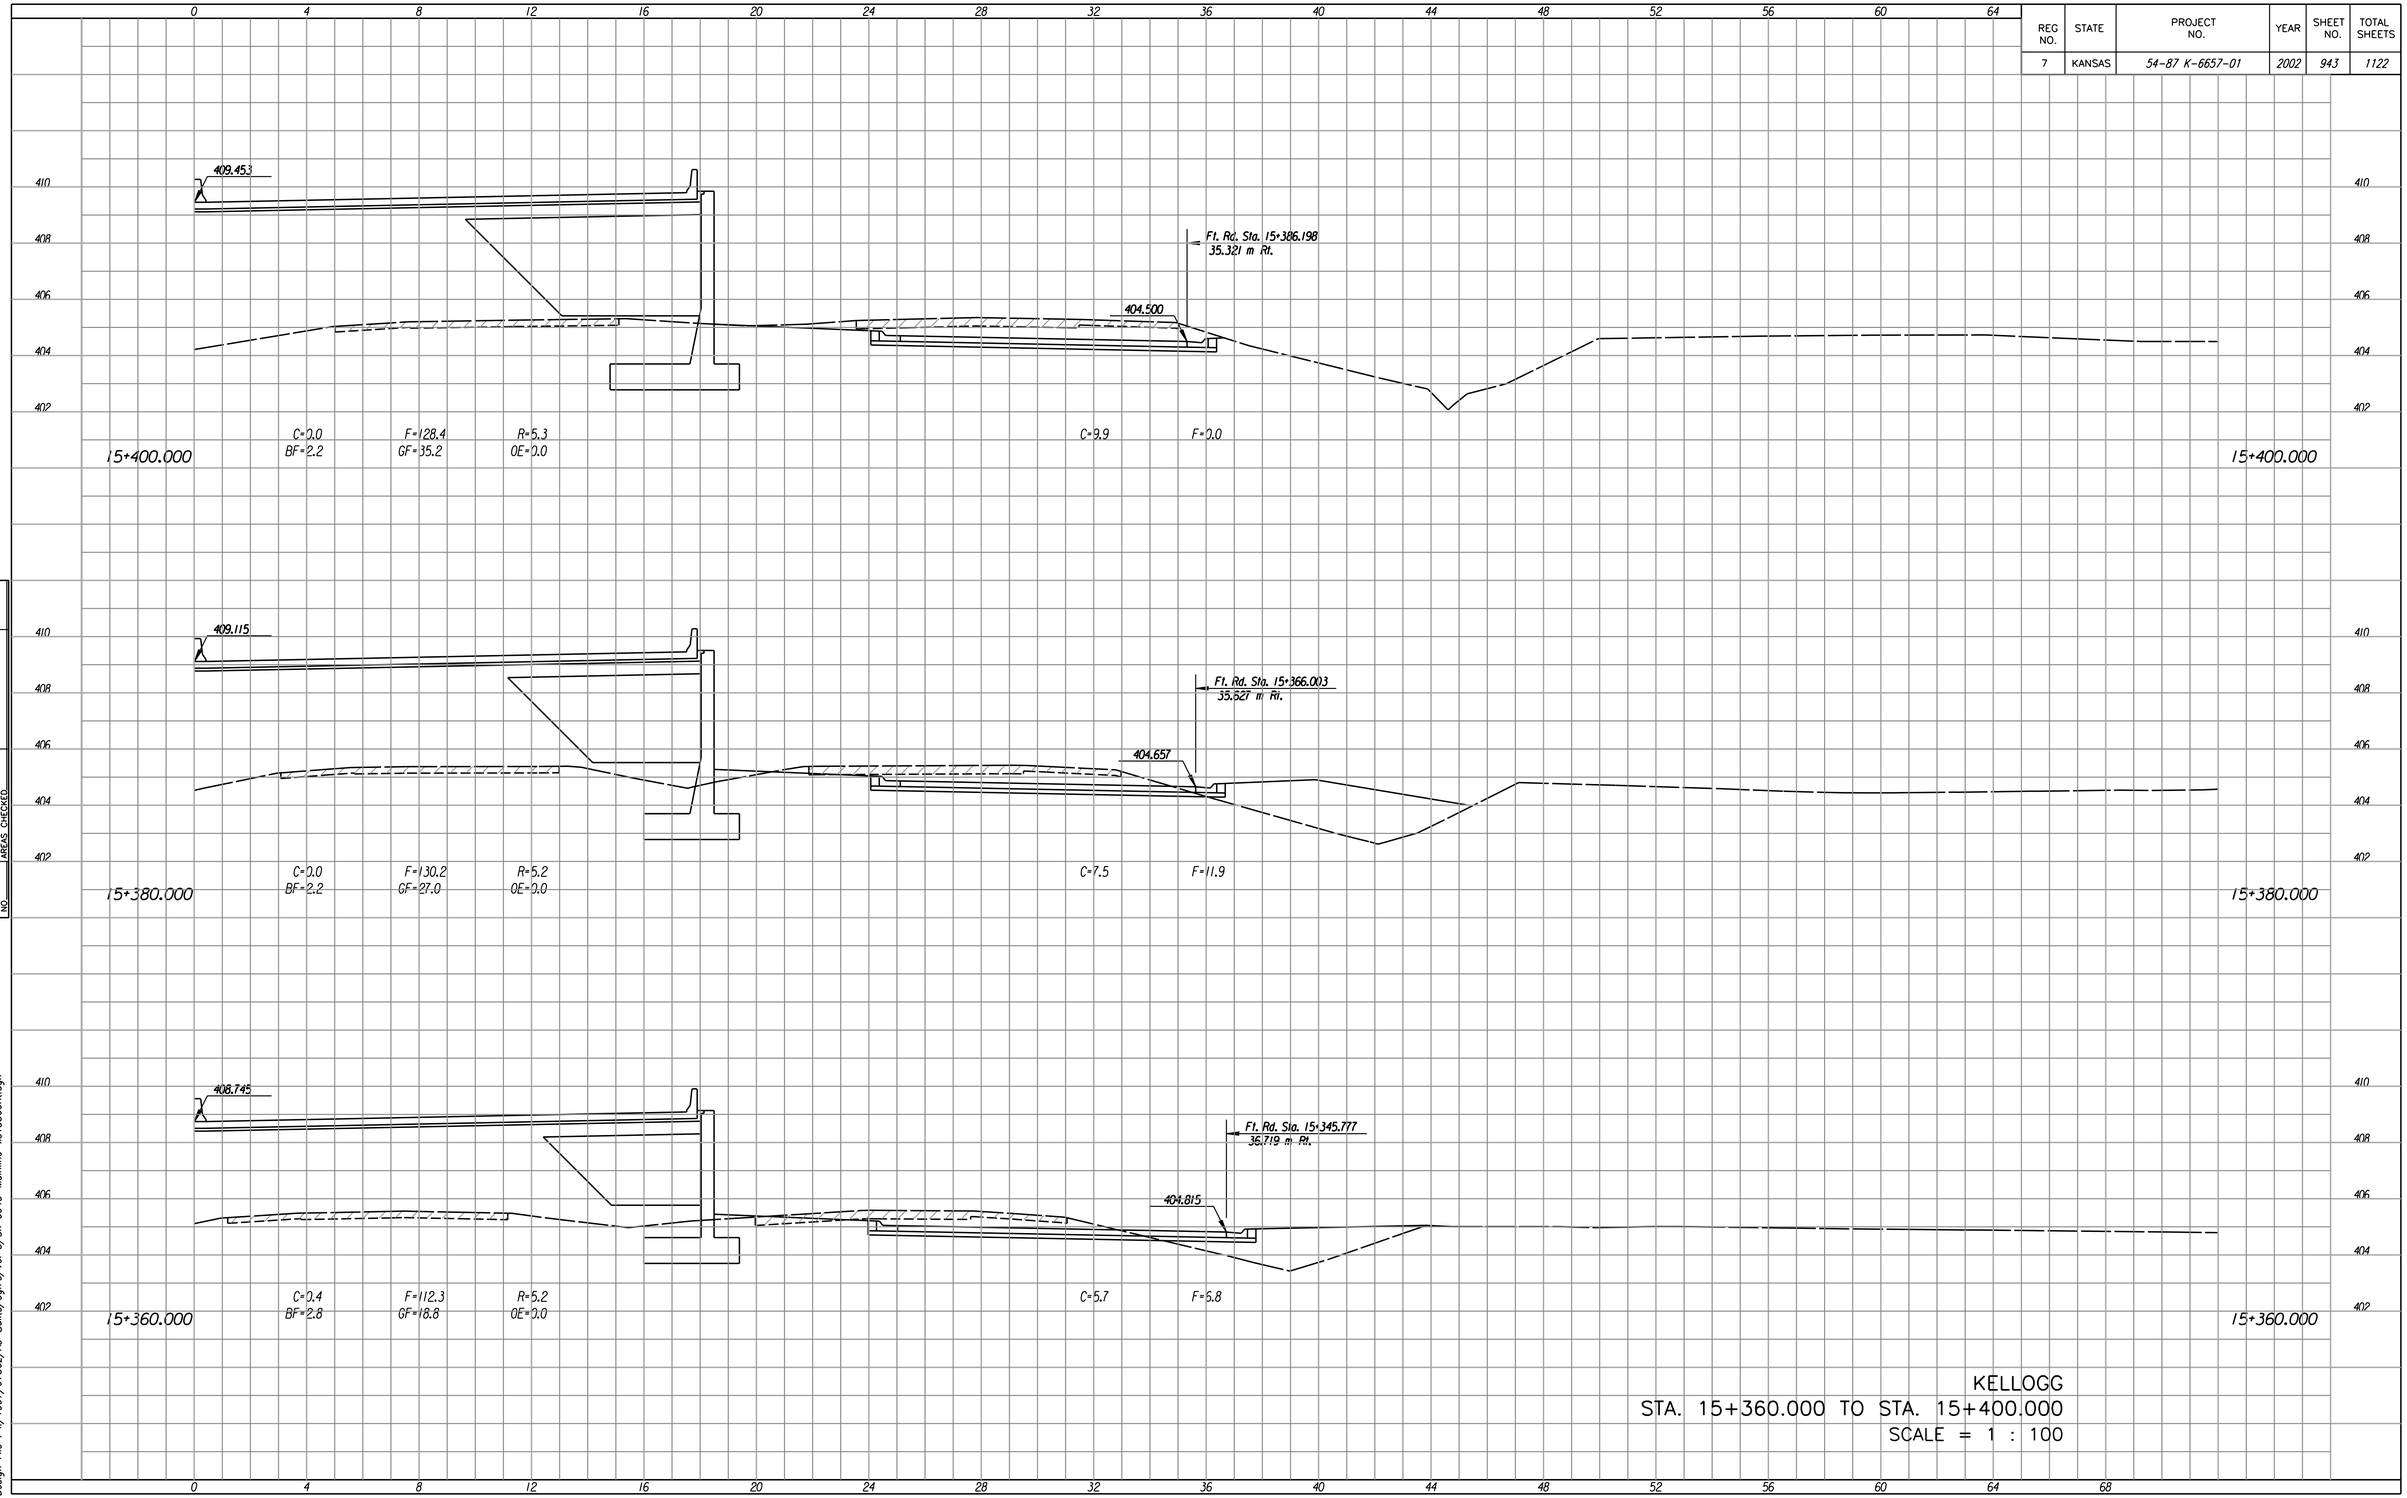

FINAL SURVEY		BY	DATE
	SURVEYED		
	PLOTTED		
NOTE BOOK	TRIANGULATE		
	AREAS		
NO.	AREAS CHECKED		

Last Rev. : 10-12-07 By: gdr
Scale : 100
Design File : t:/1997/97362/As-Builts/dgns/Vol 5/Sh 0943-Mainline-xs15360Rt.dgn