FHWA REG NO.	STATE	PROJECT NO.	YEAR	SHEET NO.	TOTAL SHEETS
7	KANSAS	54-87 K-6657-01	2002	1098	1122

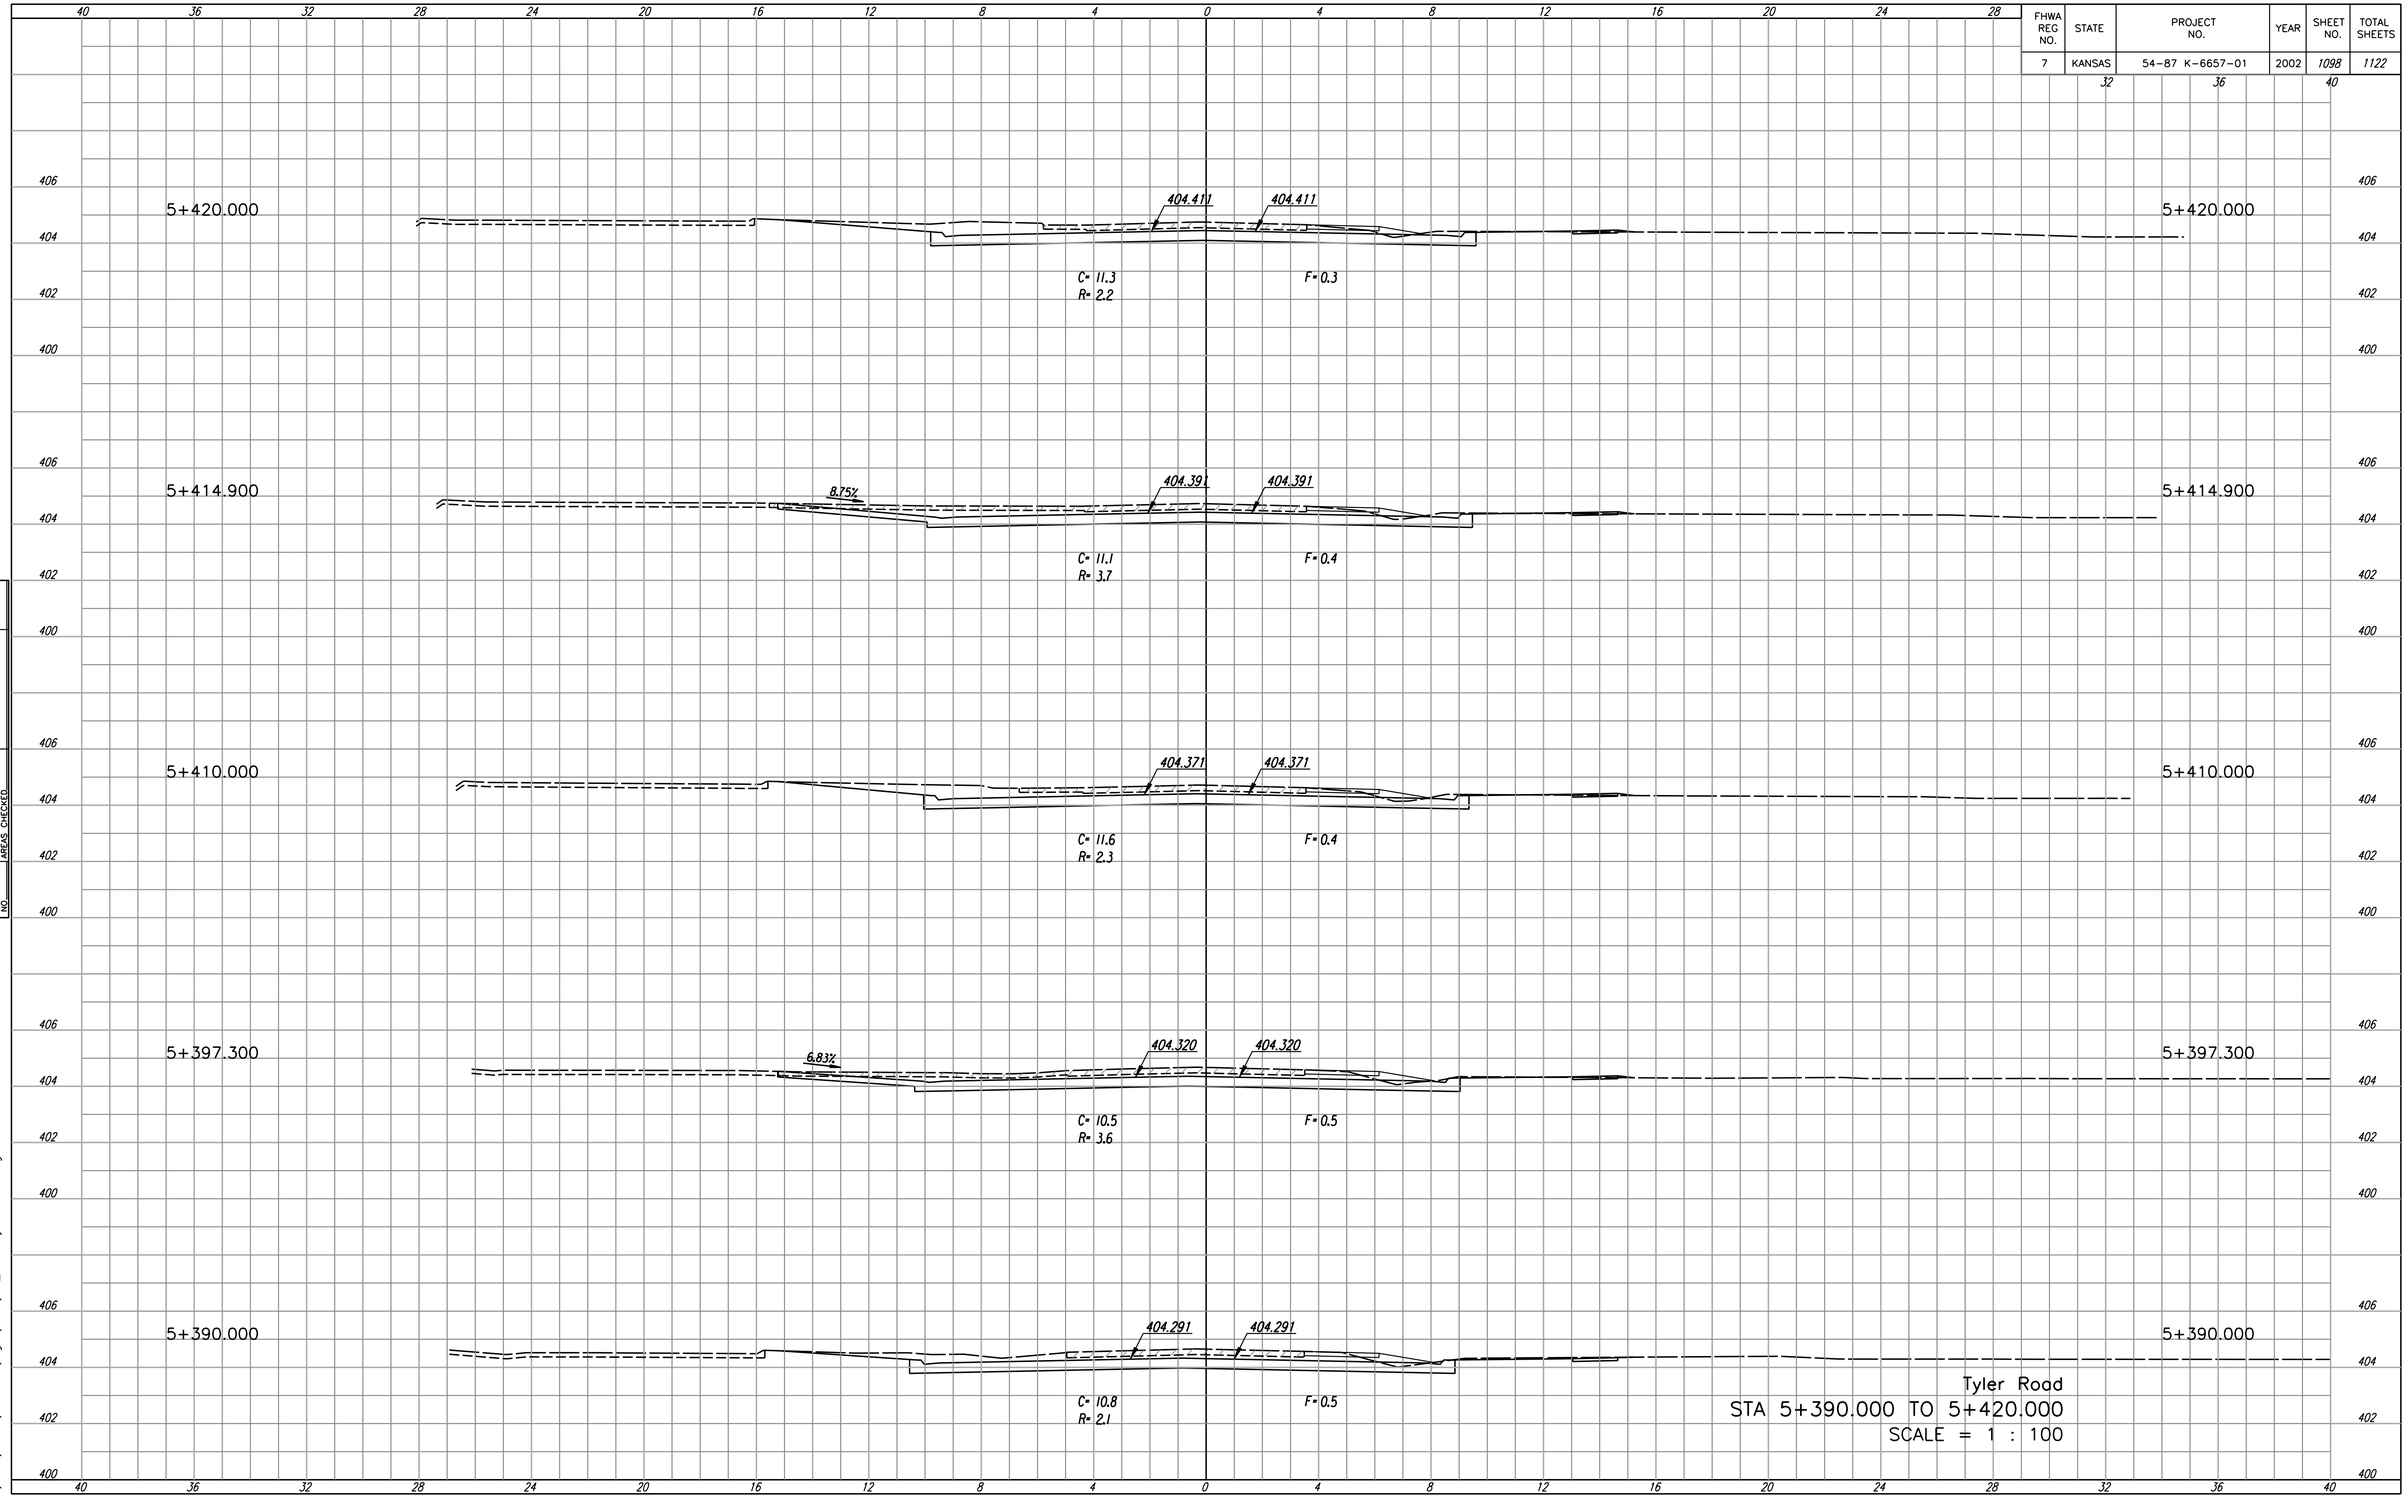

FINAL SURVEY	BY	DATE
SURVEYED		
PLOTTED		
ALIGNMENT		
AREAS		
AREAS CHECKED		
NOTE BOOK		
NO.		

DSN#: RCH OPER: SVB SCALE: 1:100
I:/1997/97362/As-Builts/dgn's/Vol.5/Sht_1098-Tyler-XSS390.dgn