FHWA REG NO.	STATE	PROJECT NO.	YEAR	SHEET NO.	TOTAL SHEETS
7	KANSAS	54-87 K-6657-01	2002	1118	1122

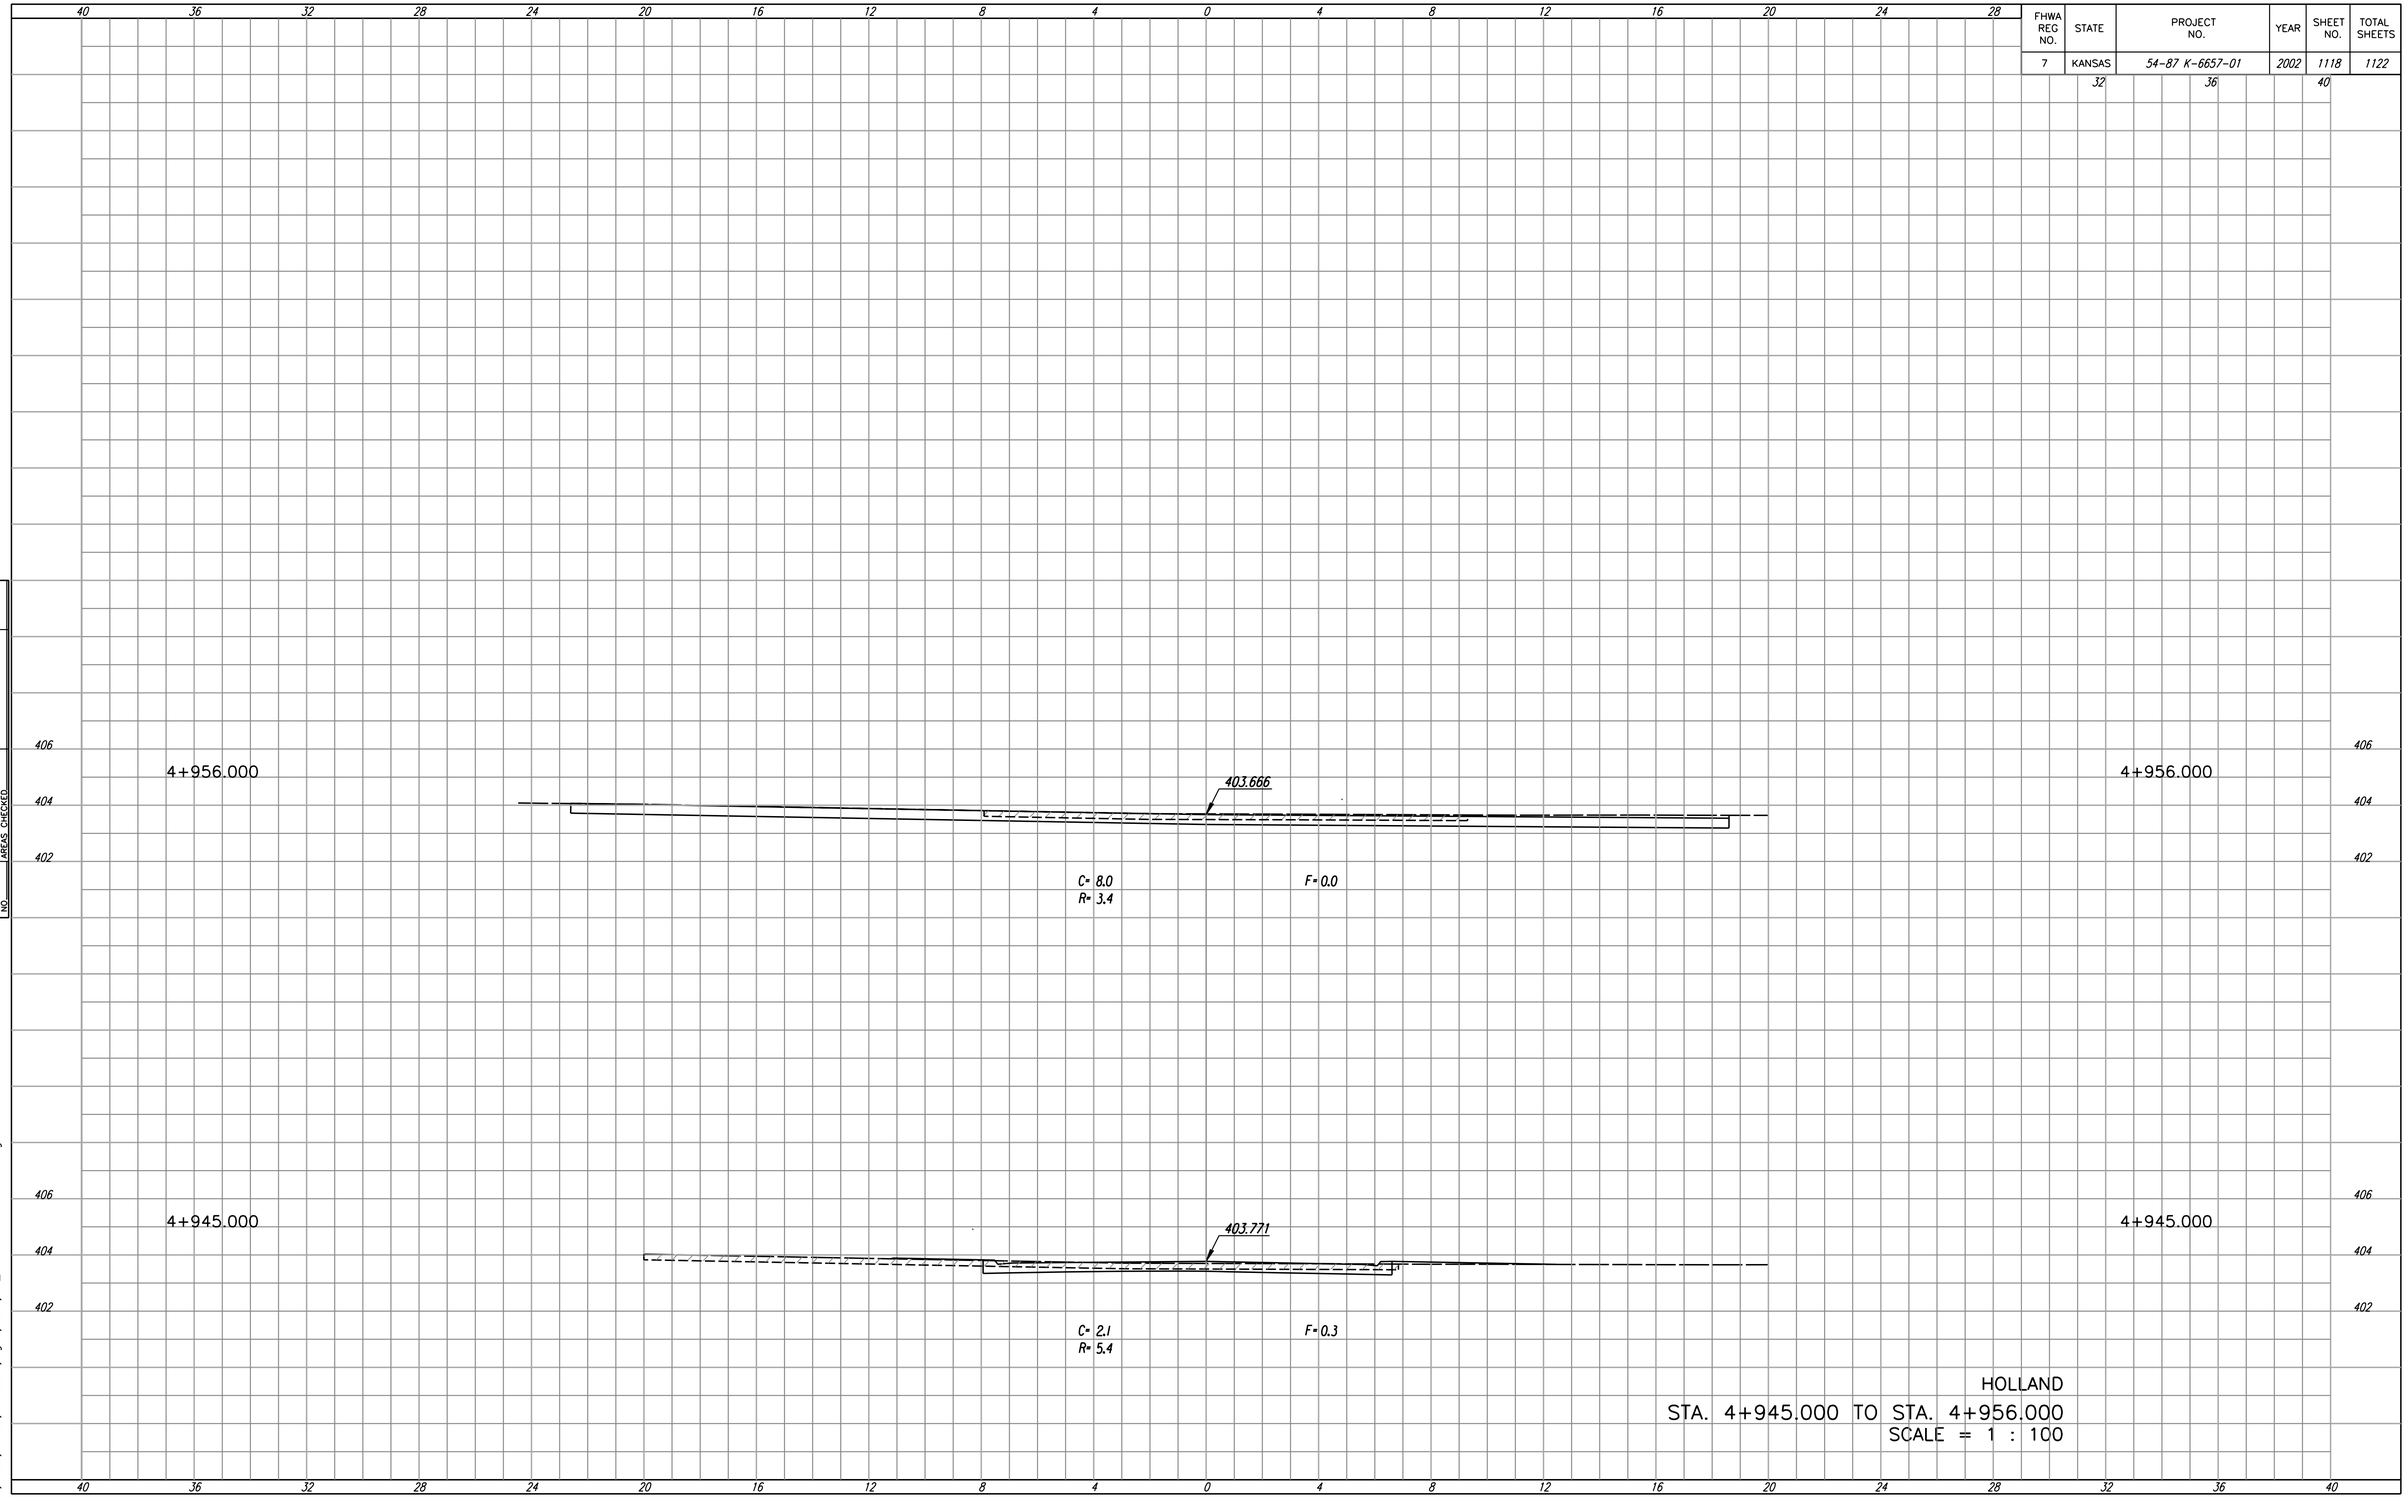

FINAL SURVEY		BY	DATE
NOTE BOOK	SURVEYED		
	PLOTTED		
	TRIANGULATE		
	AREAS		
NO.	AREAS CHECKED		

DSN#: RHM OPER: SVB SCALE: 1:100
I:/1997/97362/As-Builts/dgn's/Vol.5/Sht_1118-Holland-XS4945.dgn