


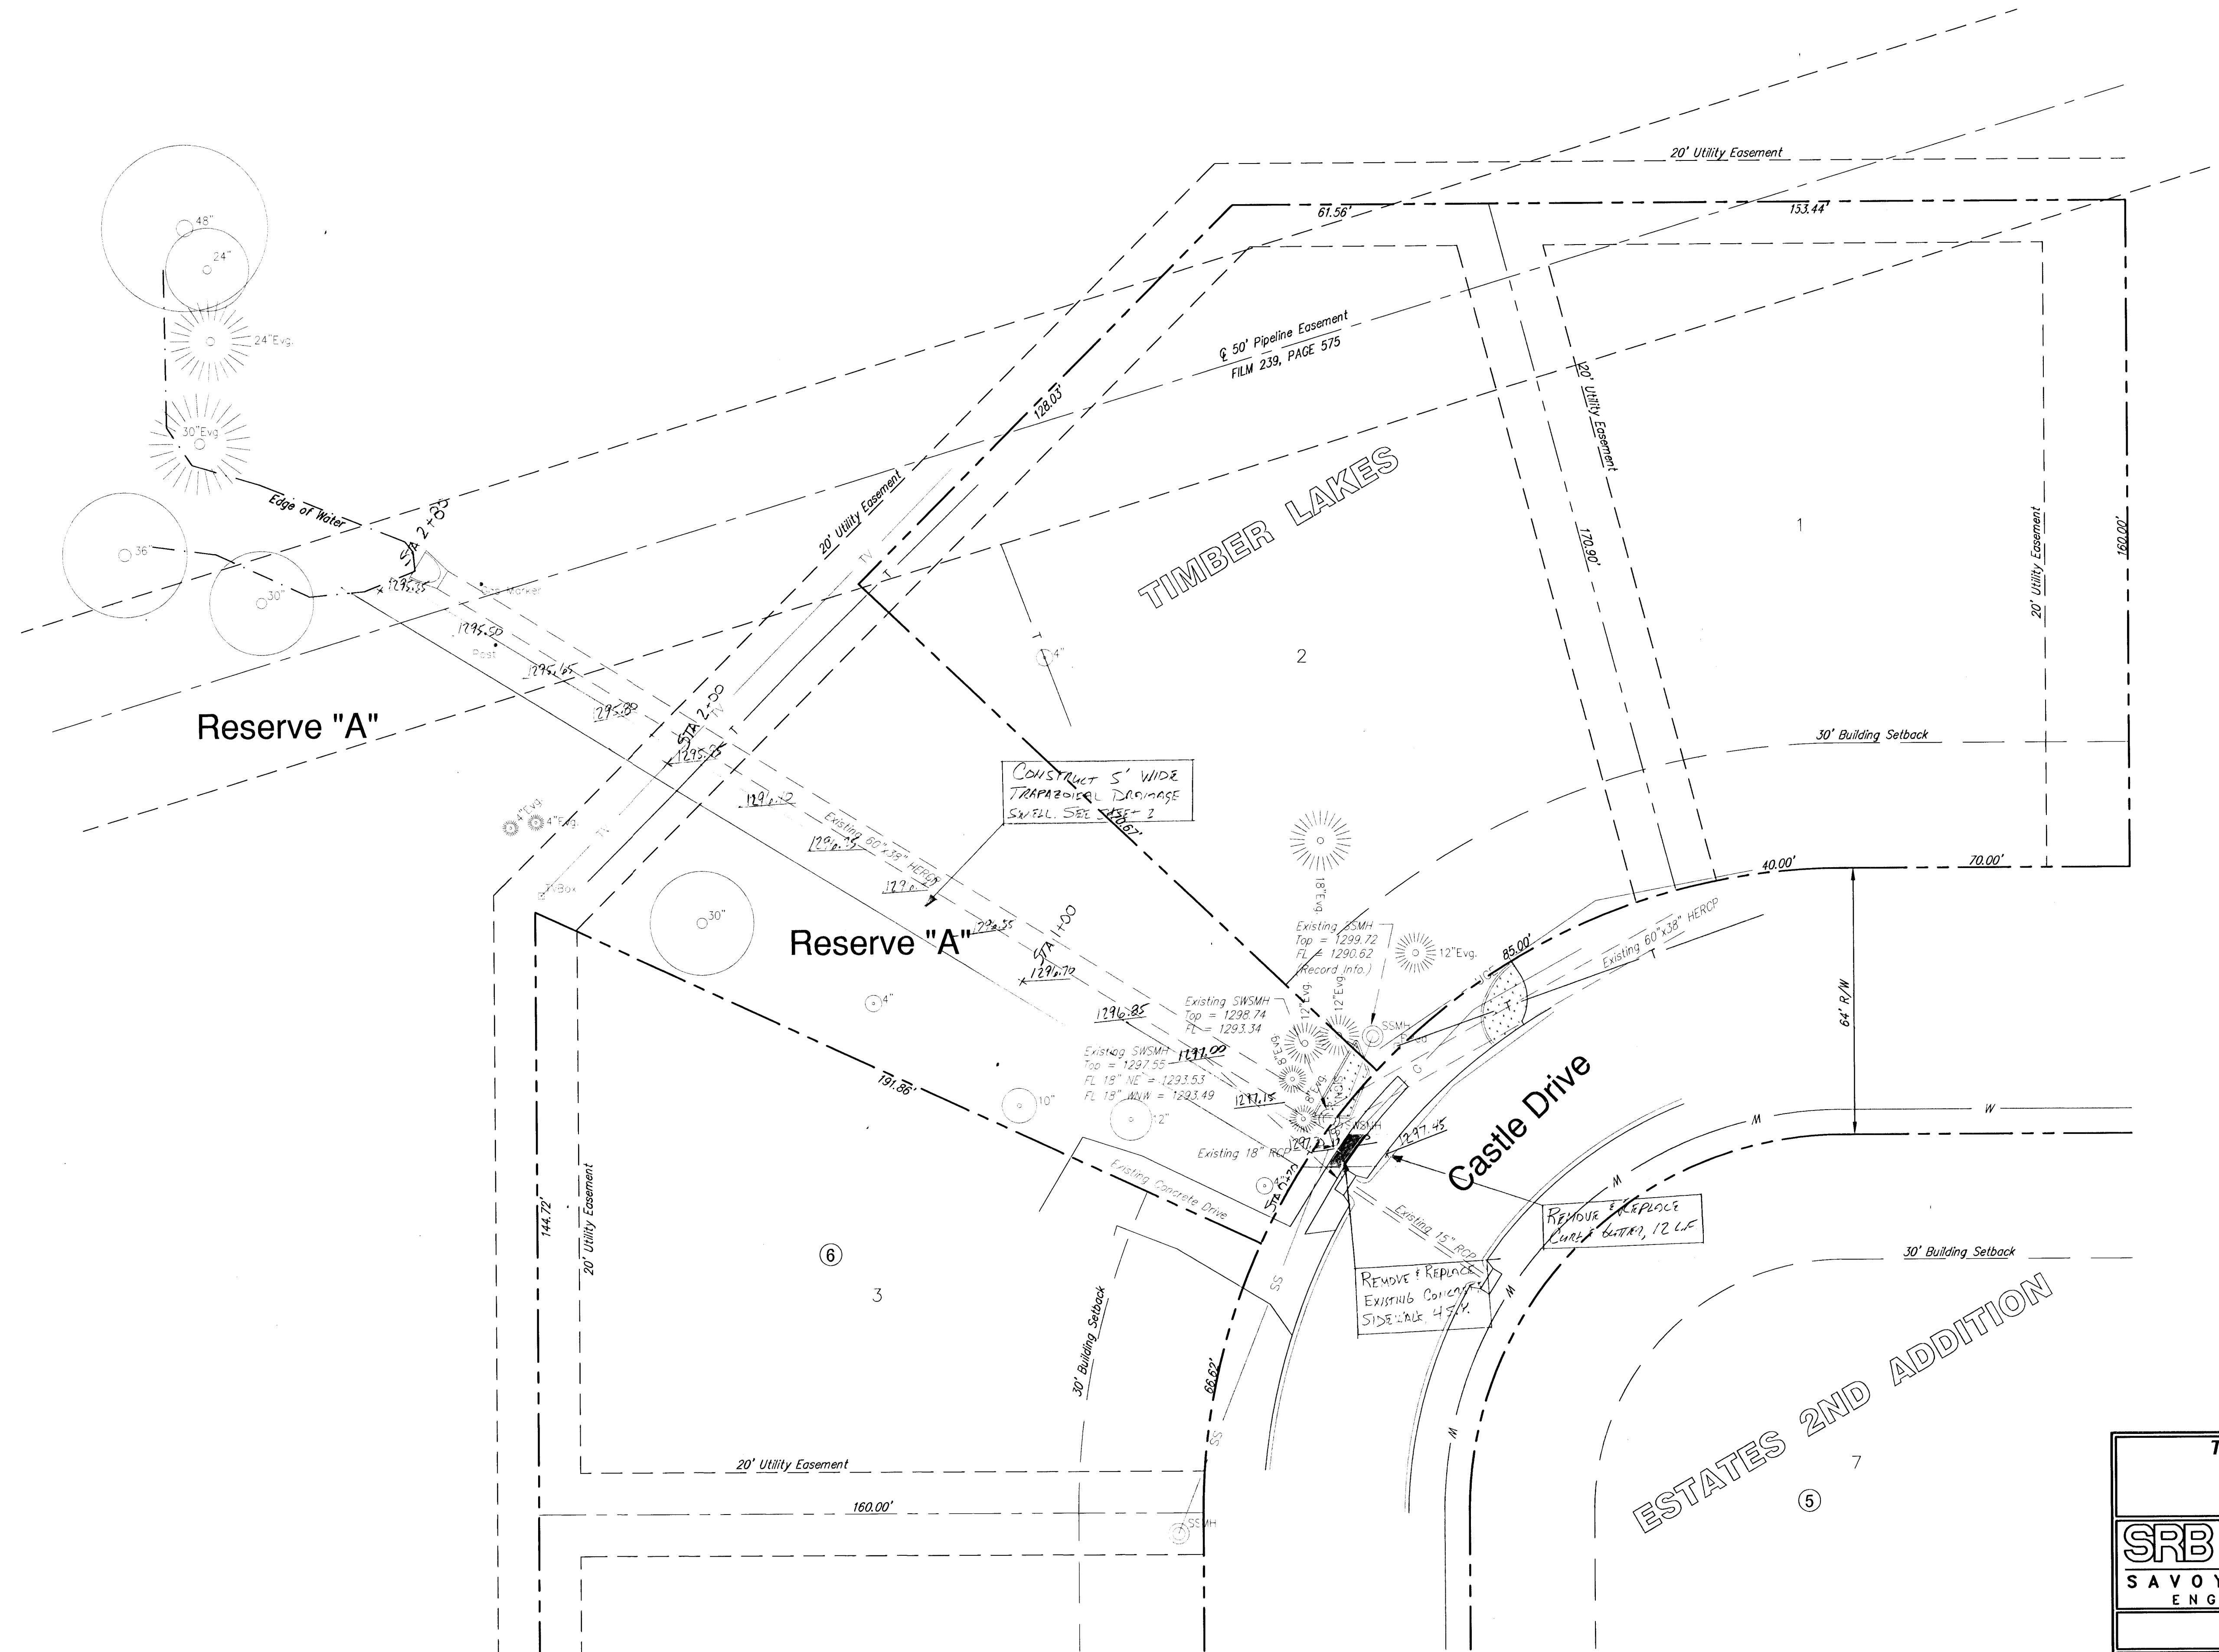

SRB
Scale 1" = 20'

TIMBER LAKES ESTATES 2ND ADDITION DRAINAGE SURVEY WICHITA, KANSAS					
SRB		924 NORTH MAIN WICHITA, KANSAS 67203 www.srb1.com		316-264-9008 FAX 264-4621 E-mail: srb@srb1.com	
SAVOY, RUGGLES & BOHM, P. A. ENGINEERING & SURVEYING					
PROJECT NUMBER					
DESIGN	DRAWN	UTILITY	REVIEW	DATE	REVISED
CMB	RA			July 2, 2001	
SHEET 2 OF 2					DATE JUL 2 2001