


PUB. ROAD DIV. NO.	STATE	FED. AID PROJ. NO.	FISCAL YEAR	SHEET NO.	TOTAL SHEETS
5	KANSAS	635W-871-55W-1(33)46	1970	803	887

DATE	BY	FINAL SURVEY
		NOTED
		PLANNED
		APPROVED

DATE	BY	ORIGINAL SURVEY
		NOTED
		PLANNED
		APPROVED

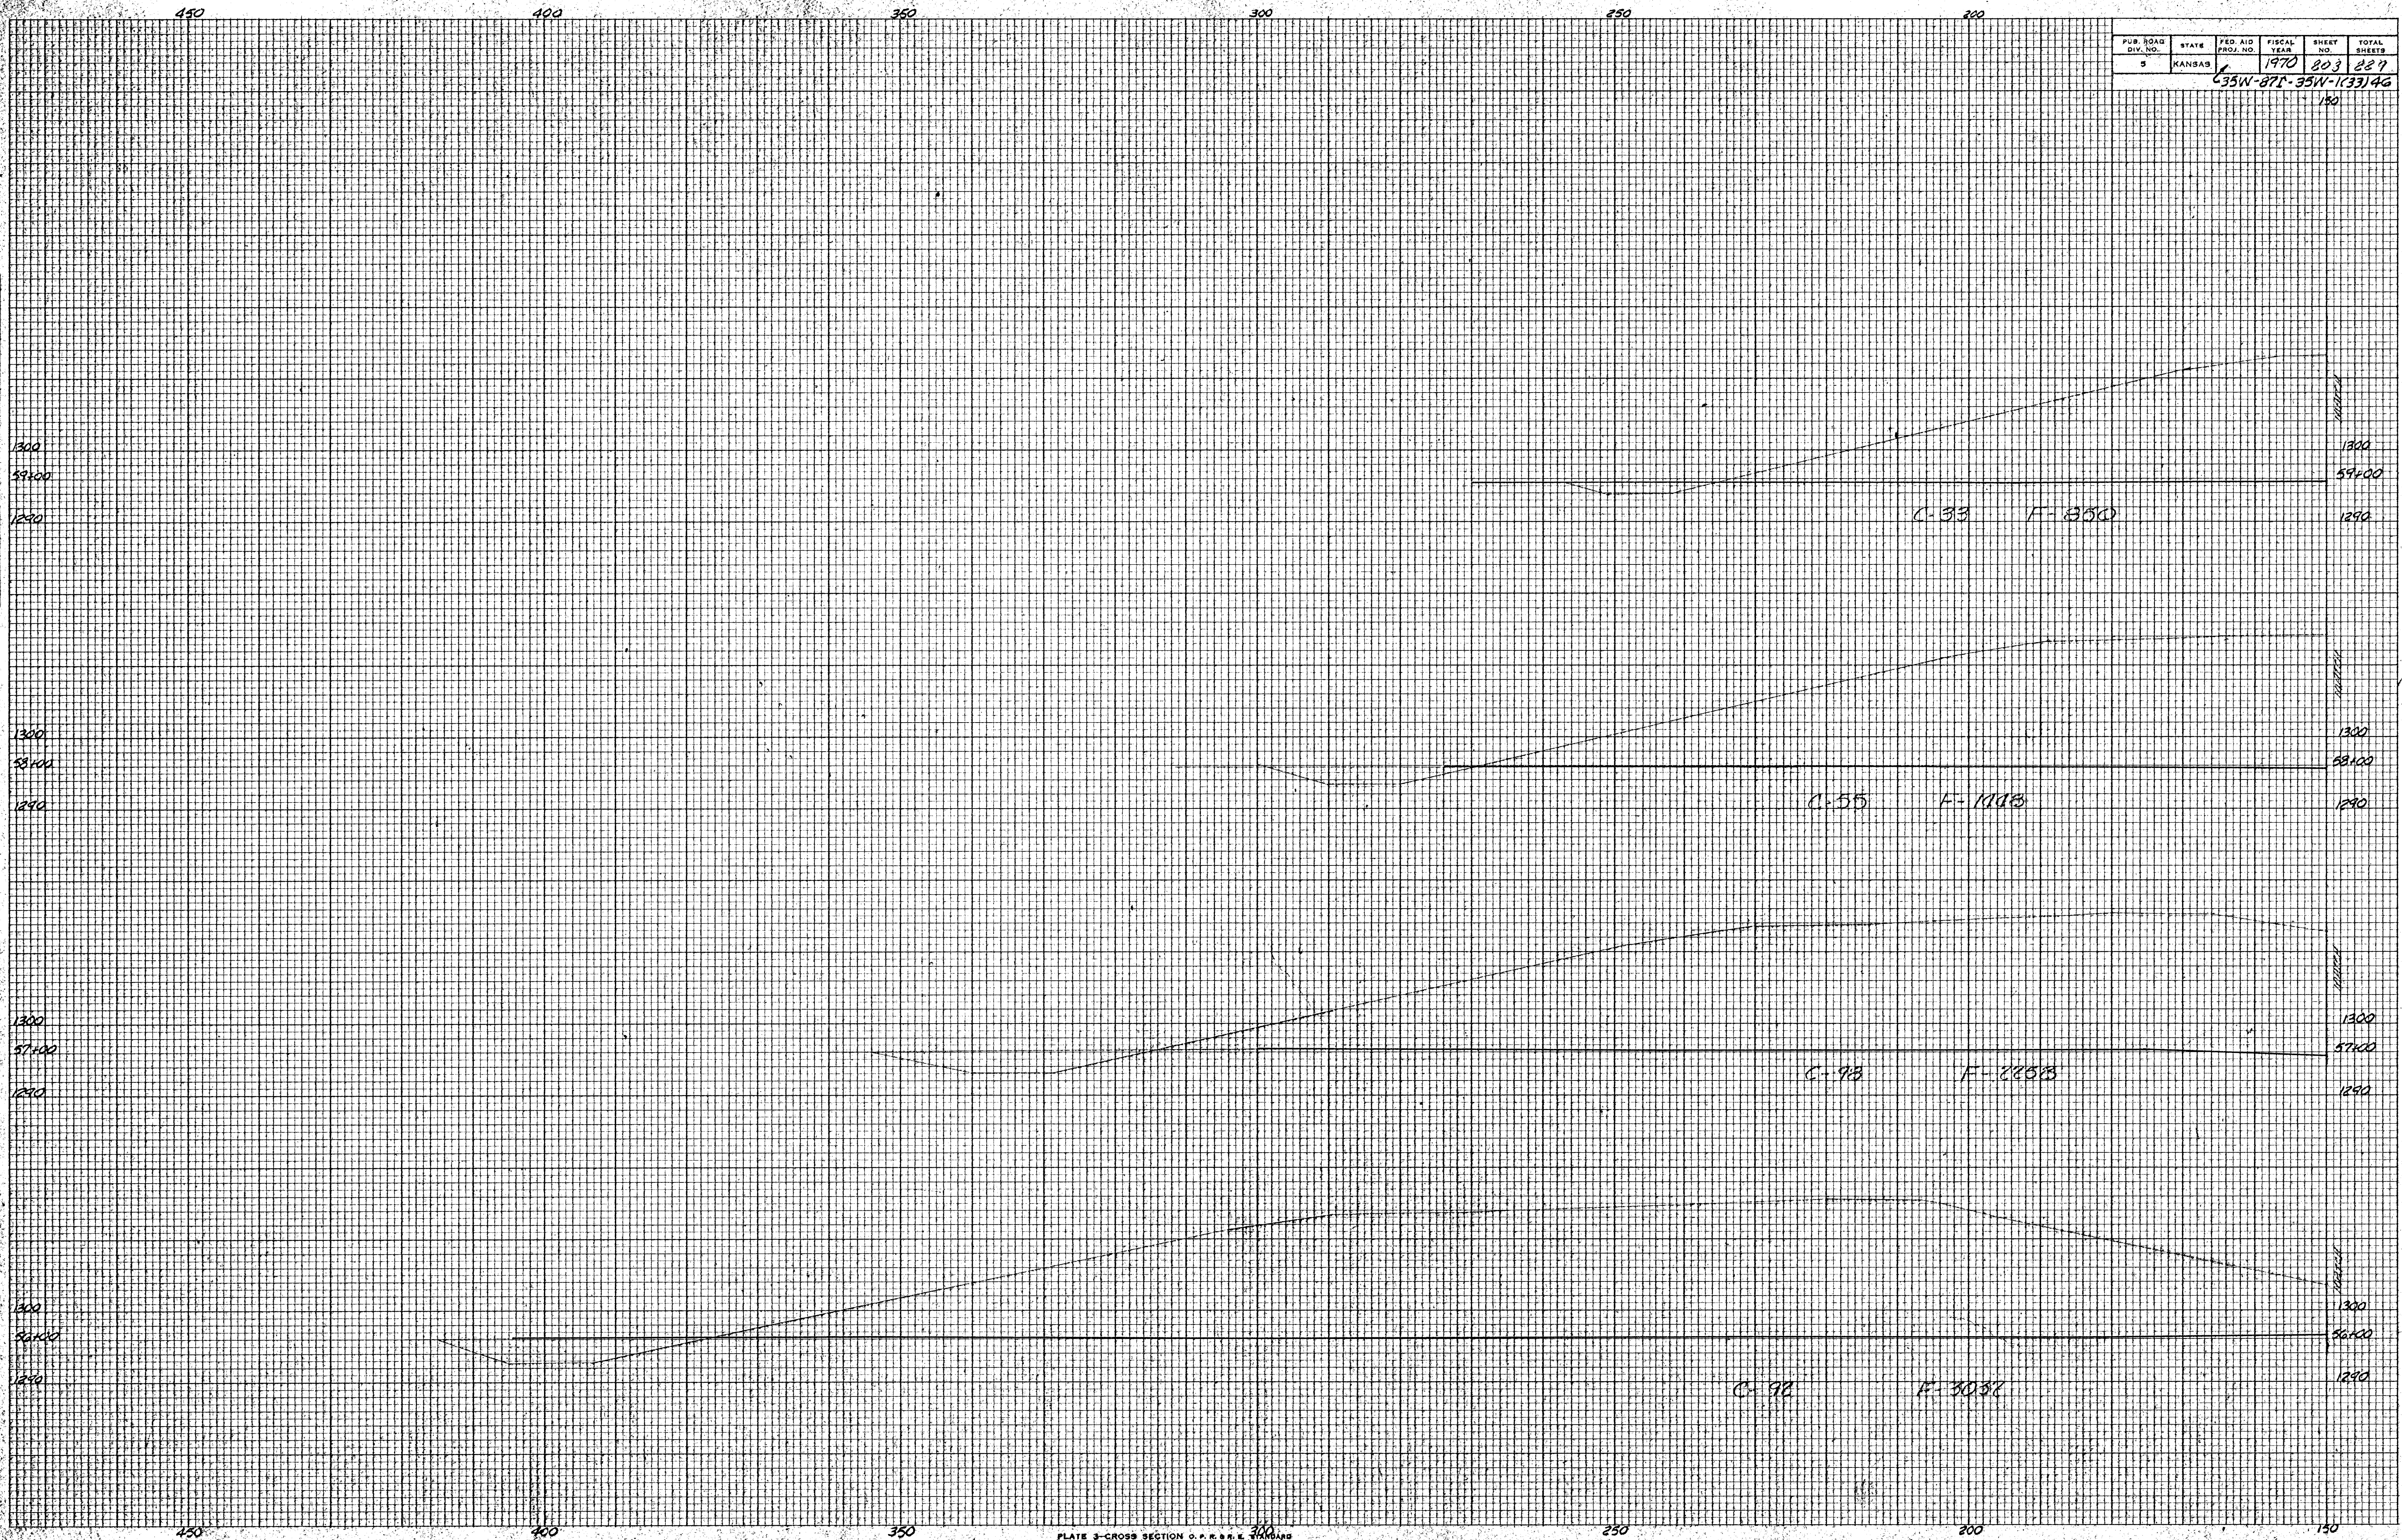

7.24
1.22
8.46

7.34
1.30
8.64

121
127
358
1428
230

63
151
188
349
205
303