
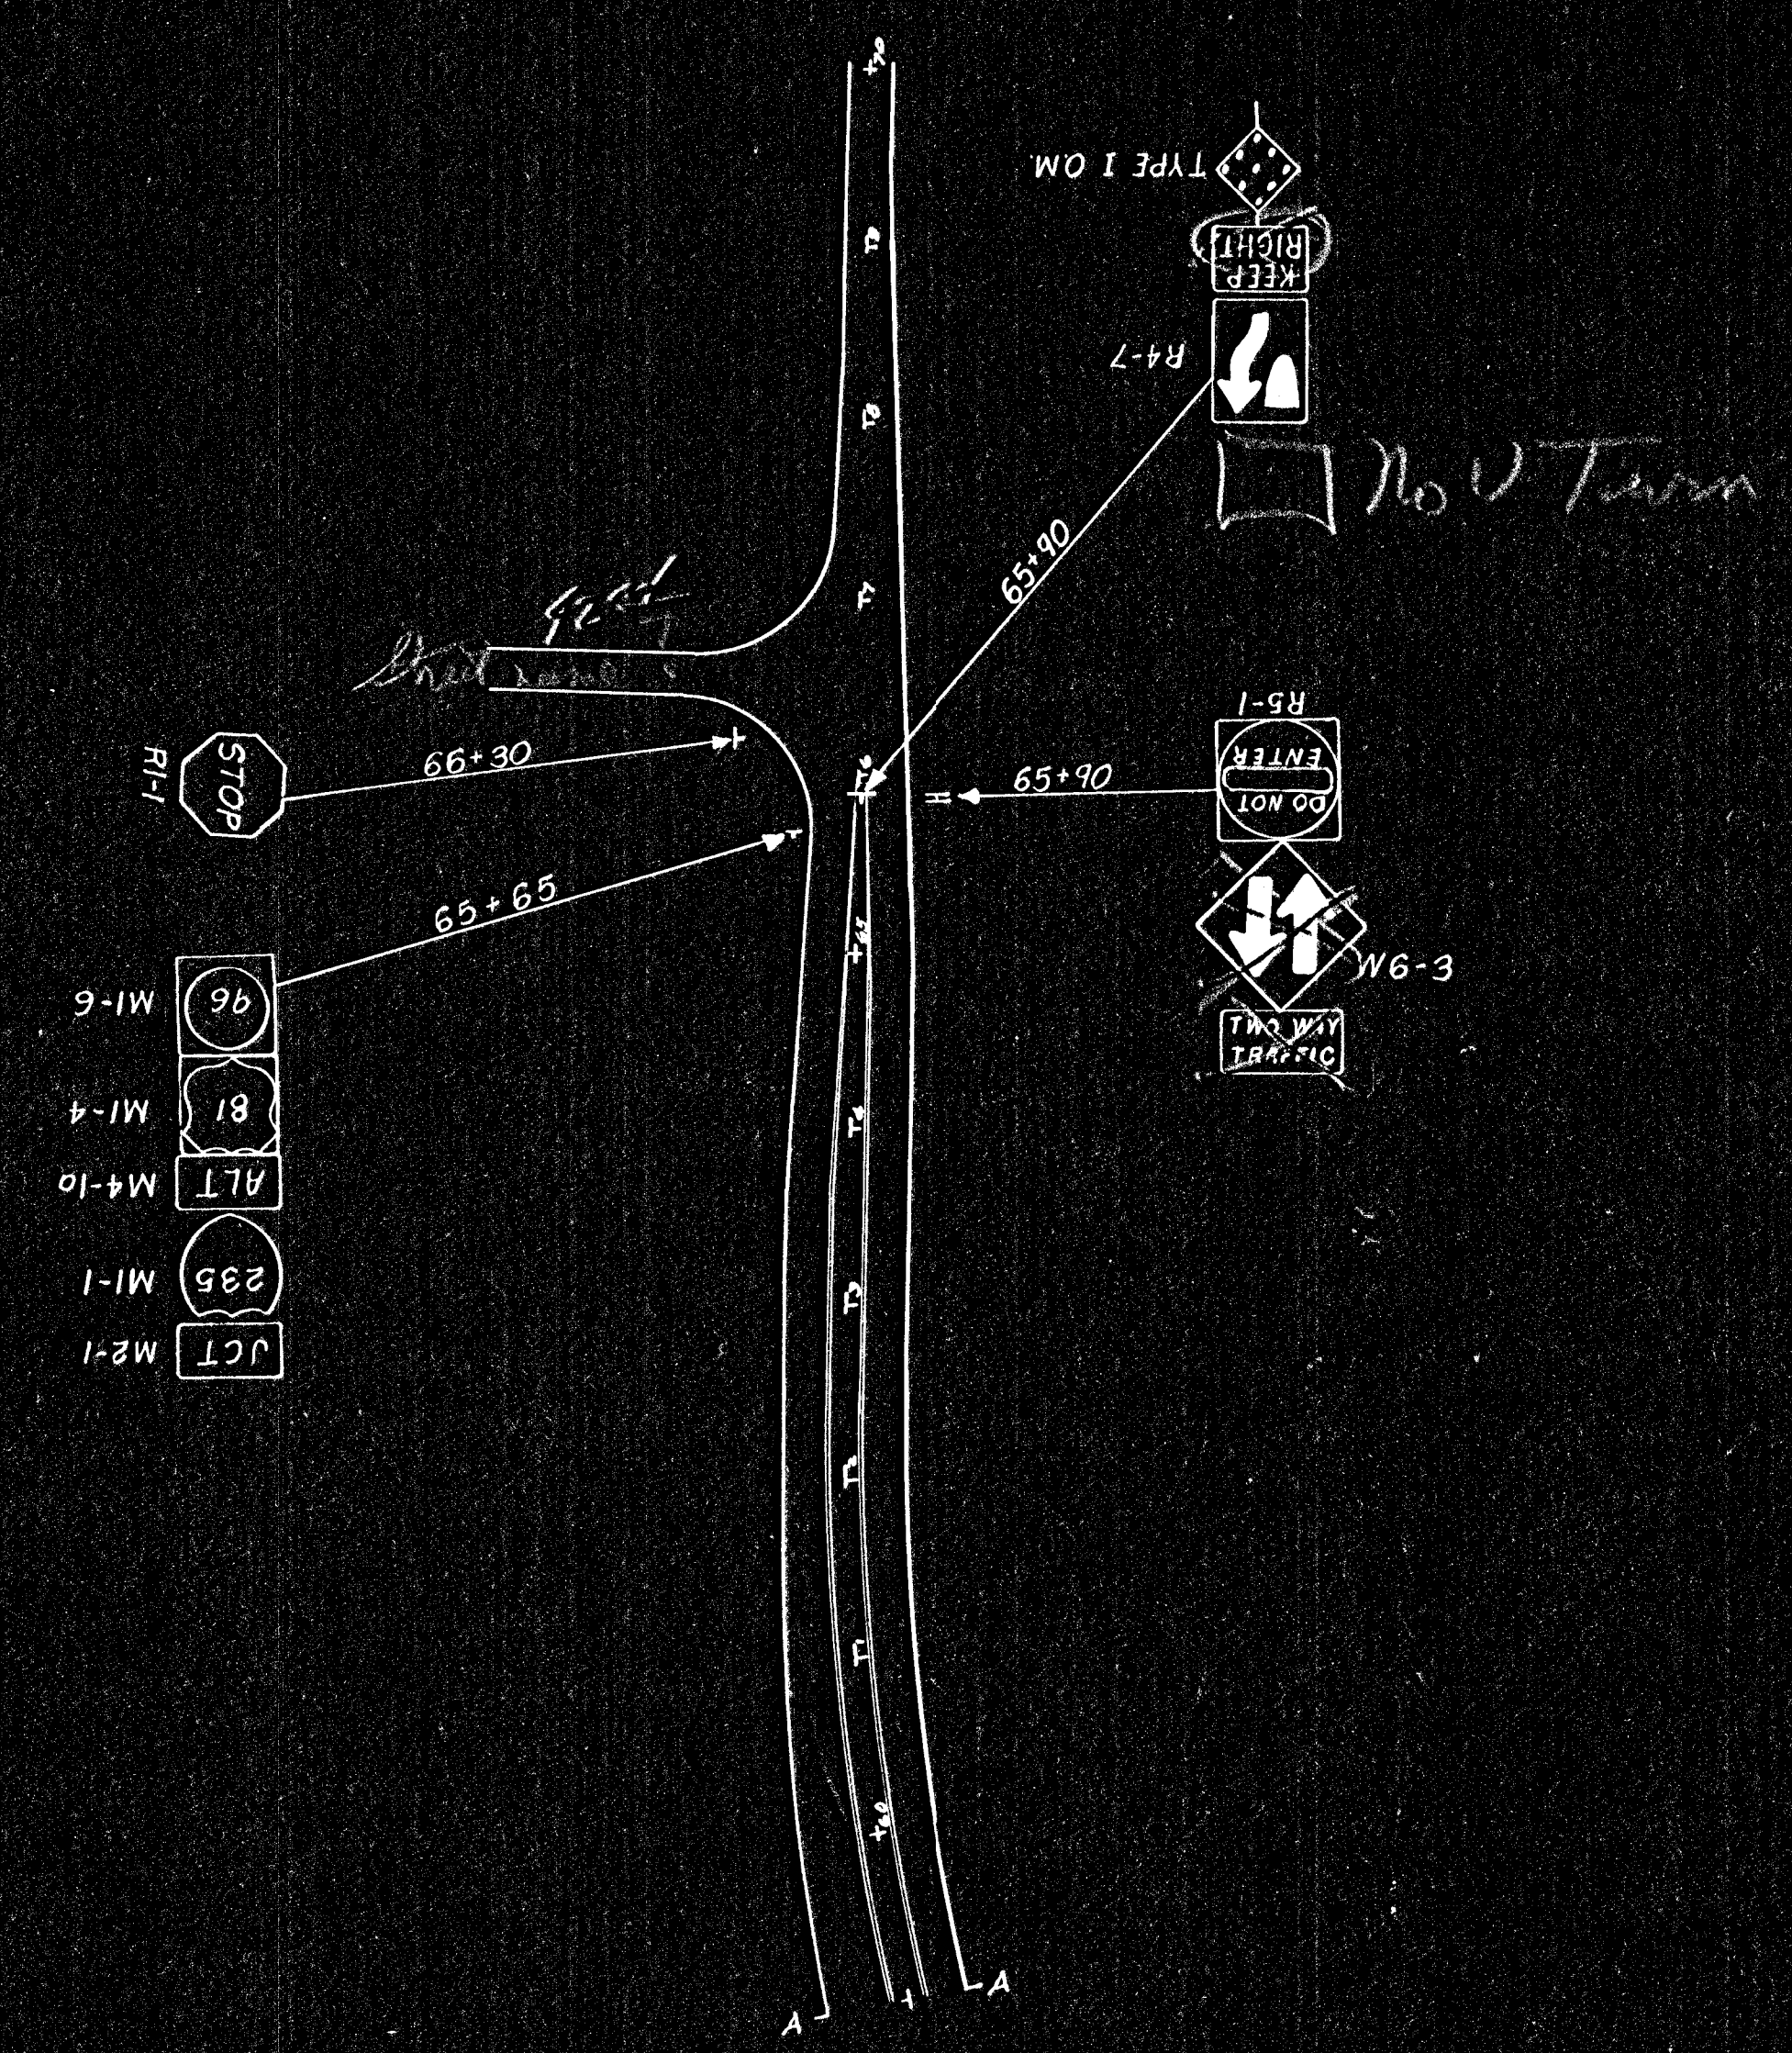


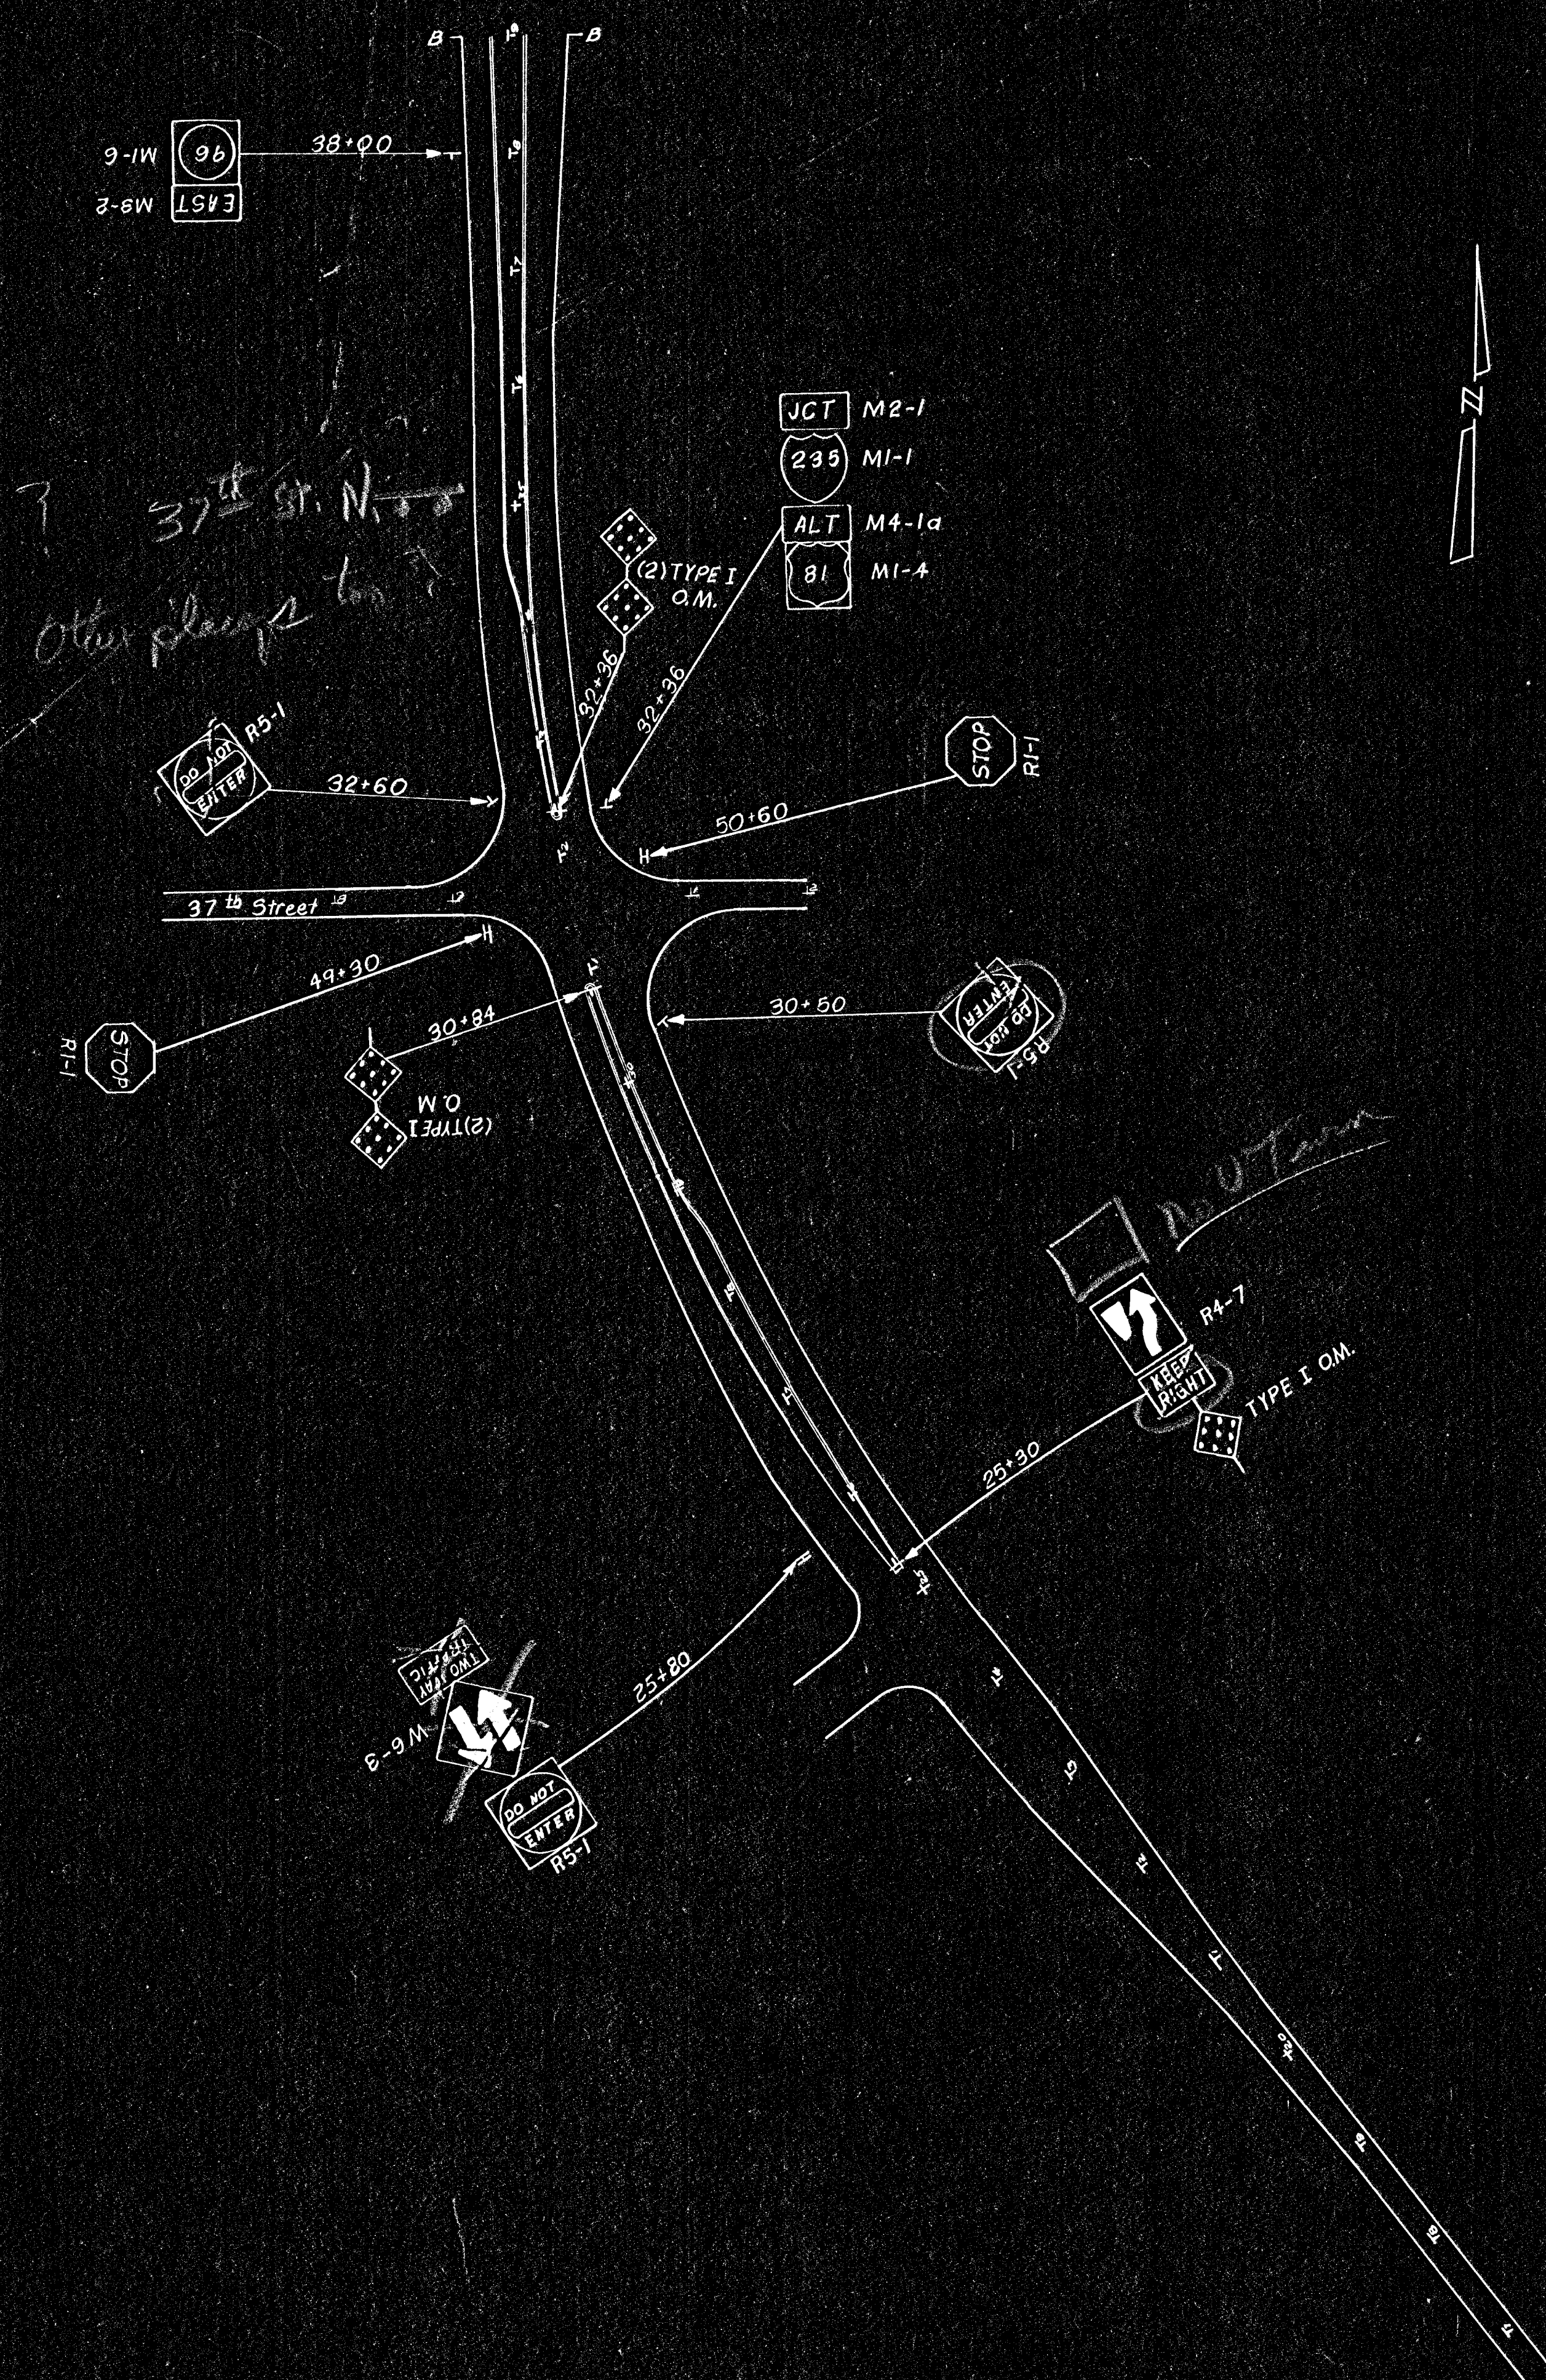

NOTE: Signs & Copy Not To Scale

NO.	DATE	REVISIONS	BY	APP'D
1				
2				
3				

DEPARTMENT OF TRANSPORTATION - KANSAS

MERIDIAN AVENUE
Sta. 17+00 to Sta. 39+00 &
Sta. 59+00 to Sta. 70+00

SHEET NO. 14 OF 143	SCALE 1" = 100'-0"	APP'D	QUANTITIES
DESIGNED BY	DETAILED BY	QUAN. CK.	TRACE CK.