


PLAN	DATE	BY	CHECKED
SURVEYED	1933	W. J. ...	...
NOTED	...	...	...
NOTED	...	...	...
NOTED	...	...	...

PROFILE	DATE	BY	CHECKED
SURVEYED	1933	W. J. ...	...
NOTED	...	...	...
NOTED	...	...	...
NOTED	...	...	...

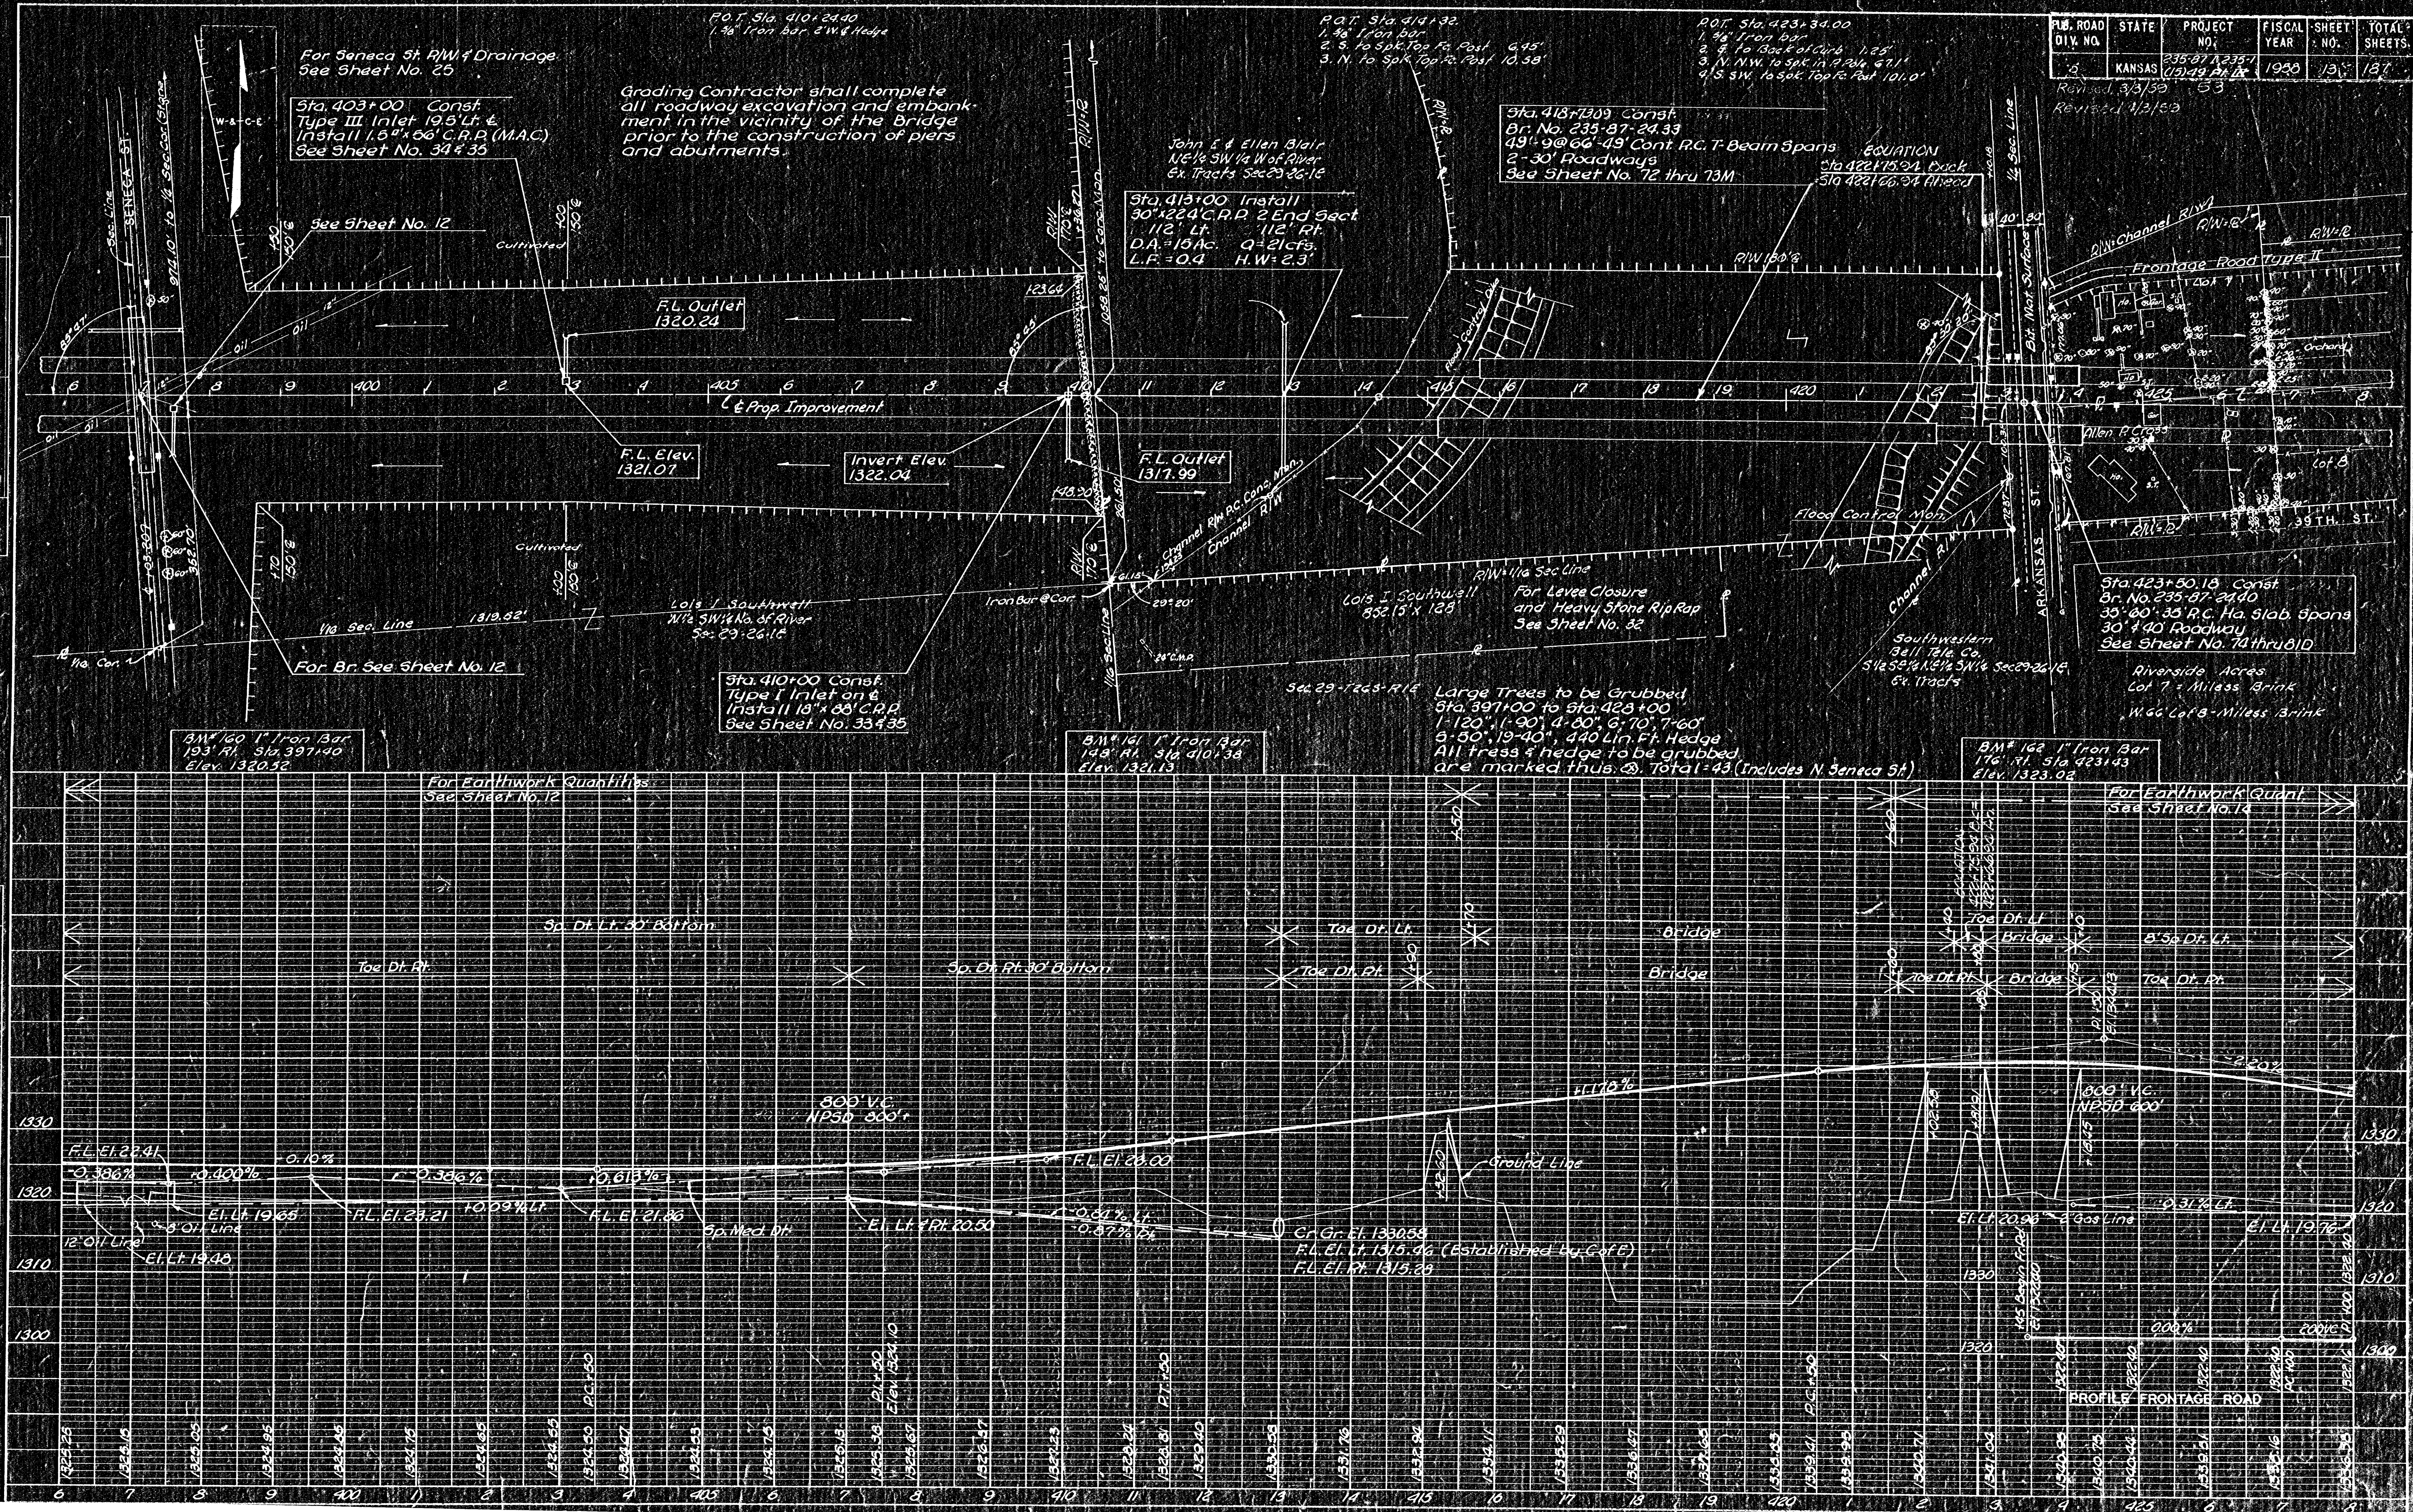

FILE NO.	STATE	PROJECT NO.	FISCAL YEAR	SHEET NO.	TOTAL SHEETS
3	KANSAS	235-87-24.33	1933	137	137

Revised 3/3/33
Revised 4/3/33