


P.H.W.A. REGION NO.	STATE	PROJECT NO.	FISCAL YEAR	SHEET NO.	TOTAL SHEETS
7	KANSAS	X	1976	174	304

*35W-87 & 35W-1(33)40
Construction Phase 3

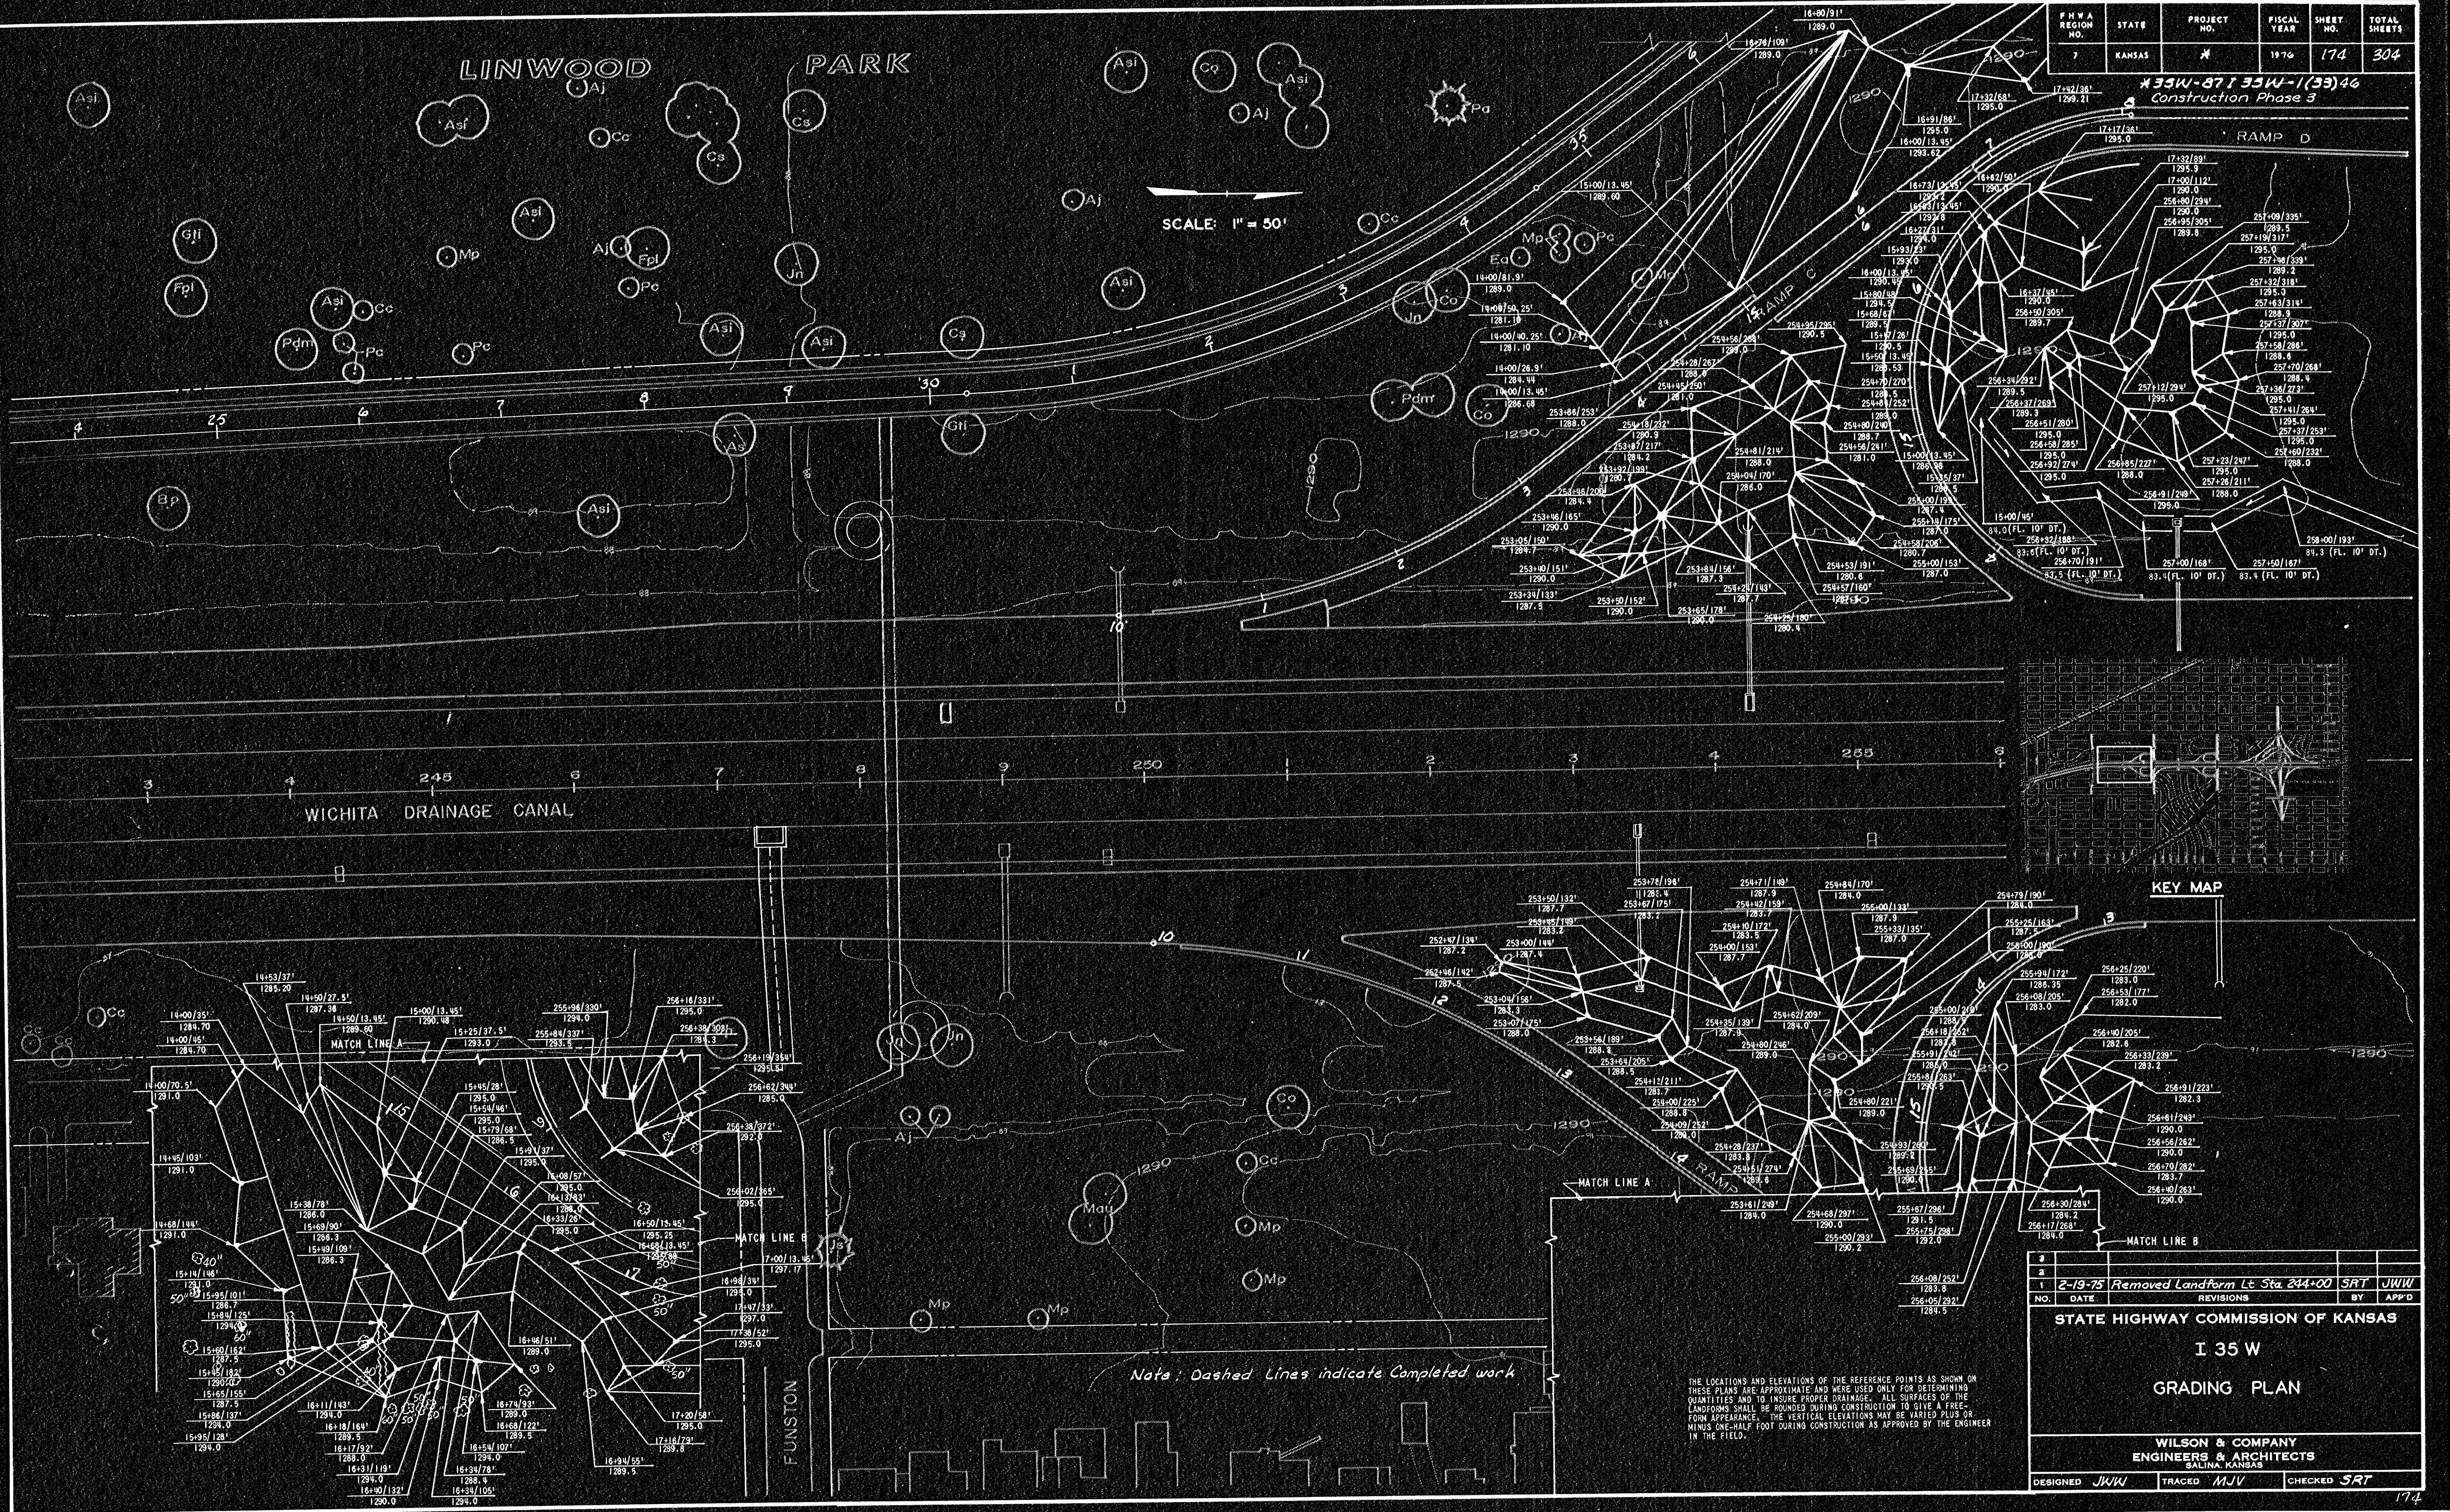

Note: Dashed Lines indicate Completed work

THE LOCATIONS AND ELEVATIONS OF THE REFERENCE POINTS AS SHOWN ON THESE PLANS ARE APPROXIMATE AND WERE USED ONLY FOR DETERMINING QUANTITIES AND TO INSURE PROPER DRAINAGE. ALL SURFACES OF THE LANDFORMS SHALL BE ROUNDED DURING CONSTRUCTION TO GIVE THEM A NEAT APPEARANCE. THE VERTICAL ELEVATIONS MAY BE VARIED PLUS OR MINUS ONE-HALF FOOT DURING CONSTRUCTION AS APPROVED BY THE ENGINEER IN THE FIELD.

3				
1				
	2-19-75	Removed Landform Lt Sta 244+00	SRT	JWW
NO.	DATE	REVISIONS	BY	APP'D
STATE HIGHWAY COMMISSION OF KANSAS				
I 35 W				
GRADING PLAN				
WILSON & COMPANY ENGINEERS & ARCHITECTS SALINA, KANSAS				
DESIGNED	JWW	TRACED	MJV	CHECKED SRT