




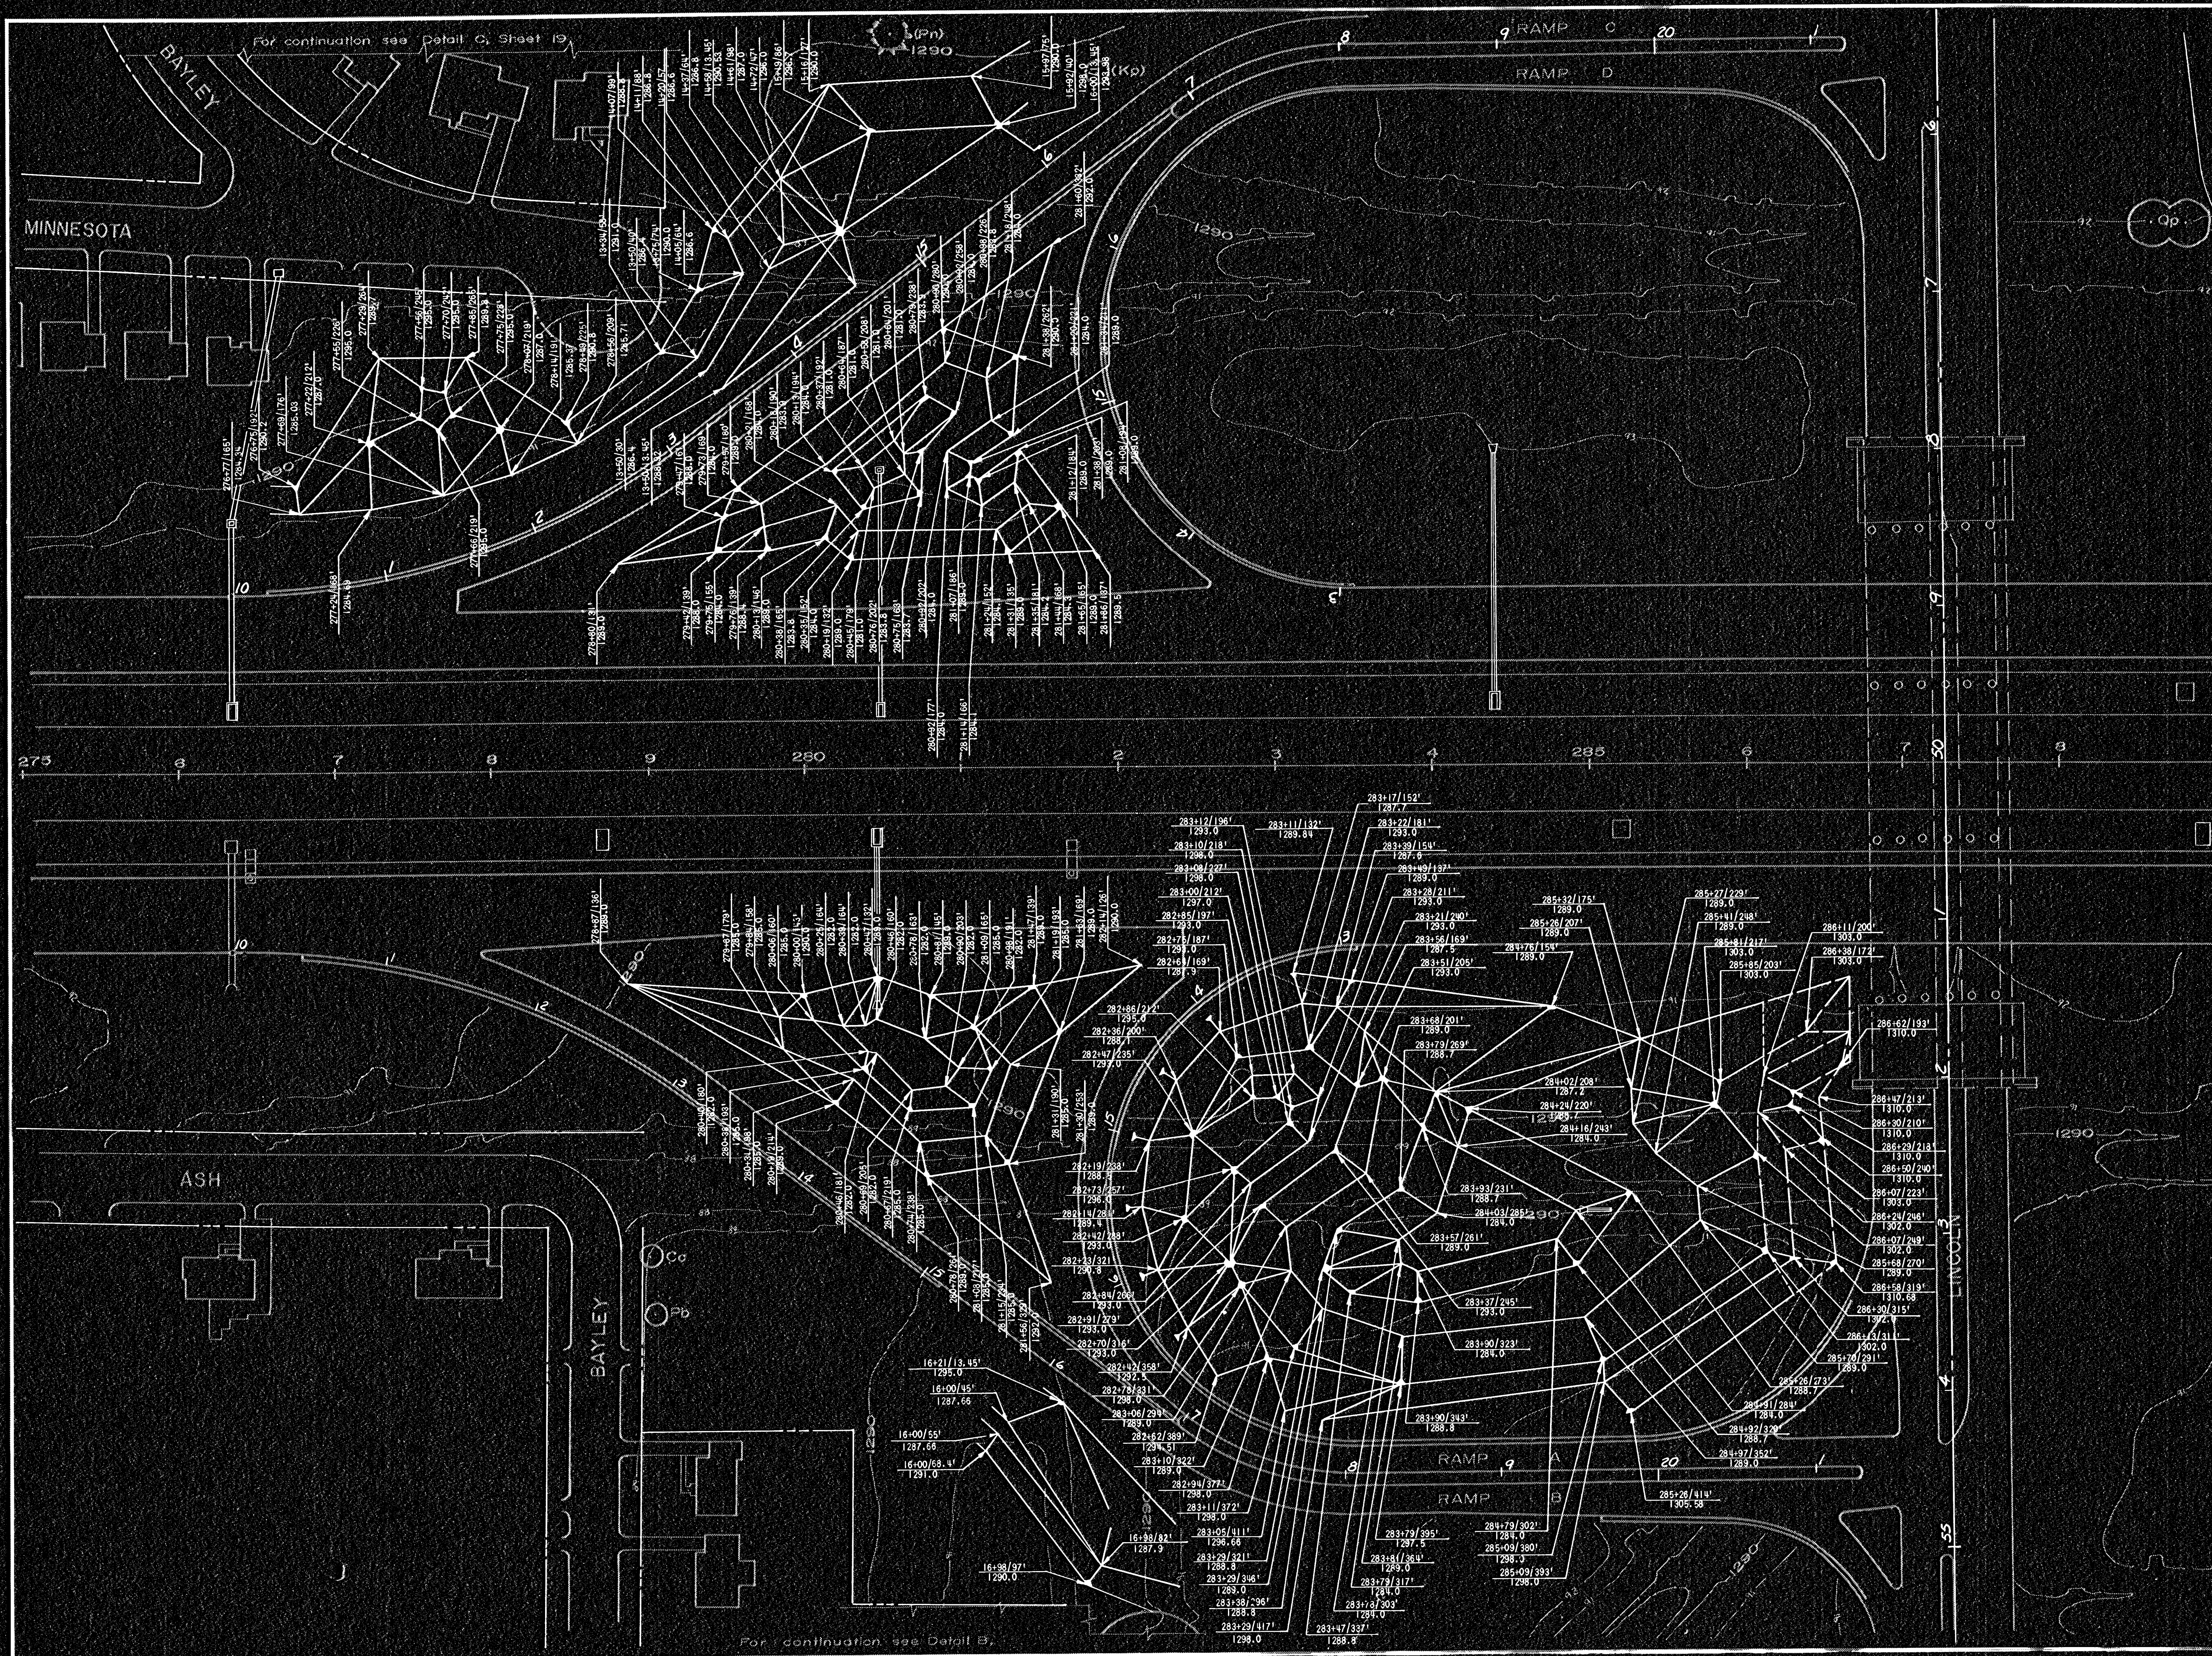


| P. H. & A. REGION NO. | STATE  | PROJECT NO. | FISCAL YEAR | SHEET NO. | TOTAL SHEETS |
|-----------------------|--------|-------------|-------------|-----------|--------------|
| 7                     | KANSAS | #           | 1976        | 178       | 304          |

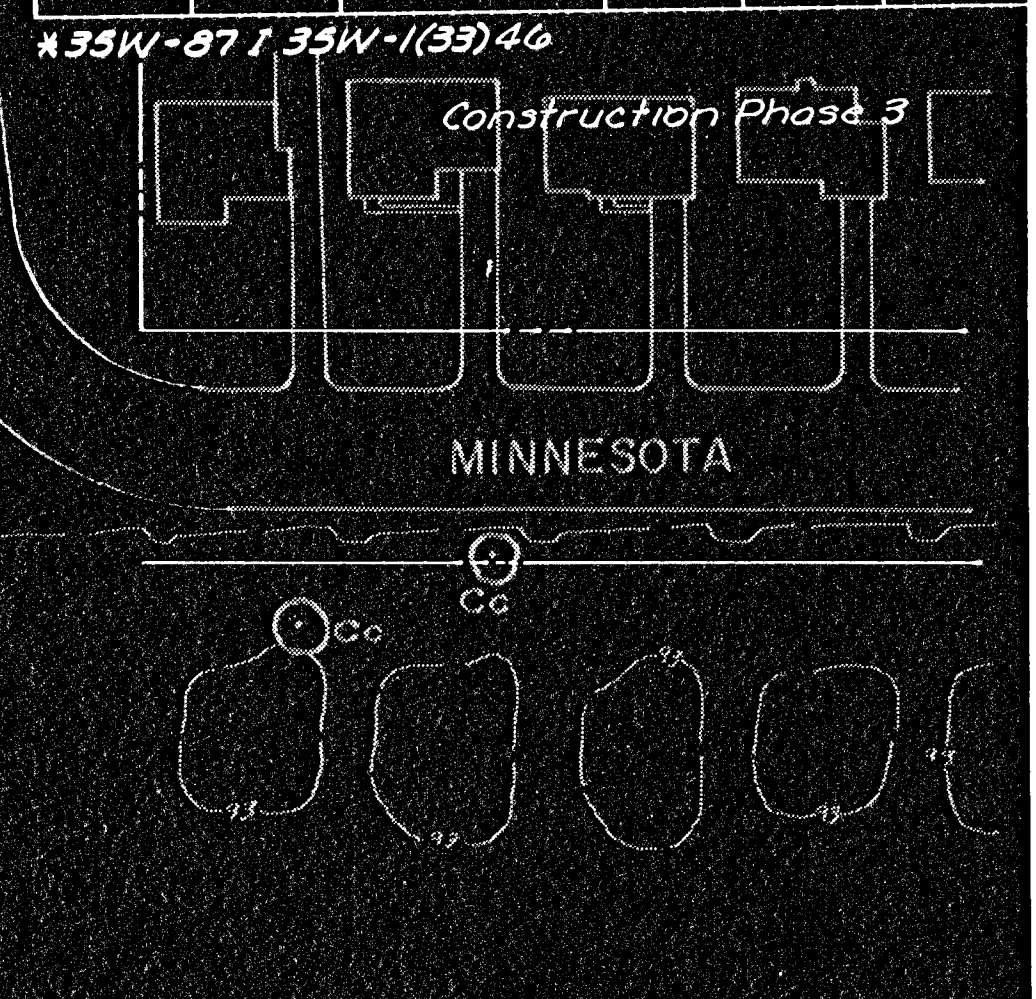

SCALE: 1" = 50'

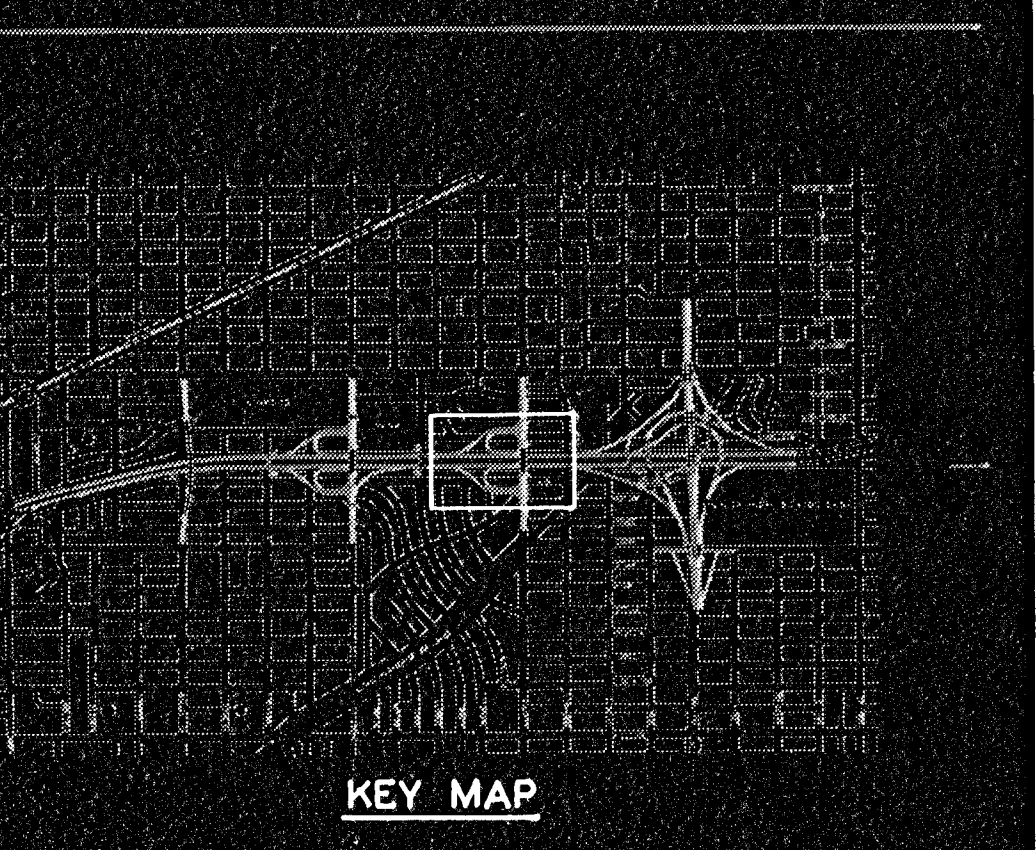

THE LOCATIONS AND ELEVATIONS OF THE REFERENCE POINTS AS SHOWN ON THESE PLANS ARE APPROXIMATE AND WERE USED ONLY FOR DETERMINING QUANTITIES AND TO INSURE PROPER DRAINAGE. ALL SURFACES OF THE LANDFORMS SHALL BE ROUNDED DURING CONSTRUCTION TO GIVE A FREE-FORM APPEARANCE. THE VERTICAL ELEVATIONS MAY BE VARIED PLUS OR MINUS ONE-HALF FOOT DURING CONSTRUCTION AS APPROVED BY THE ENGINEER IN THE FIELD.

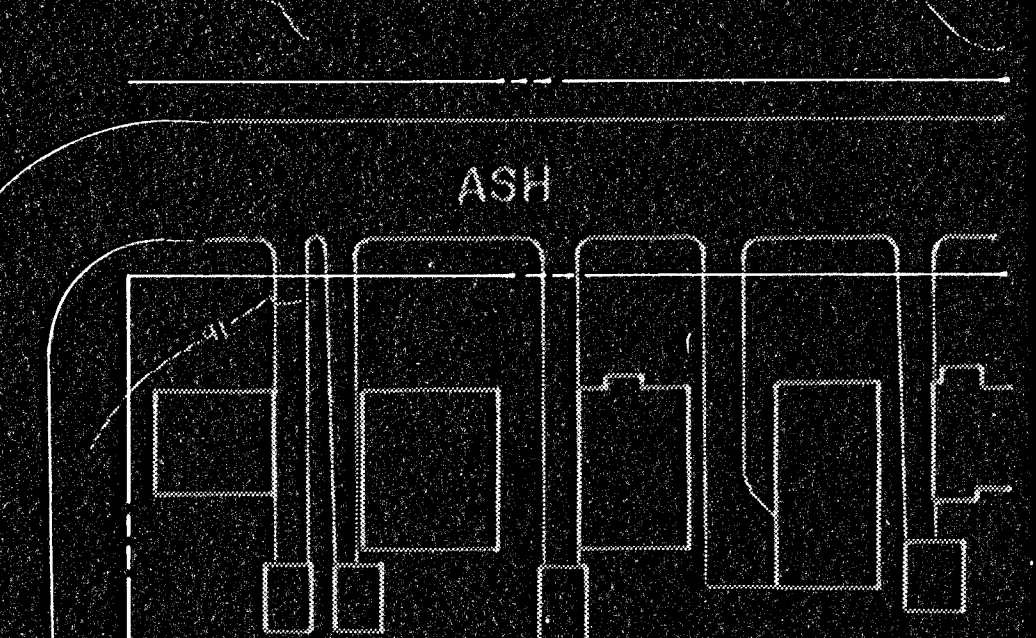

| Note: Dashed Lines Indicate Completed Work.                  |         |                                           |     |         |     |
|--------------------------------------------------------------|---------|-------------------------------------------|-----|---------|-----|
| 5                                                            | 5-12-75 | Raise Dt. Rt. Sta. 16+00 to 17+78.5 R. B. | SRT | JWW     |     |
| 4                                                            | 5-12-75 | Remove Landform Rt. Sta. 10+00 R. B.      | SRT | JWW     |     |
| NO.                                                          | DATE    | REVISIONS                                 | BY  | APP'D   |     |
| STATE HIGHWAY COMMISSION OF KANSAS                           |         |                                           |     |         |     |
| I 35 W                                                       |         |                                           |     |         |     |
| GRADING PLAN                                                 |         |                                           |     |         |     |
| WILSON & COMPANY<br>ENGINEERS & ARCHITECTS<br>SALINA, KANSAS |         |                                           |     |         |     |
| DESIGNED                                                     | JWW     | TRACED                                    | MJV | CHECKED | SRT |