


CHINA RECORD NO.	STATE	FED. AID PROJ. NO.	FISCAL YEAR	SHEET NO.	TOTAL SHEETS
7	KANSAS	#	1976	202	304

* 35 W-27 T-35 W-1133 46
Construction Phase 3

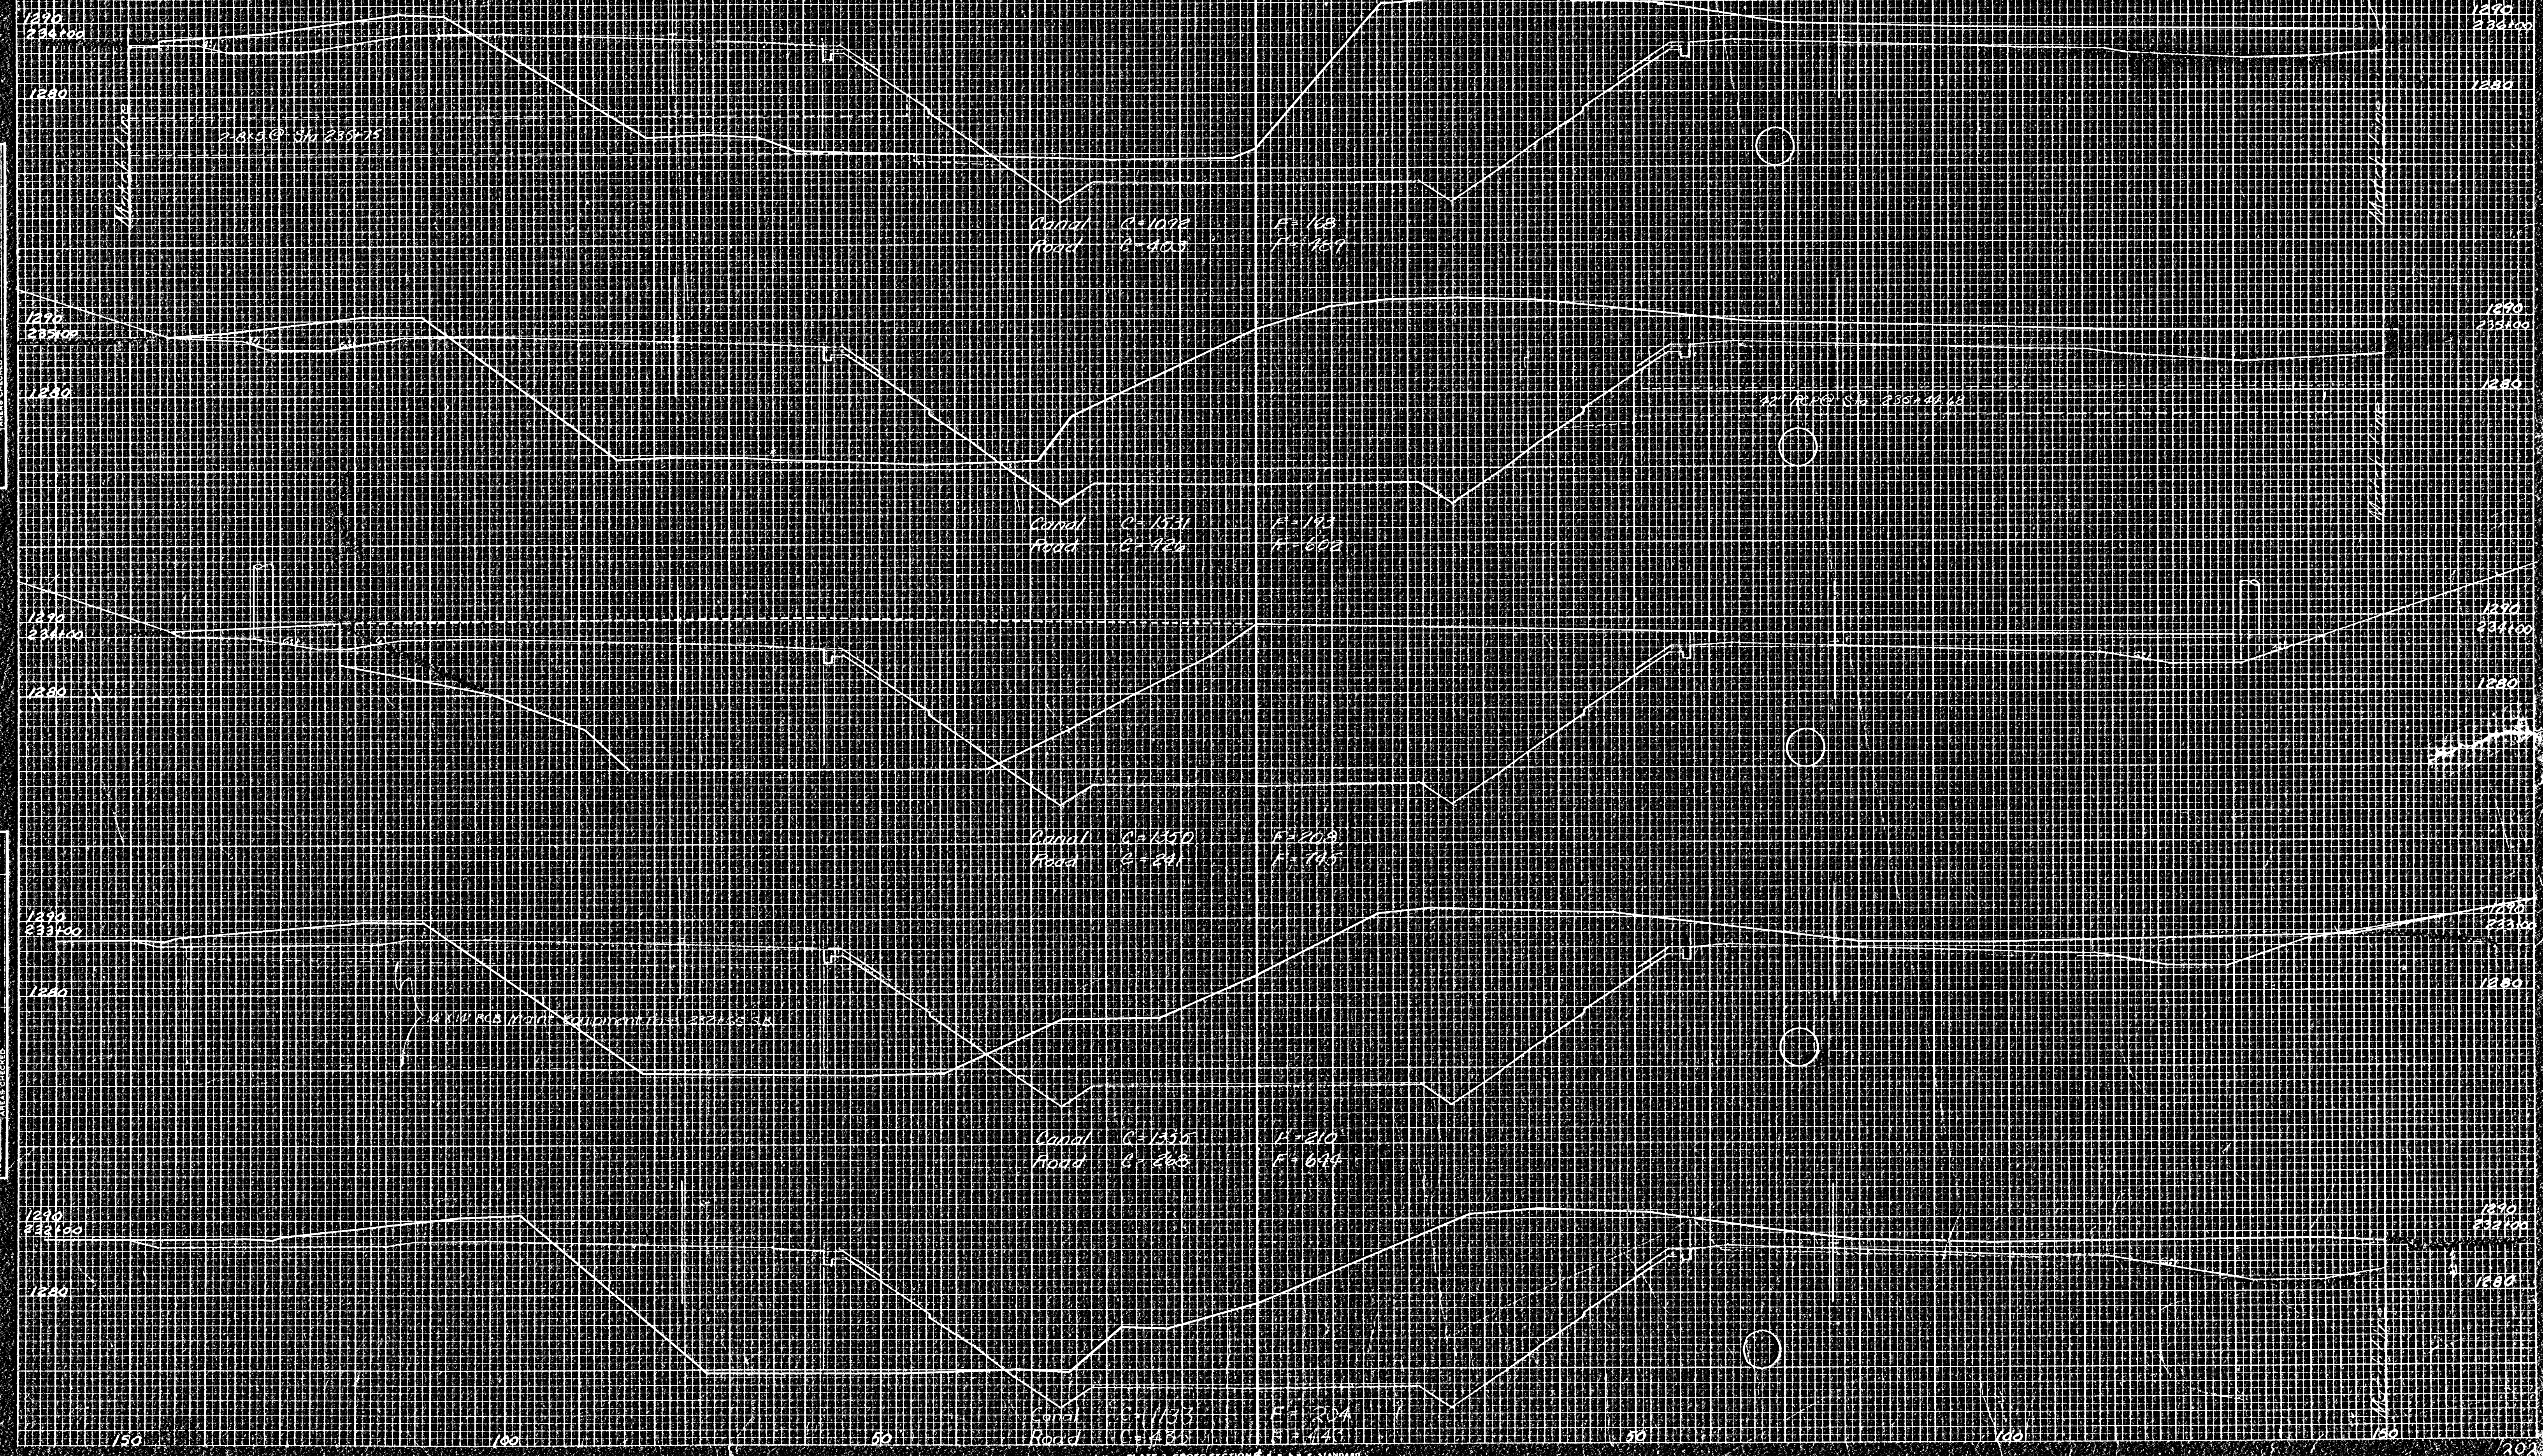

FINAL
SURVEY
NOTEBOOK
NO.

ORIGINAL
SURVEY
NOTEBOOK
NO.