


F H W A REGION NO.	STATE	PROJECT NO.	FISCAL YEAR	SHEET NO.	TOTAL SHEETS
7	KANSAS	X	1976	286	304

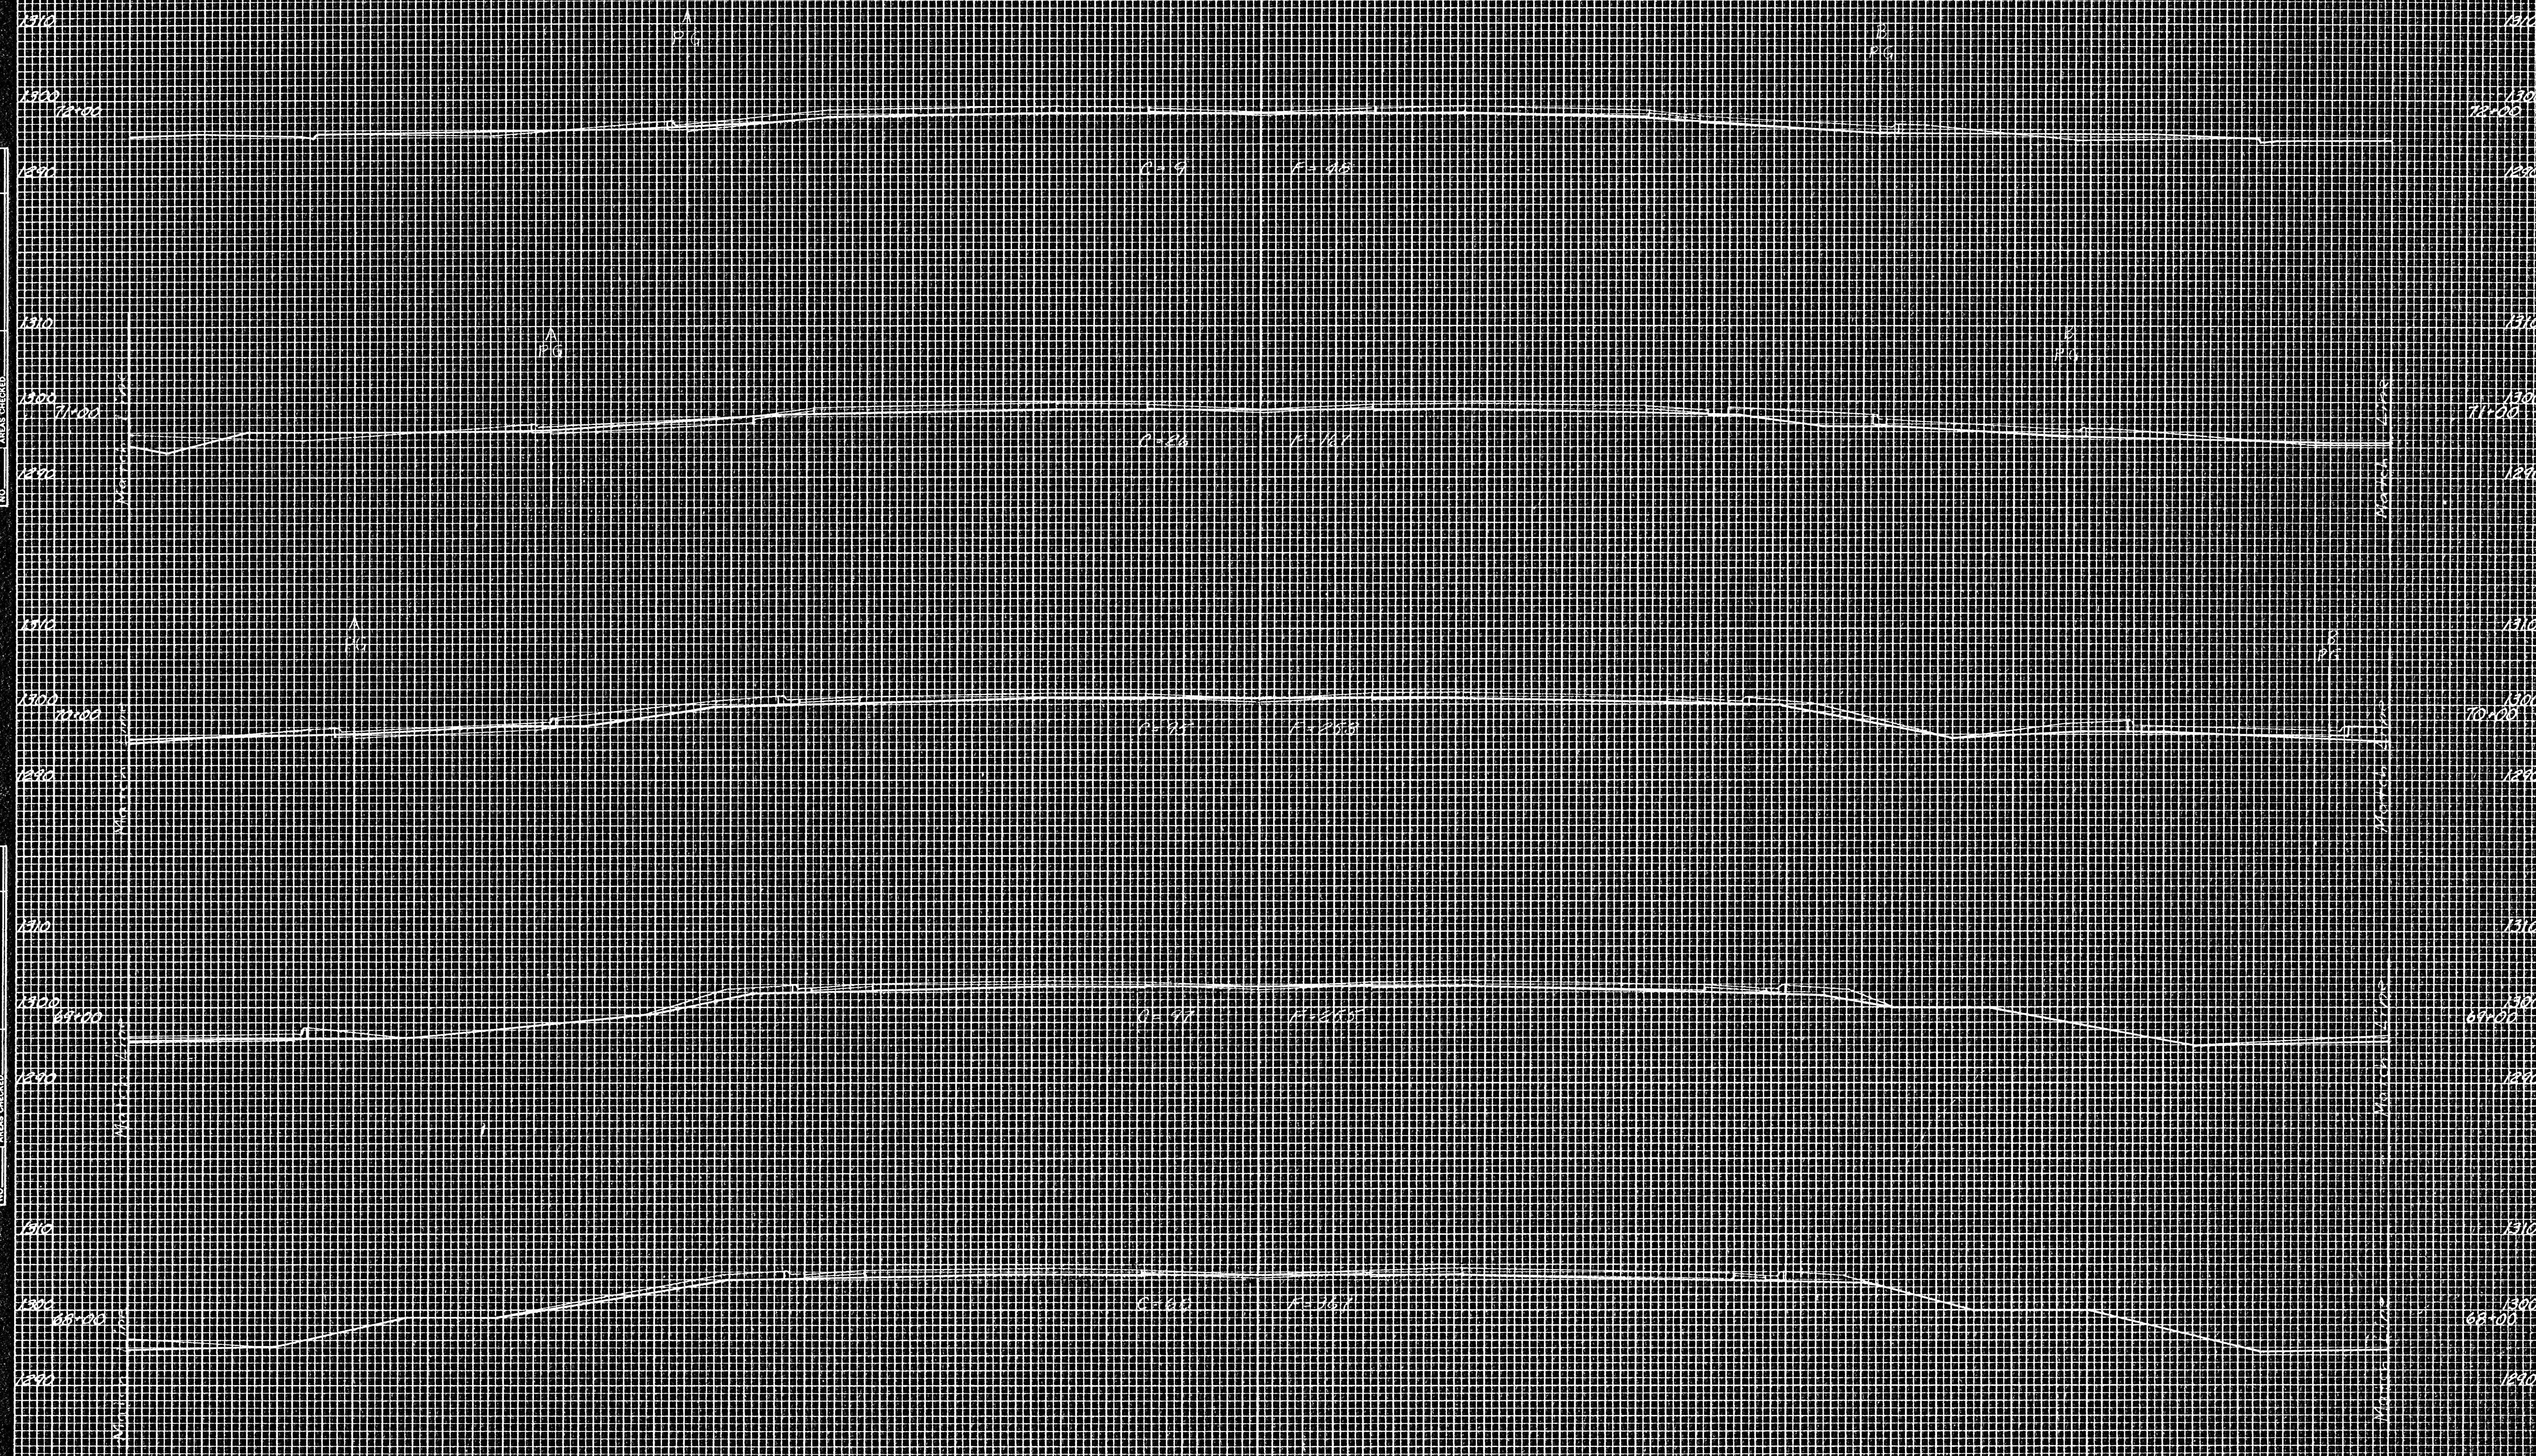

FINAL SURVEY		BY	DATE
SURVEIVED			
PLOTTED			
TEMPLATE			
AREA			

ORIGINAL SURVEY	BY	DATE
SURVEYED		
PLOTTED		
NOTE BOOK		
AREAS		
AREAS OUTLINED		