


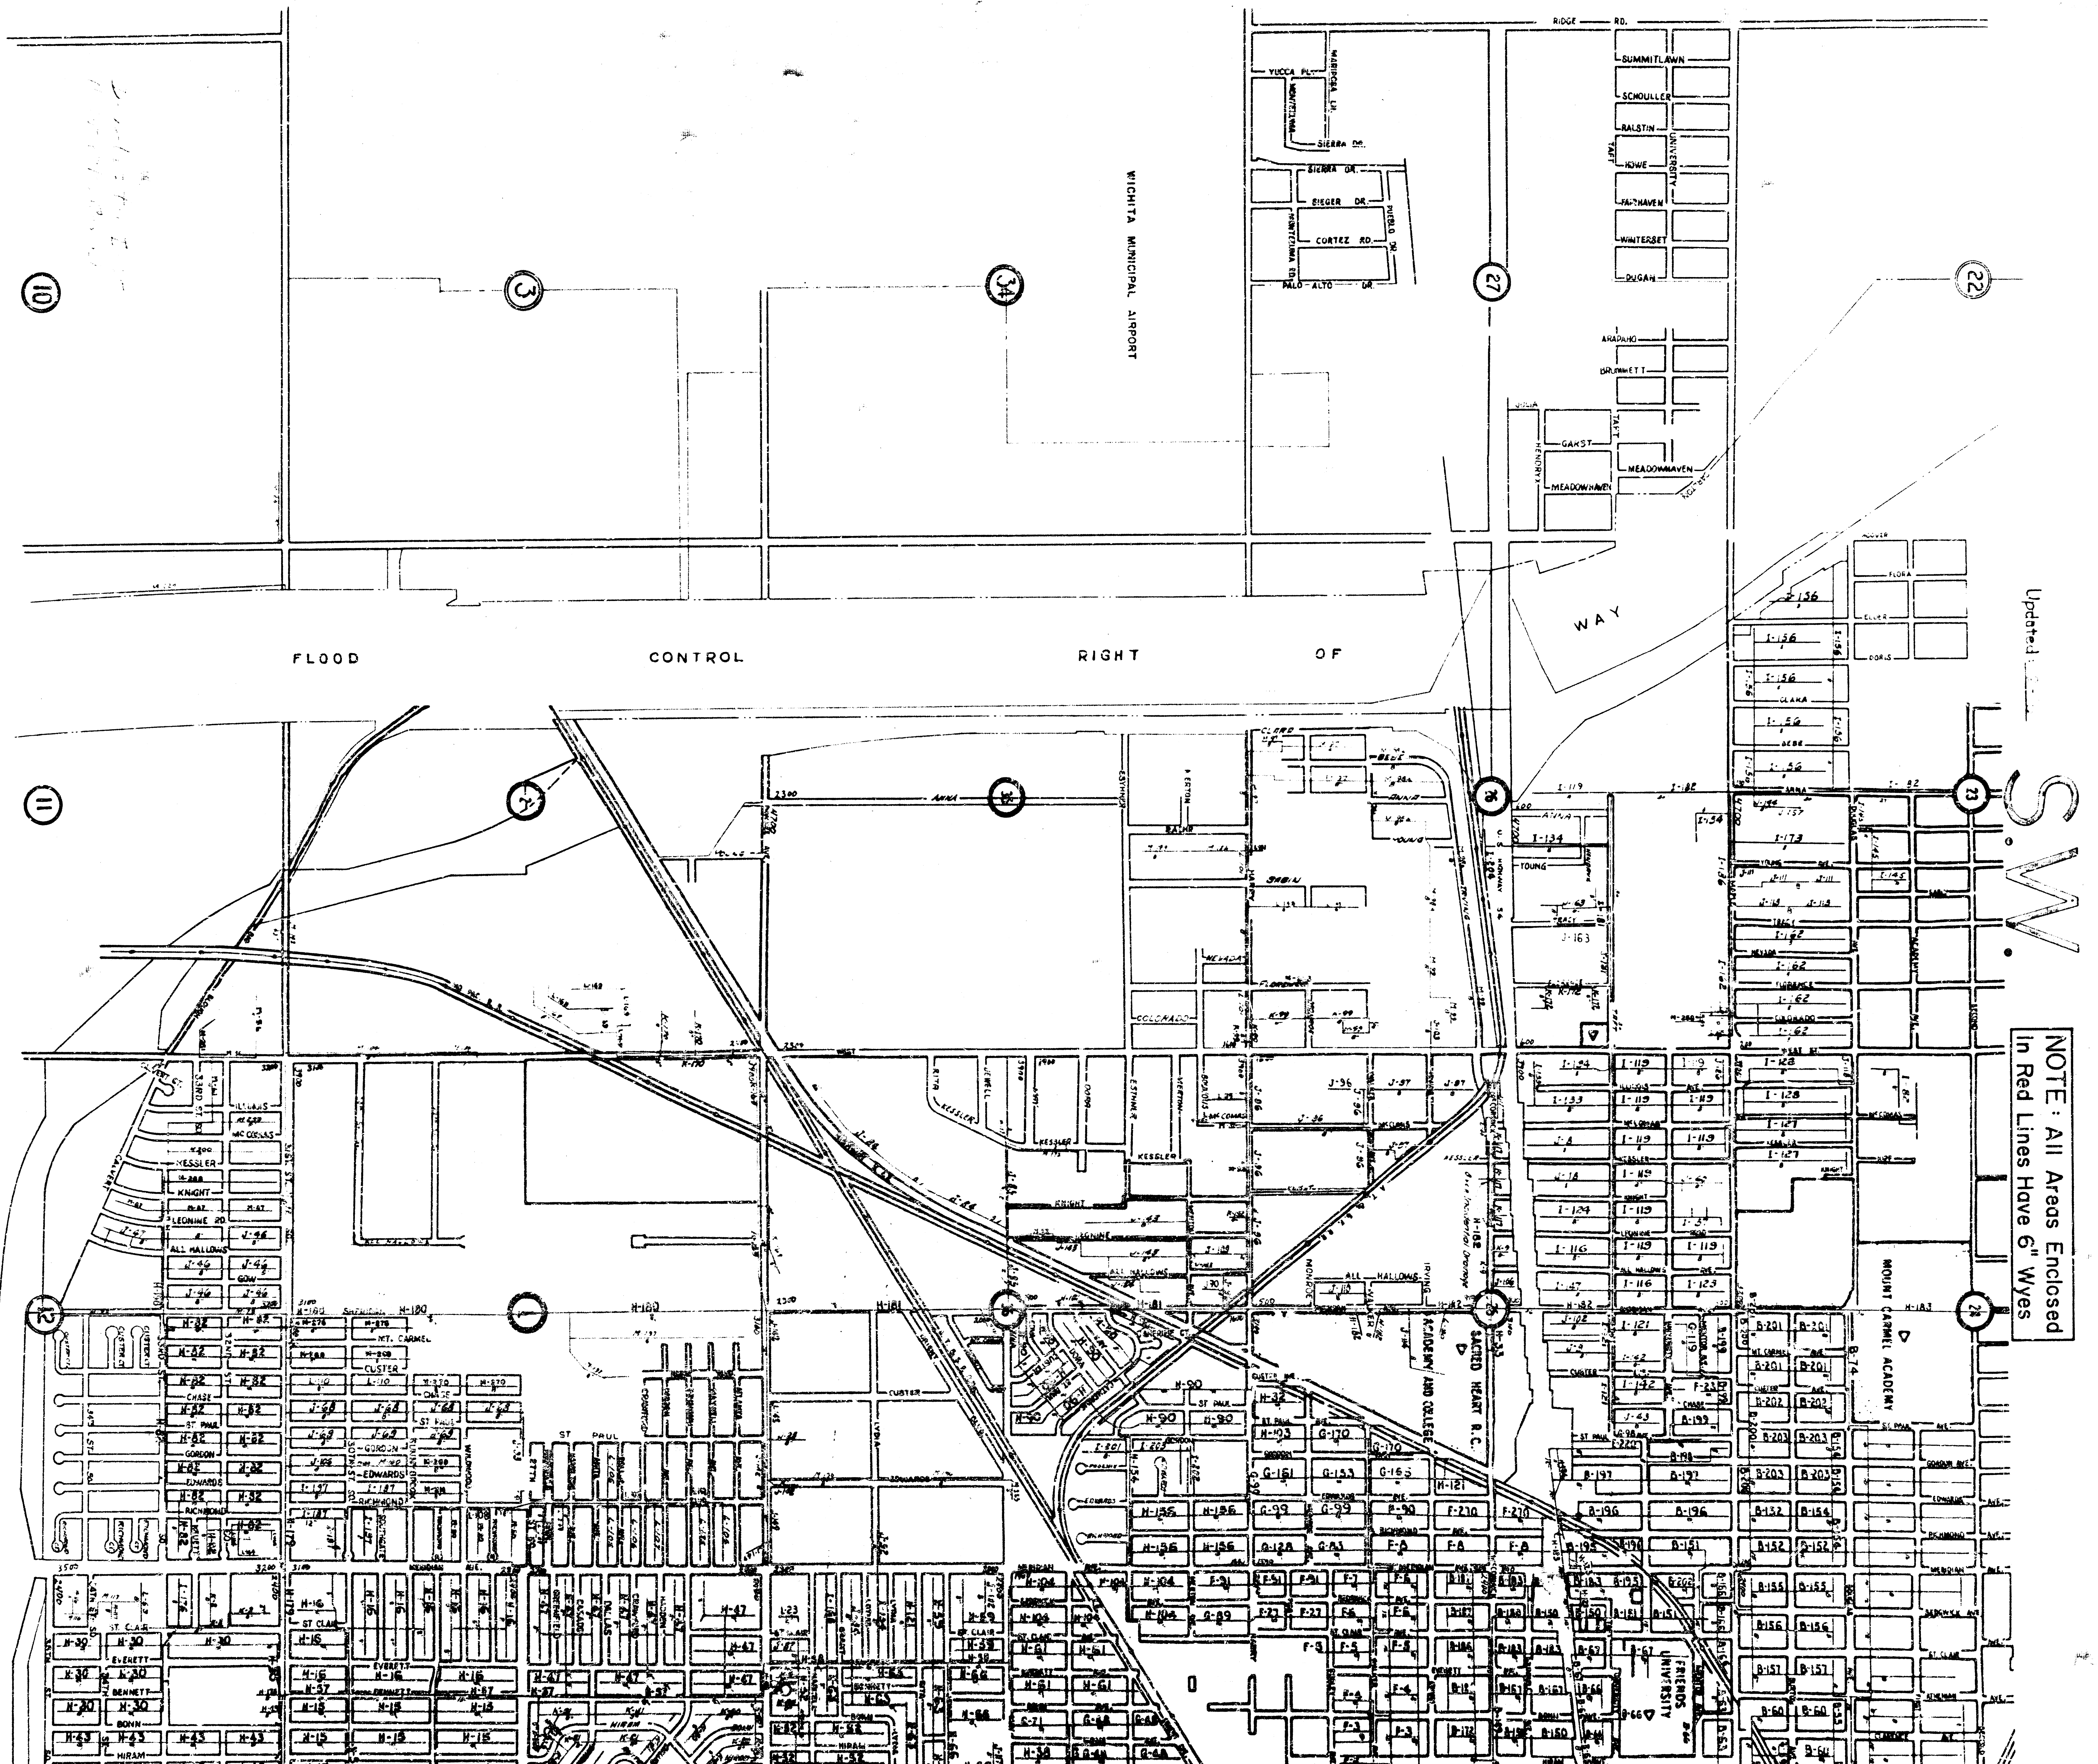



OF

RIGHT

CONTROL

FLOOD

