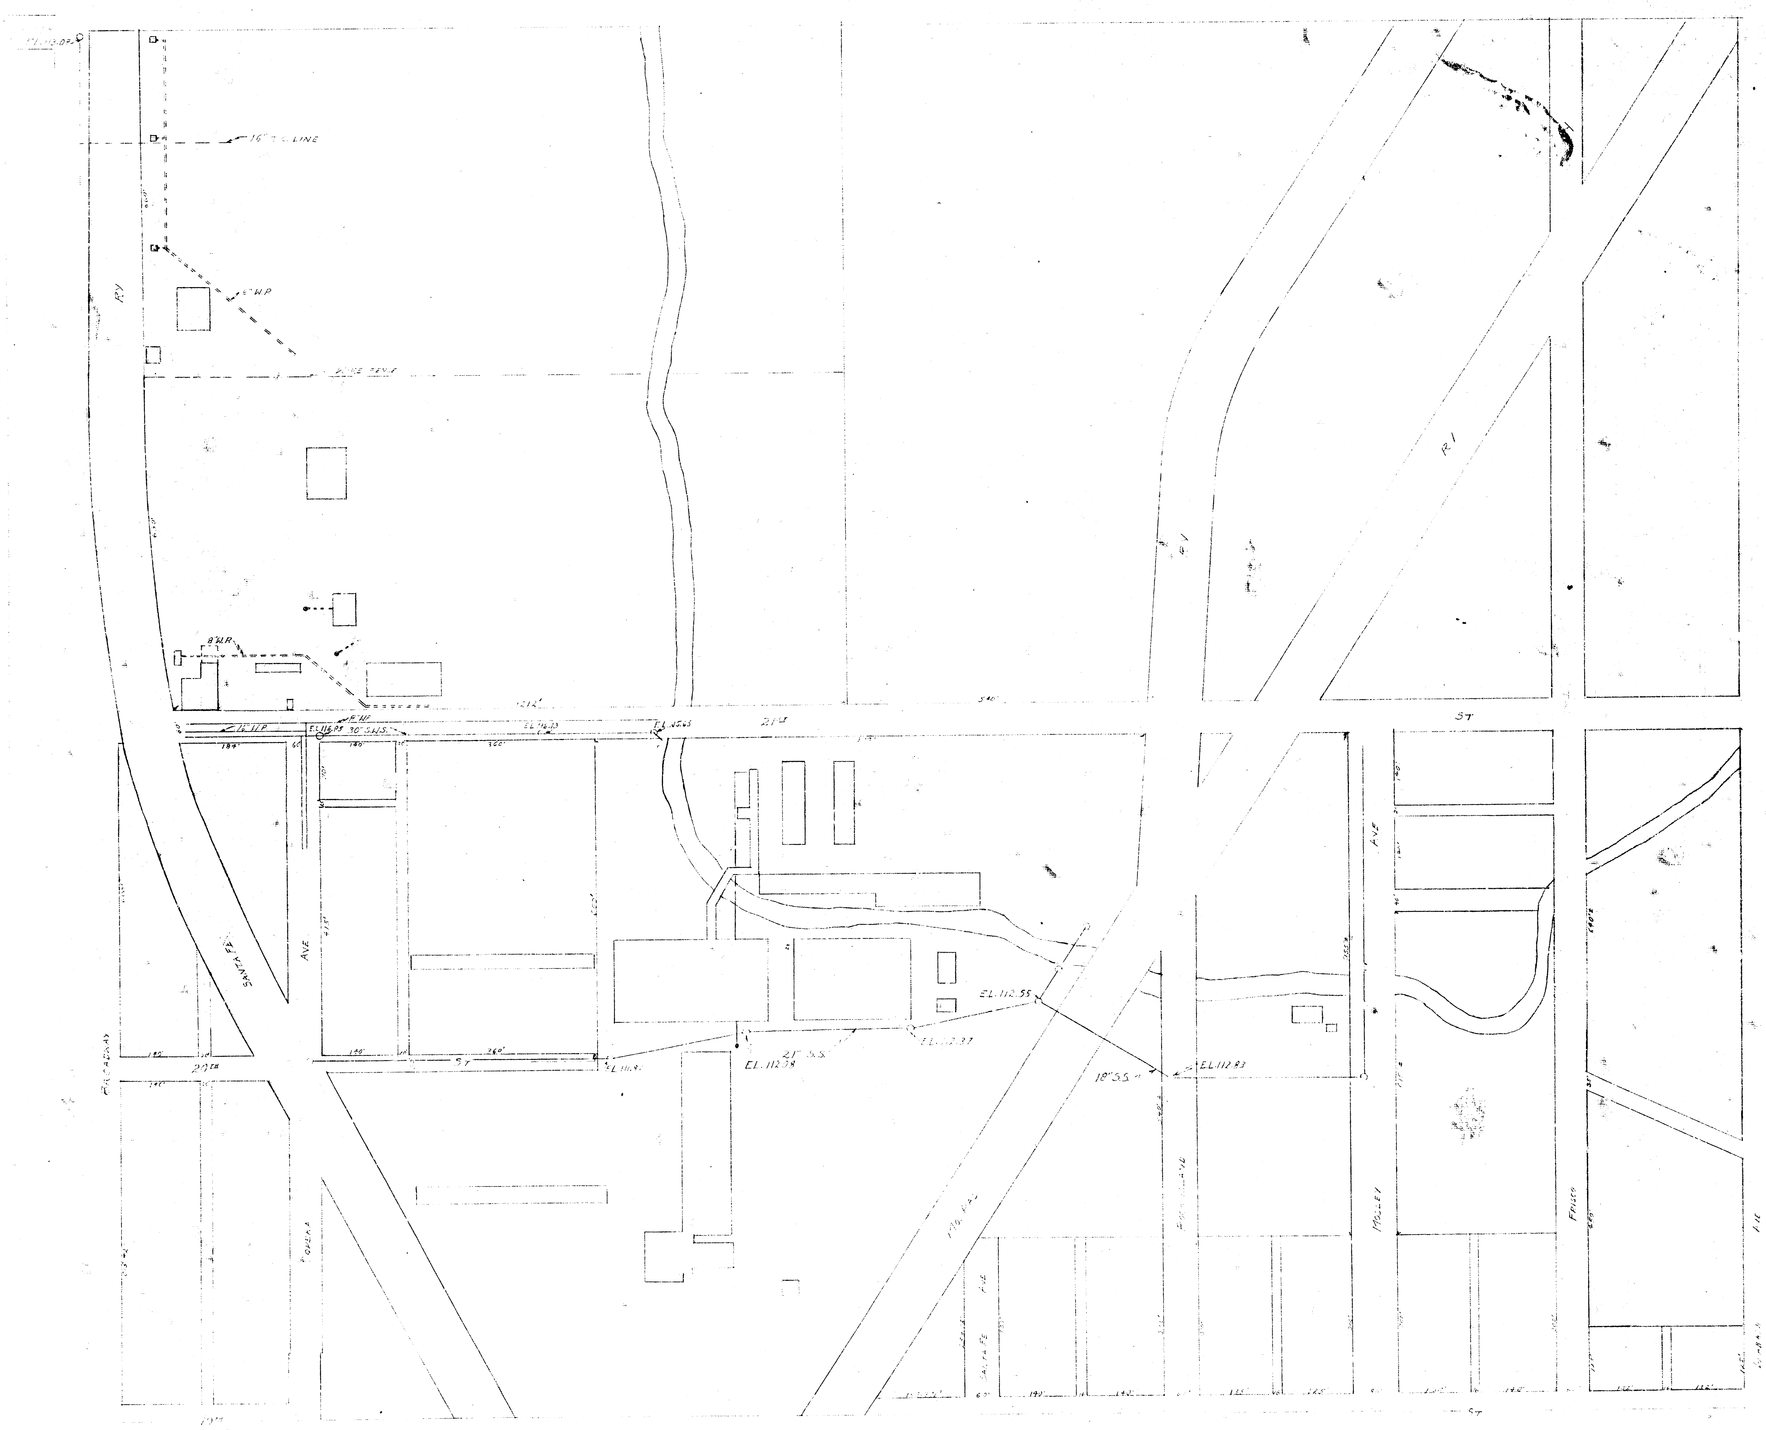
EL.112.58
EL.112.37
EL.112.83
EL.112.55
21" S.S.
18" S.S.
SANTA FE
AVE
AVE
ST
ST
ST
ST