





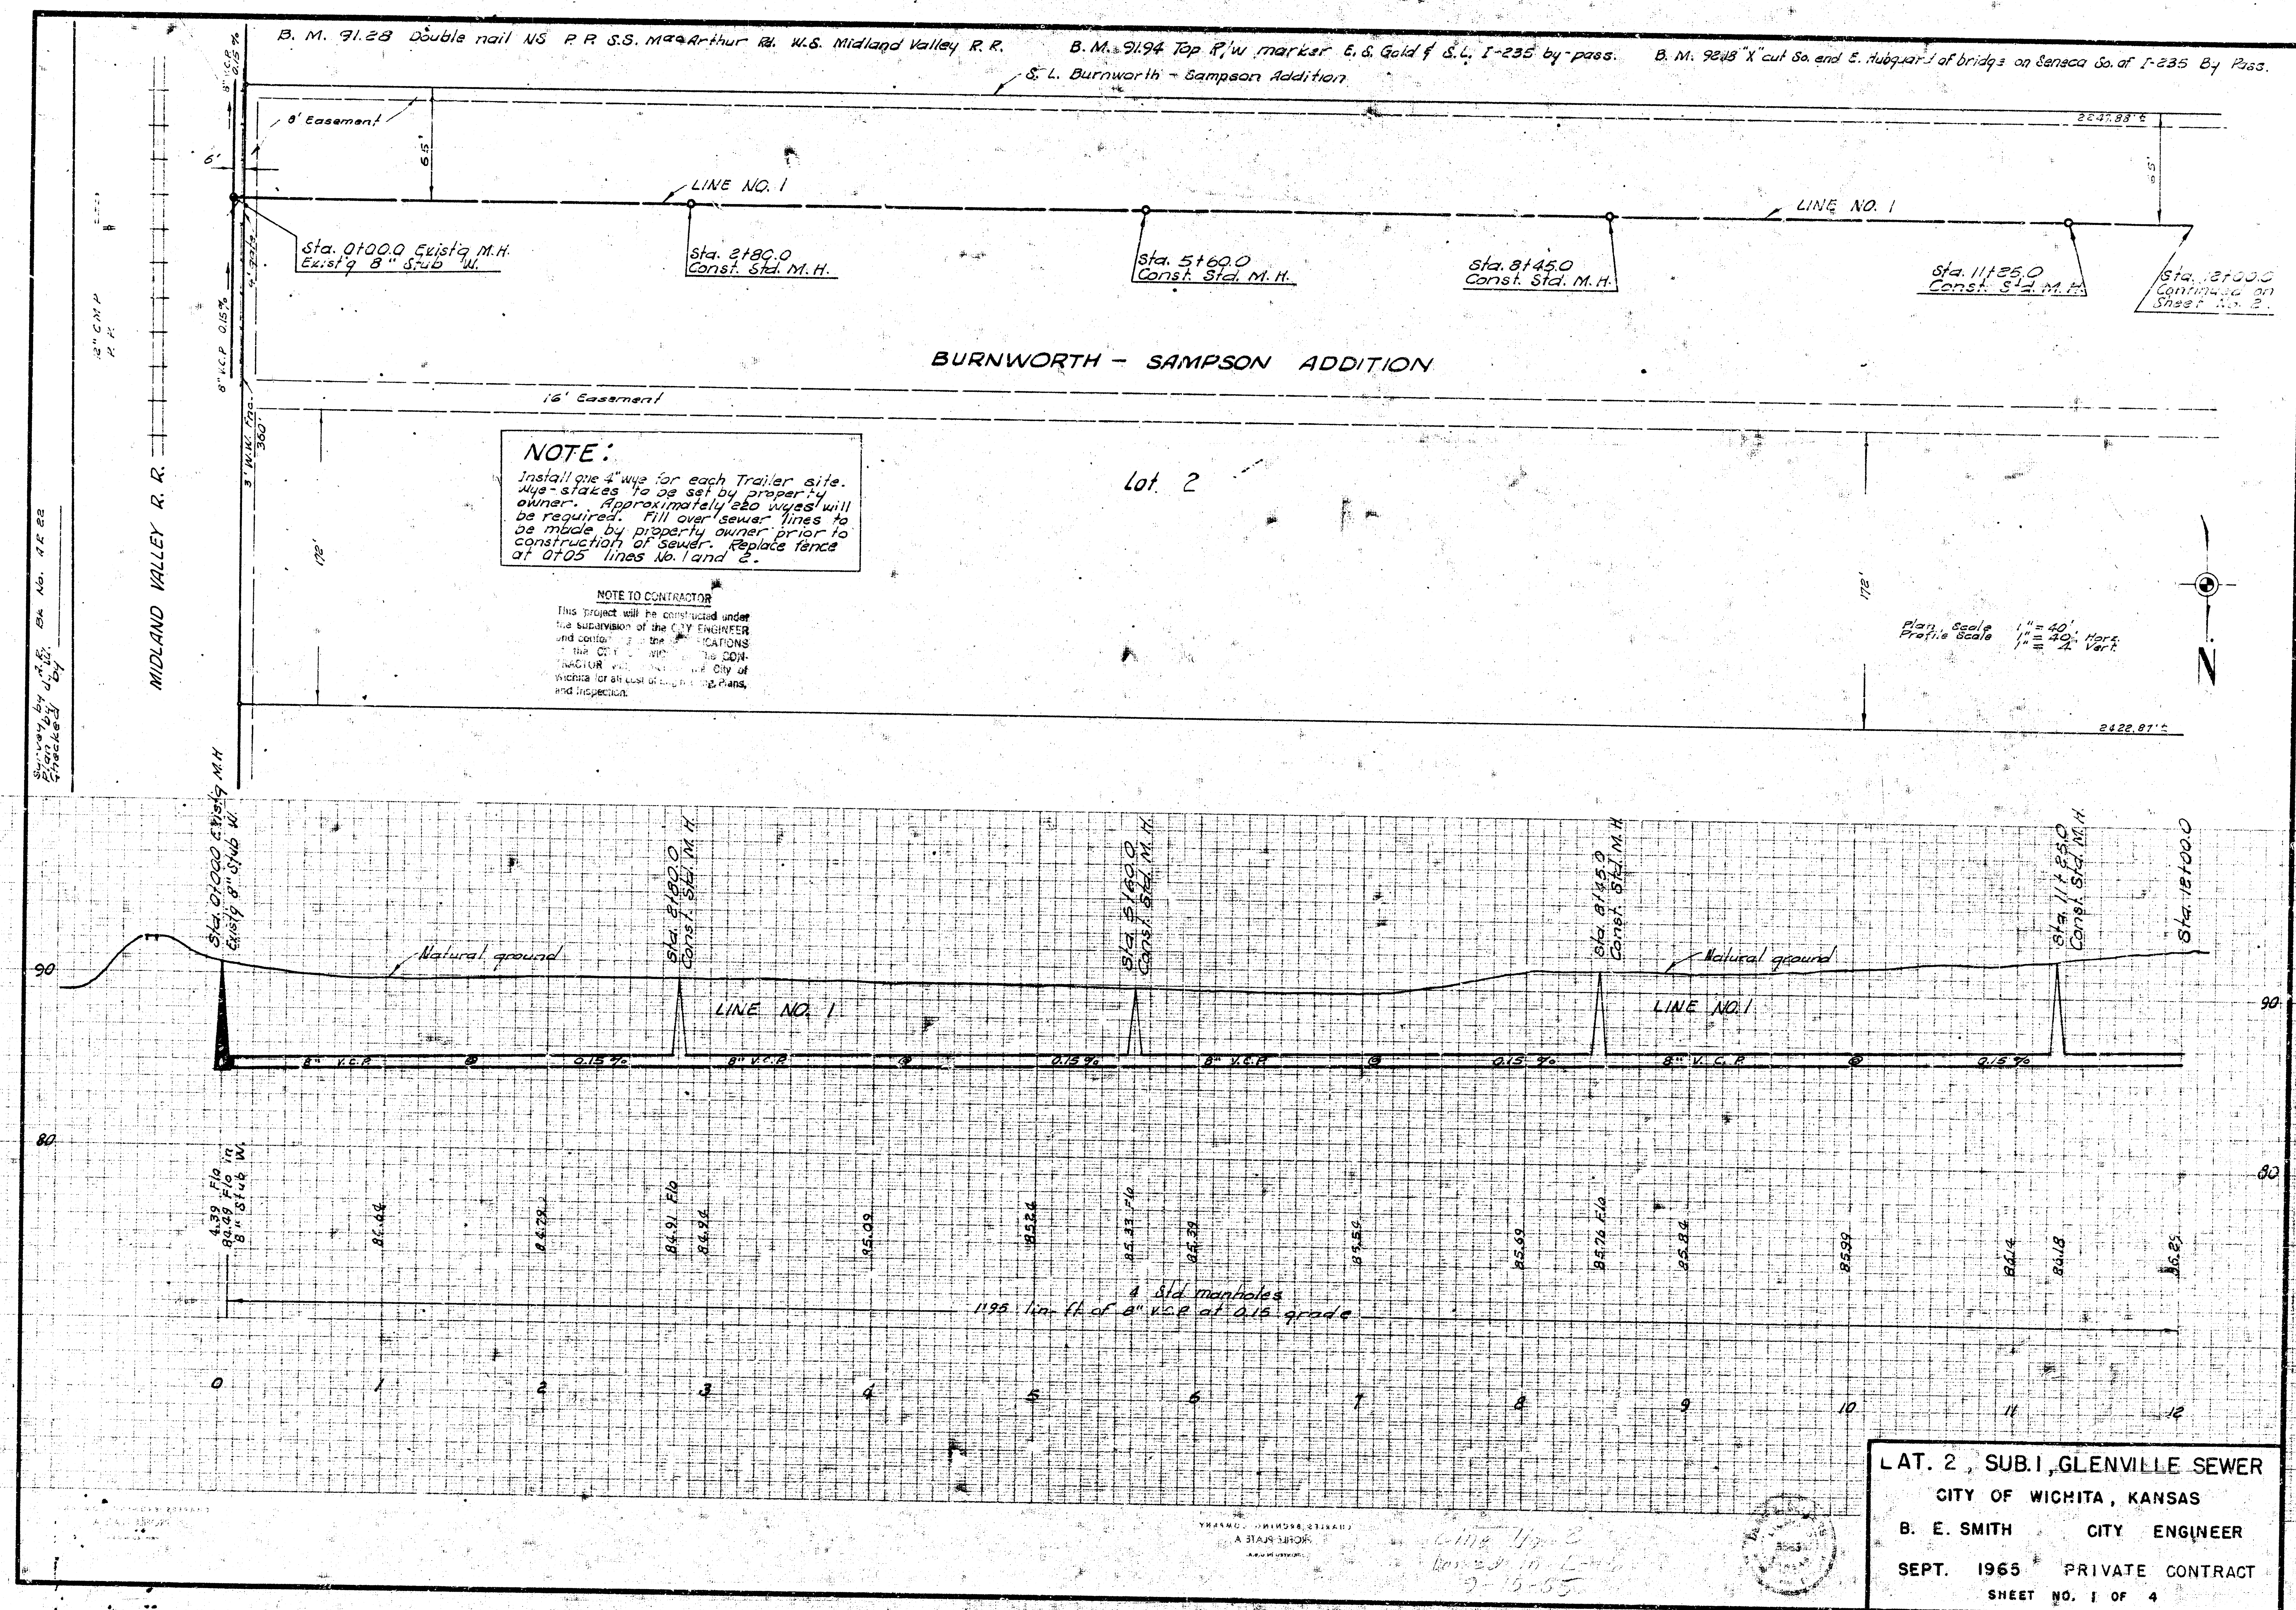

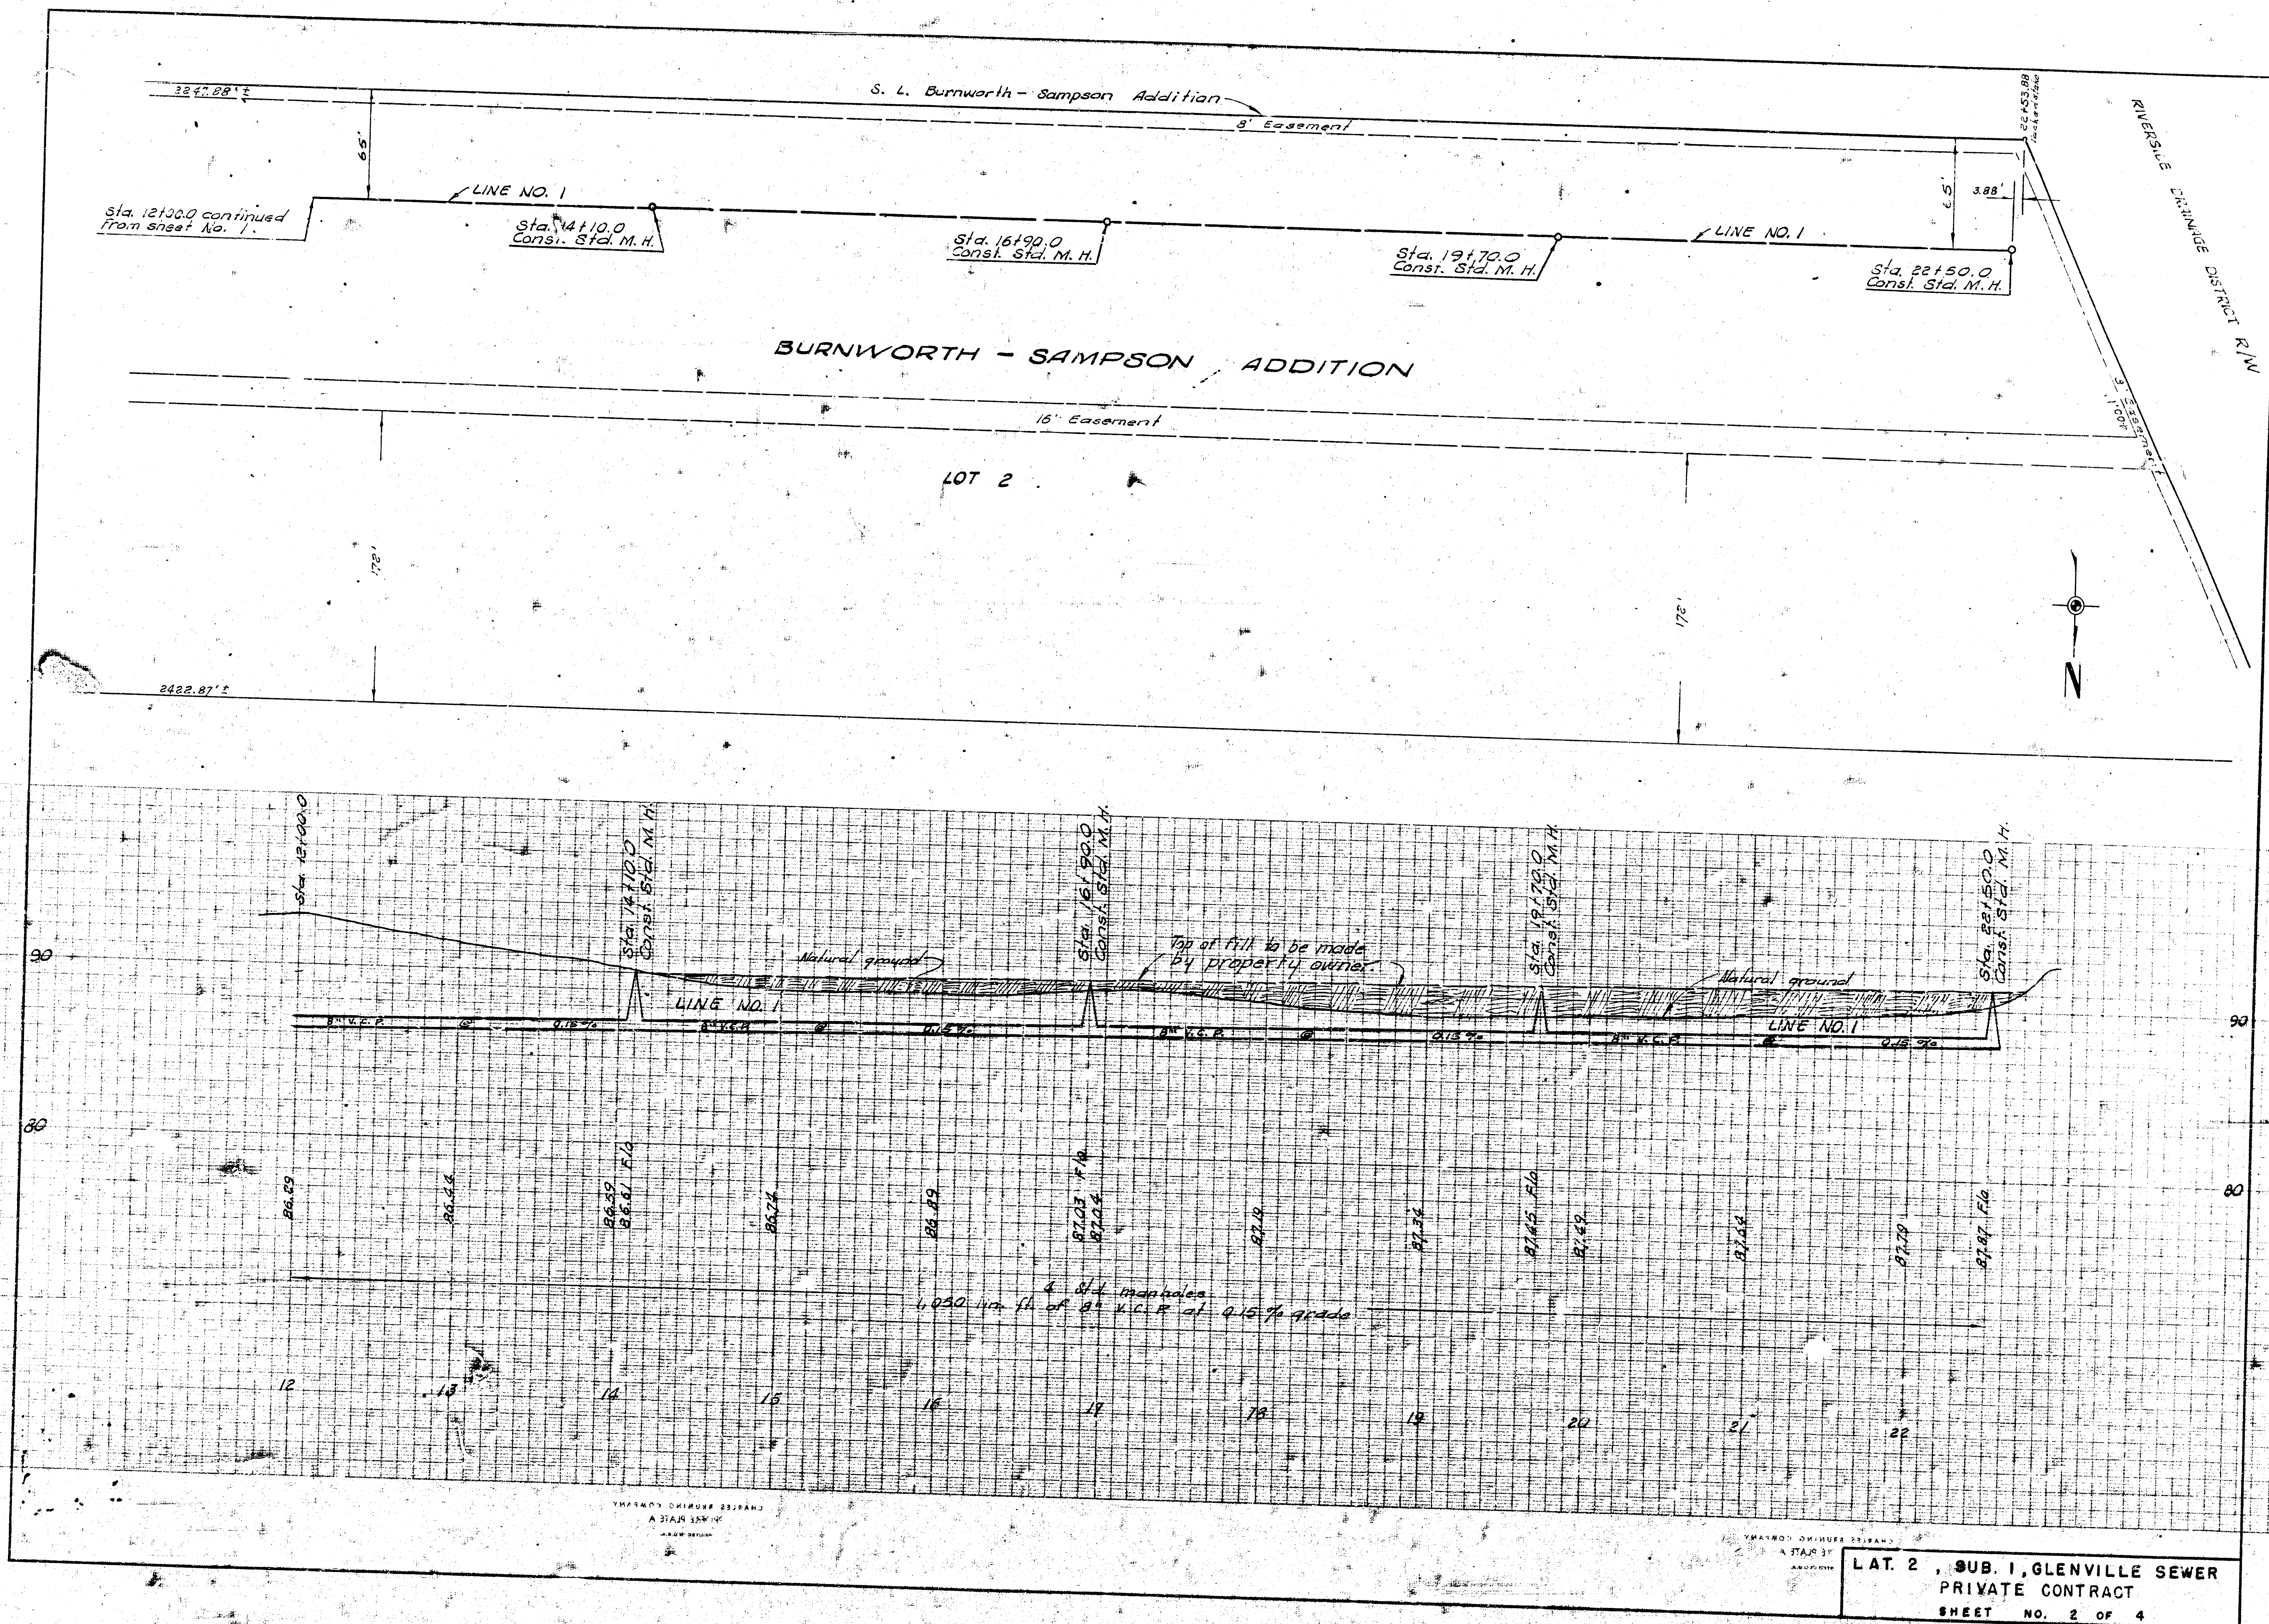

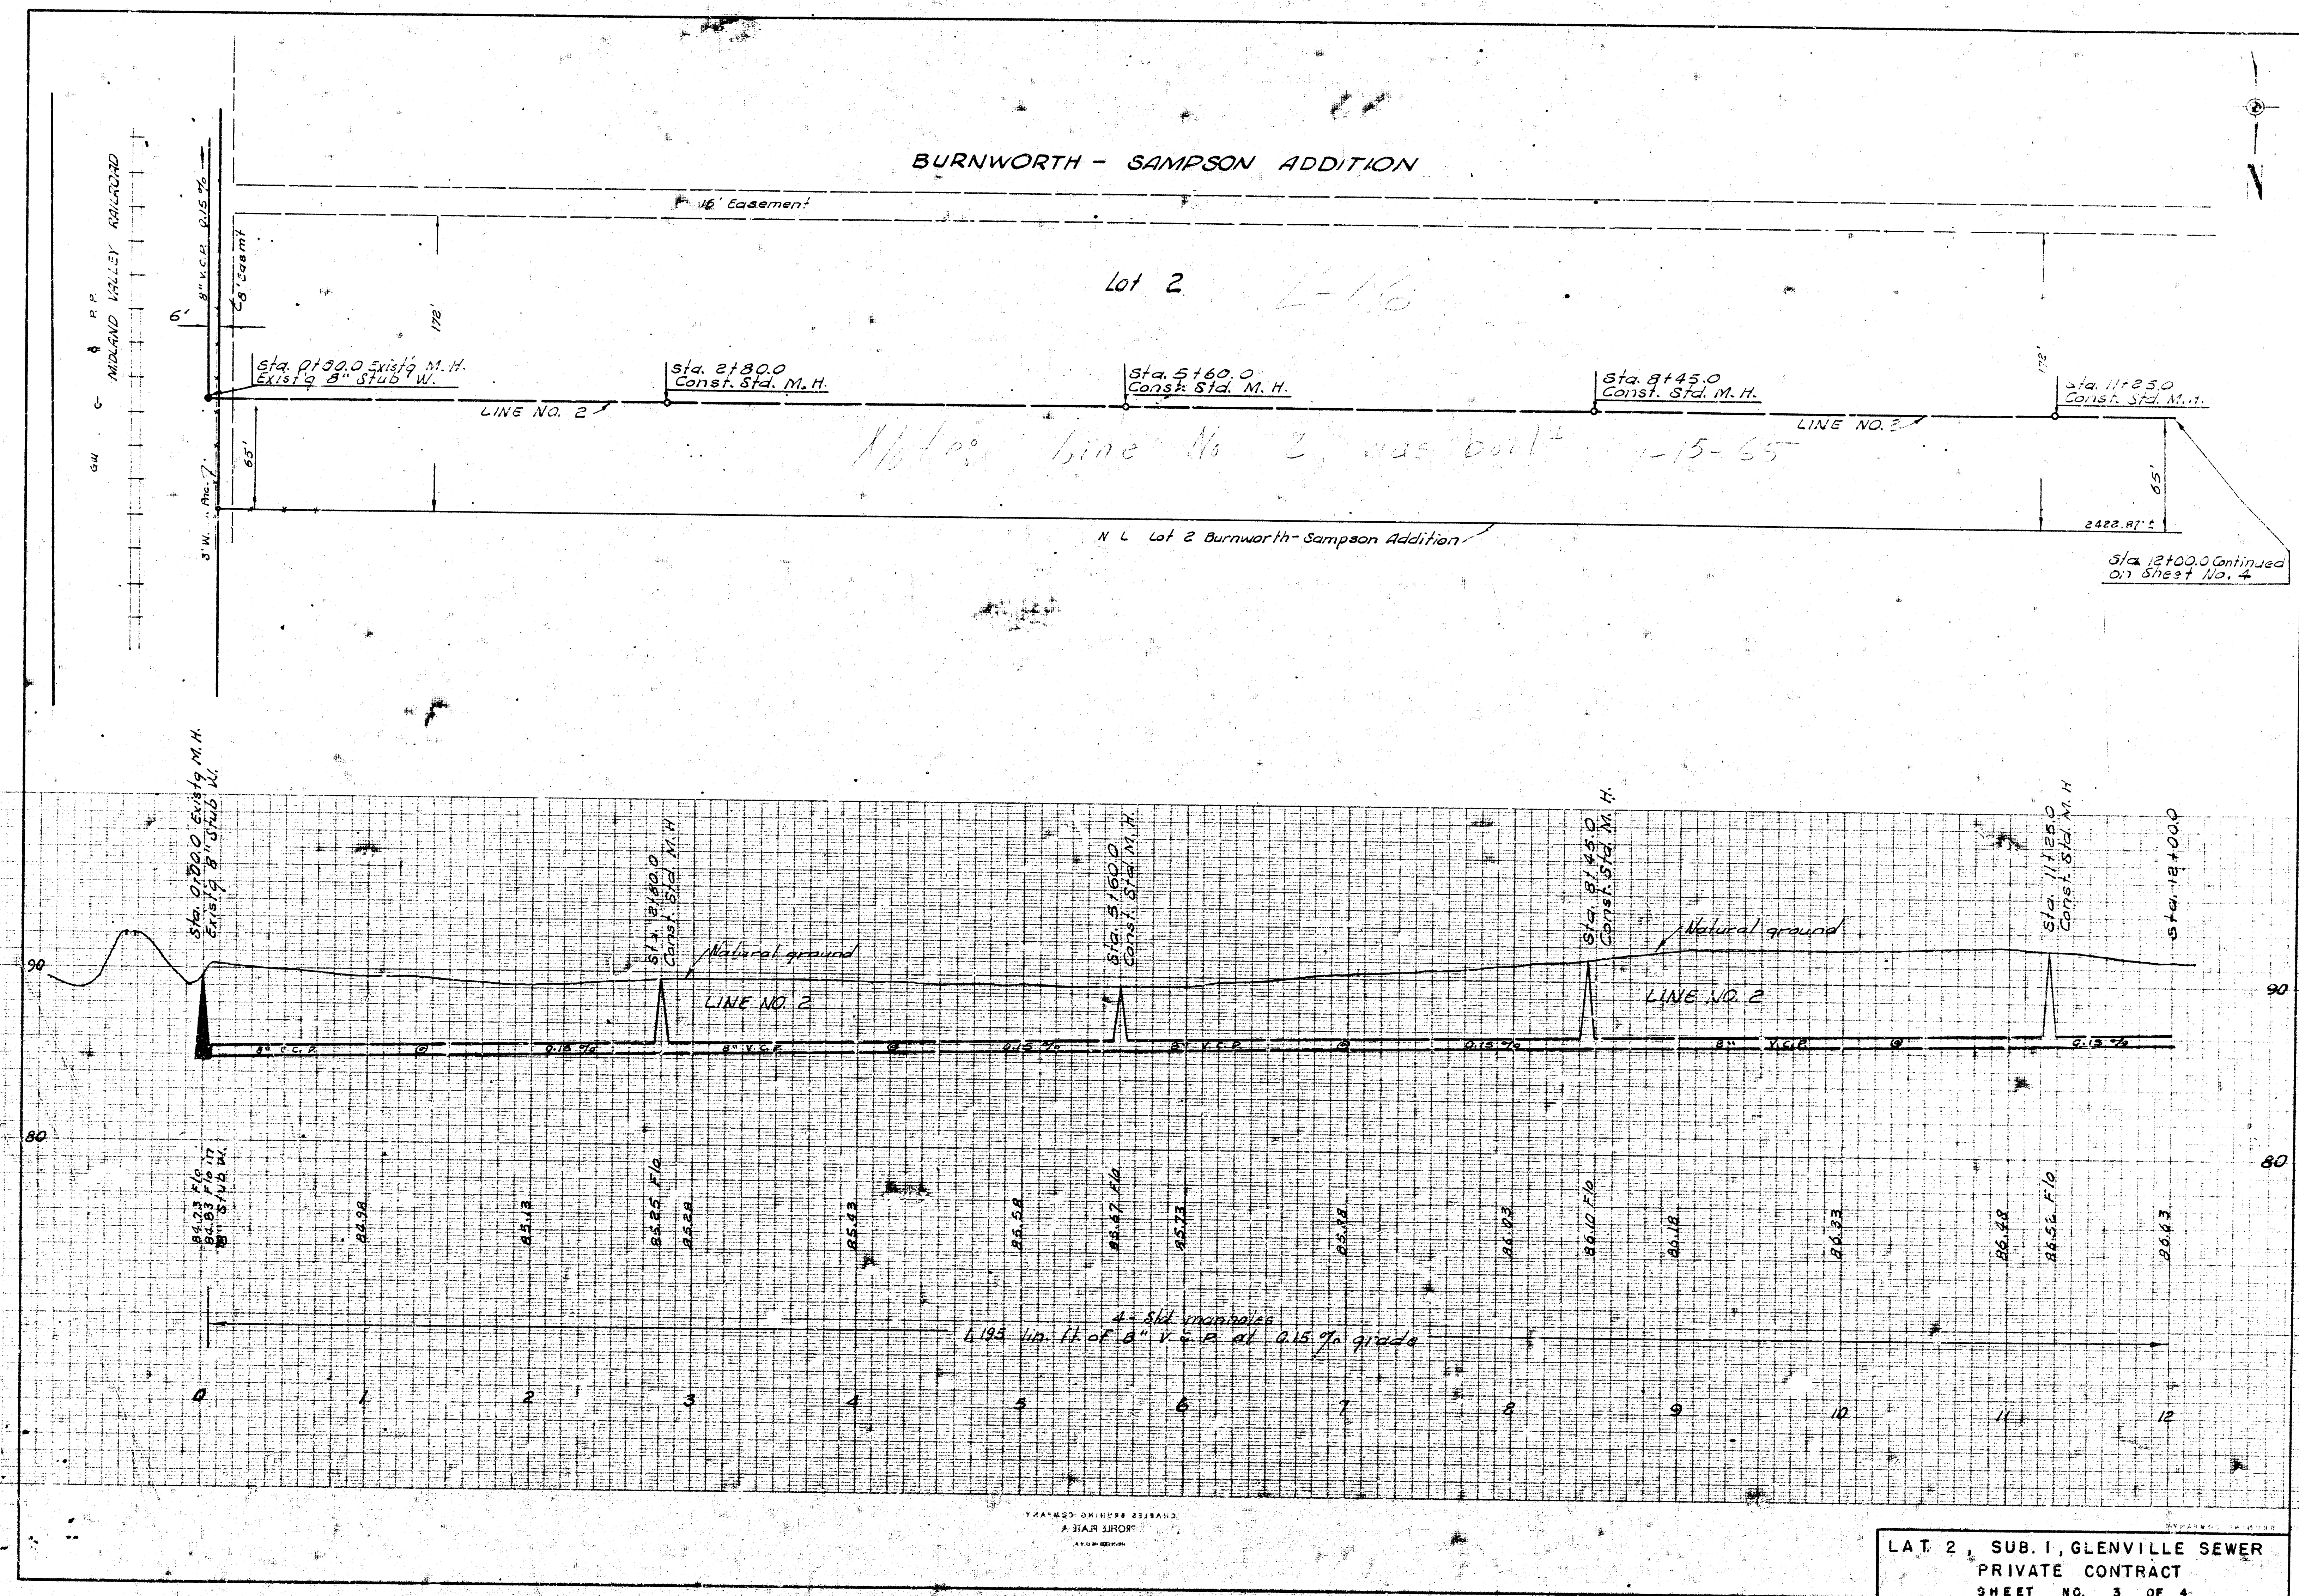

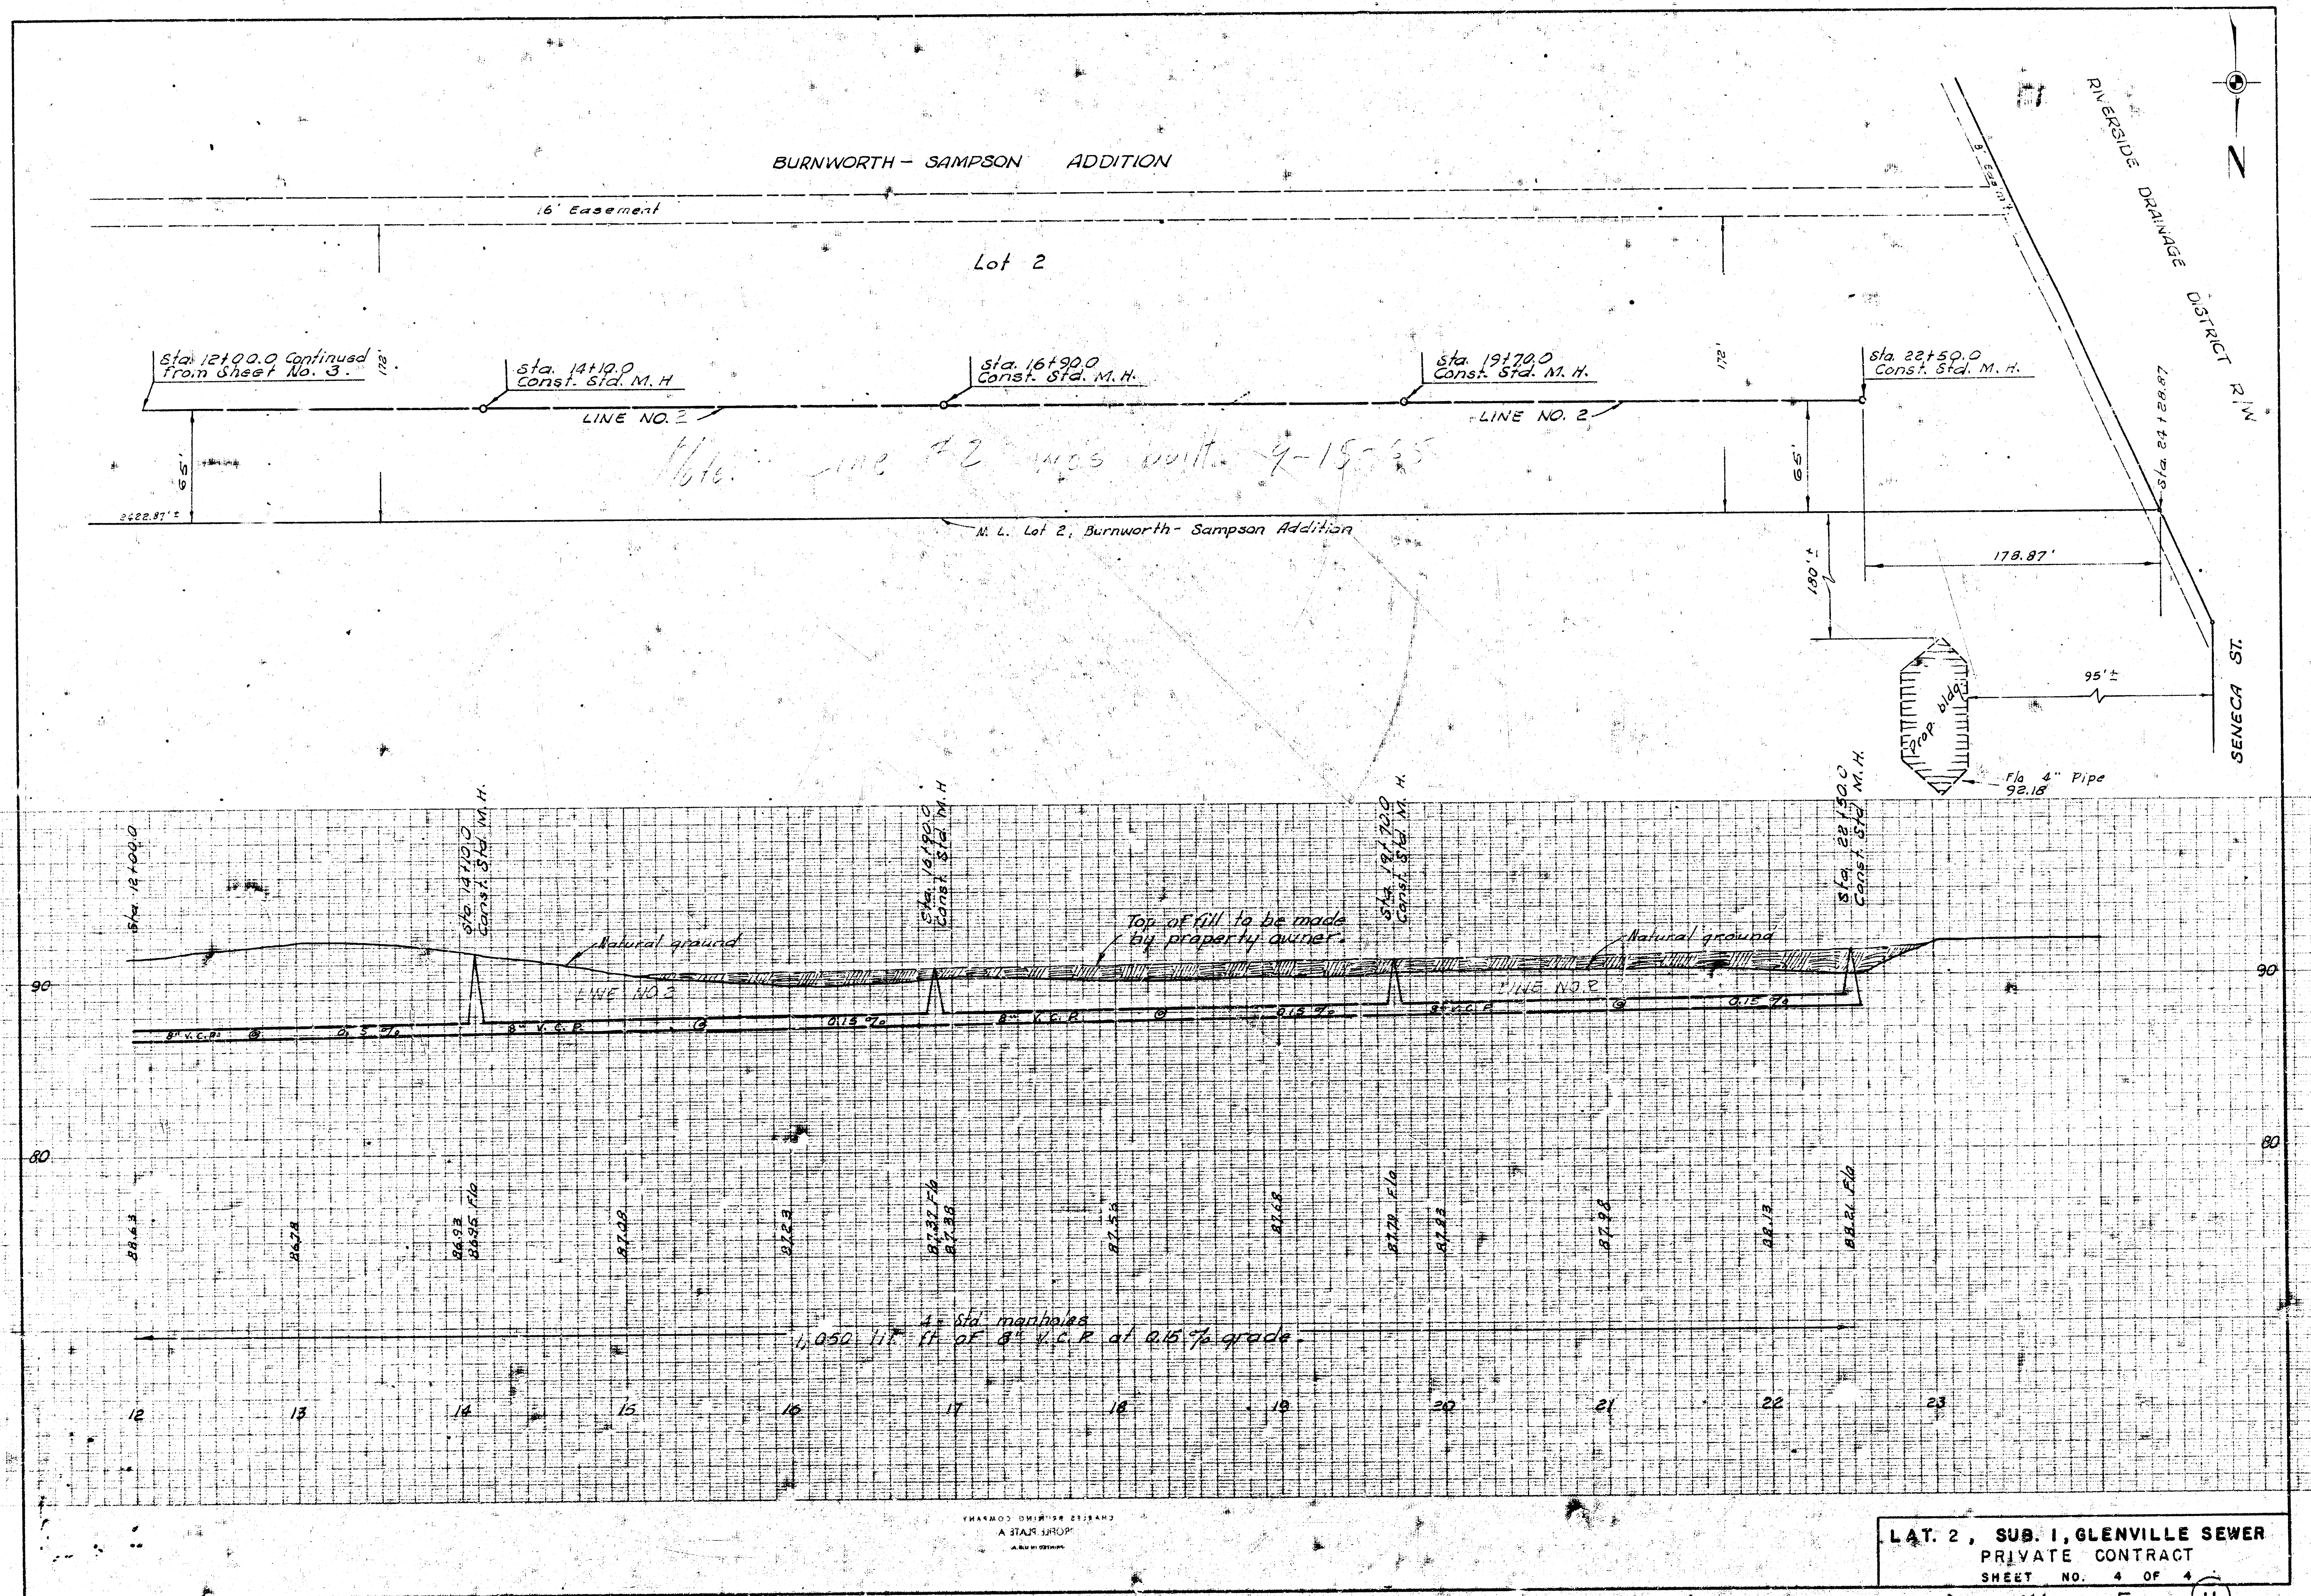

LAT. 2, SUB. I, GLENVILLE SEWER
PRIVATE CONTRACT
SHEET NO. 4 OF 4

11 5 11