

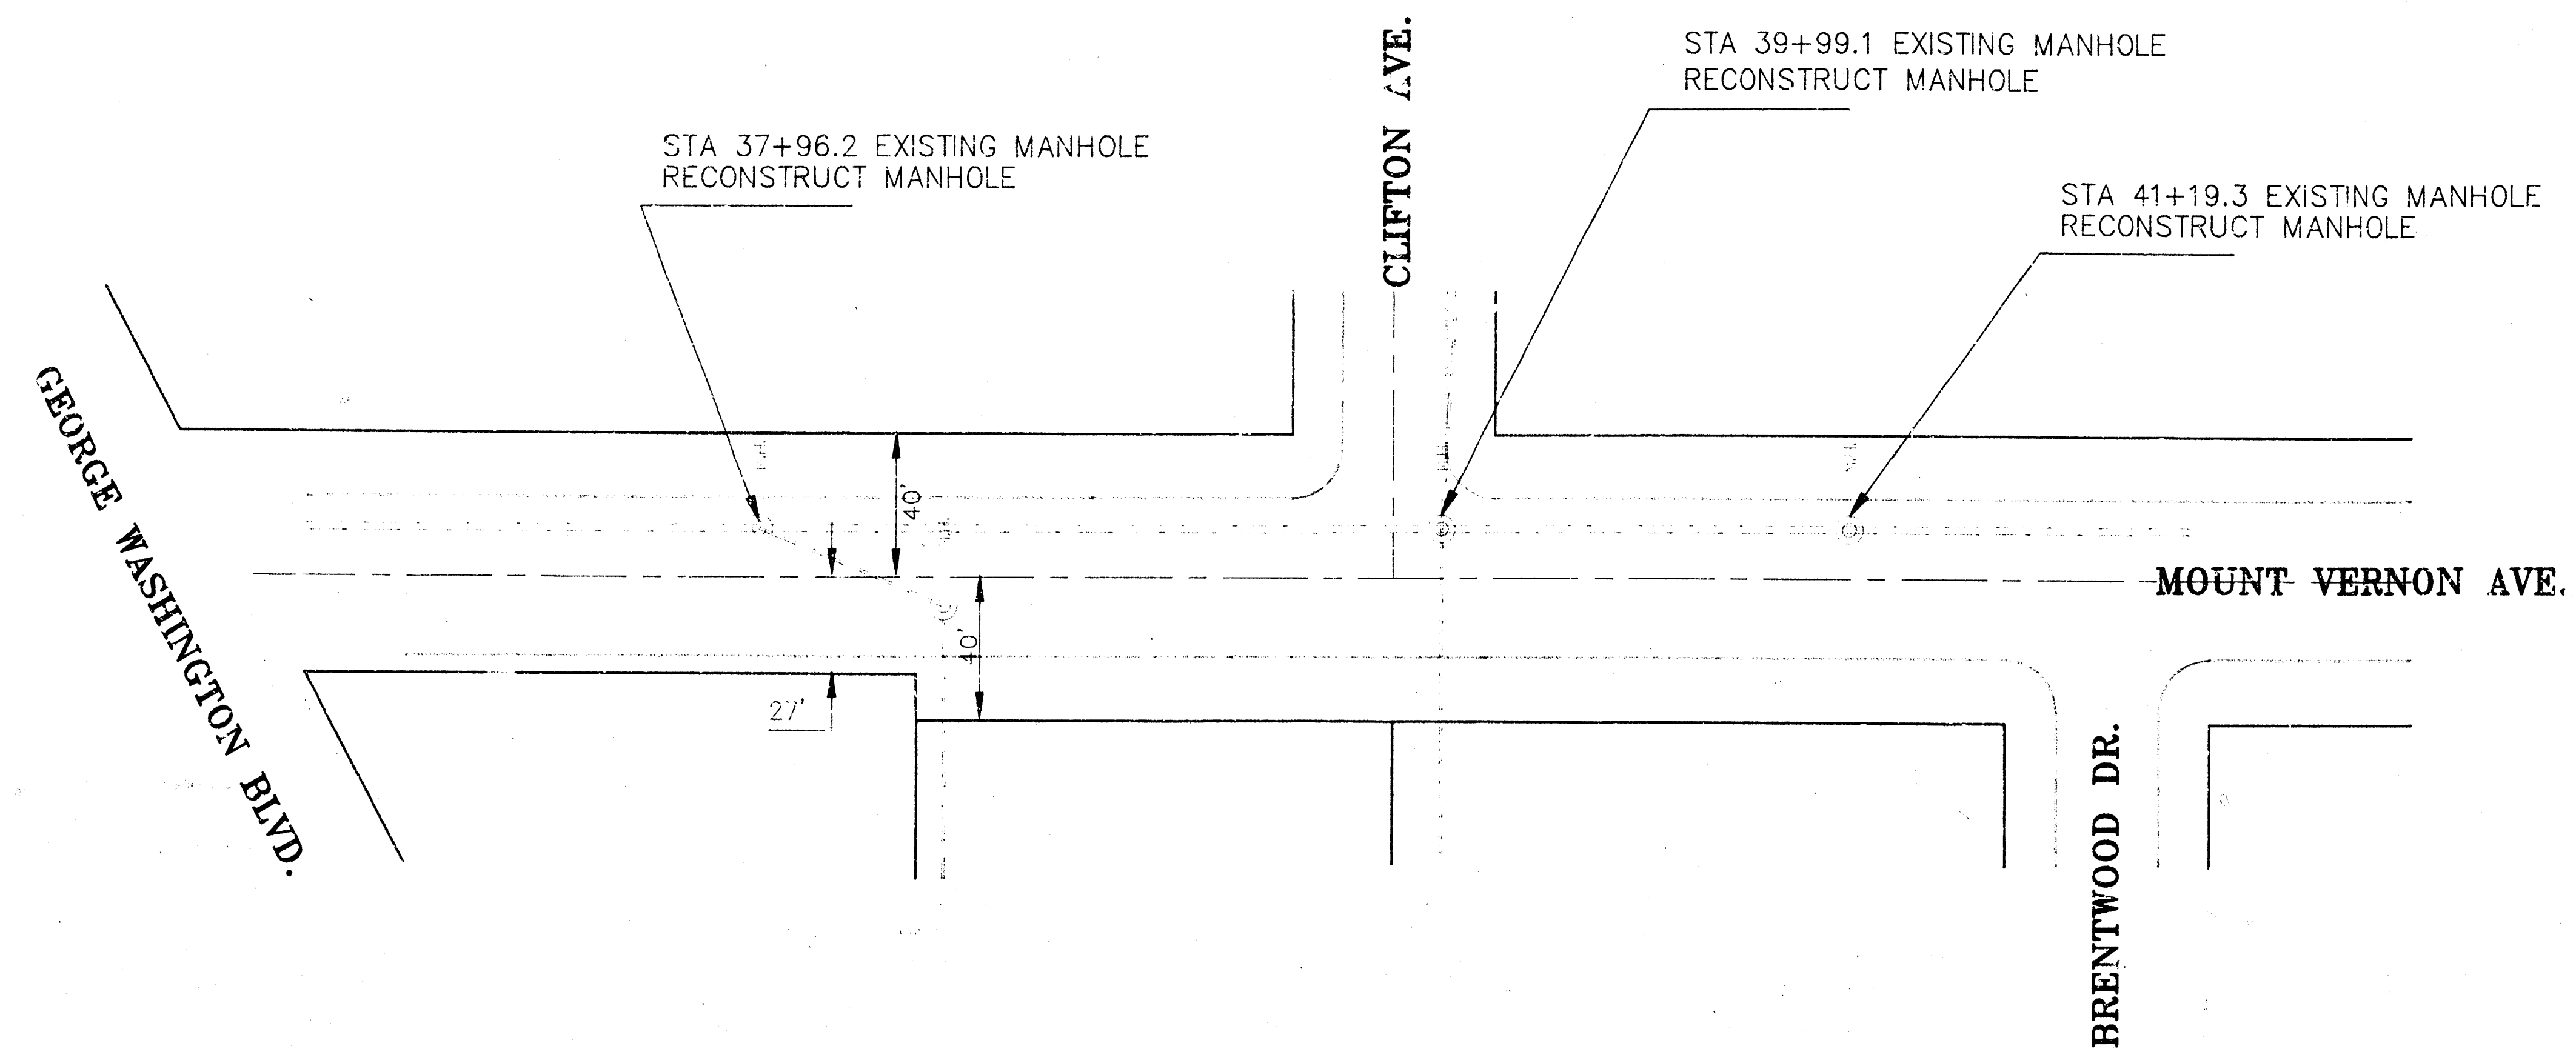
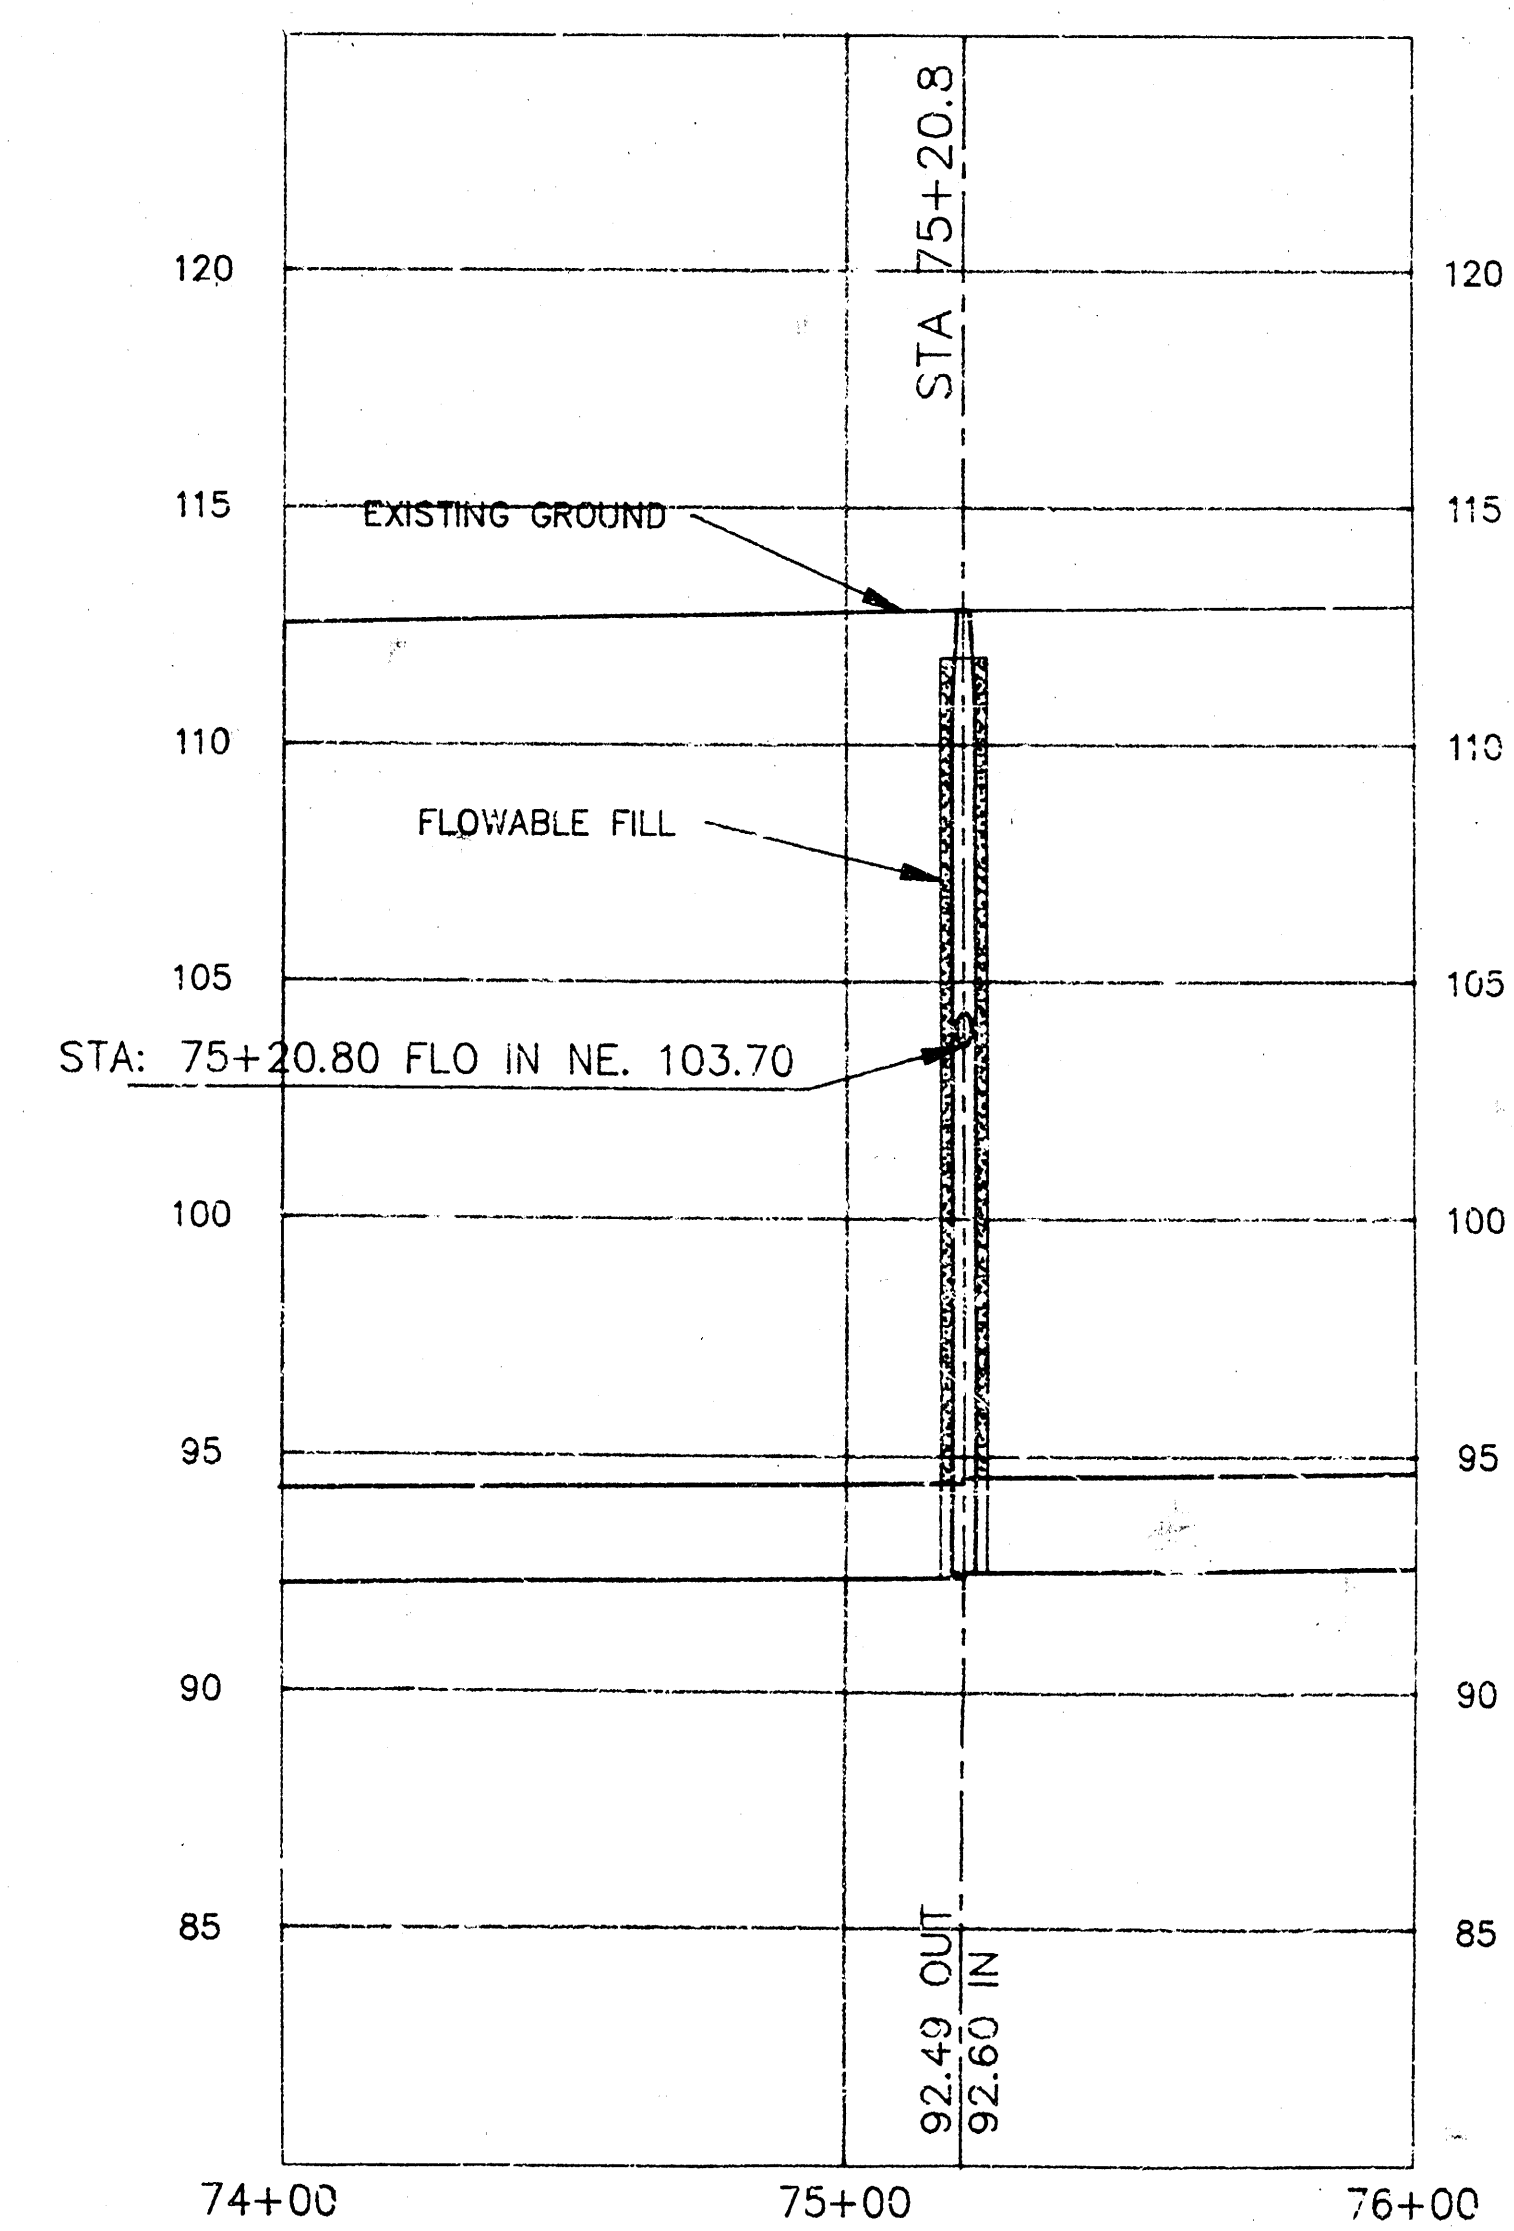


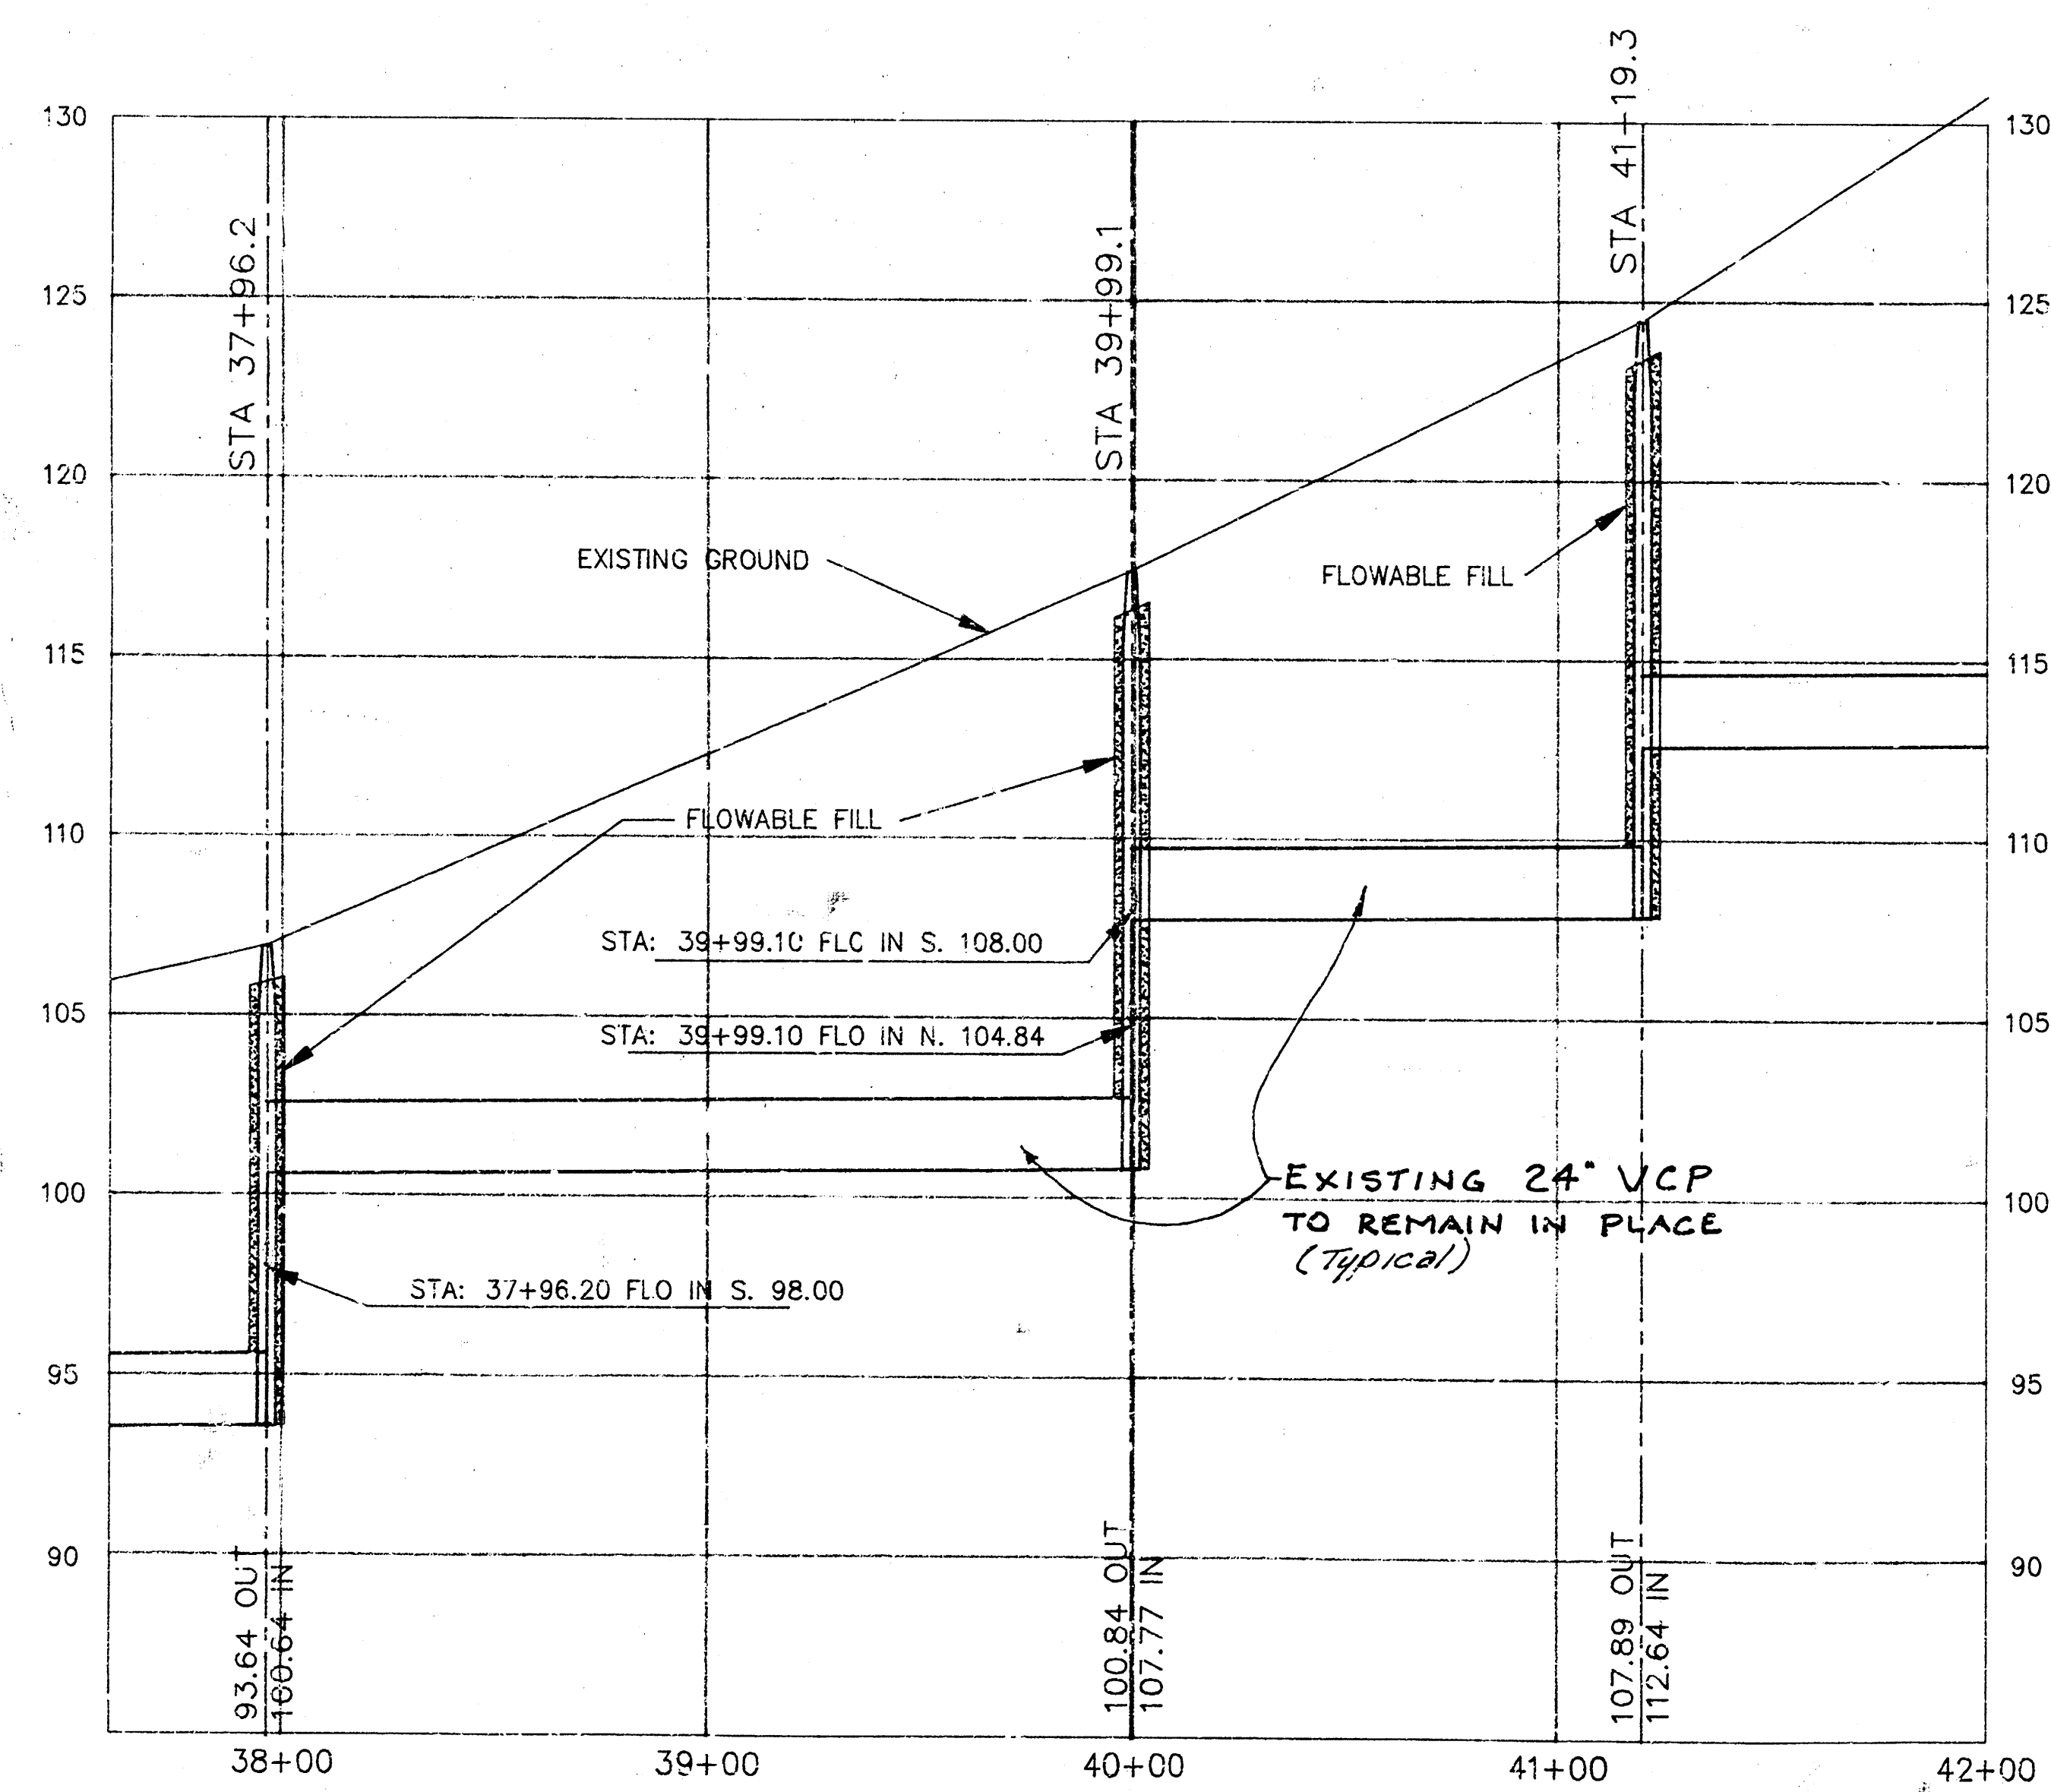

SCALE: PLAN 1" = 40' PROFILE 1" = 40' HORZ. 1" = 5' VERT.

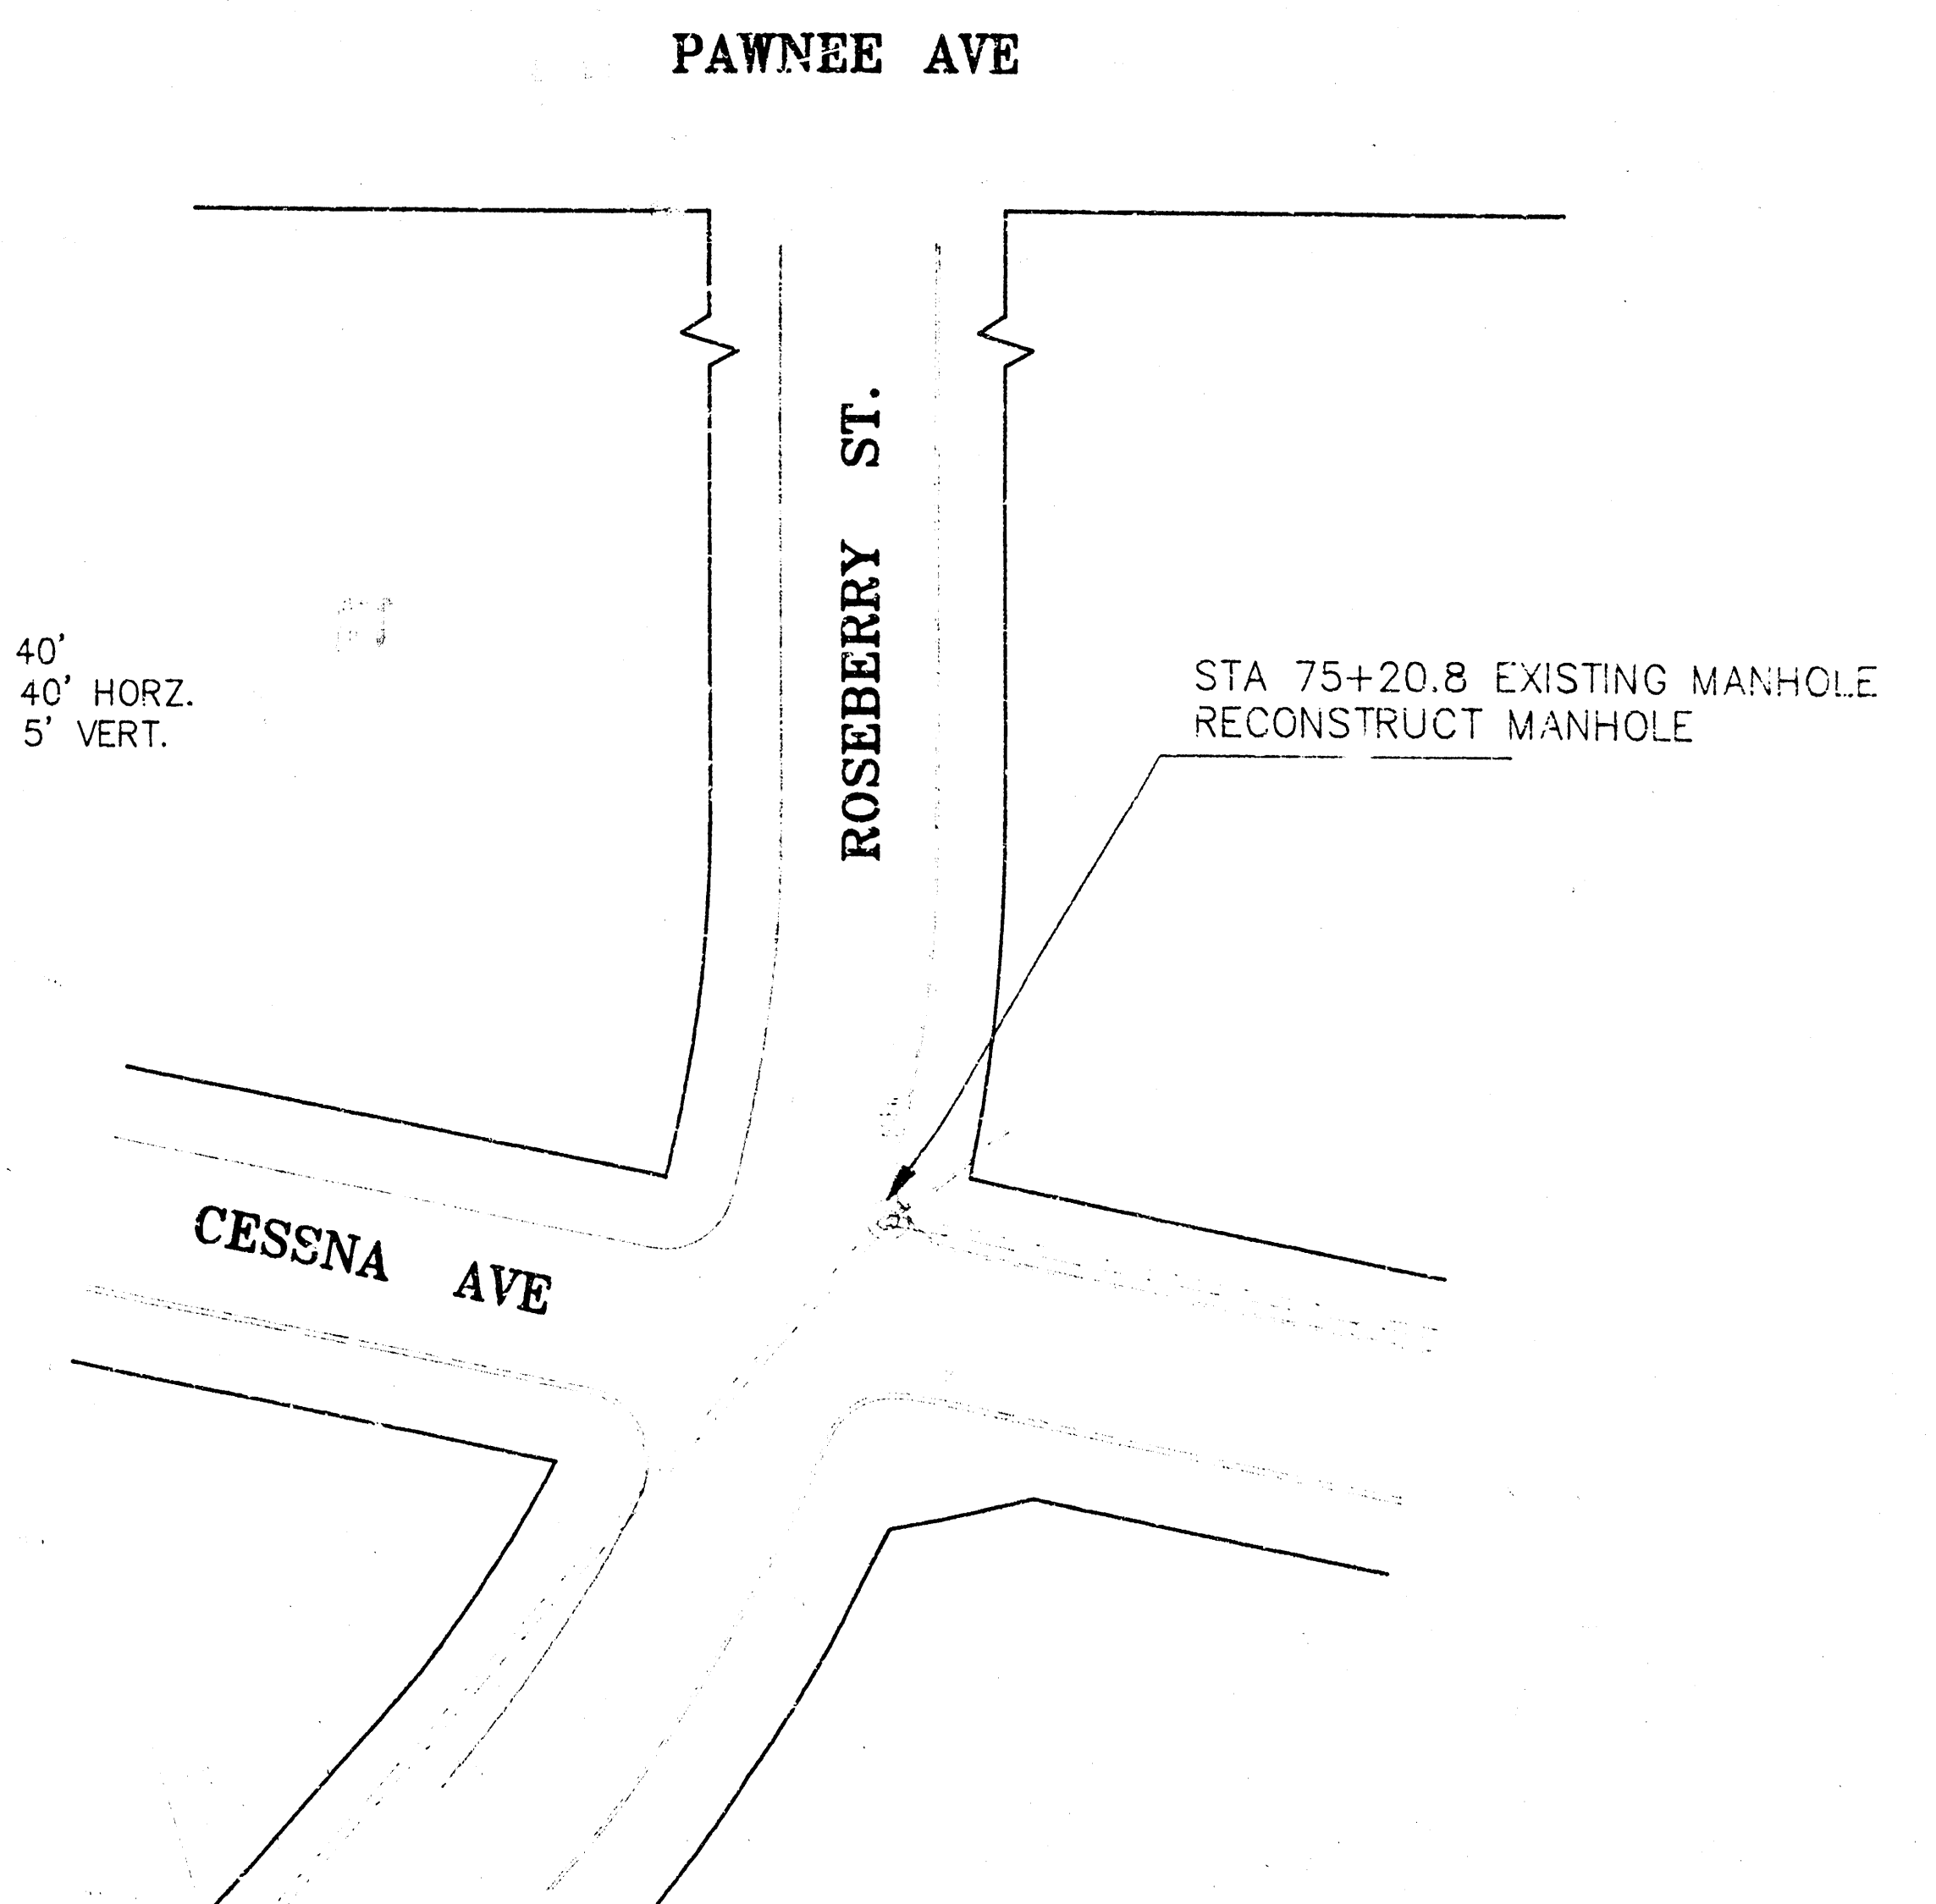

1993 SEWER REHAB. PROGRAM - PHASE III
INDEX NO. 632000

Booked
As per plan
10-17-94

