
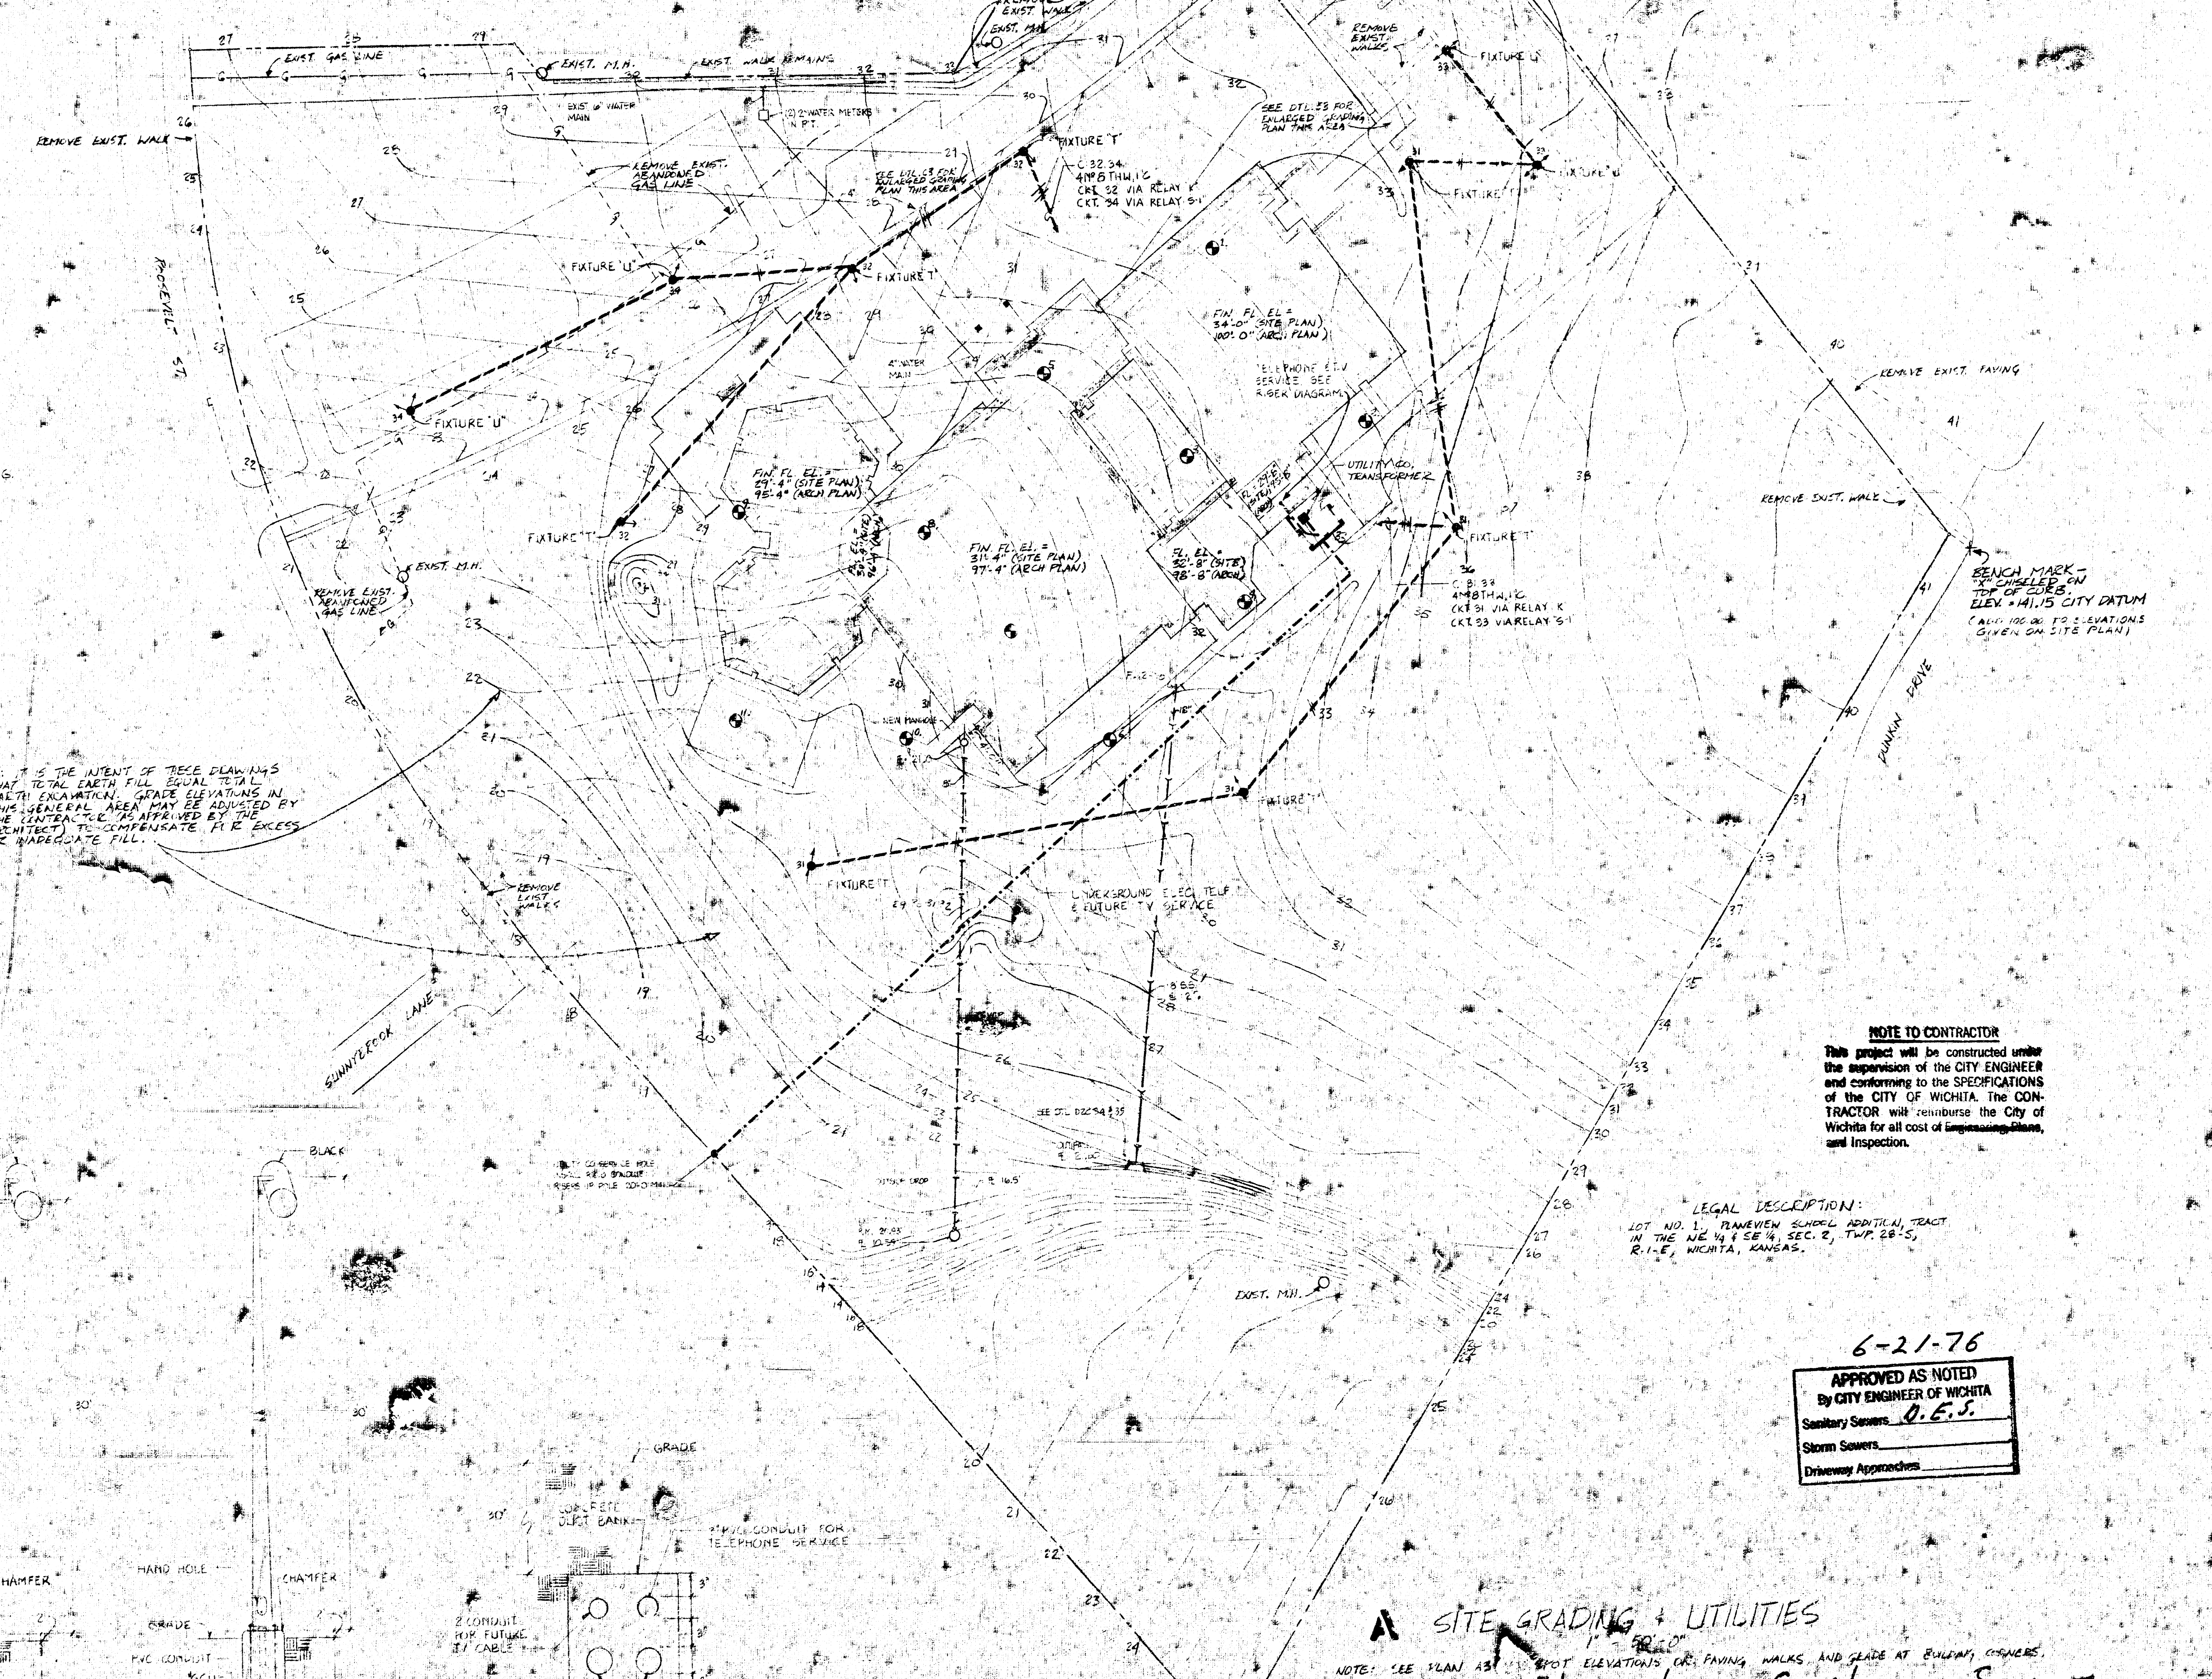


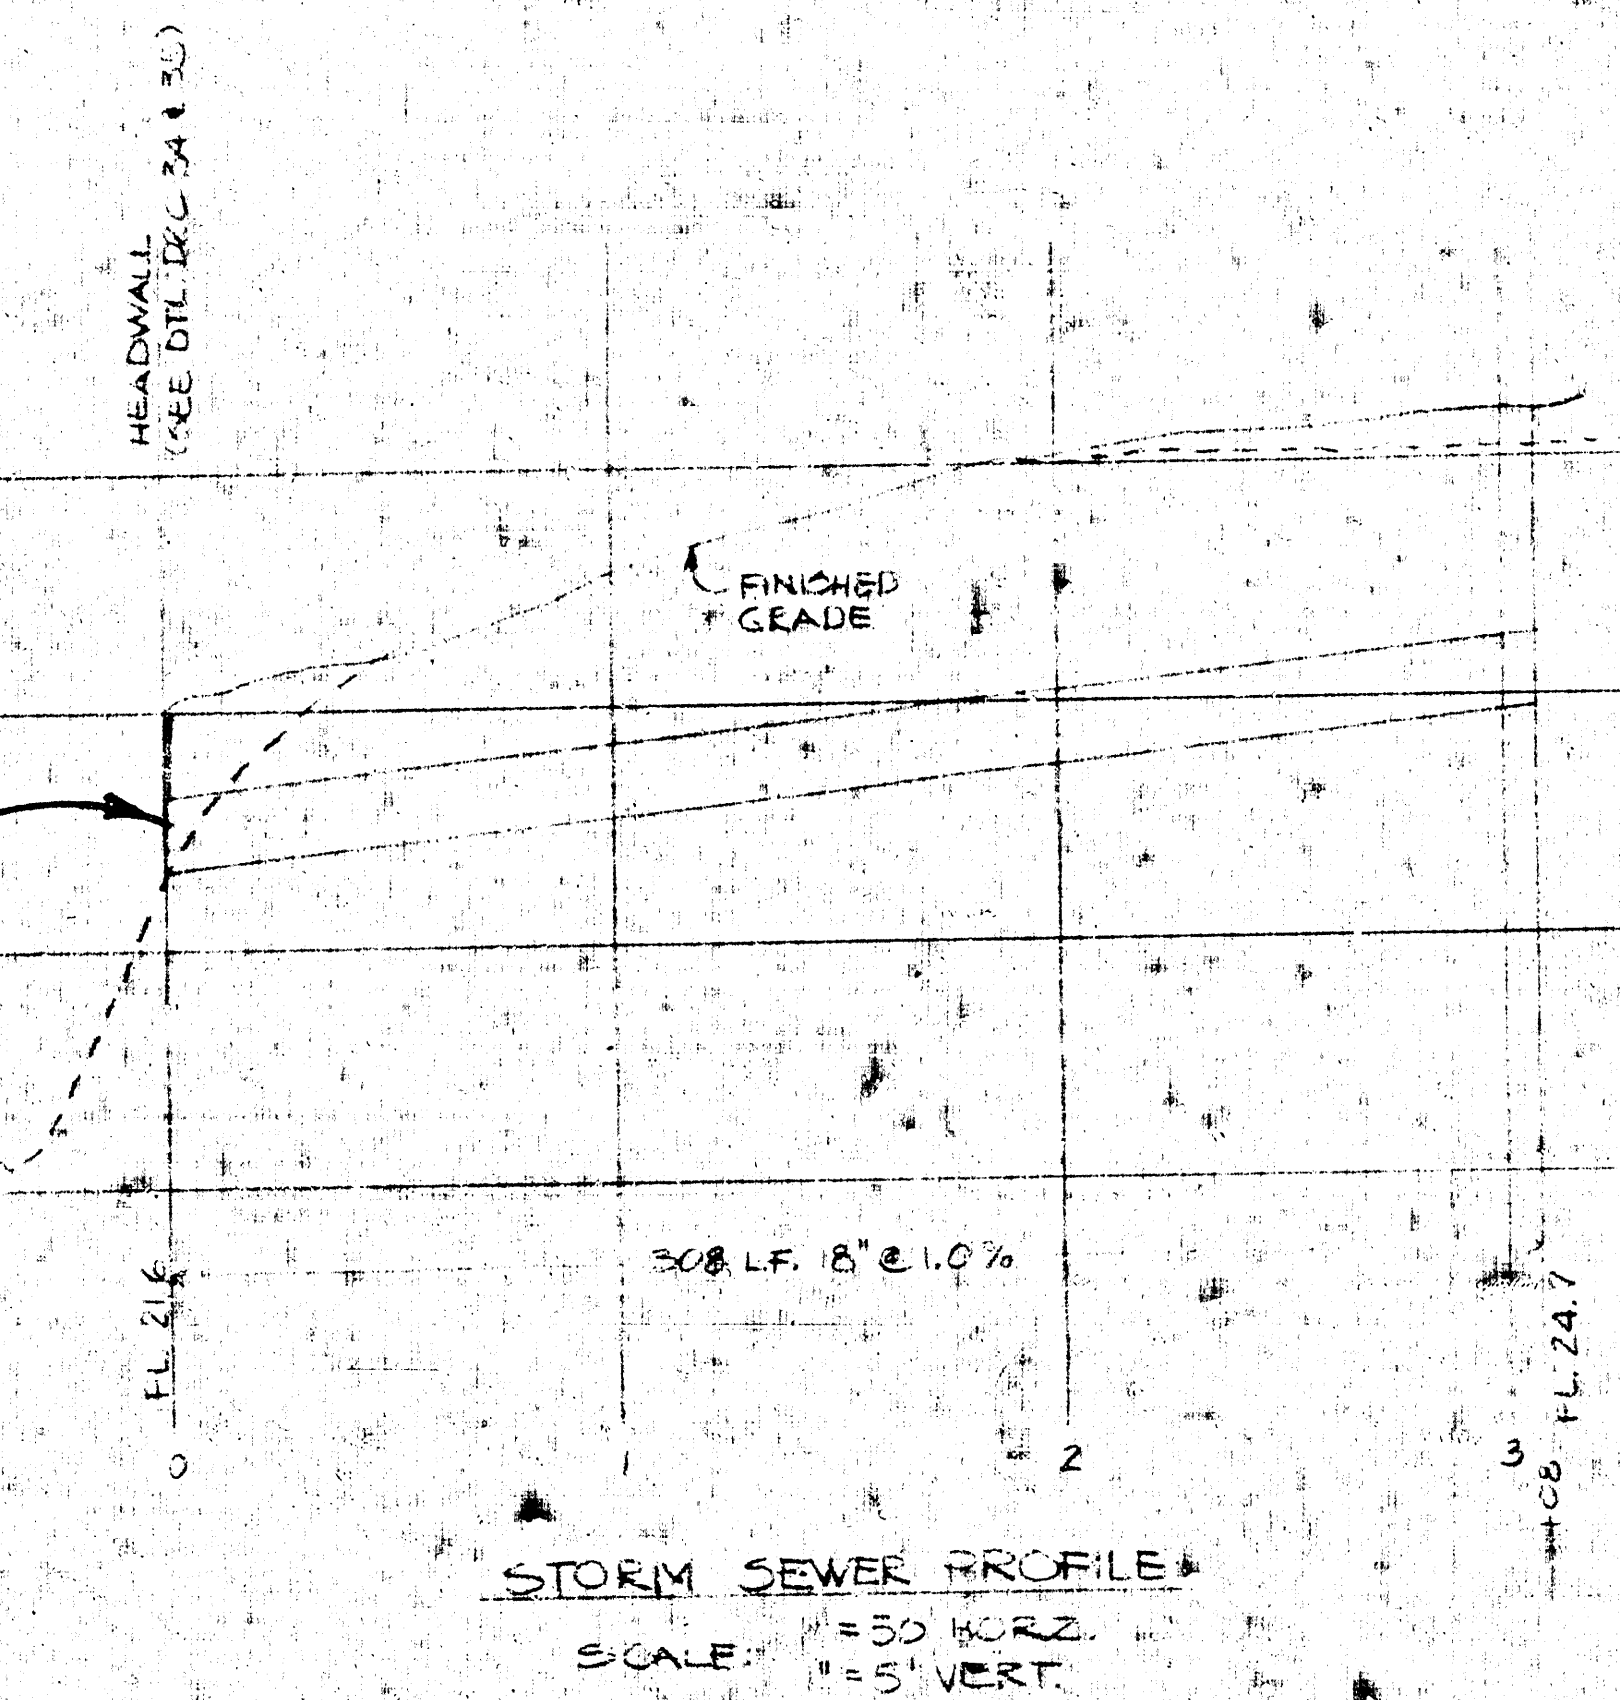

6-21-76

APPROVED AS NOTED
By CITY ENGINEER OF WICHITA

Sanitary Sewers *D.E.S.*

Storm Sewers _____

Driveway Approaches _____

PLANEVIEW ELEMENTARY SCHOOL AND
COMMUNITY CENTER

by Flood Control.

A SITE GRADING & UTILITIES

NOTE: SEE PLAN A3 FOR SPOT ELEVATIONS ON PAVING, WALKS AND GRADE AT BUILDING CORNERS.