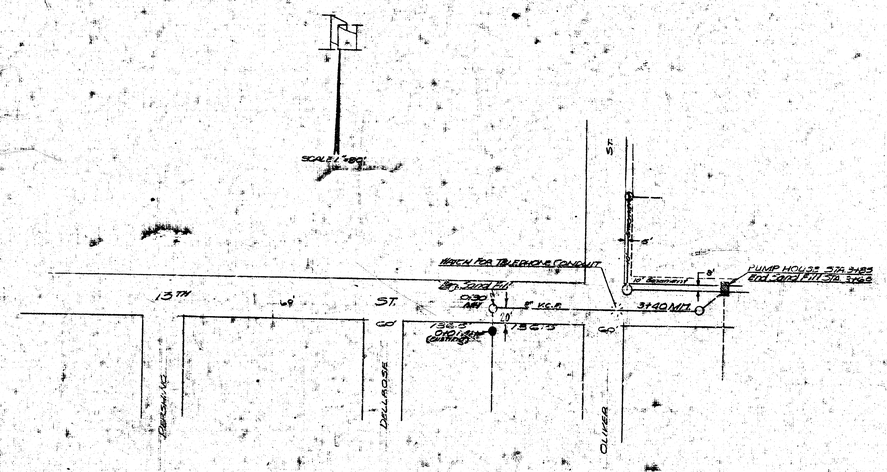
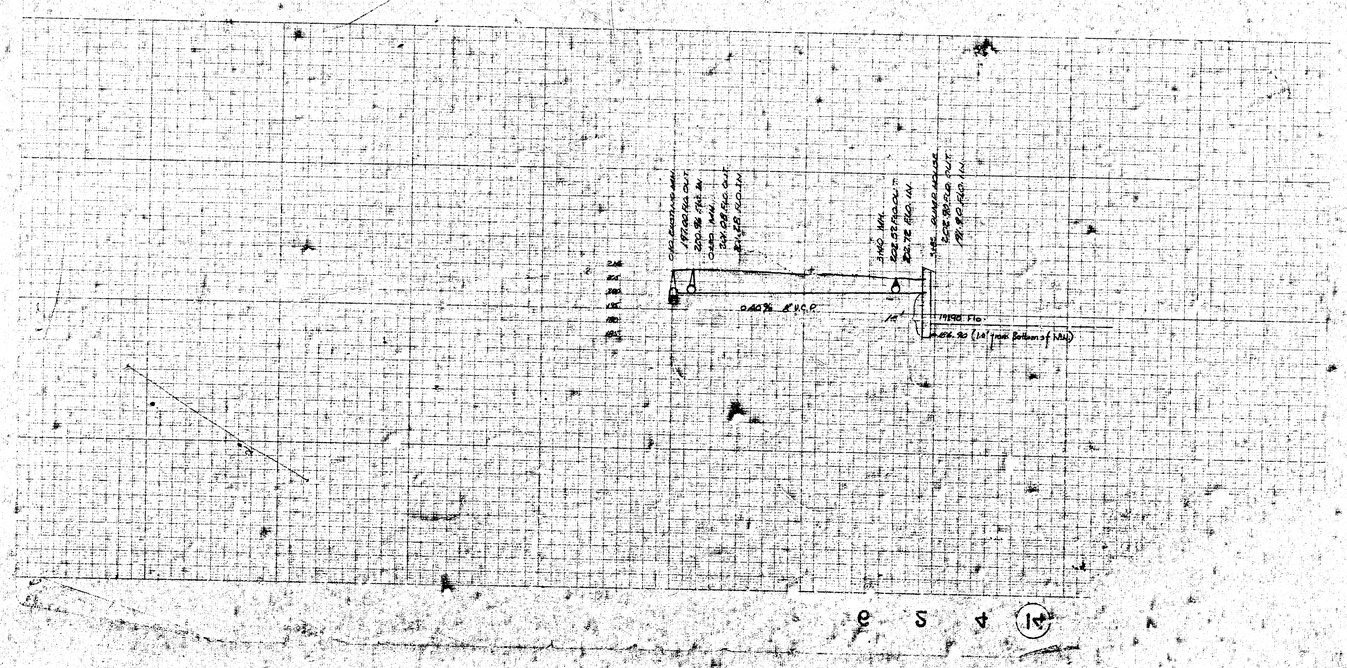
Force Main Line & Pump House @ 13th & Oliver. Presently Abandoned.