

B.M. 113.58 SE cor. conc. base R.R. signal light
N.W. cor. Central and Wichita

NOTE TO CONTRACTOR:


Contractor is to give the Mr. Pac. & Texas
Pac. R.R. Co. an advanced notification of 48 hours
prior to beginning construction near R.R. Tracks
in Wichita St.

NOTIFY: The Roadmaster
Mo. Pacific and Texas Pacific R.R. Co.
1410 East 25th St. No.
Ph. No. 838-8911


Casing pipe to be installed by boring
methods using equipment that encases
the hole as the earth is removed. Boring
without concurrent installation of cas-
ing will not be permitted. Sewer to be
accurately positioned to flow elevation
in casing using creosoted wood skids.
Casing pipe to be completely filled
with specified sand mix concrete after
installation of 8" cast iron sewer pipe.

Bid price of tunnel shall include the steel pipe,
pressure grout, skids and straps.

Concrete collar constructed on storm sewer will not
be paid for directly and shall be considered as
subsidiary to other items of work.

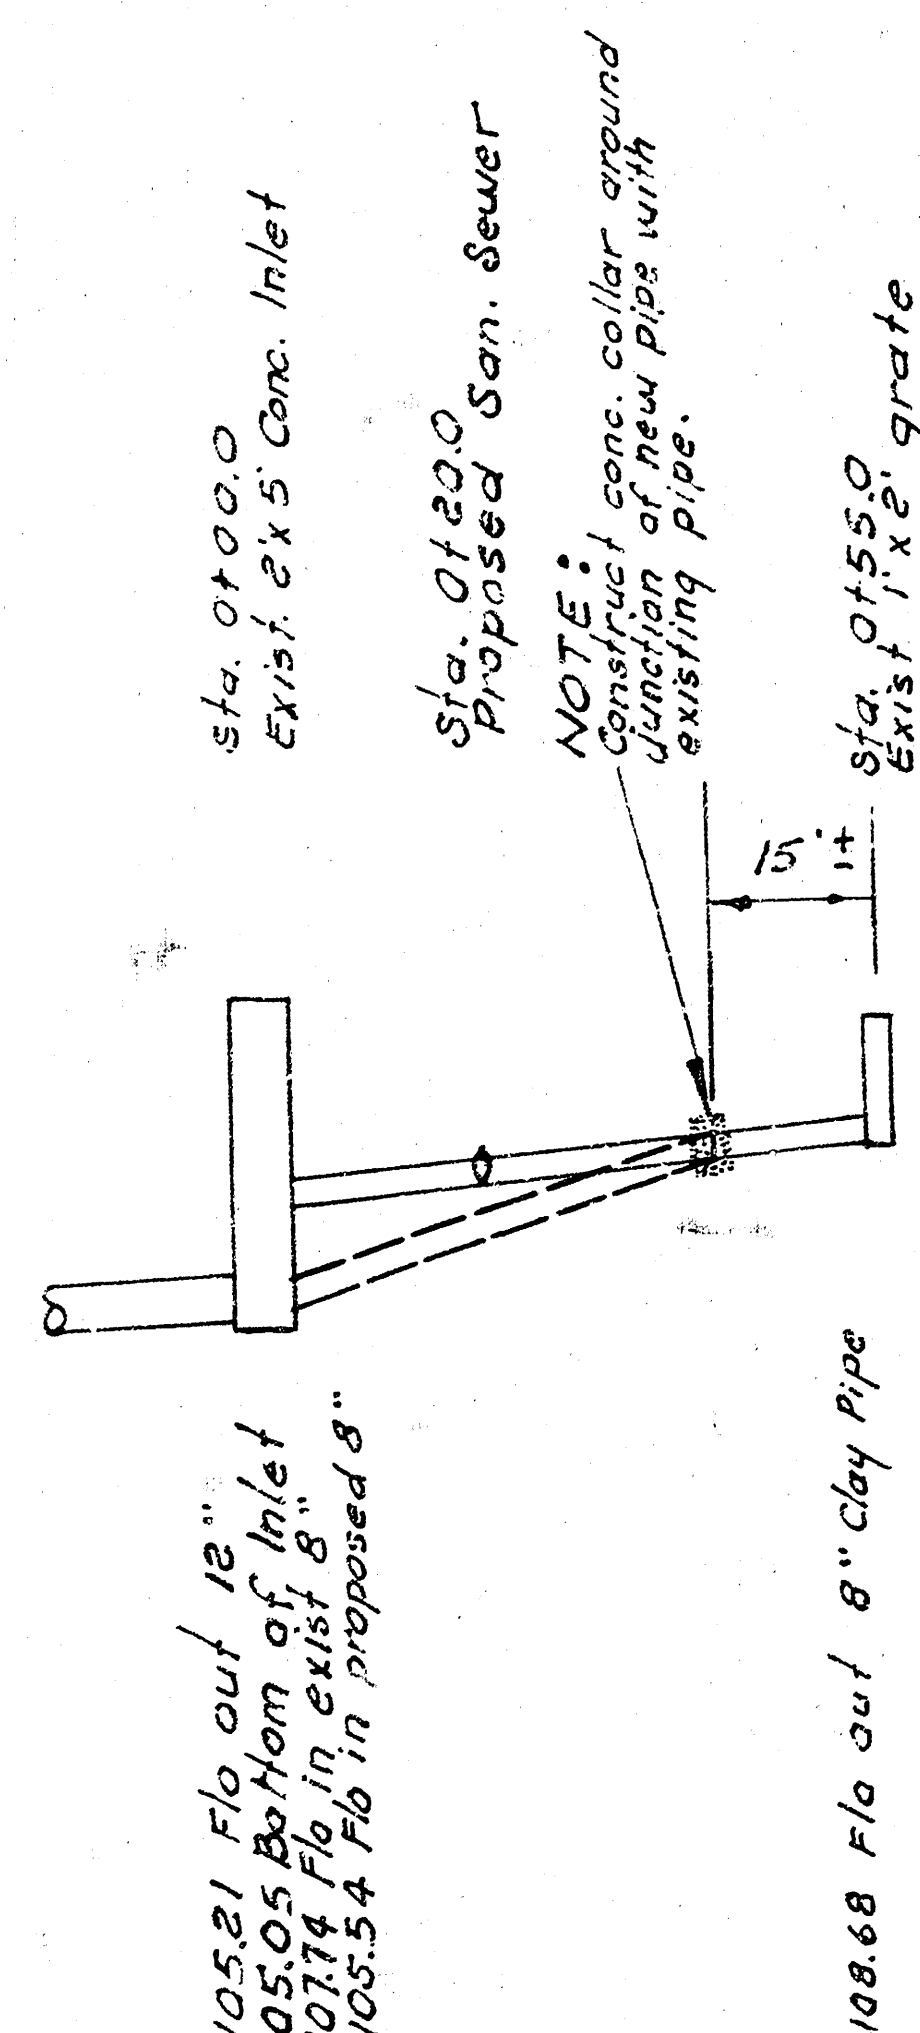

Storm Water Pipe Alteration

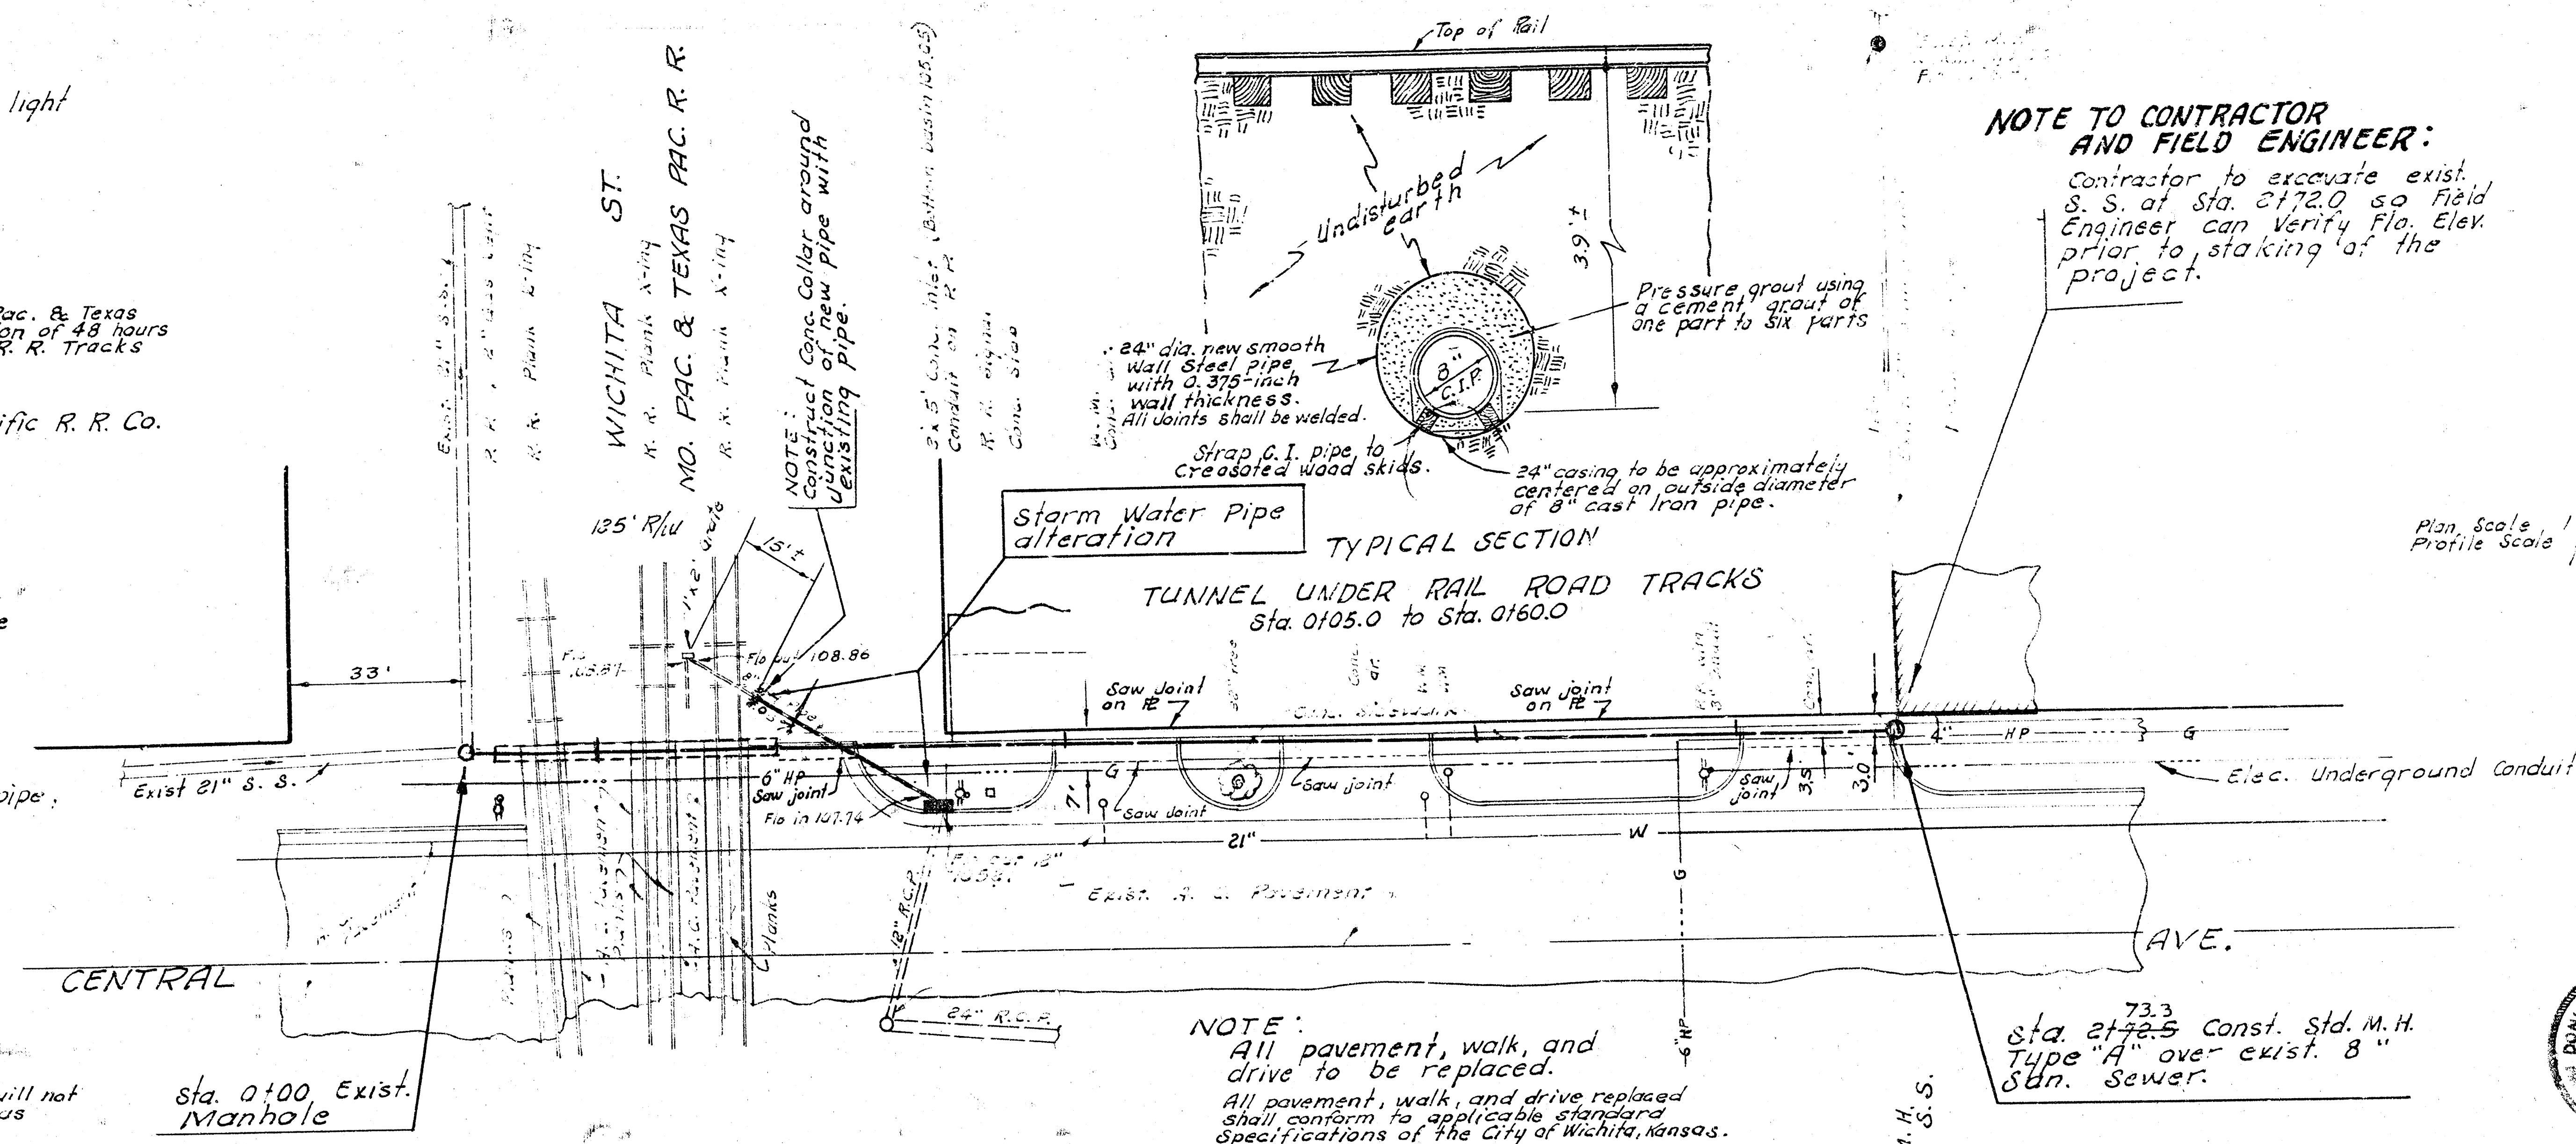


NOTE TO CONTRACTOR AND FIELD ENGINEER:

Contractor to excavate exist.
8" S. of Sta. 2172.0 so Field
Engineer can verify Fla. Elev.
prior to staking of the
project.

Plan Scale 1" = 20'
Profile Scale 1" = 5' Vert.

NOTE:
All pavement, walk, and
drive to be replaced.
All pavement, walk, and drive replaced
shall conform to applicable standard
specifications of the City of Wichita, Kansas.

Sta. 2172.5 Const. Std. M.H.
Type "A" over exist. 8"
Sdn. Sewer.

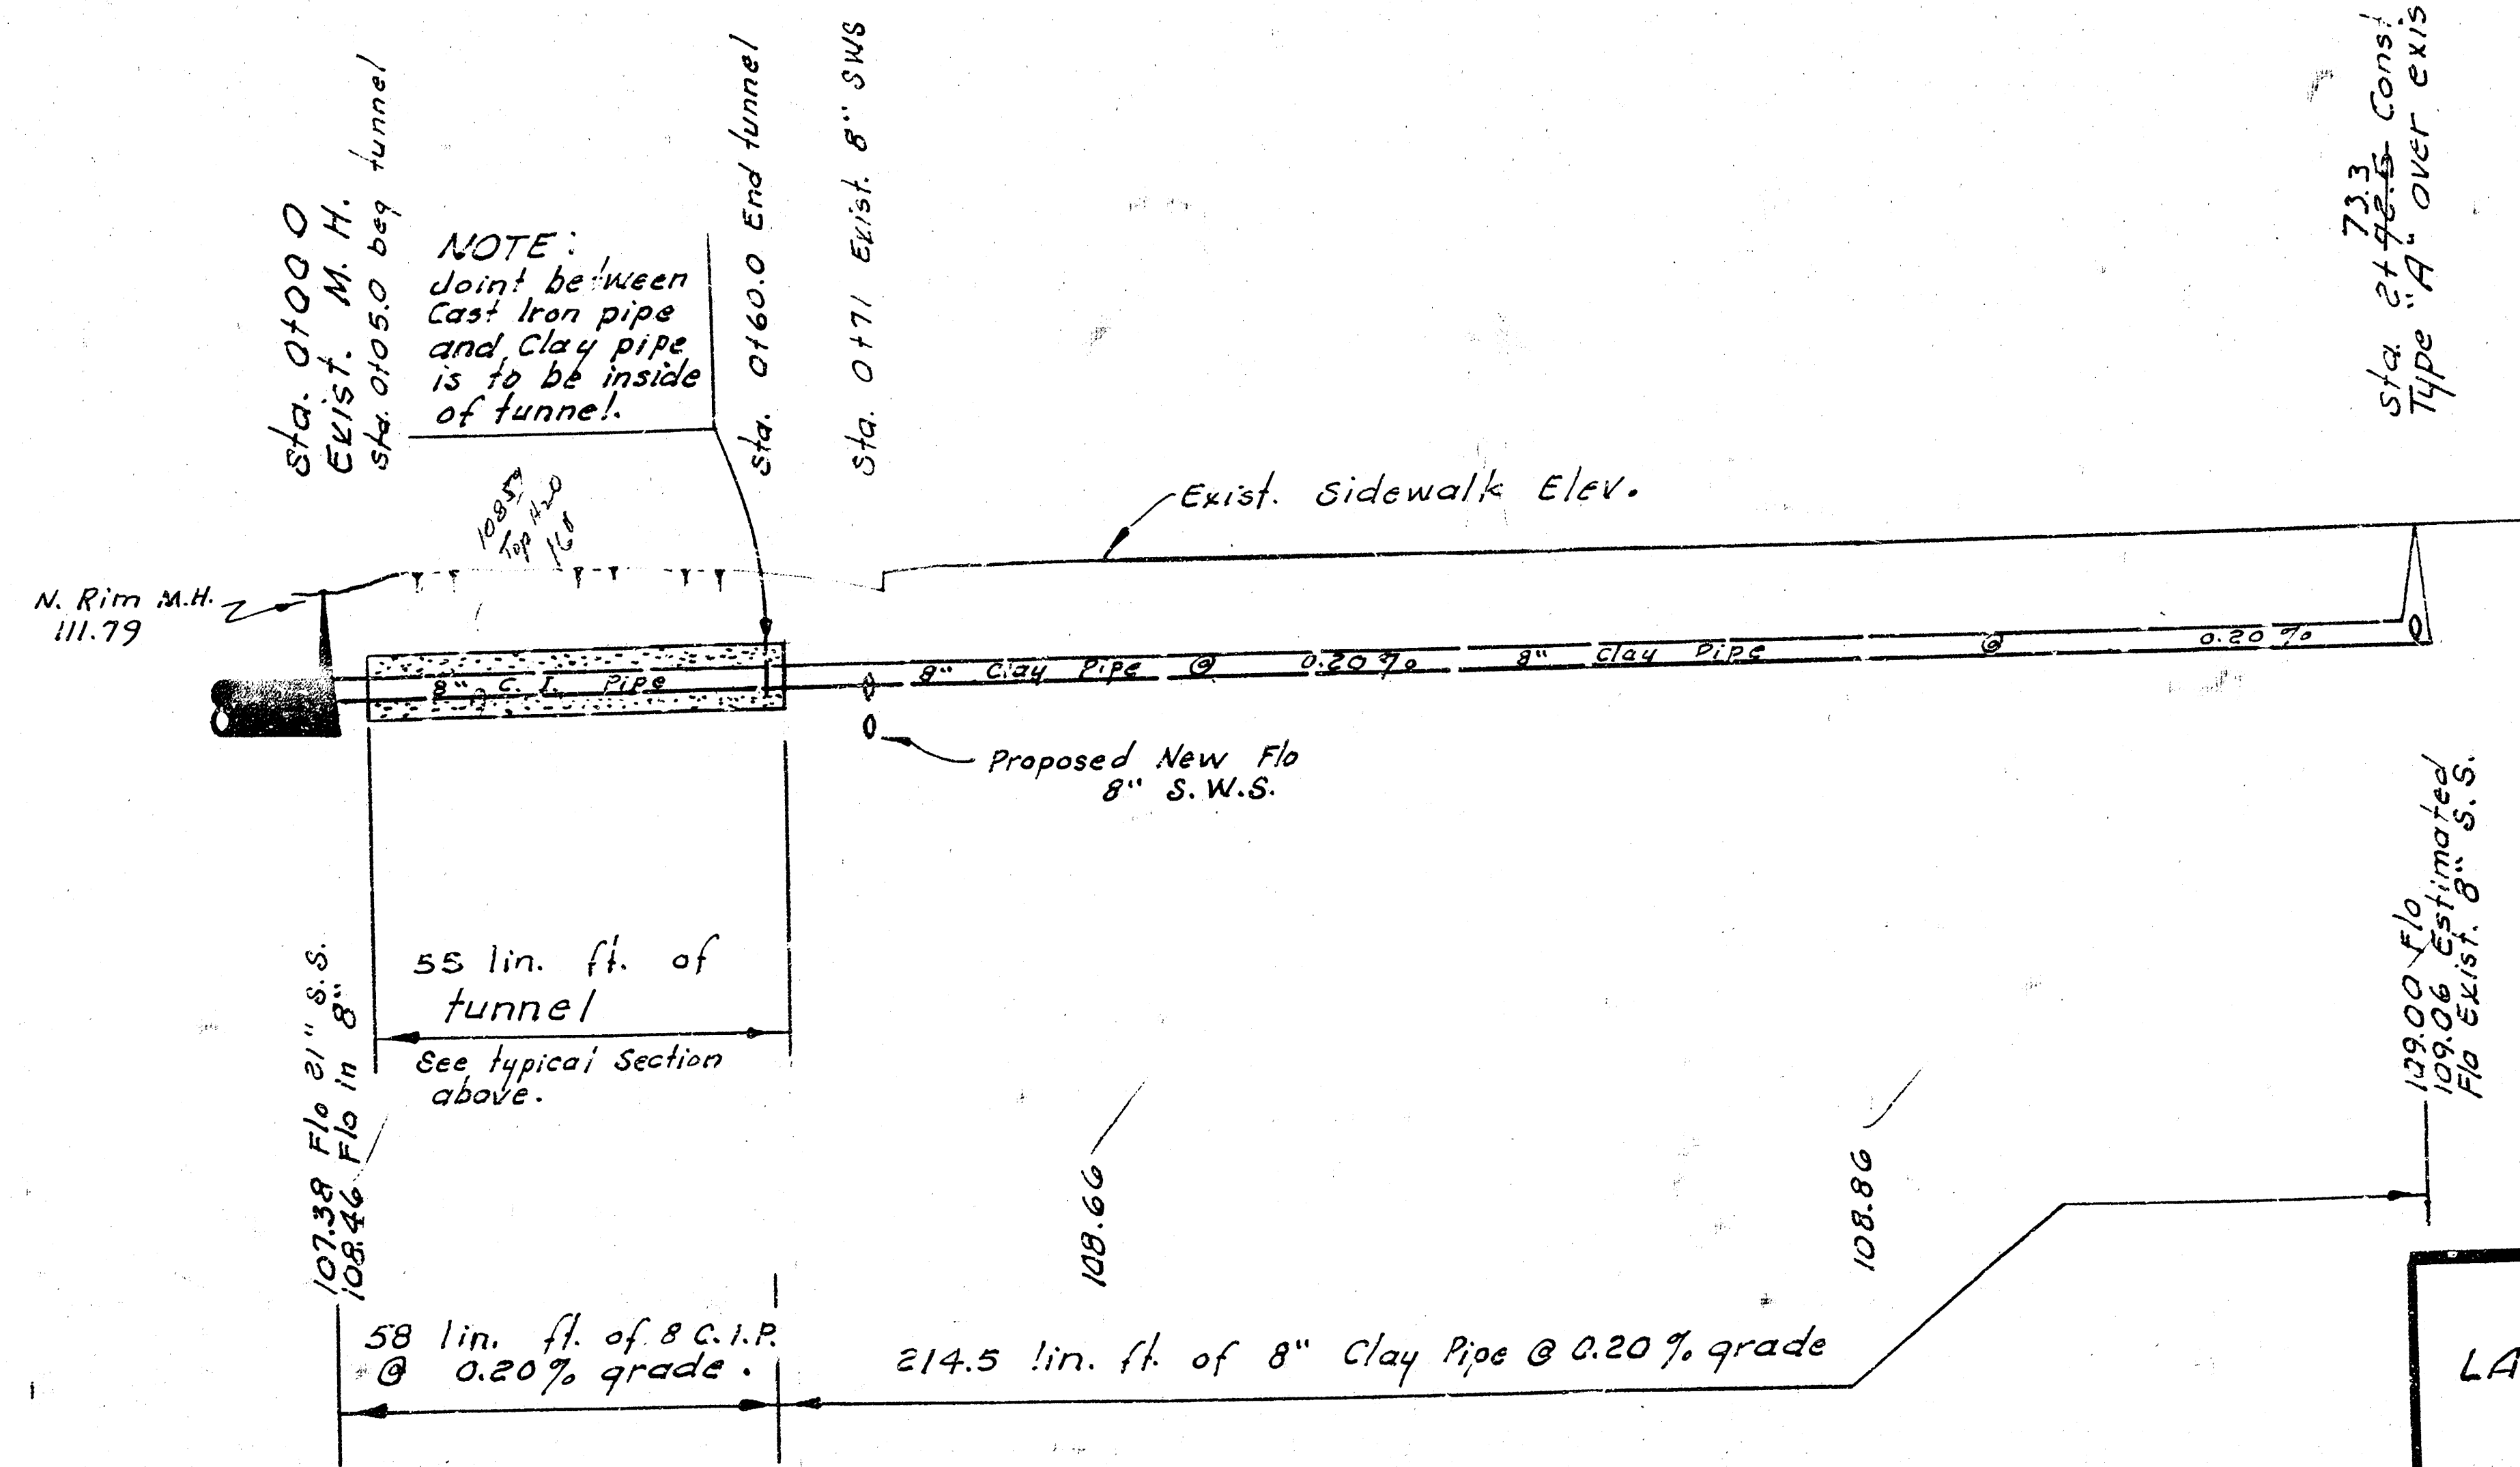

RELOCATION OF A PART OF
LAT. S, WEST SUB. A, on CENTRAL AVE., S.S. NO. 1
CITY OF WICHITA, KANSAS
R. W. LINN CITY ENGINEER
AUG. 1972 PROJECT NO. KANS 4-5-3
AKA 502026