




LAT. T, DIST. D., S.S. No. 12.

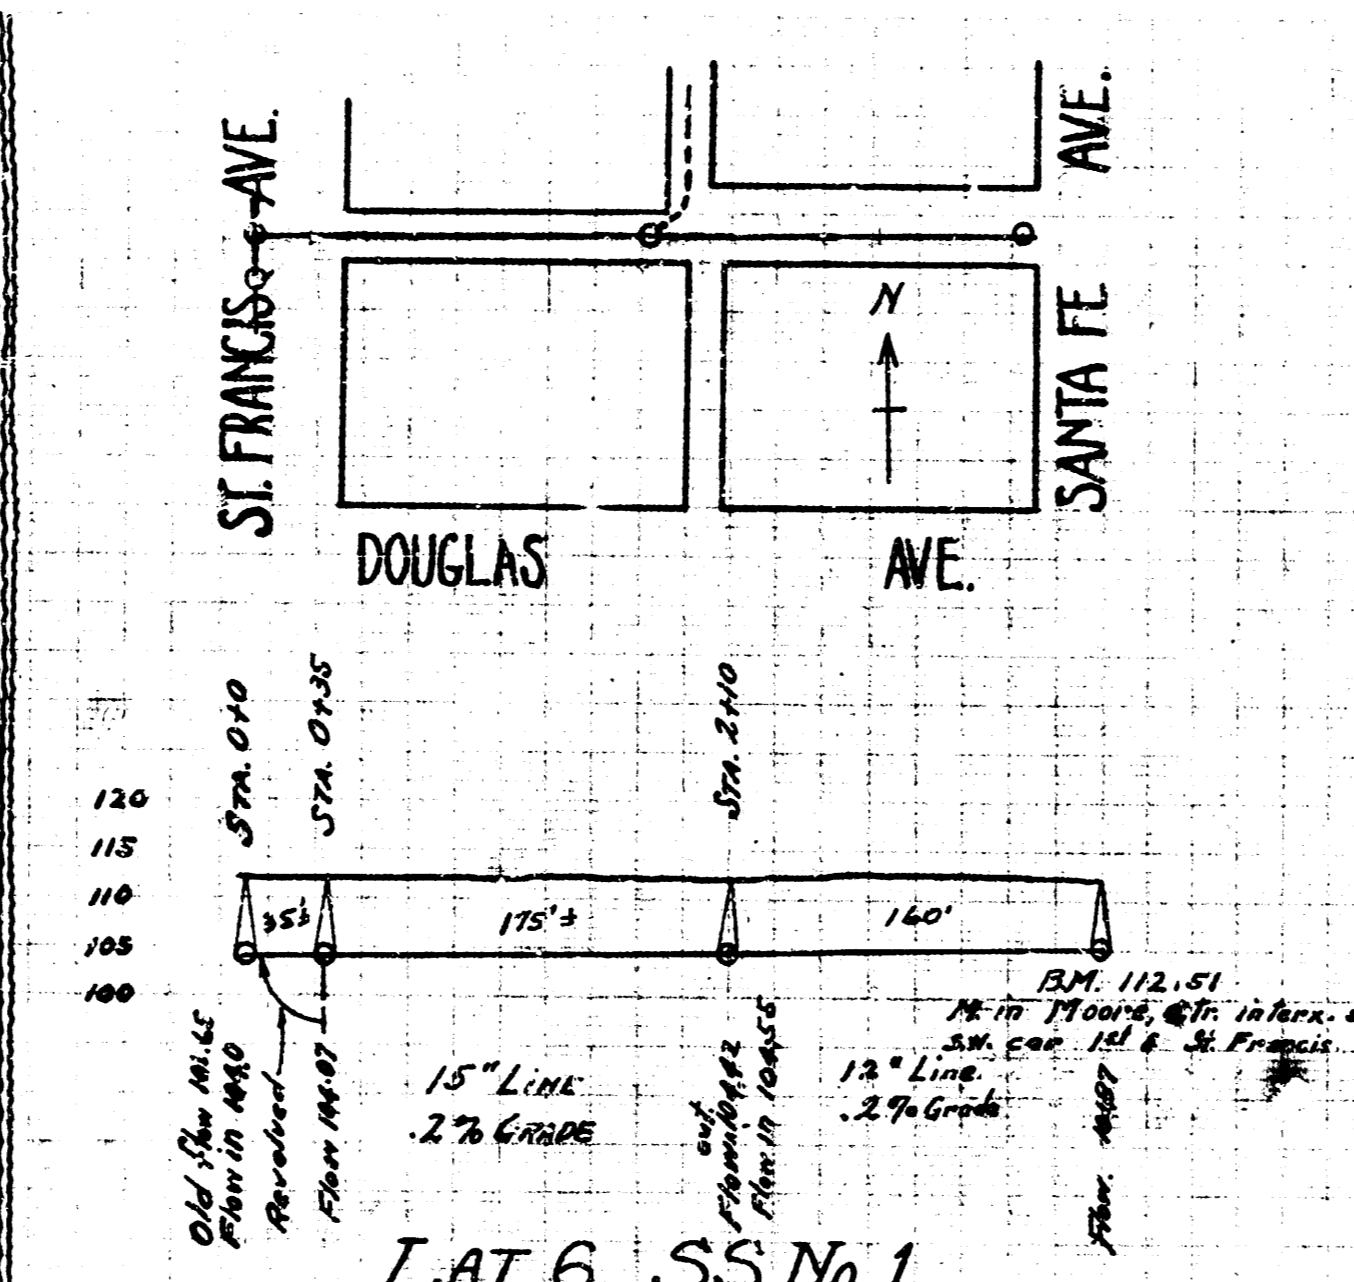

LAT. 6, S.S. No. 1

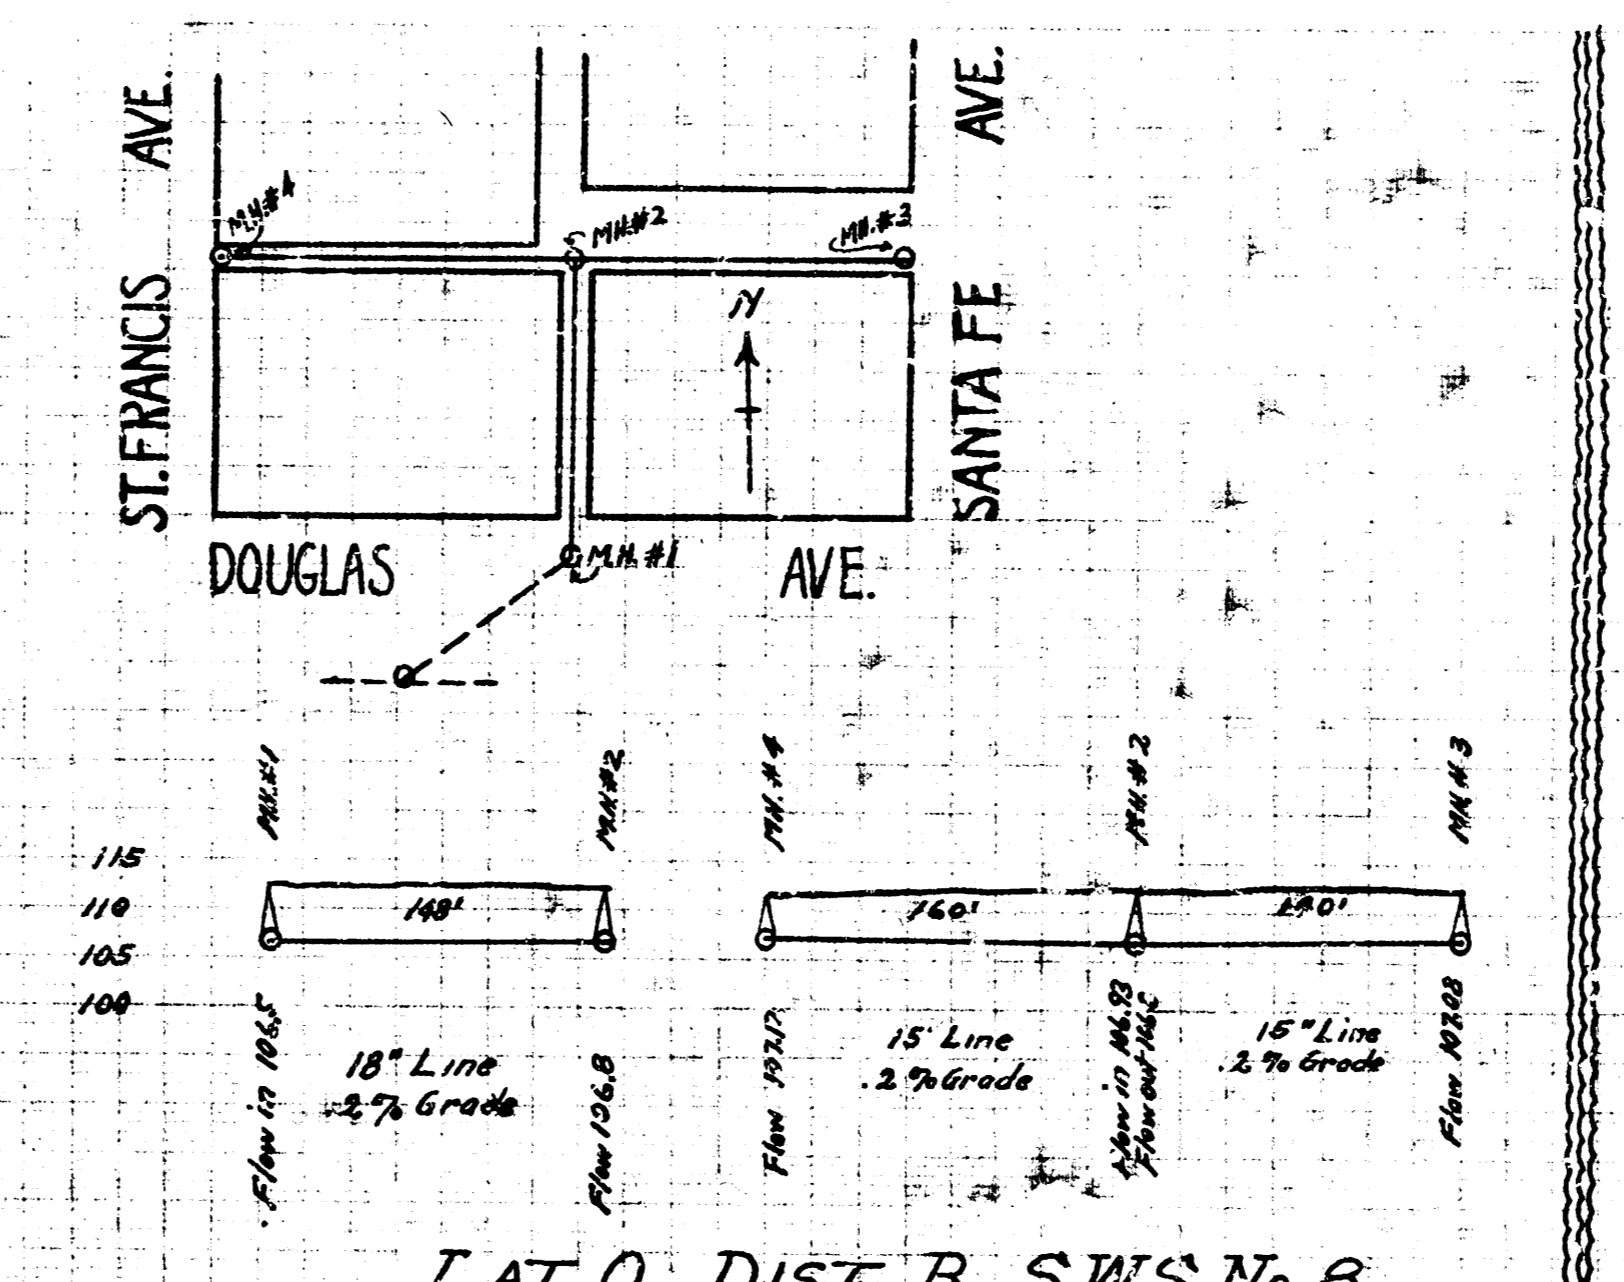


LAT. 0, DIST. B., S.W.S. No. 8

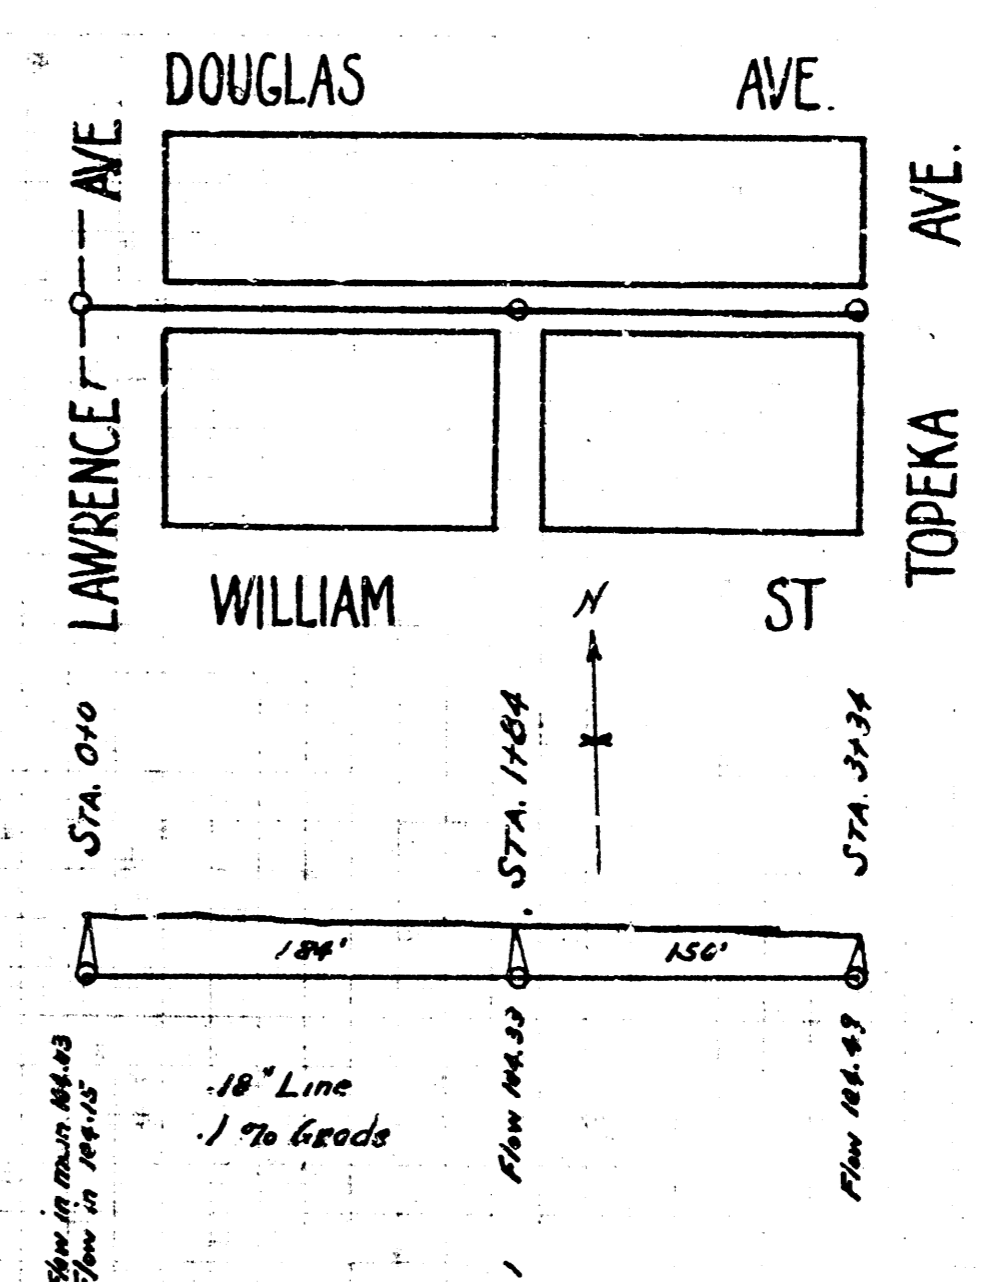


LAT. 7, S.S. No. 1.

B.M. 110.33 - On south end iron water table under south window of side Manhattan Hotel. 120' on Topeka & Douglas.

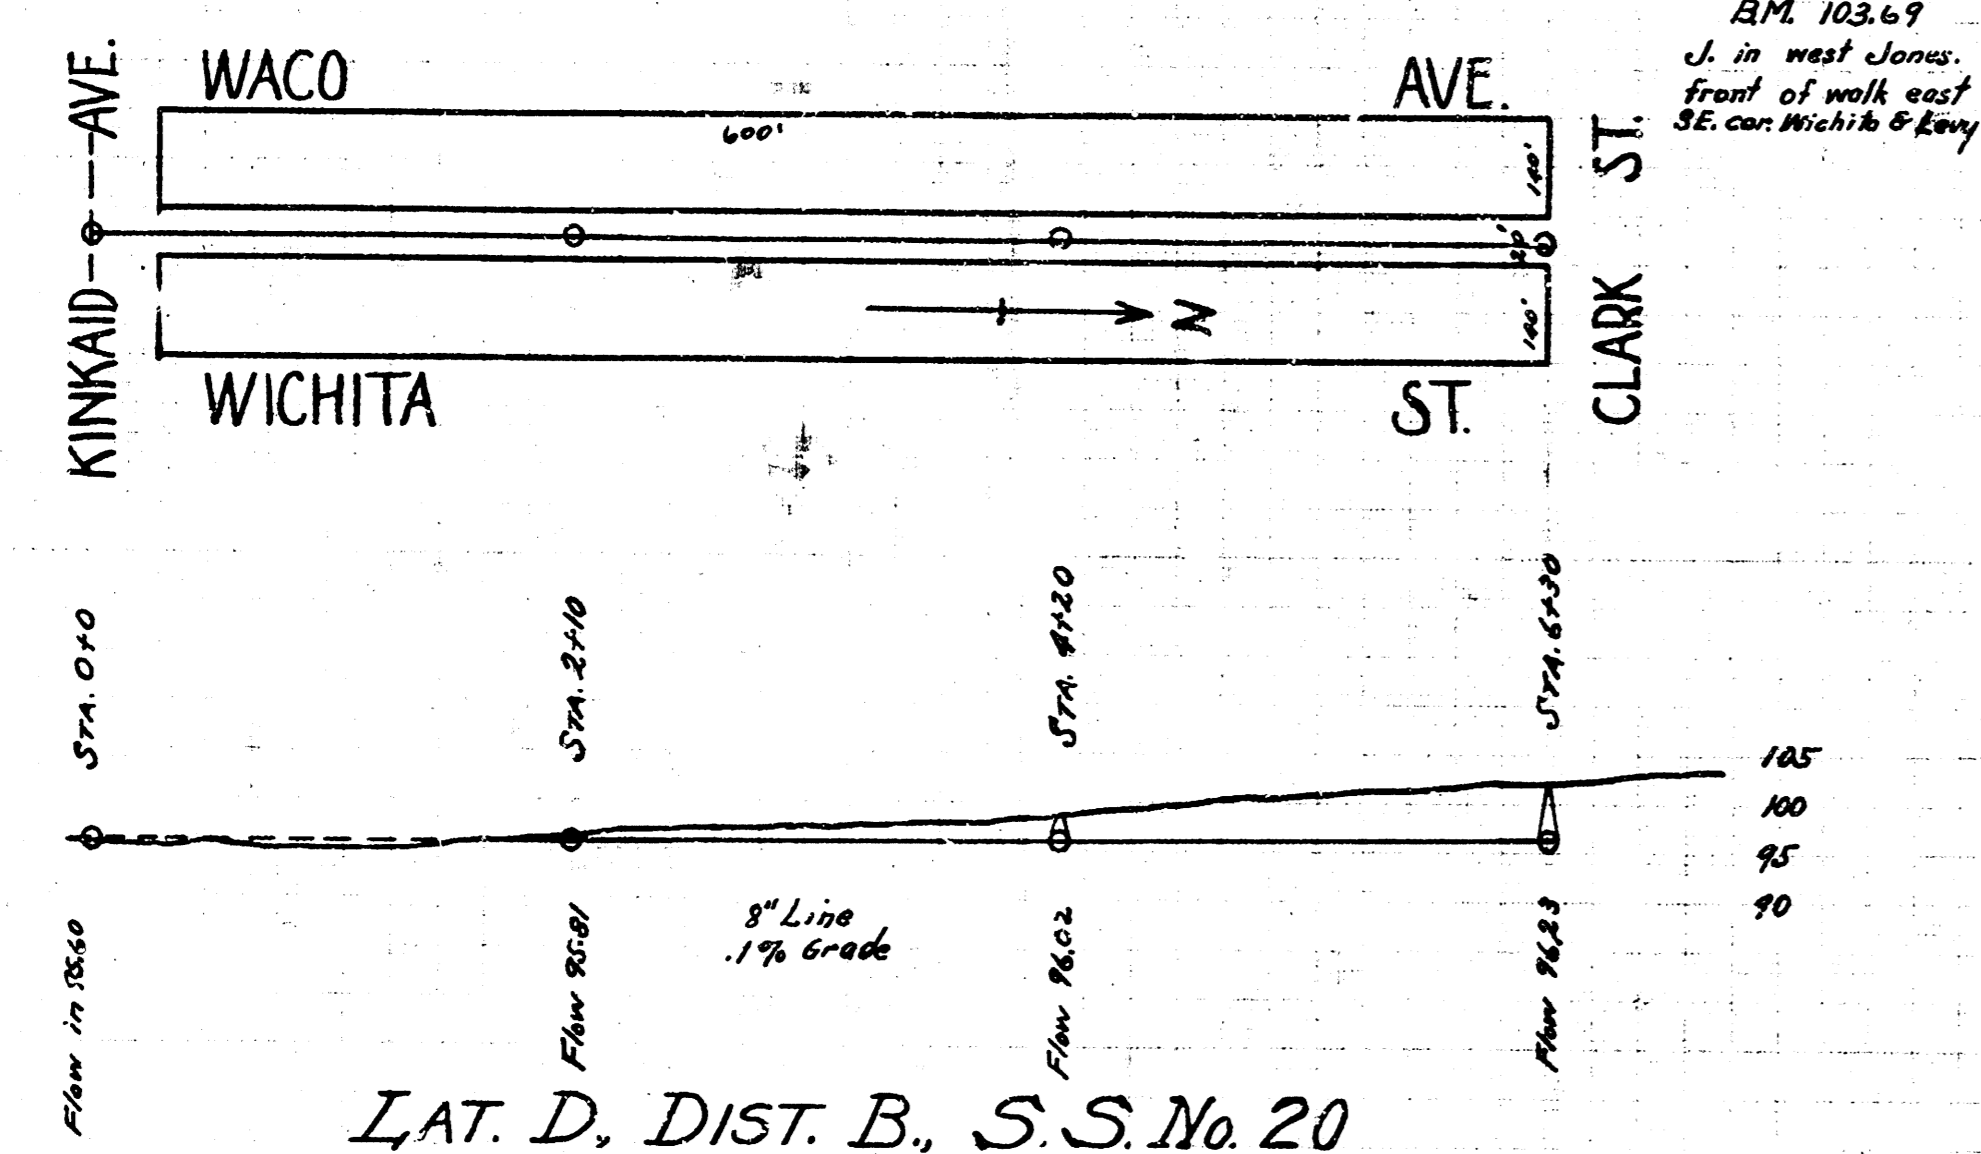

LAT. D, DIST. B., S.S. No. 20

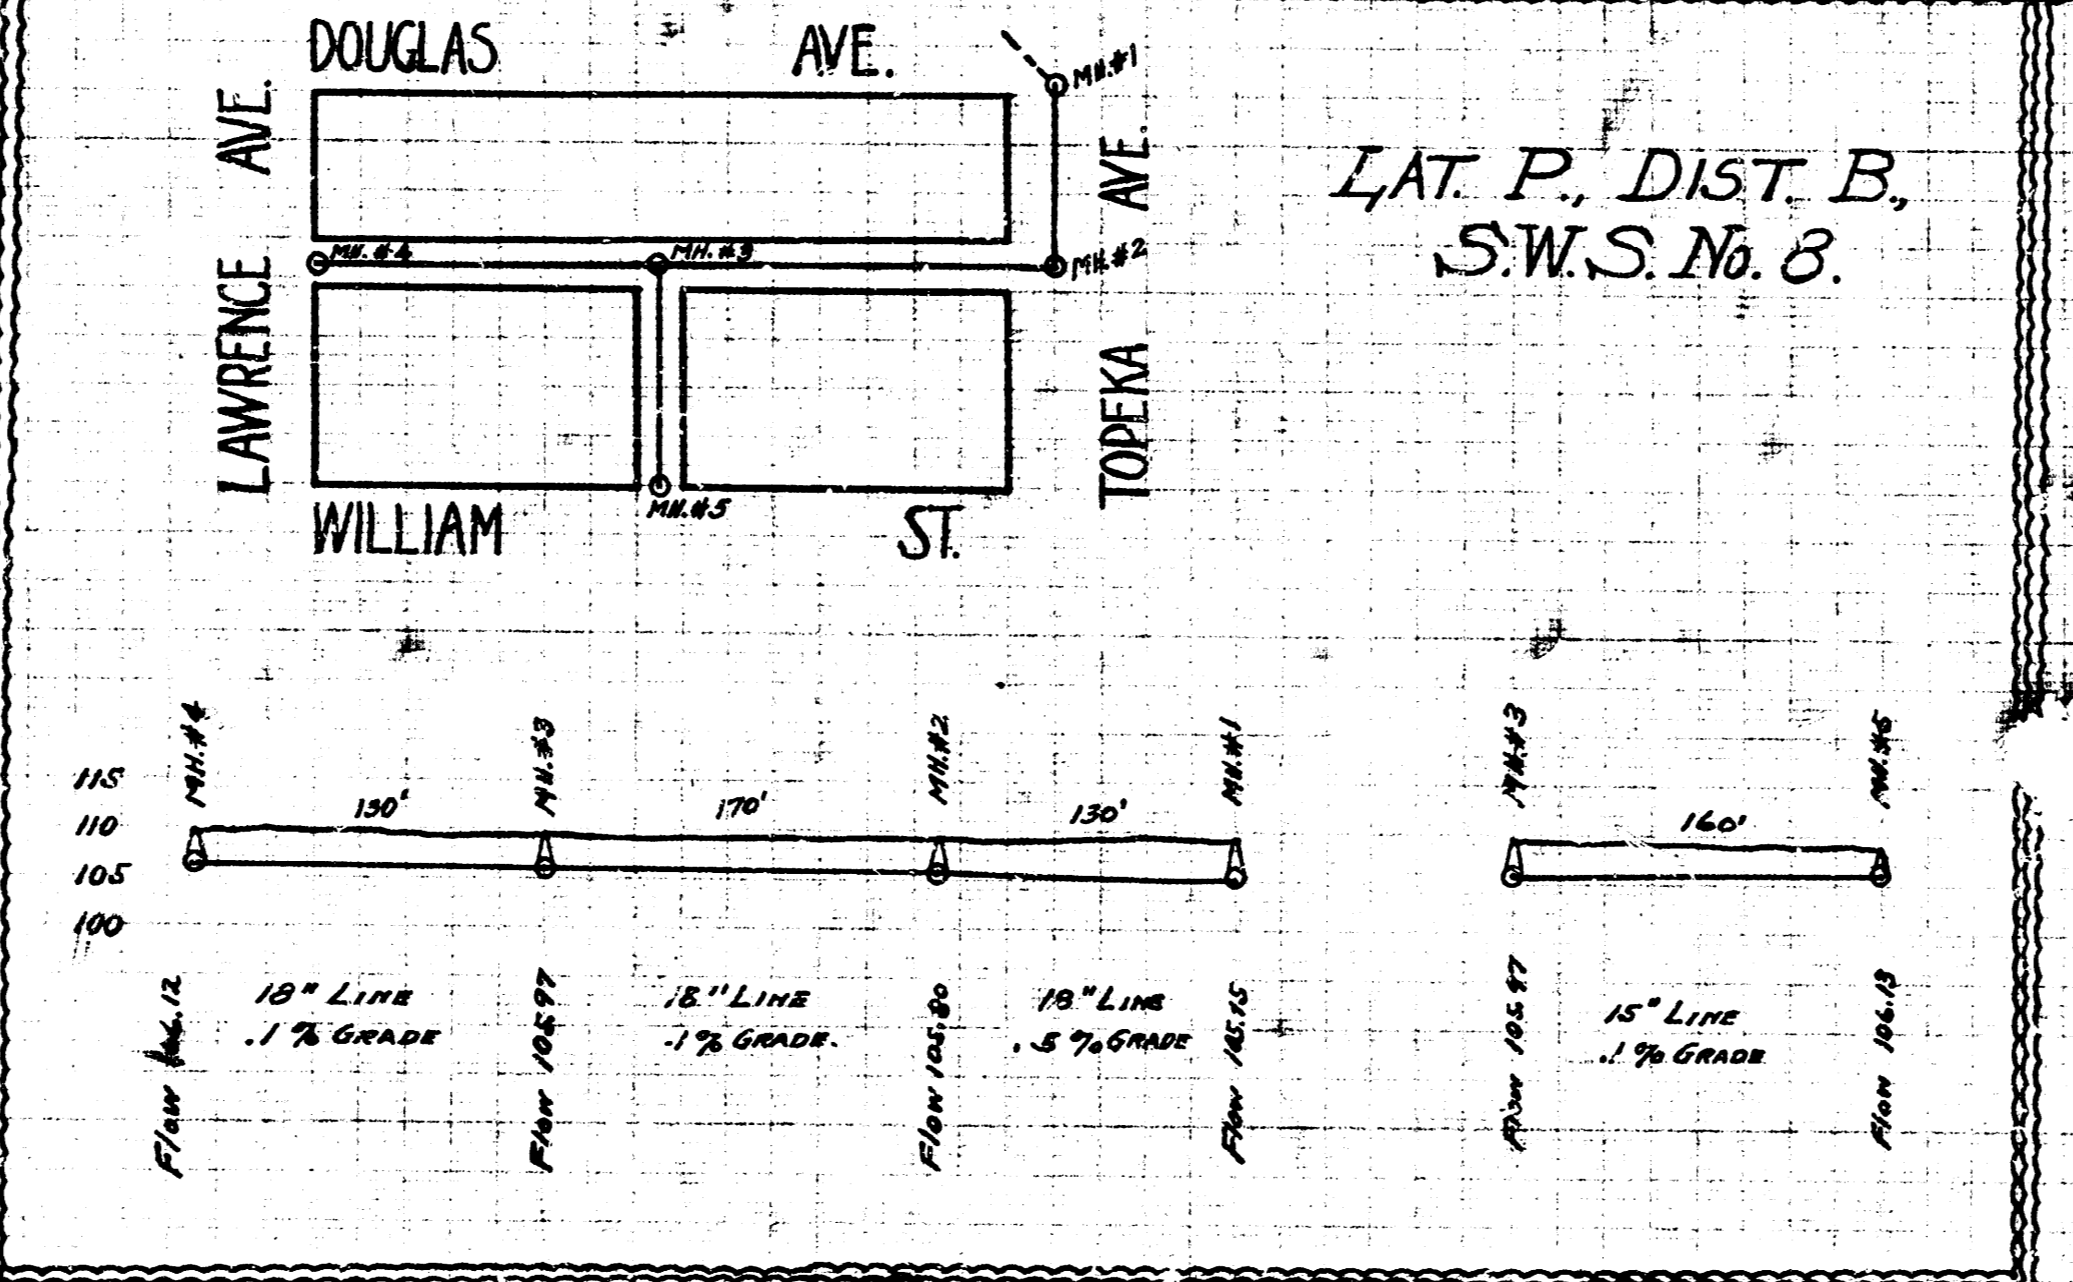

LAT. P, DIST. B., S.W.S. No. 8.