

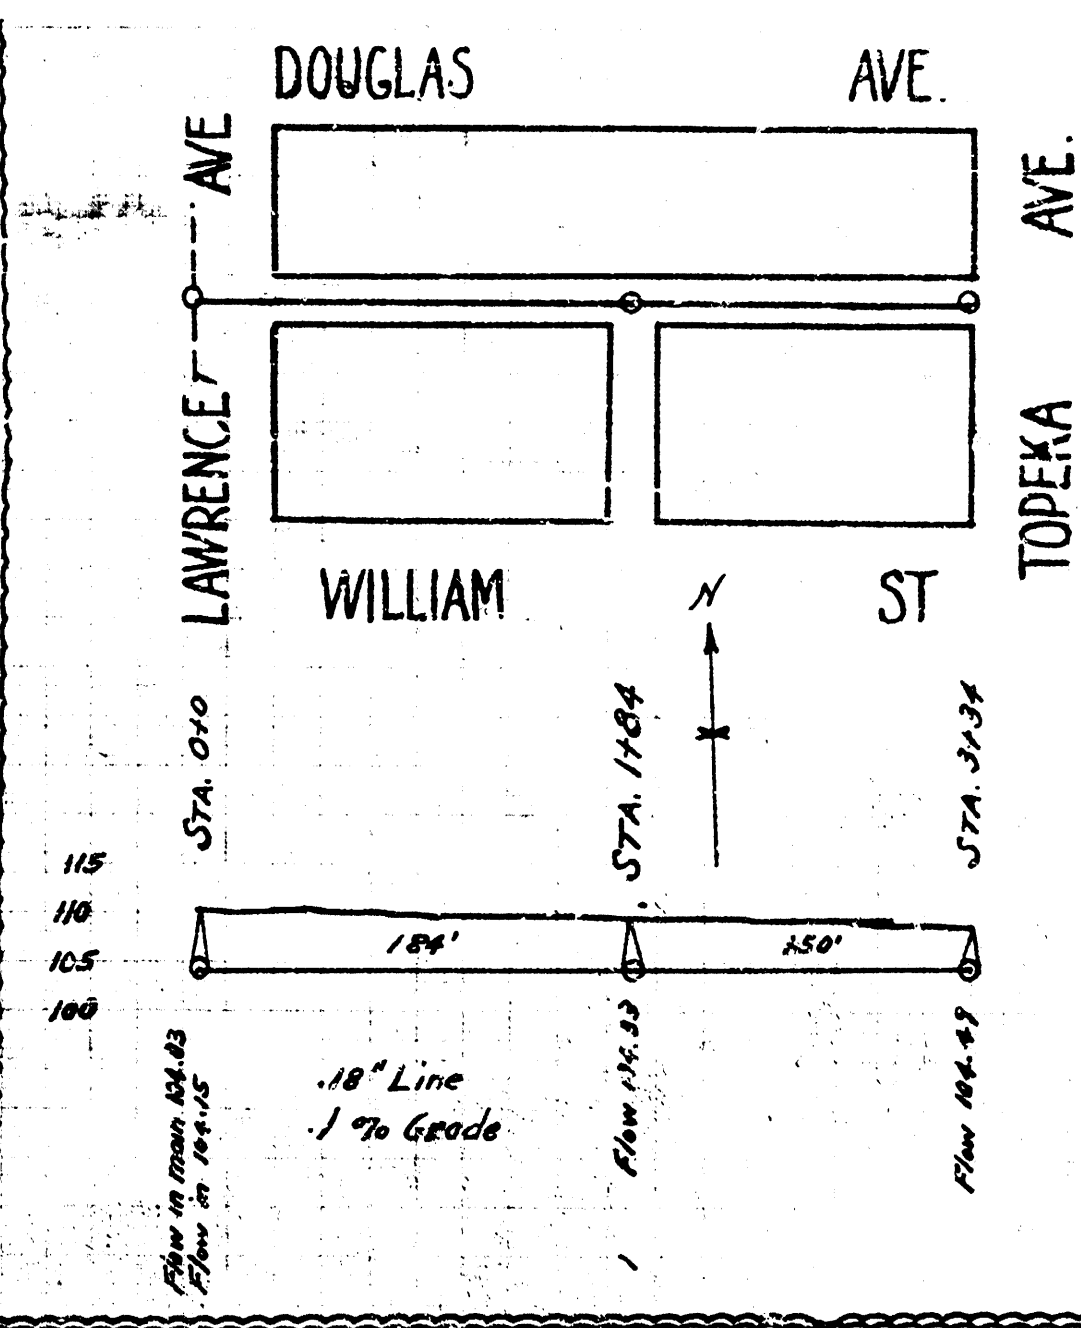
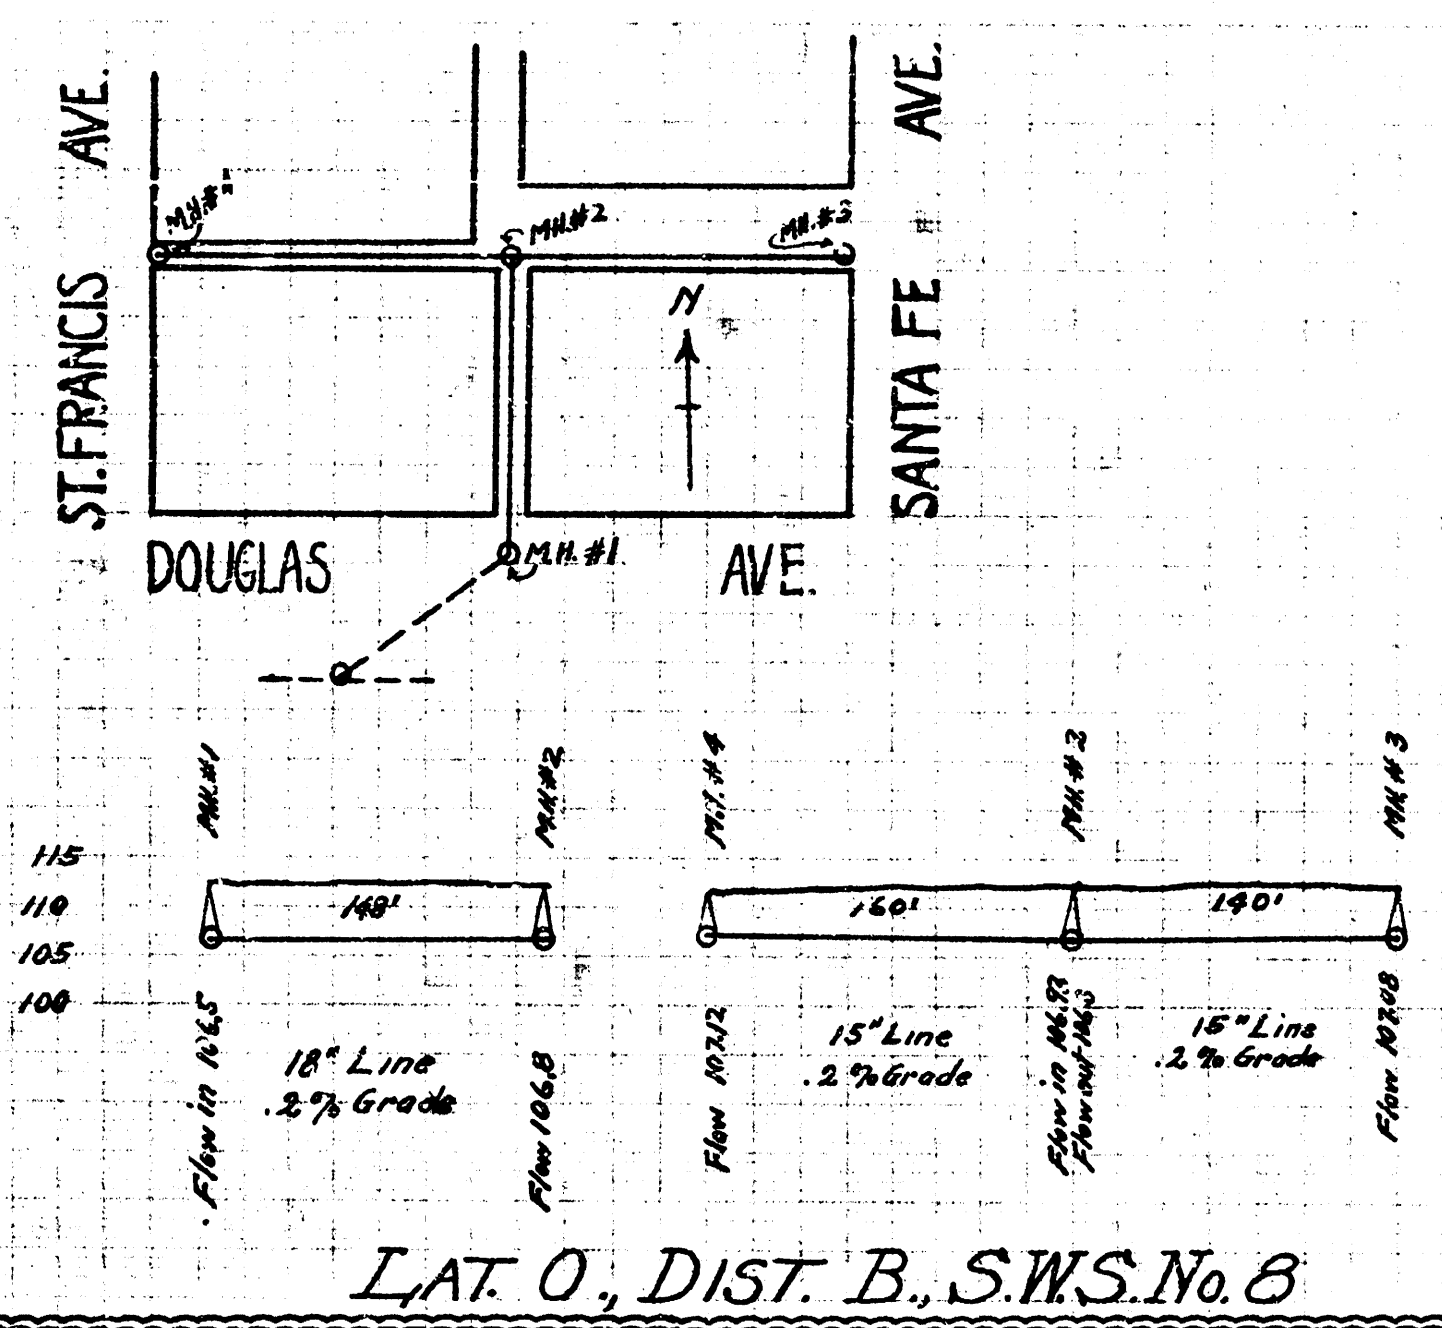
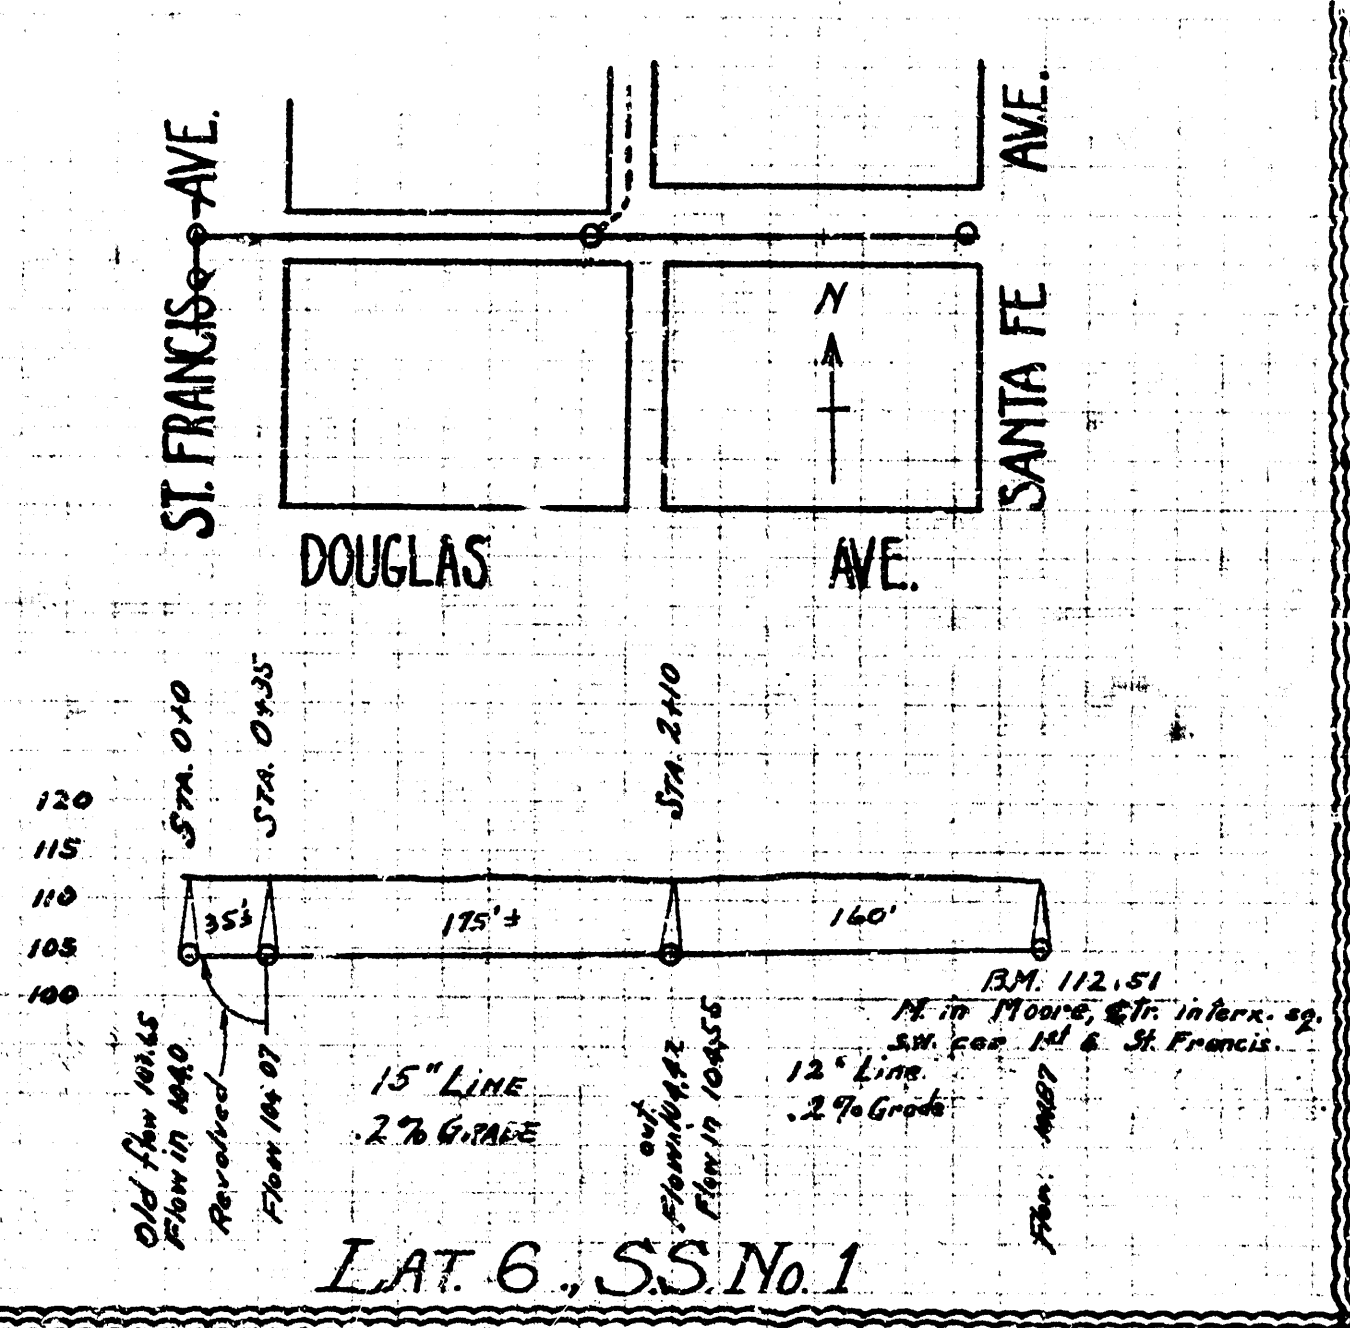
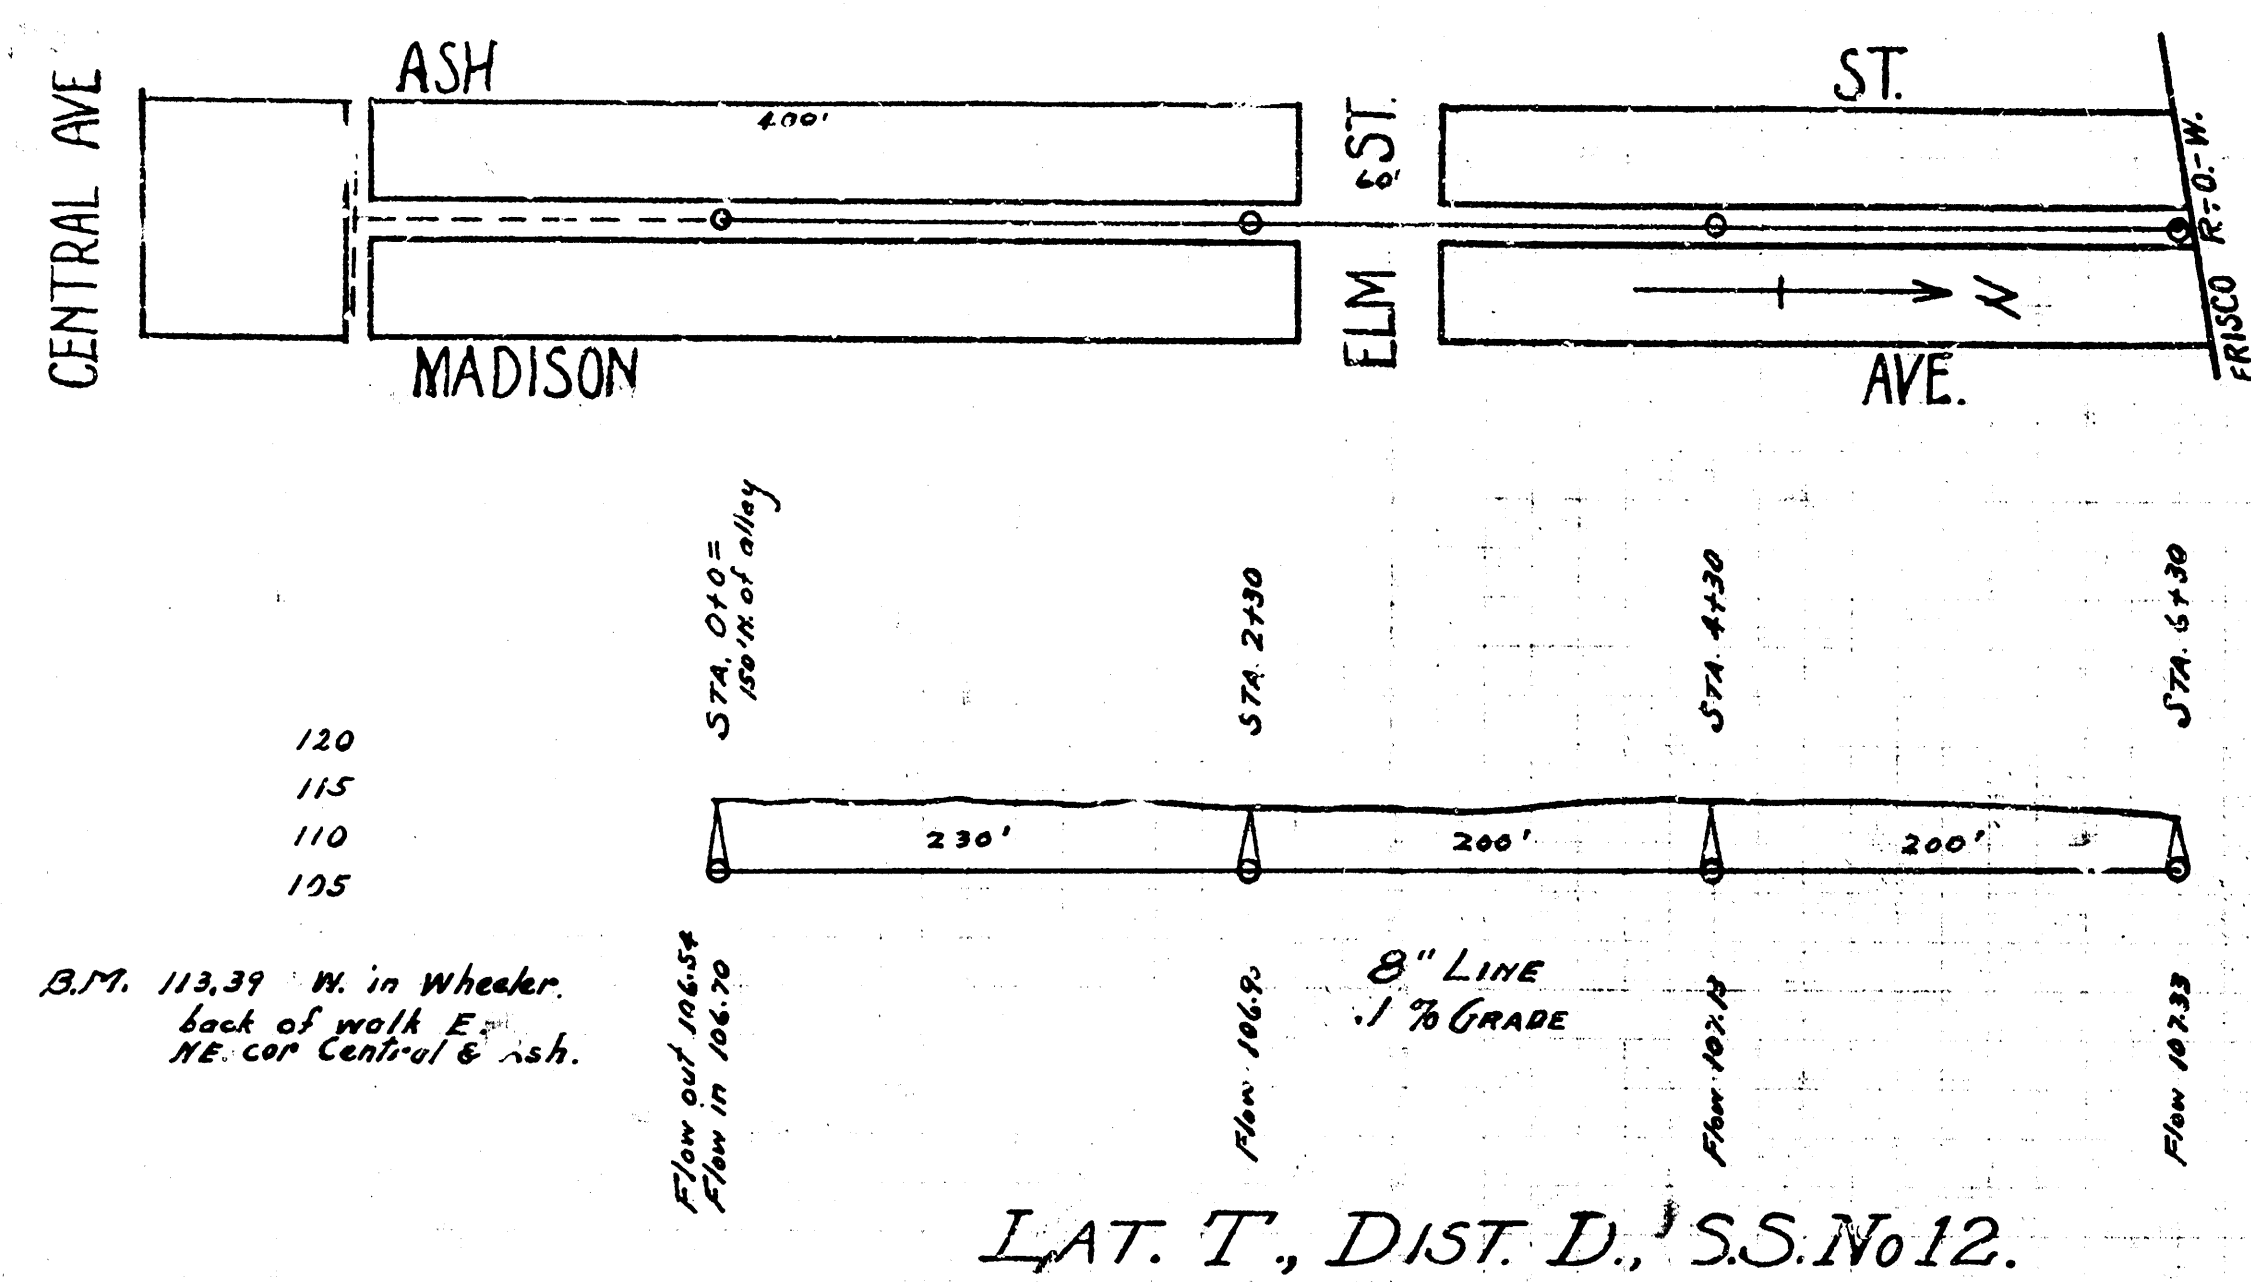


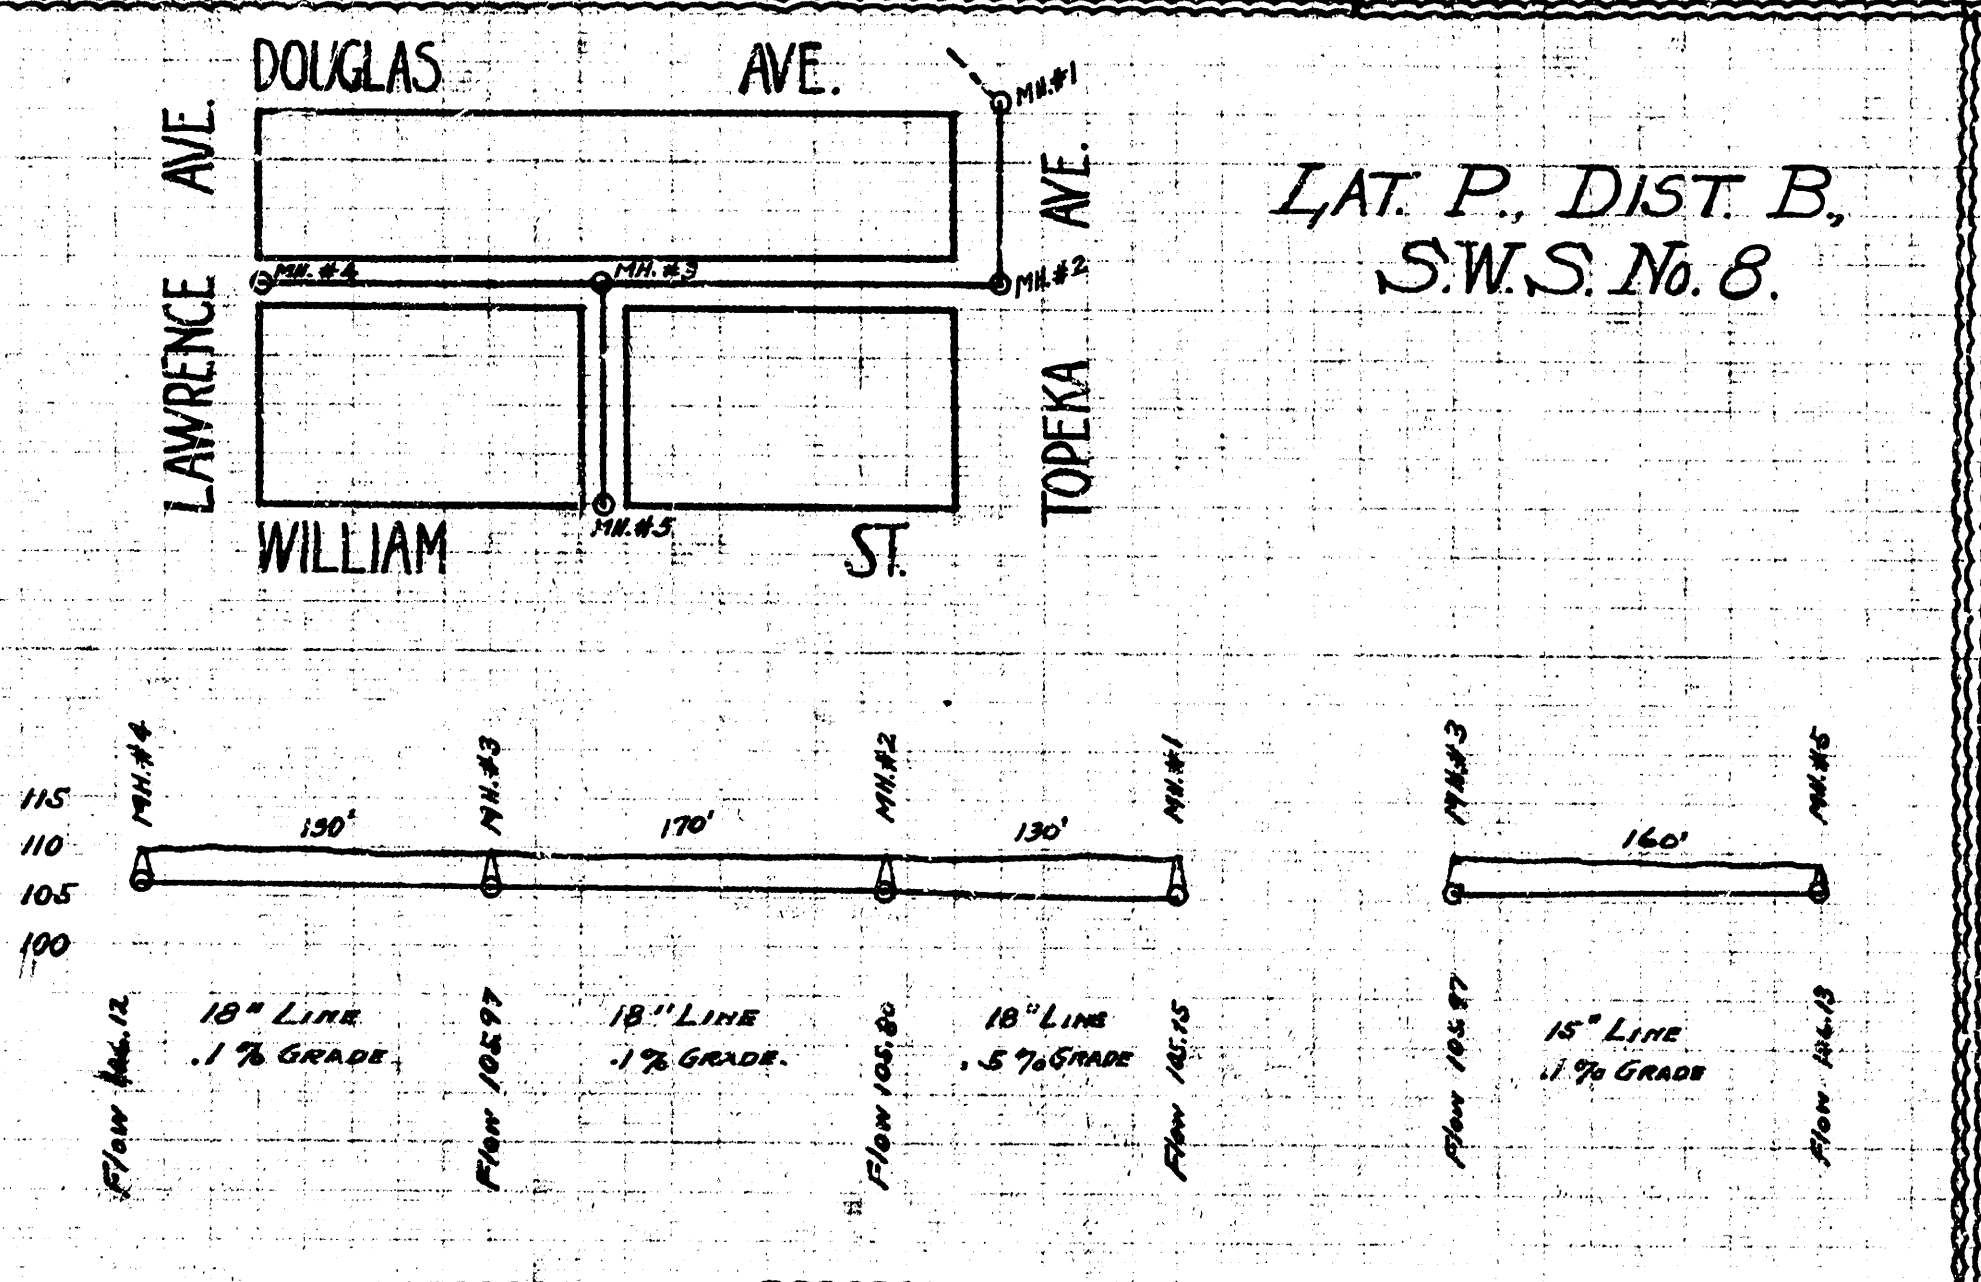

LAT. 7, S.S. No. 1.
 B.M. 110.33 — On south end iron
 water table under south window
 E. side Main Street West.
 N.E. cor. Topeka & Douglas.

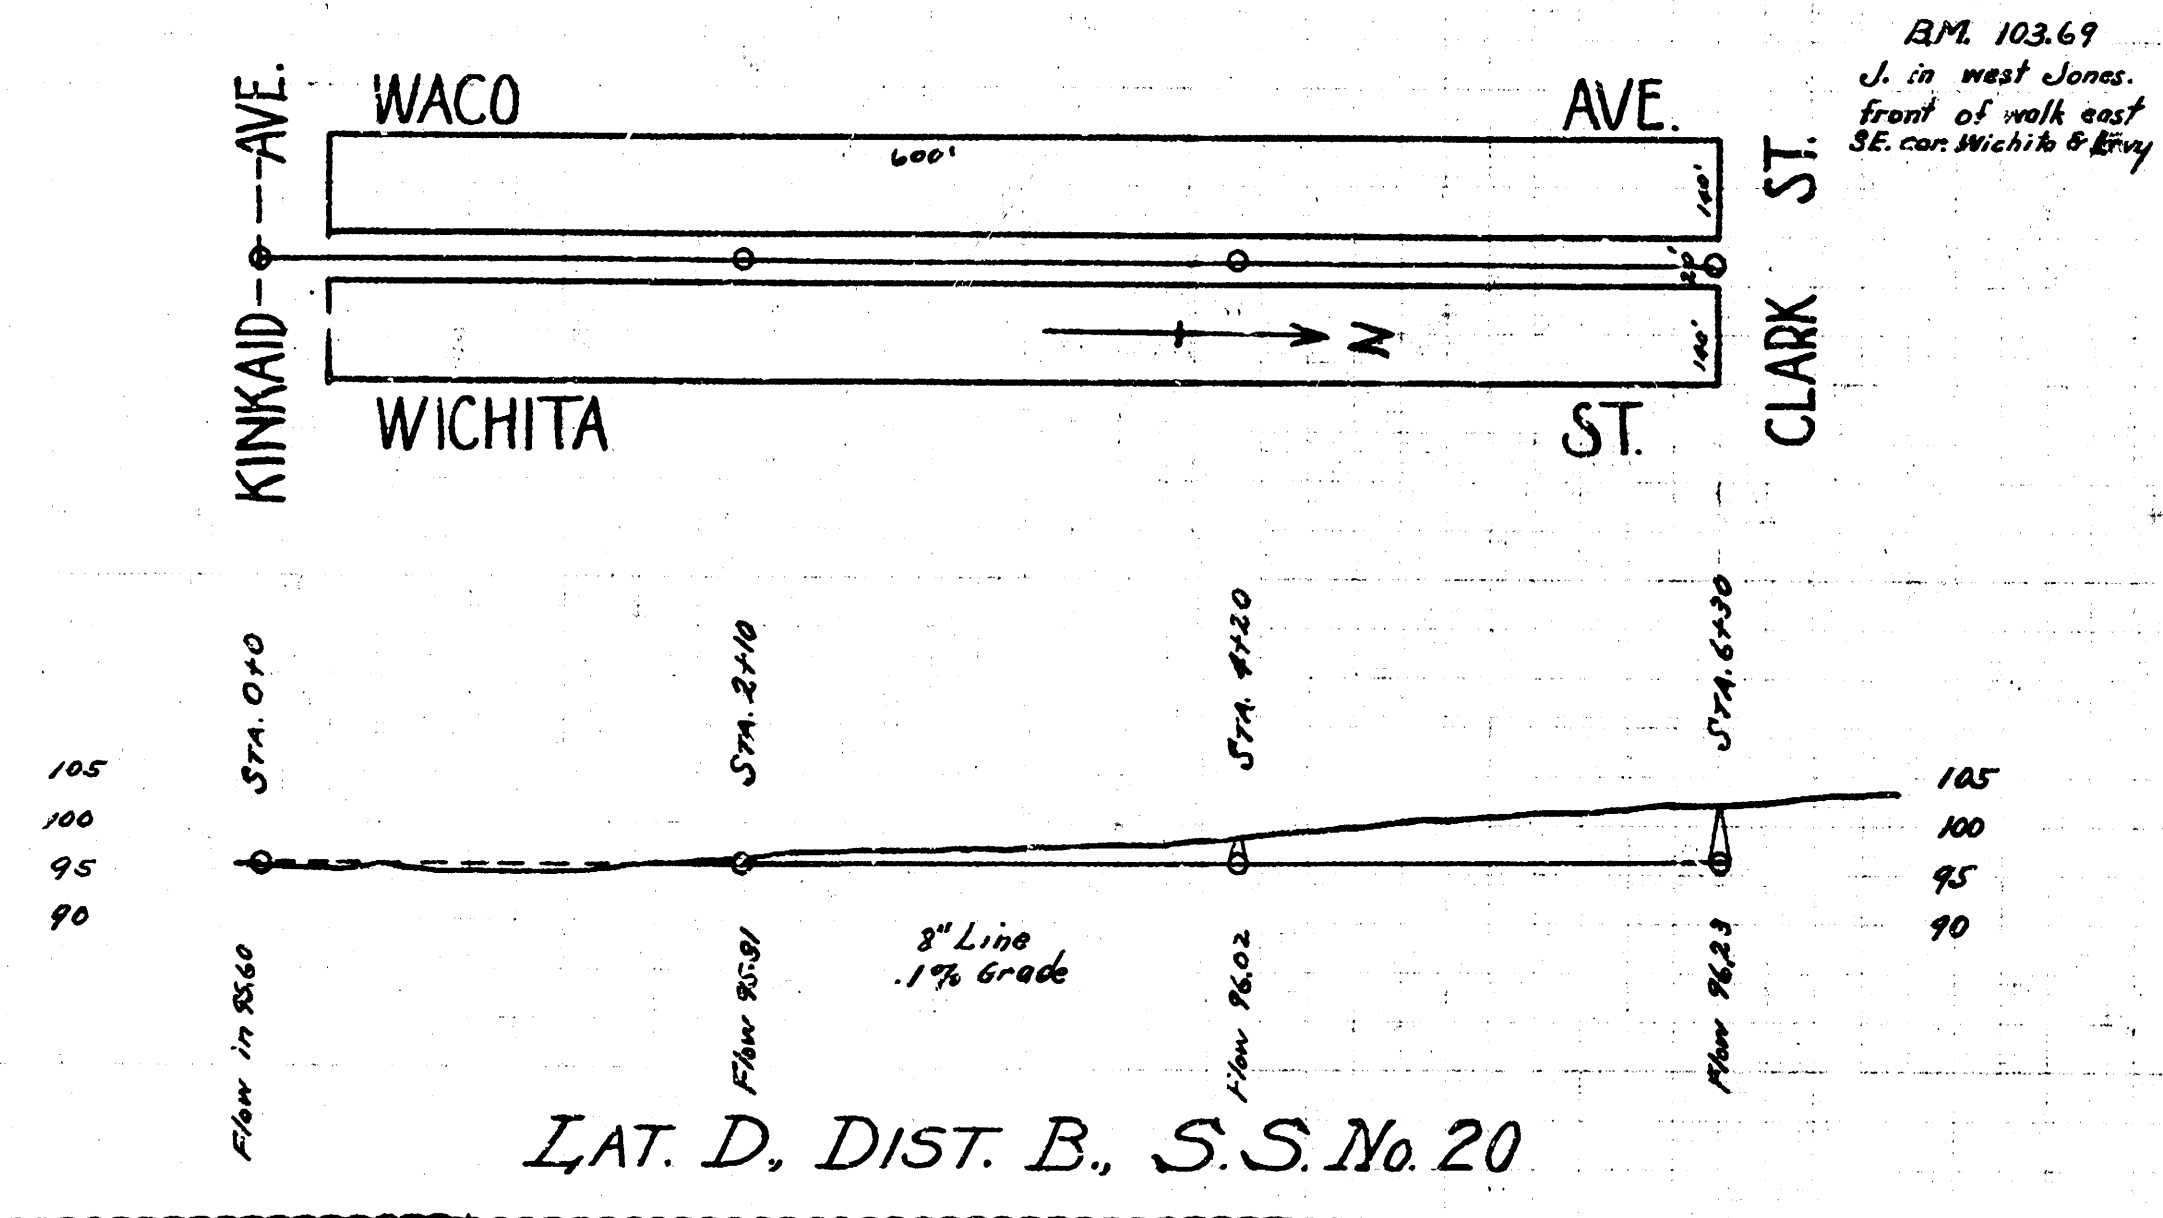

